



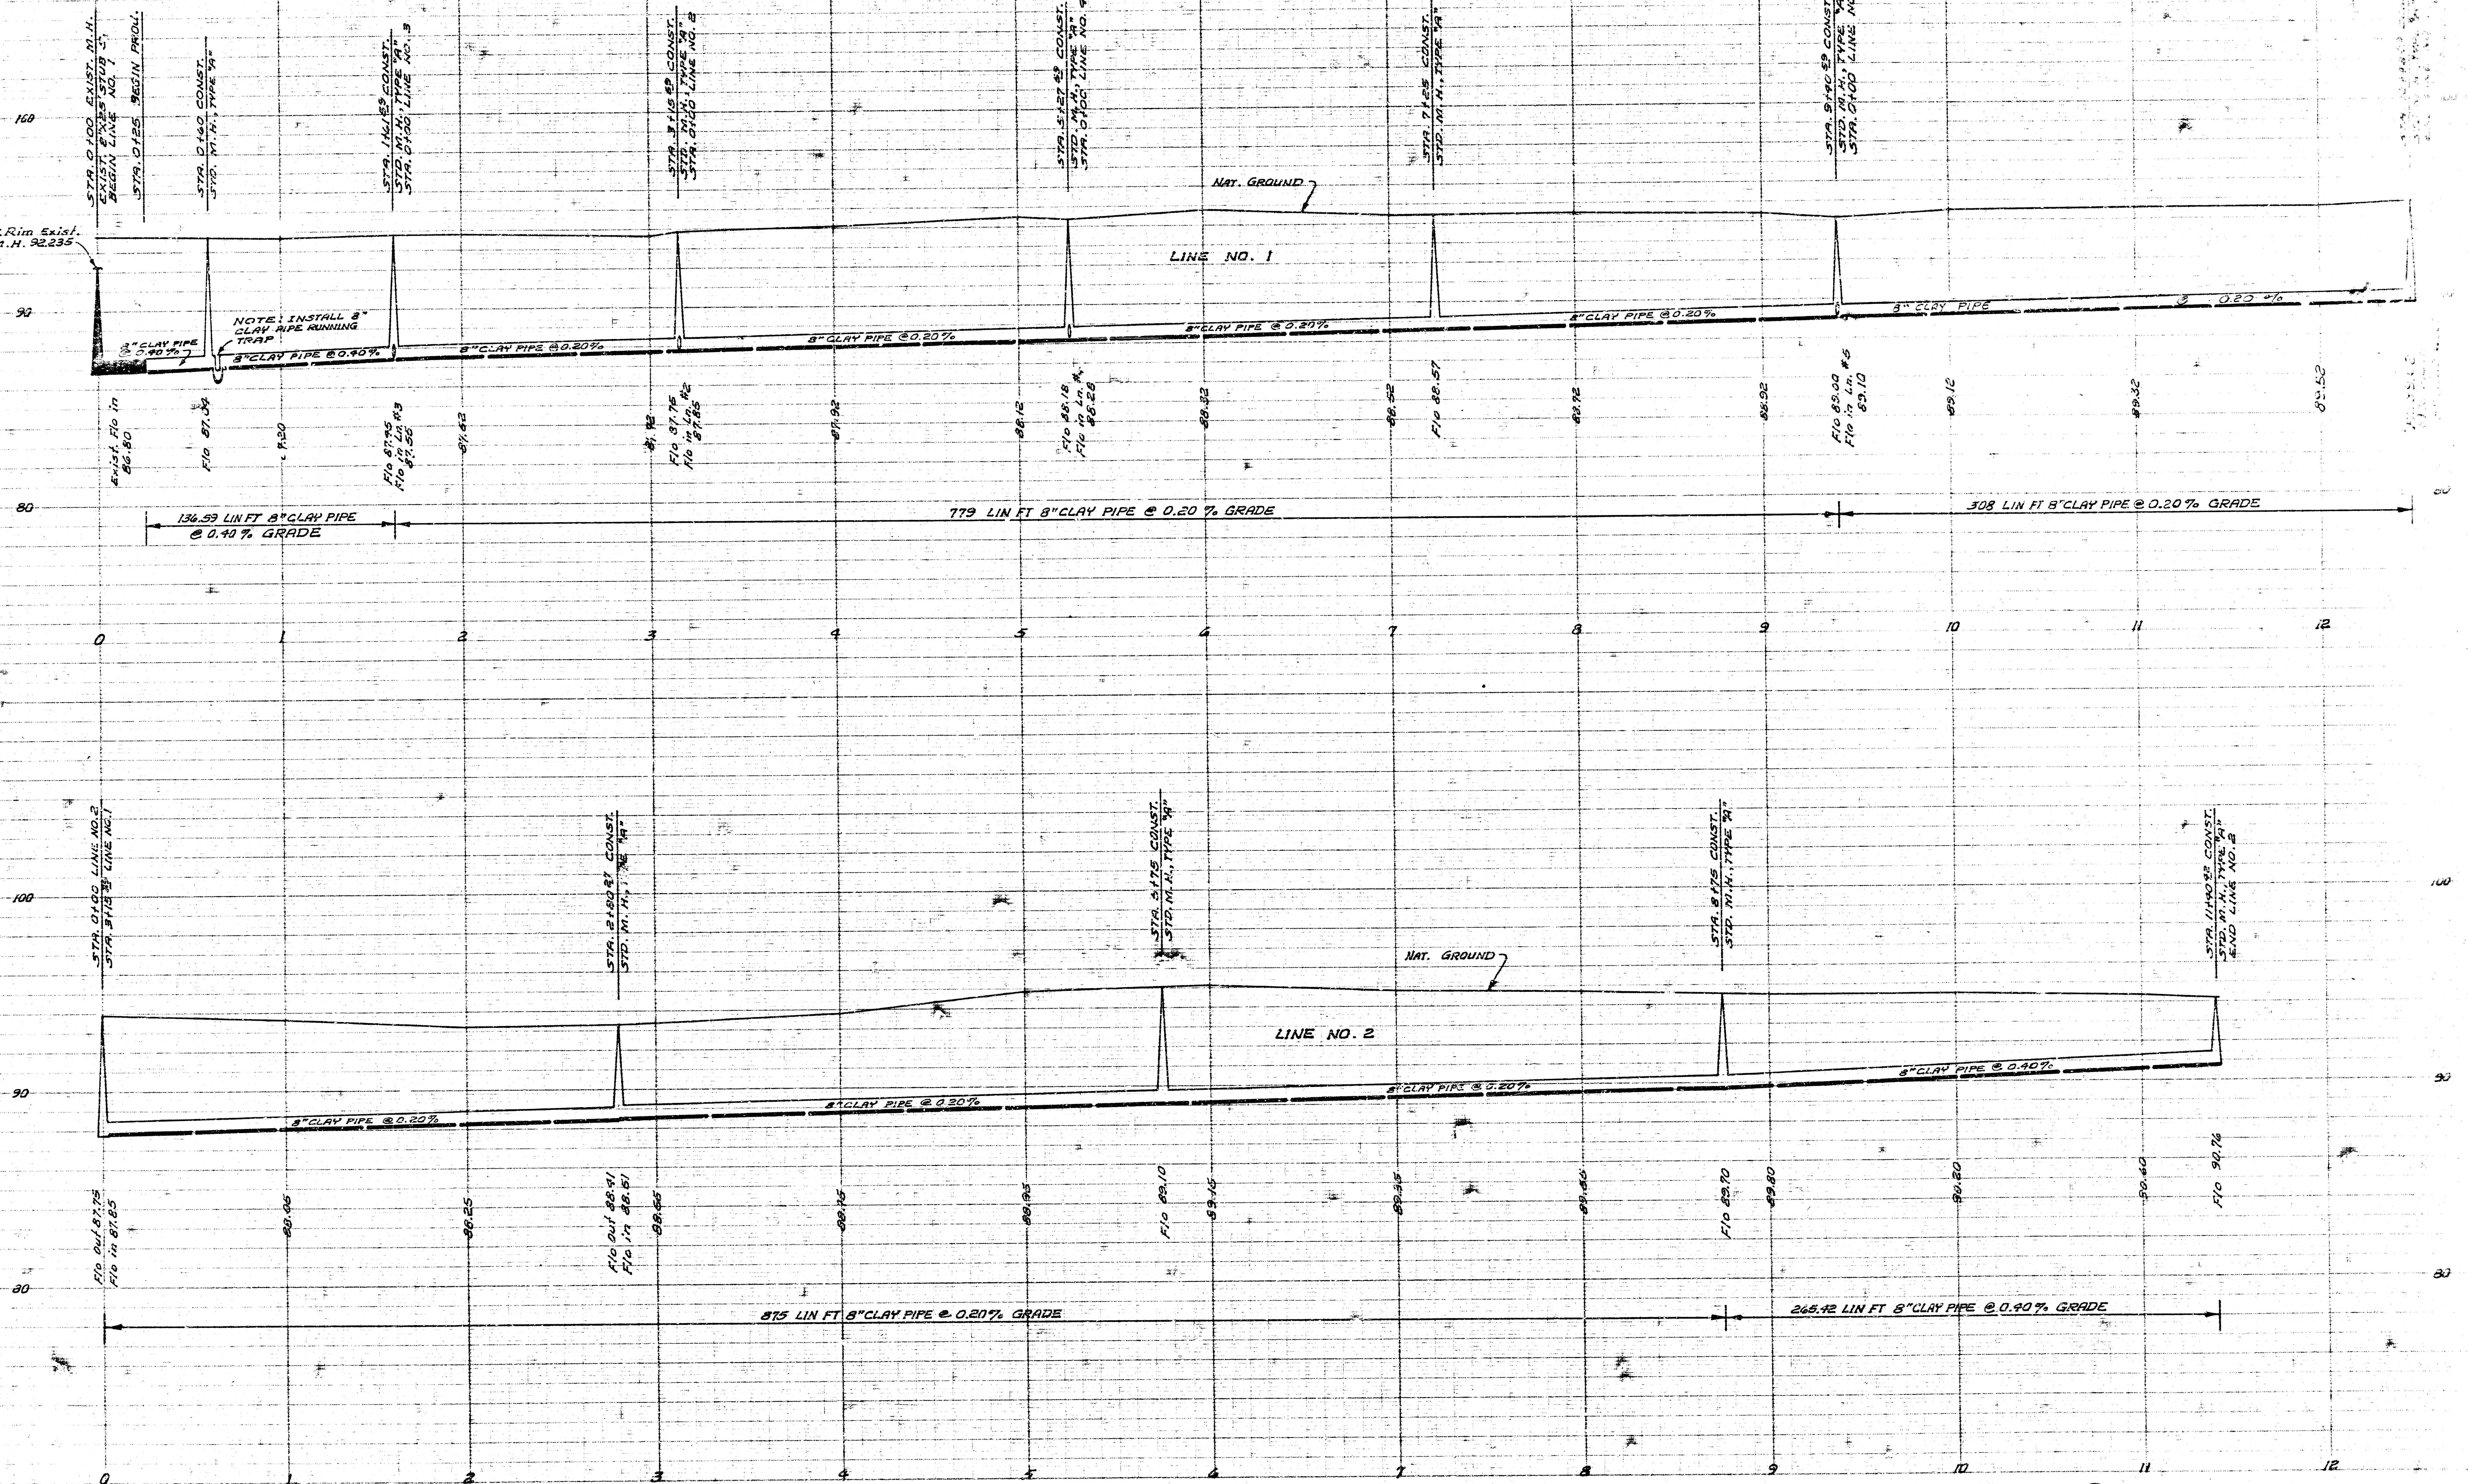
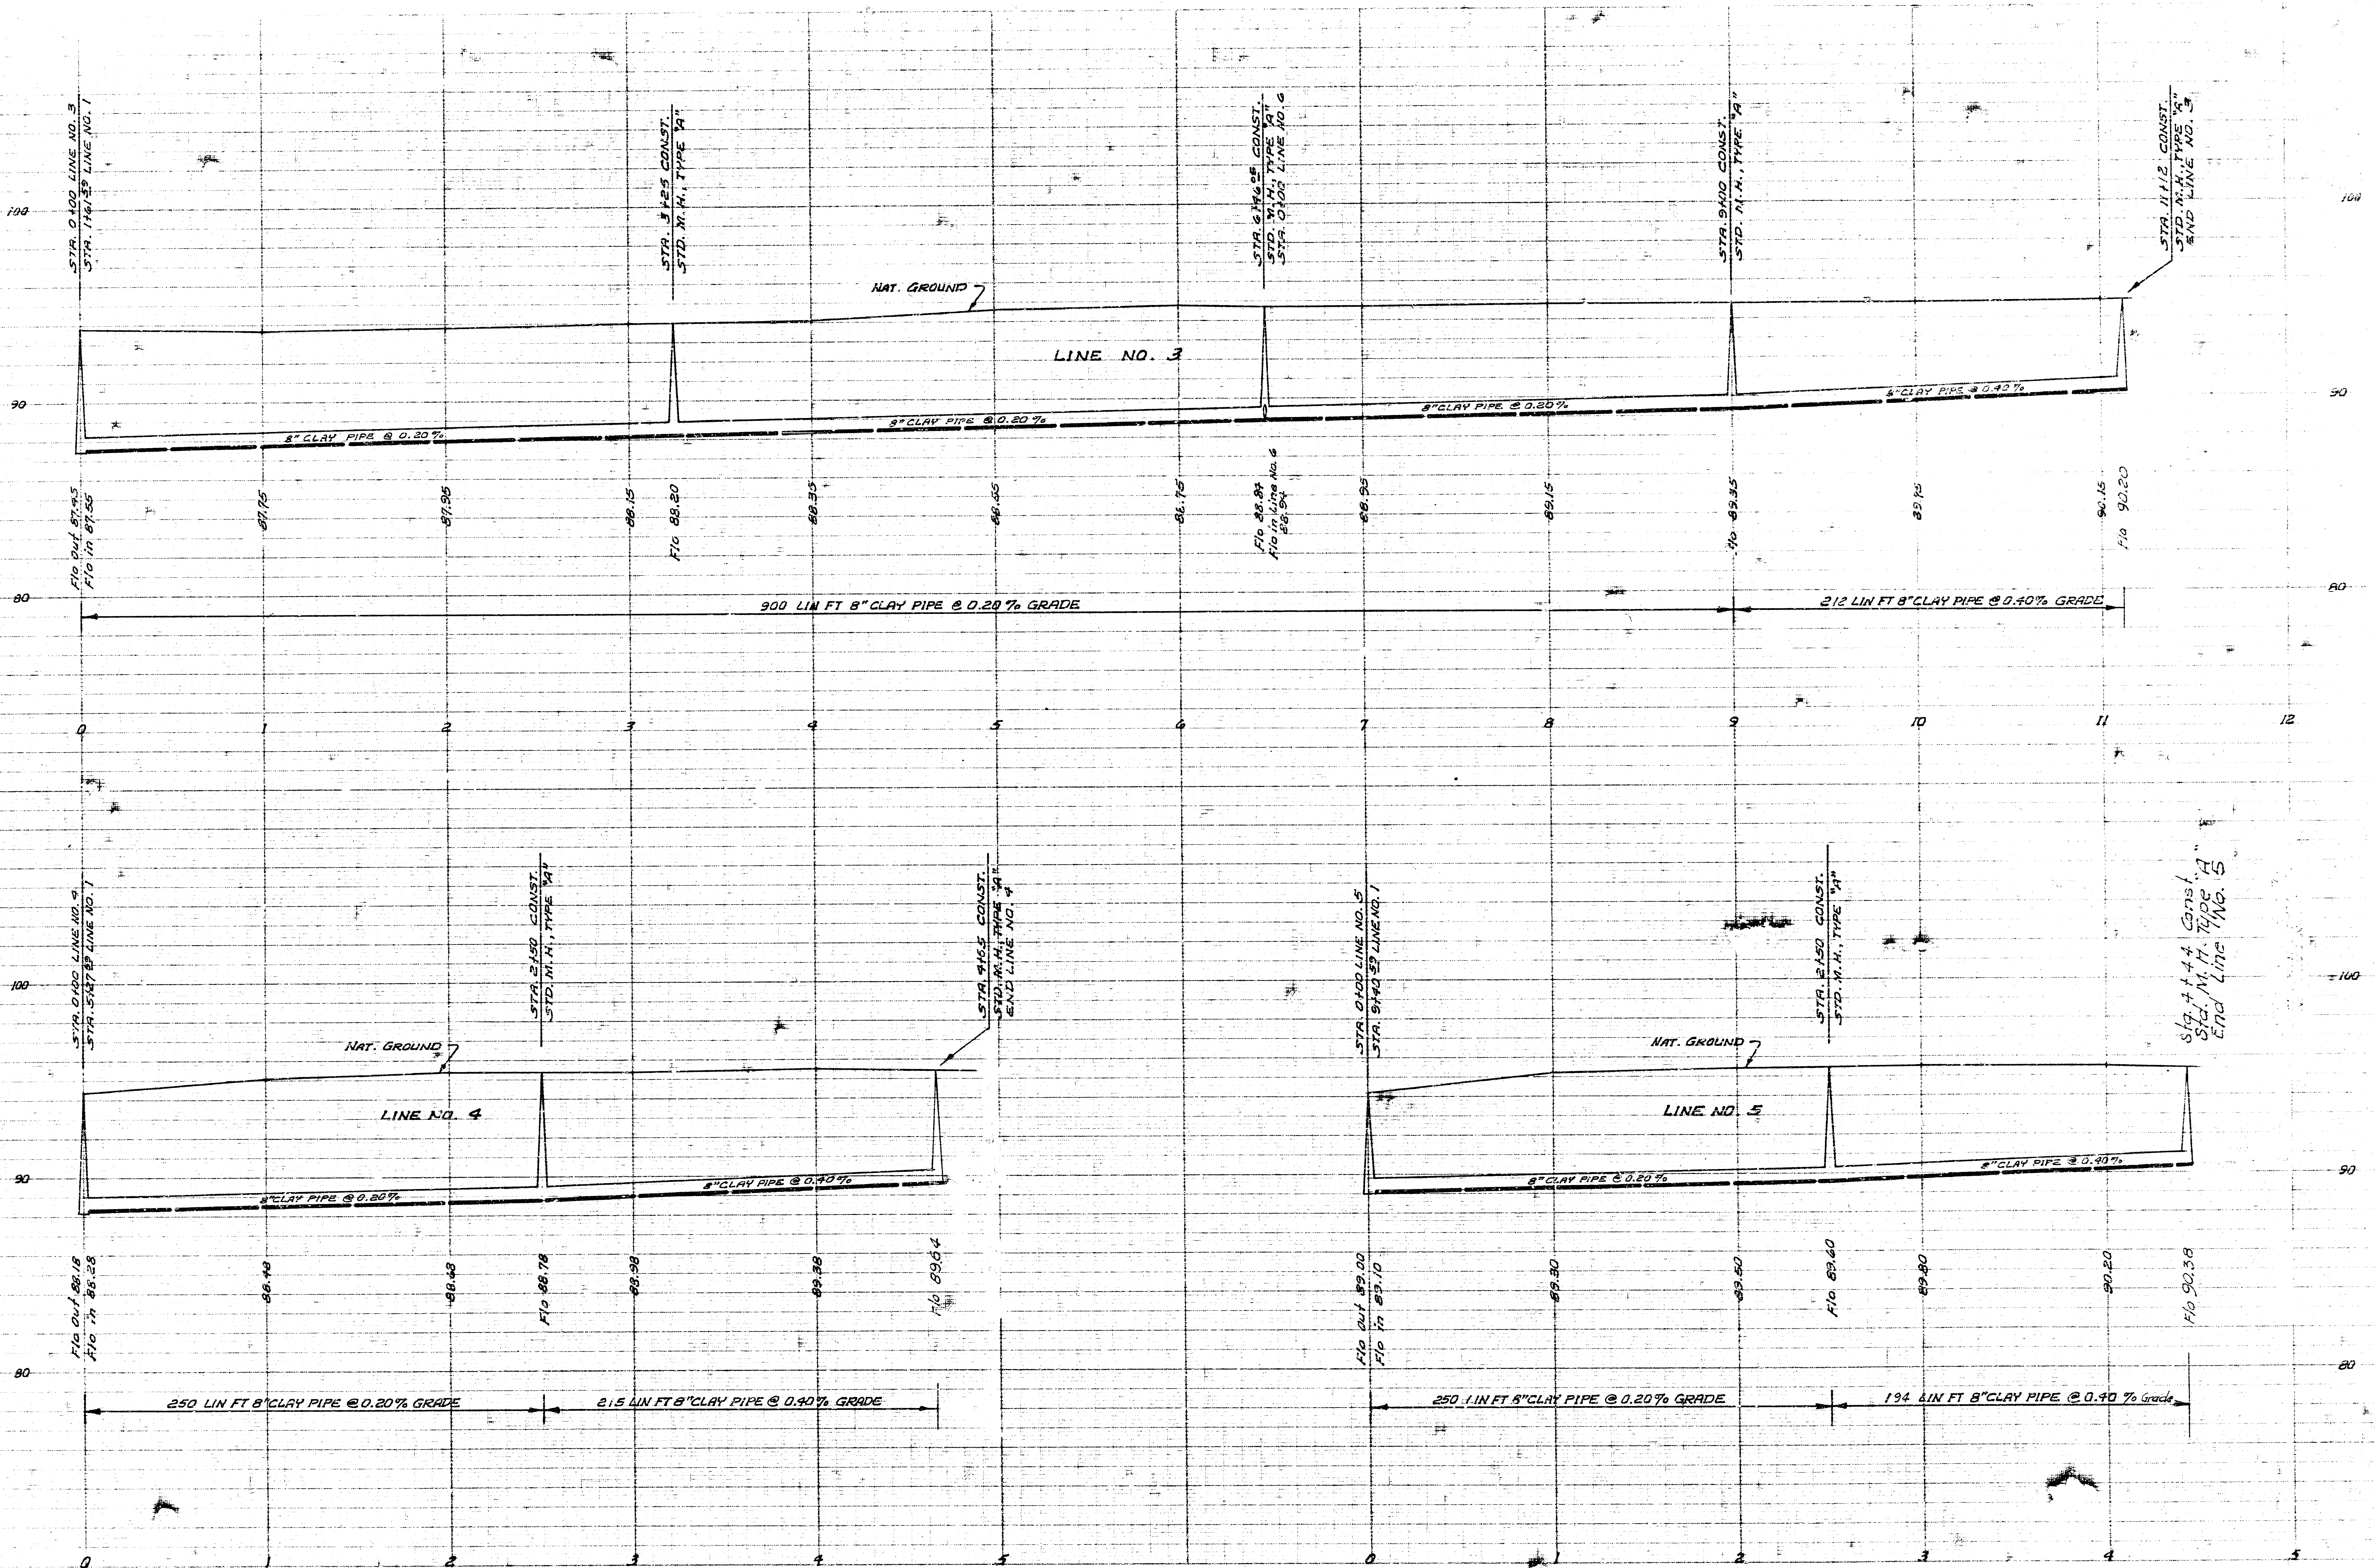
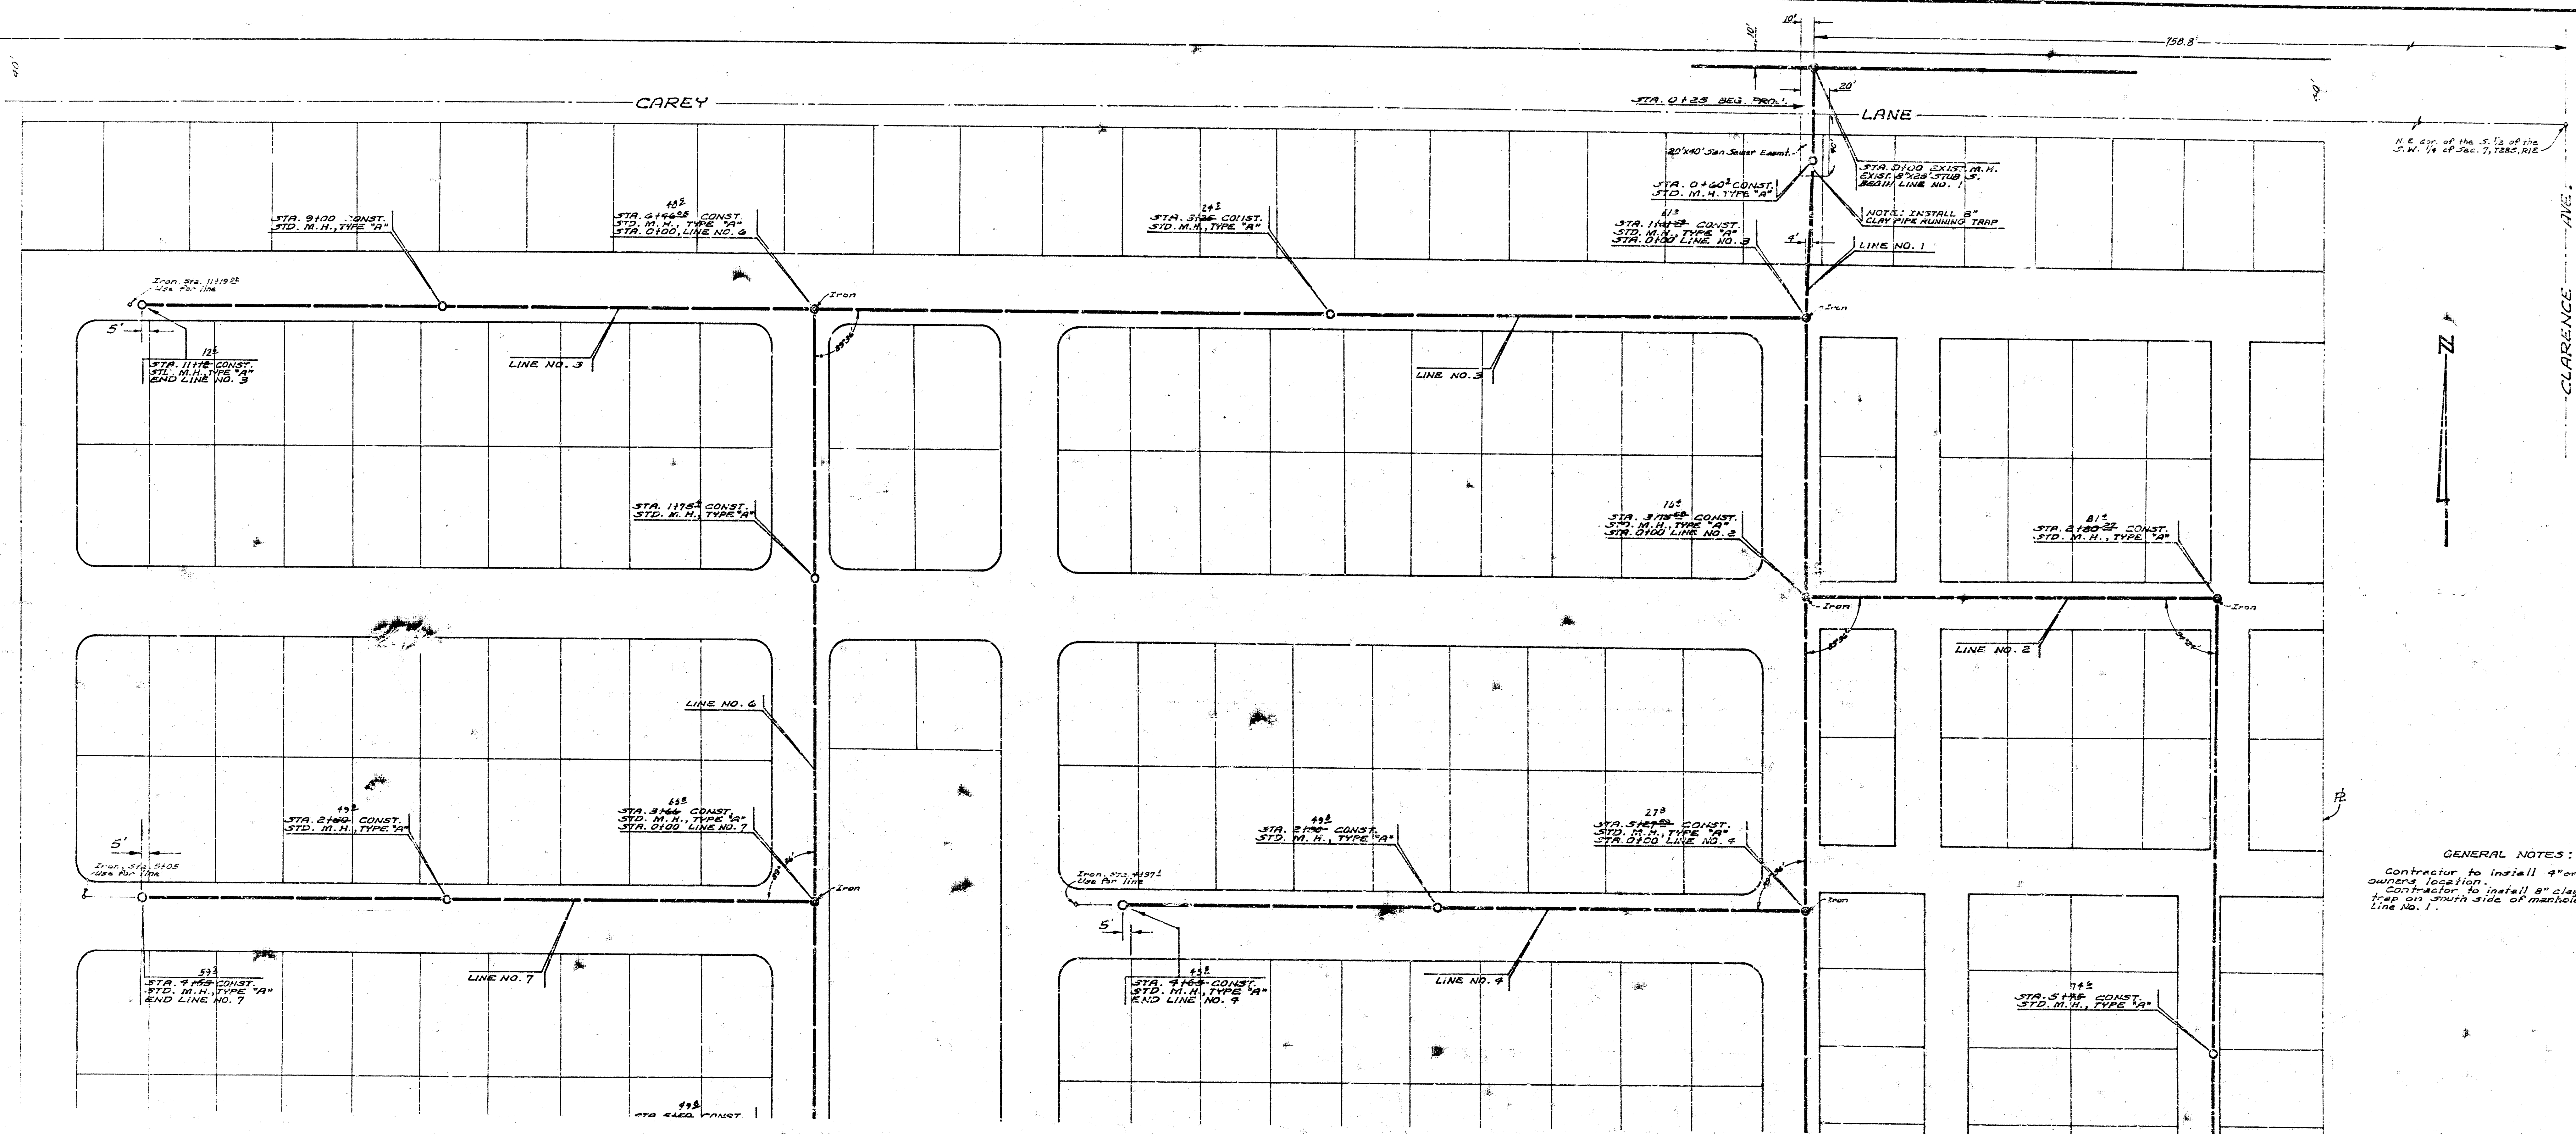
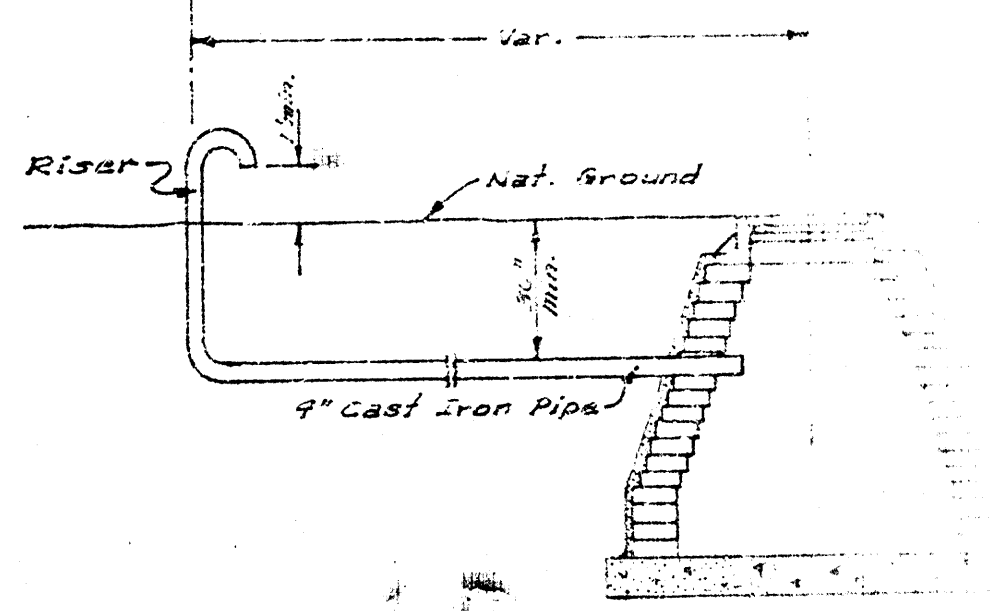
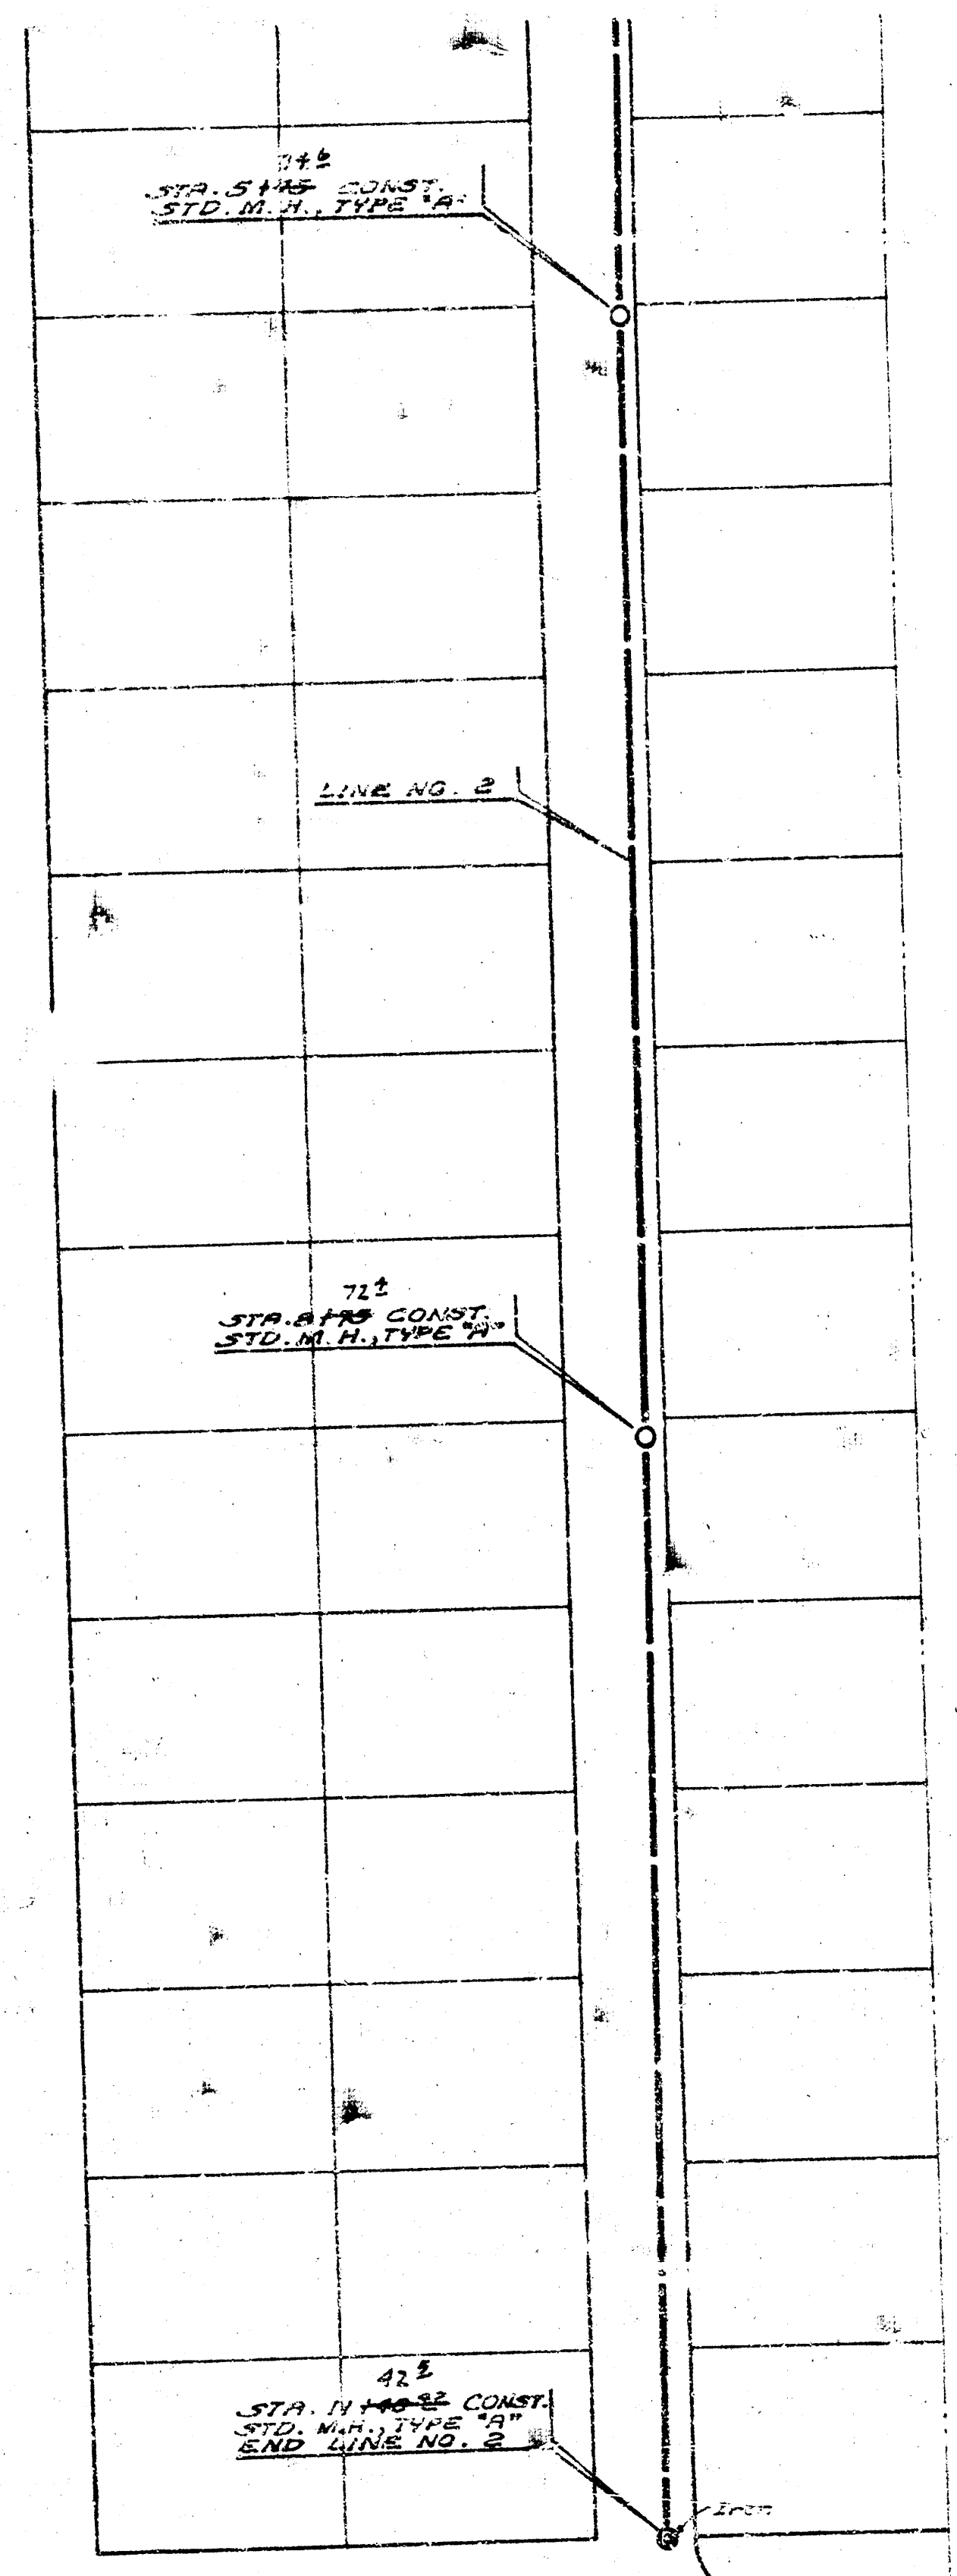
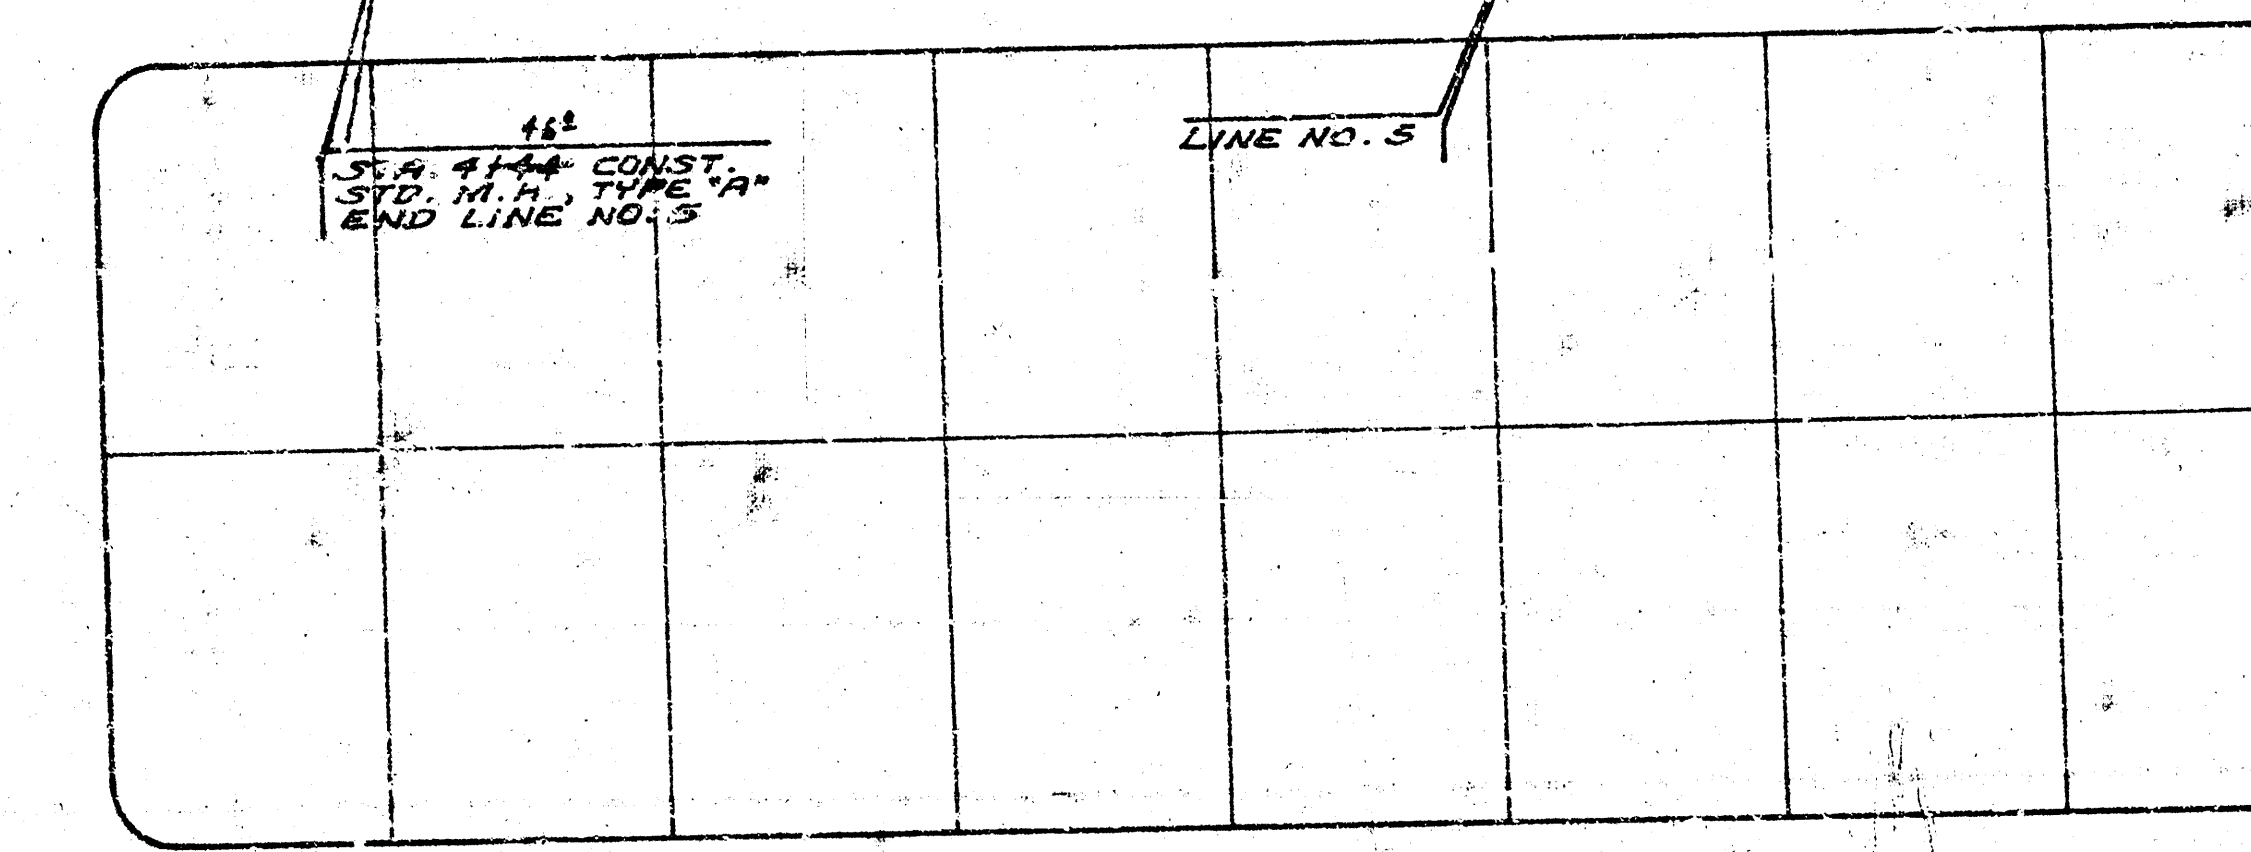
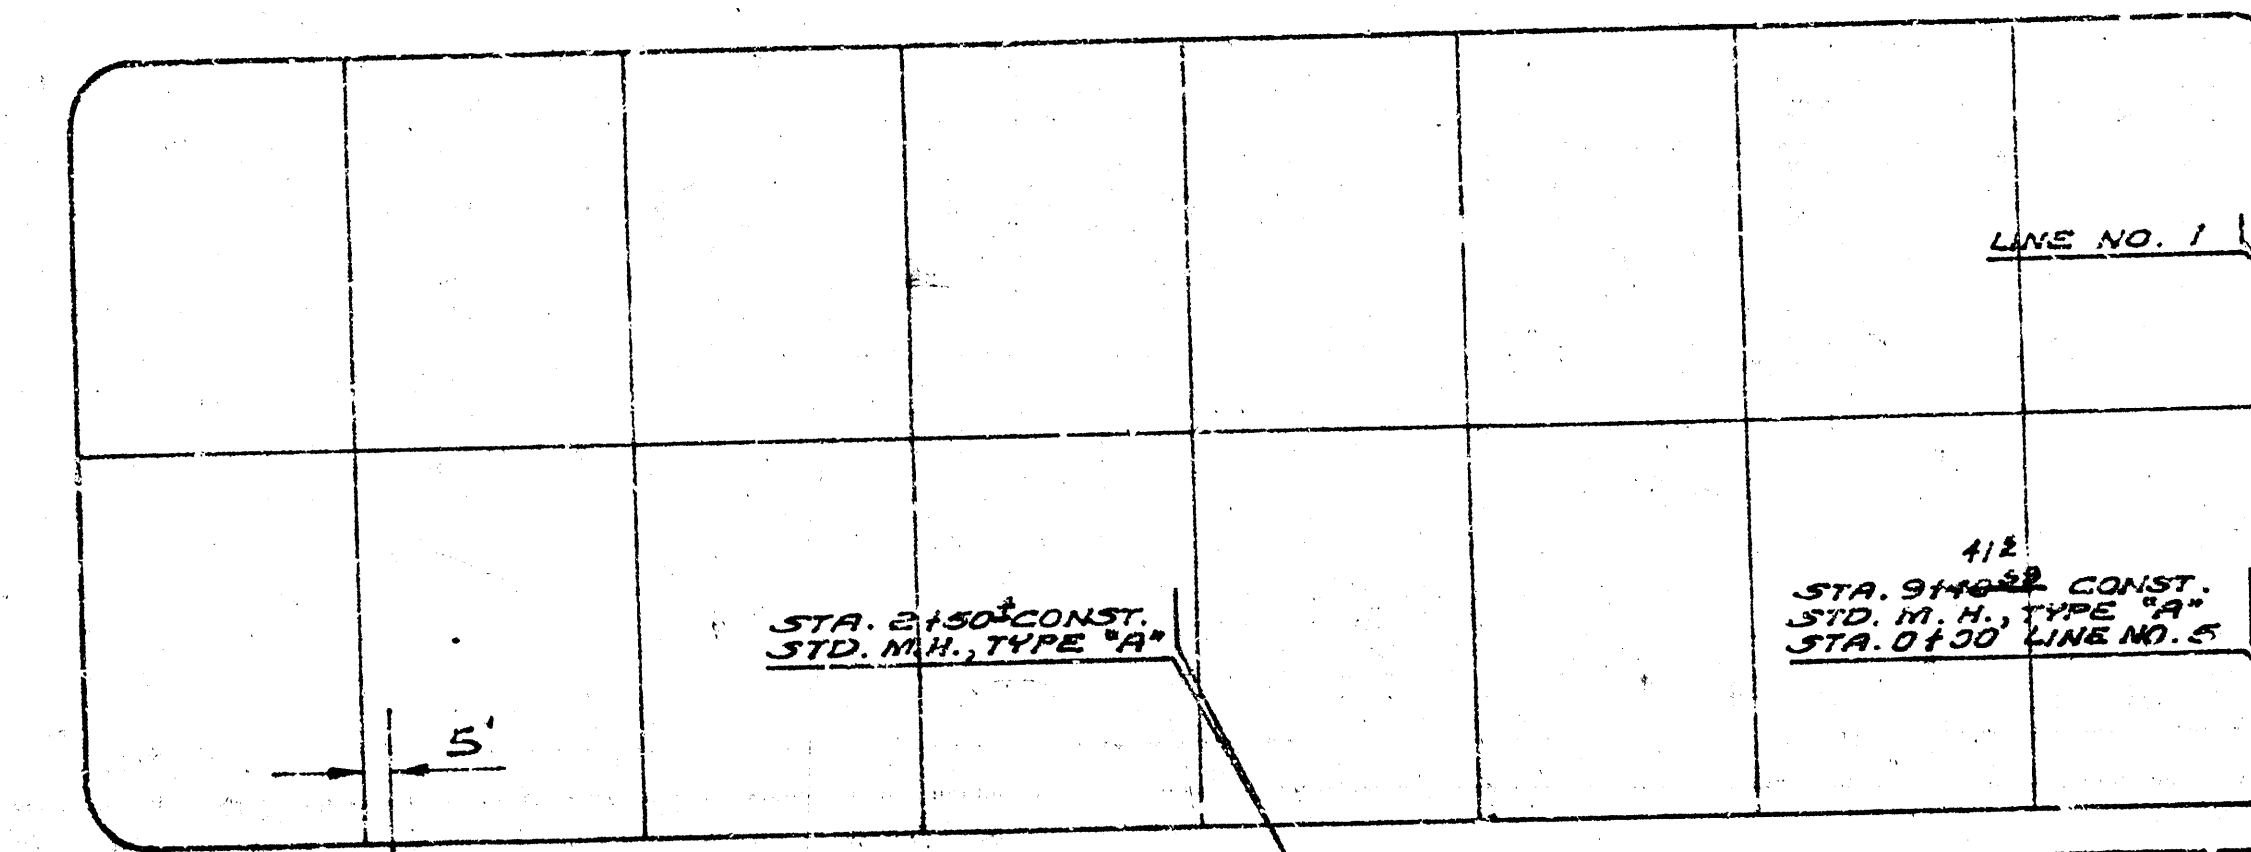


B.M. 95.305 R.R. Spike E. Side Double Fork 30" C.W. Tree 745' W. of Clarence on E Carey Lane

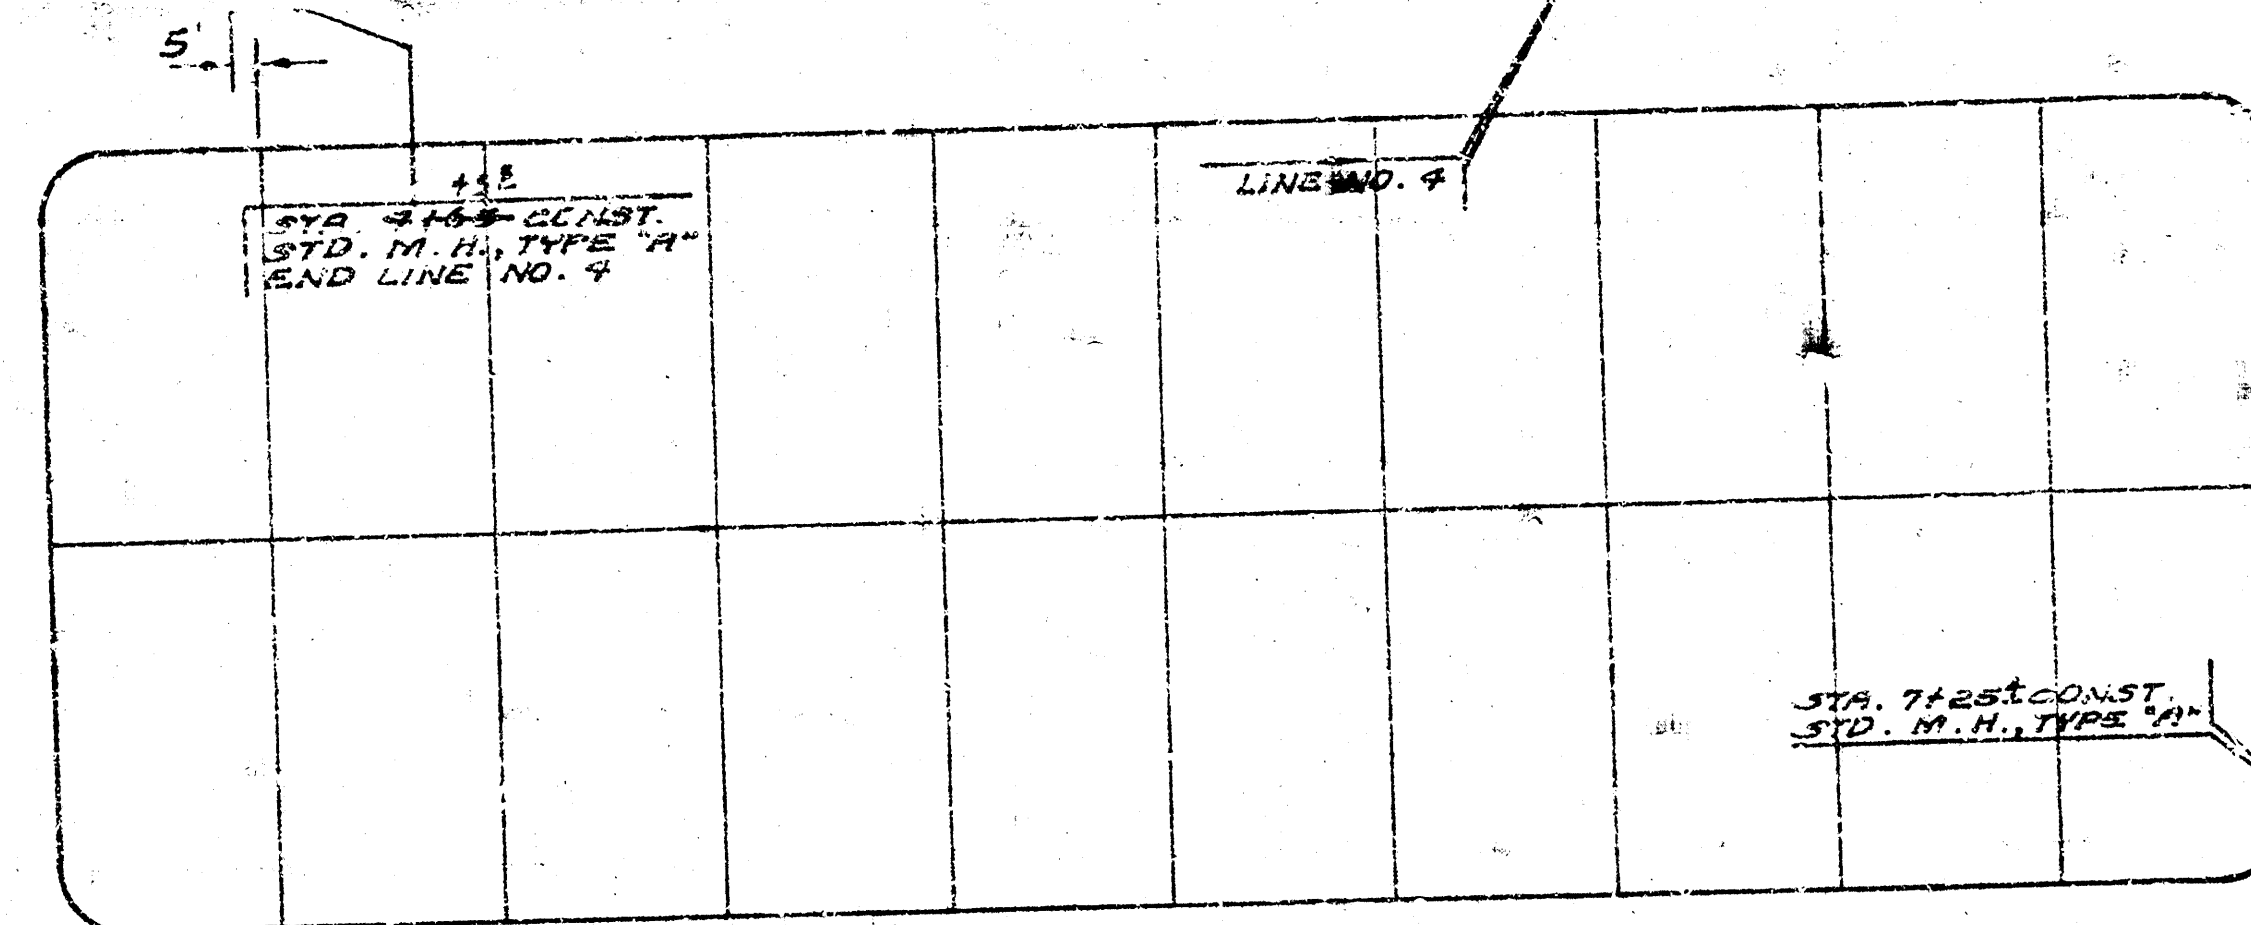


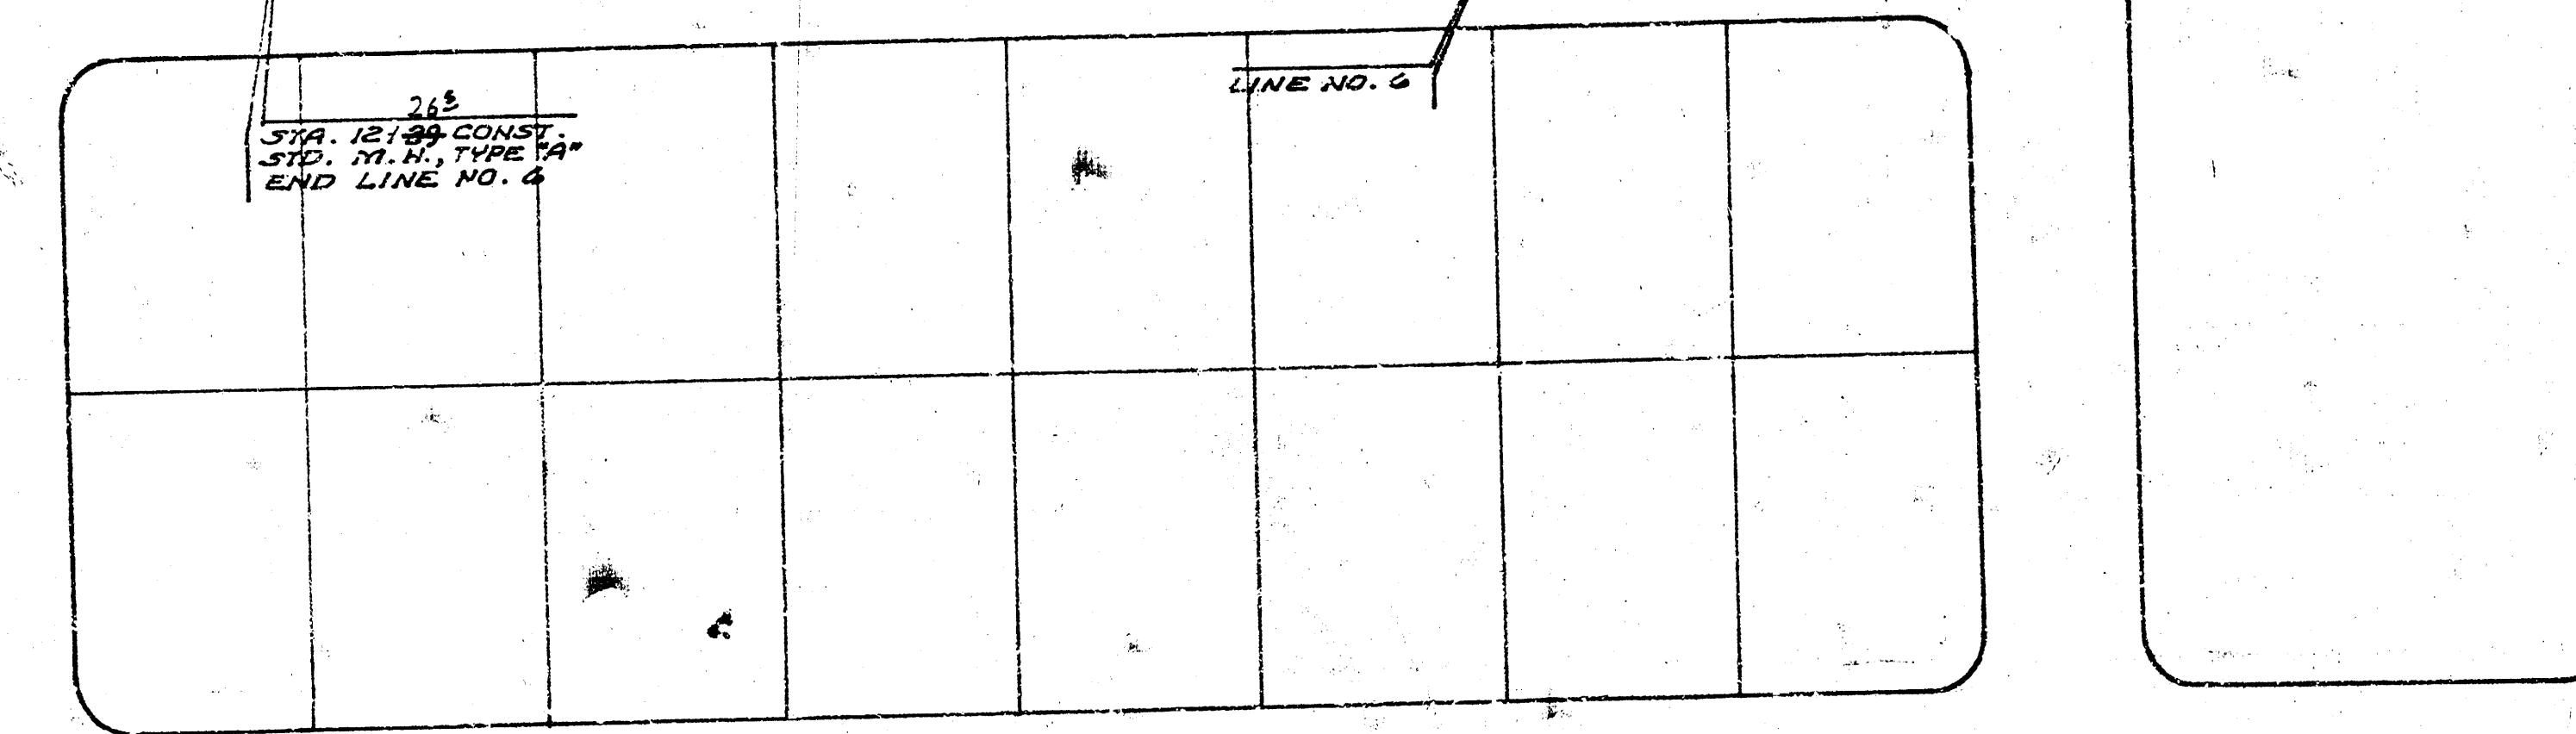


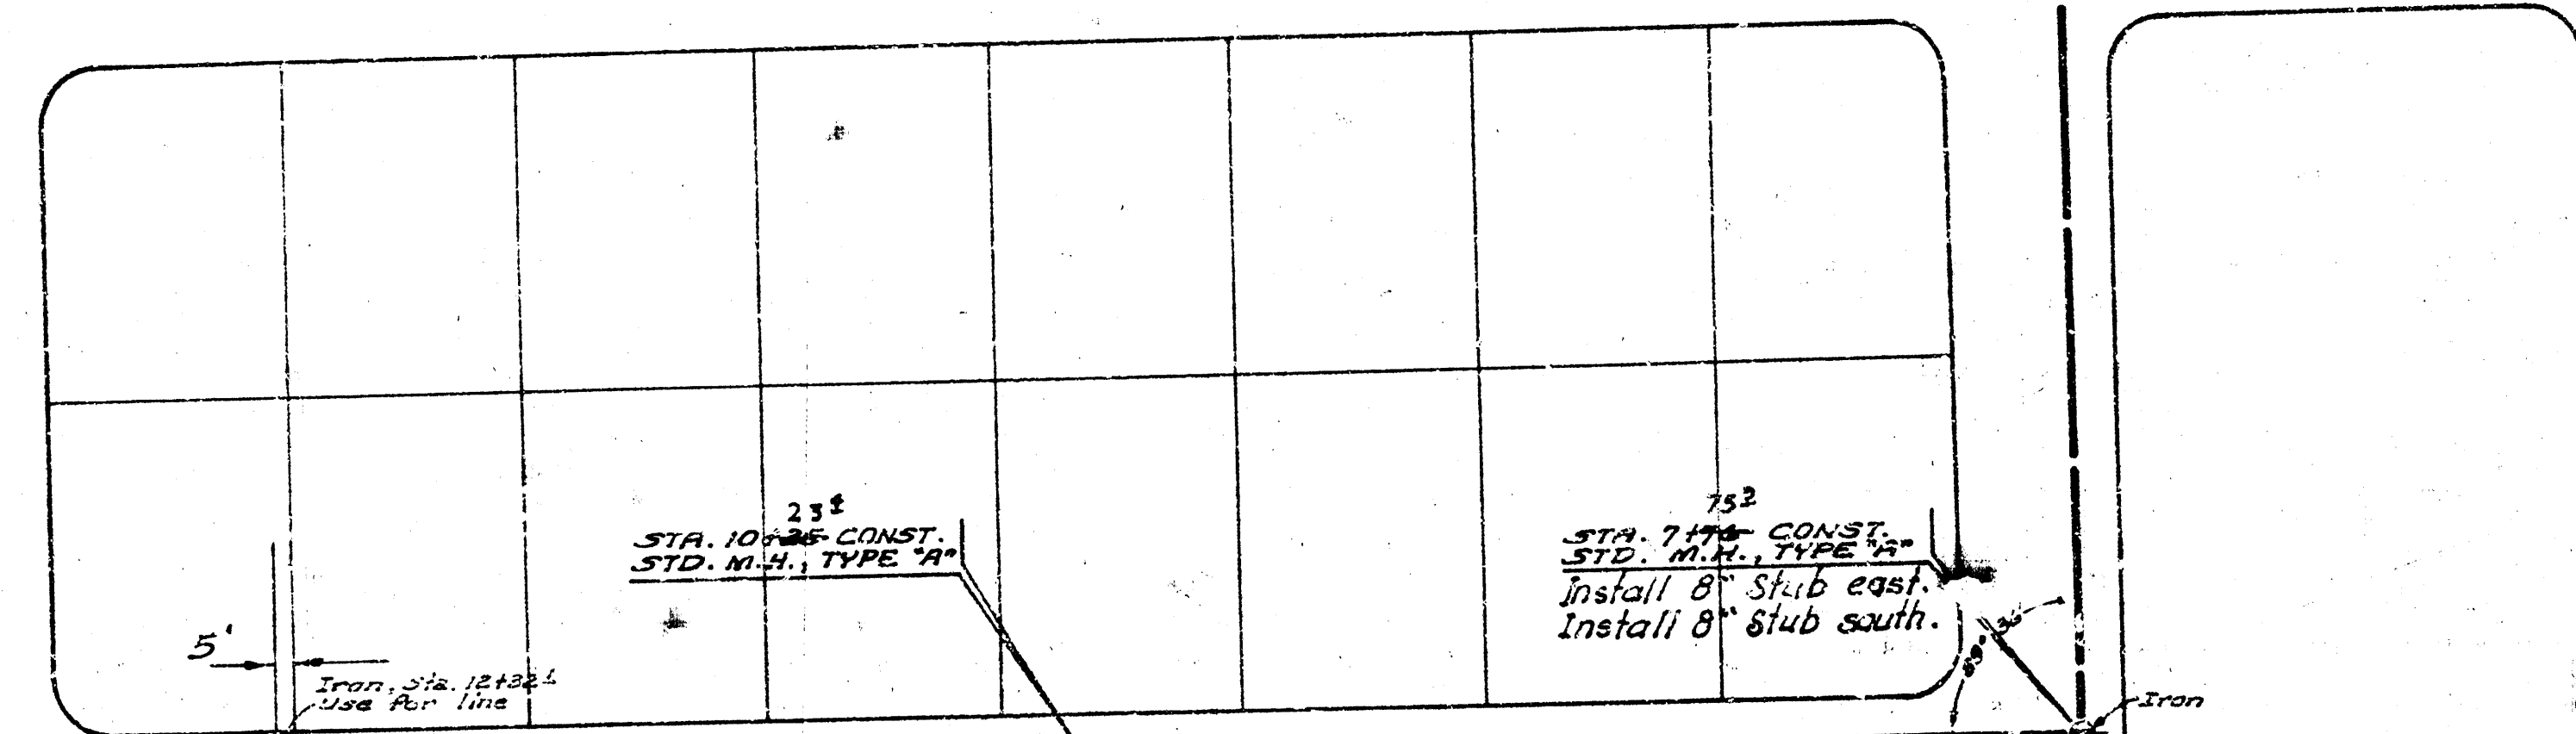

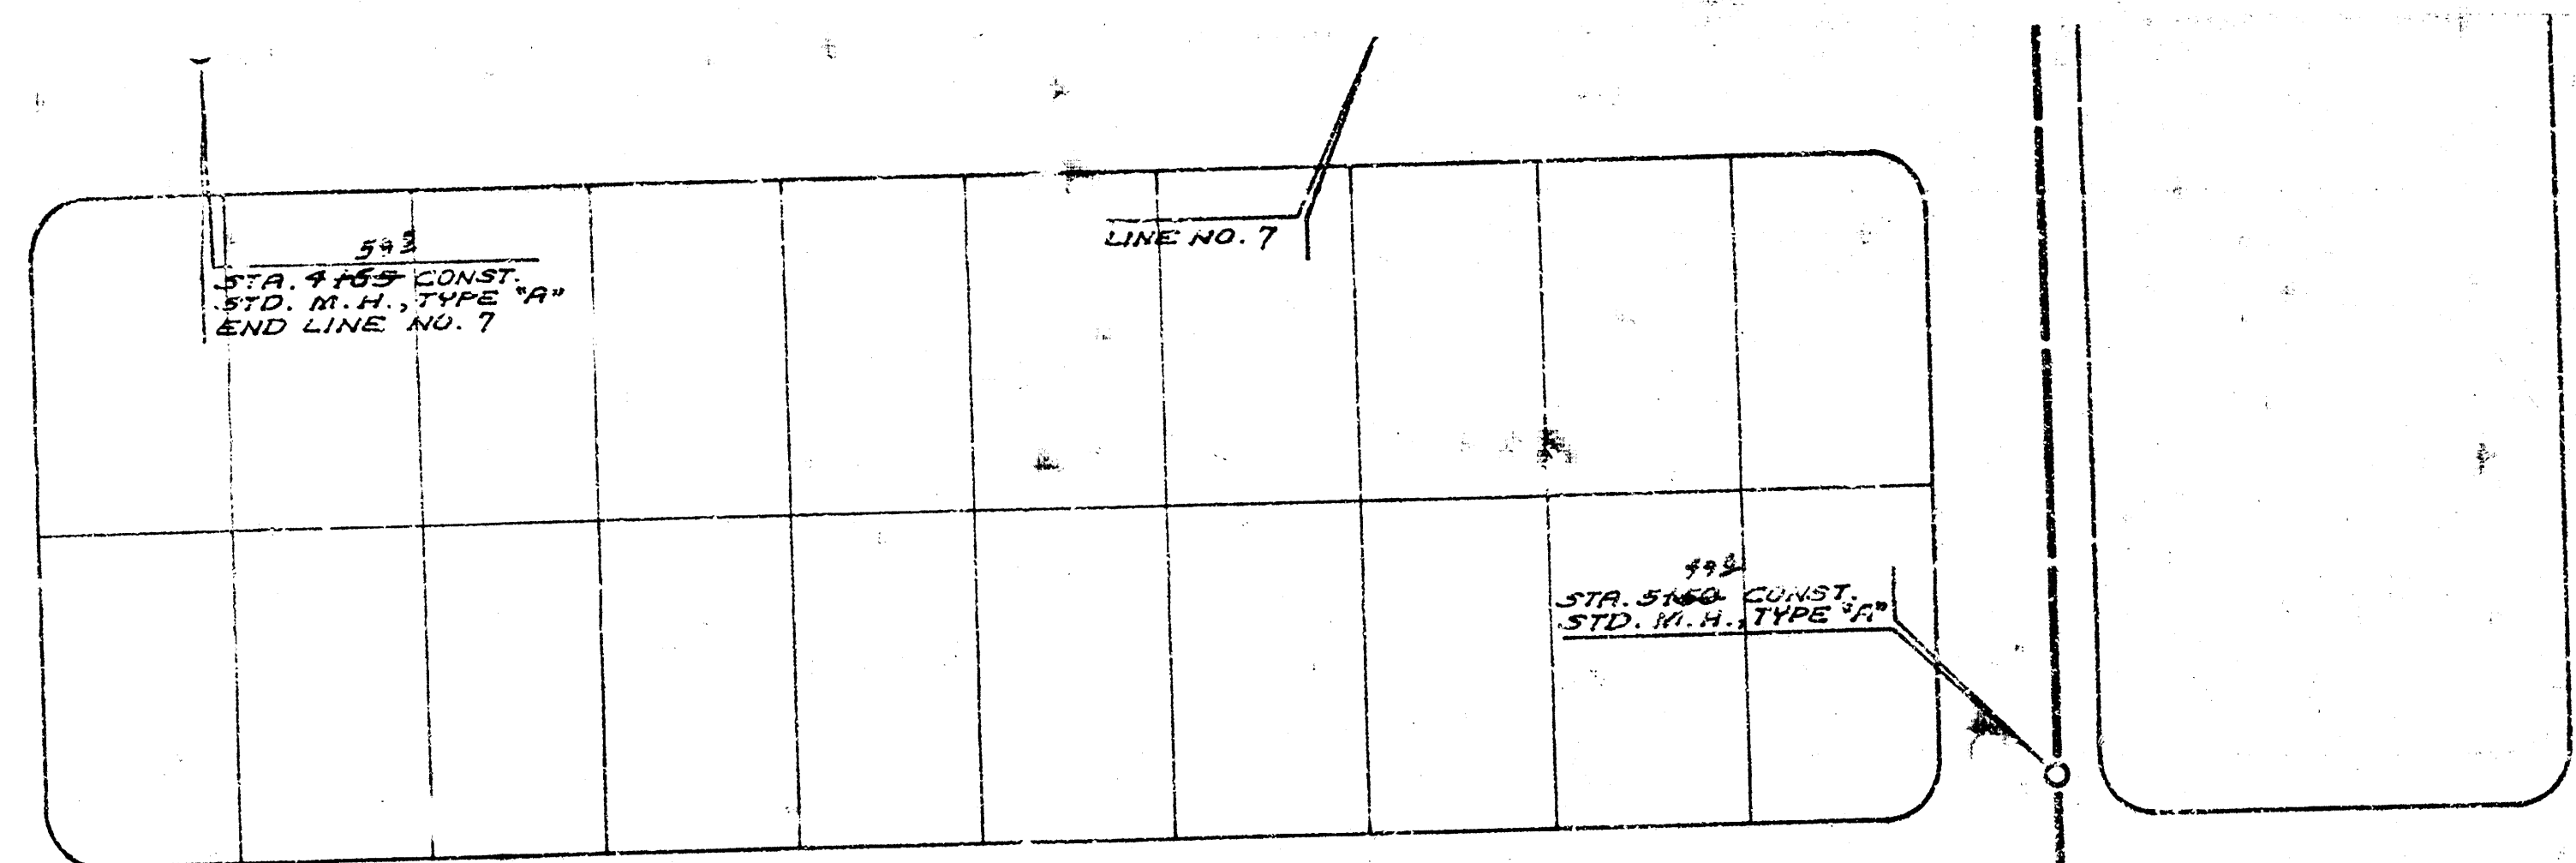

NOTE:
Manholes @ Sta. 121+00, Line No. 1, Sta. 111+00, Line No. 2, Sta. 111+00, Line No. 3, Sta. 111+00, Line No. 4, Sta. 111+00, Line No. 5, Sta. 121+00, Line No. 6 and Sta. 415+00, Line No. 7, and Sta. 415+00, Line No. 8, shall be vented with 4" cast iron pipe. Location of Riser or vent pipe to be determined by owner, B.A. Rudabusch.

NOTE TO CONTRACTOR:
This project was constructed under the supervision of the CITY ENGINEER and conforming to the specifications of the CITY OF WICHITA. The CONTRACTOR shall reimburse the City of Wichita for all cost of Engineering, Plans, and Inspection.

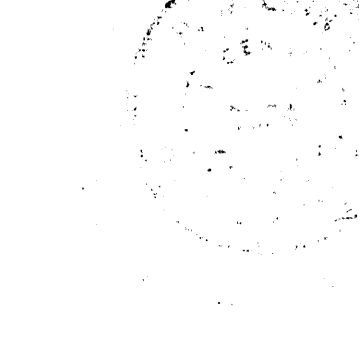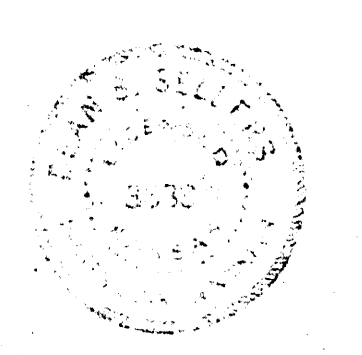

CLARENCE AVE.

As Built
Final Plans
SS 13 1/2"

MOBIL MANOR MOBIL HOME PARK
SANITARY SEWER
CITY OF WICHITA, KANSAS
R.W. LINN, CITY ENGINEER
DATE: SEPT. 1970 PROJECT NO. 174
PLAN 55-13

174