


File No.	
Sheet No.	
Project No.	
Drawn By	
Checked By	
Approved By	

Redg. out
156.50

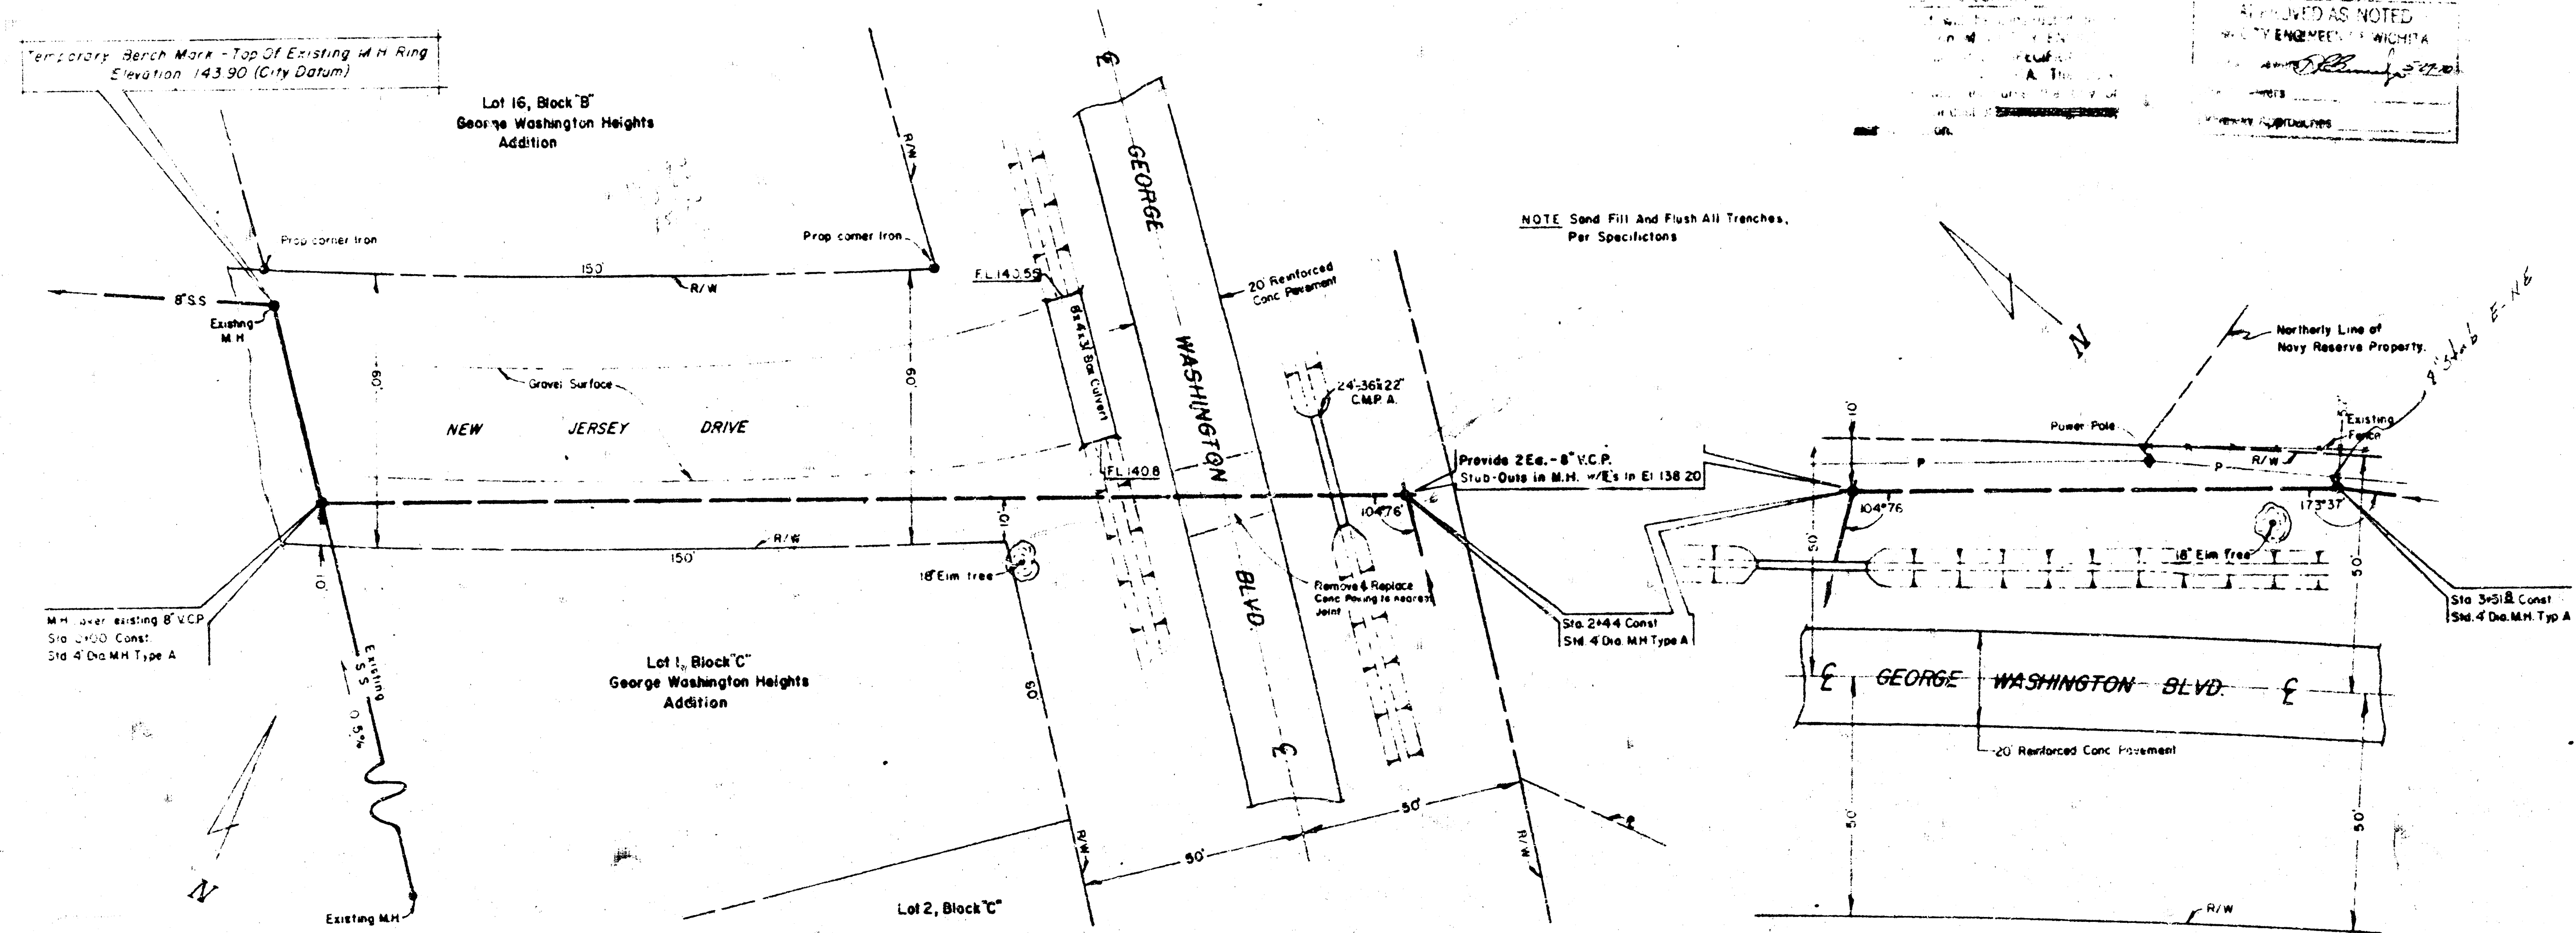


NOTE: Sand Fill And Flush All Trenches, Per Specifications

APPROVED AS NOTED
WICHITA ENGINEERS & ARCHITECTS
A. THOMPSON
WICHITA, KANSAS

156.55
10m "D" cut in Headwall
centerline of R.C.B.

Horizontal Scale in Feet
20 10 0 10 20

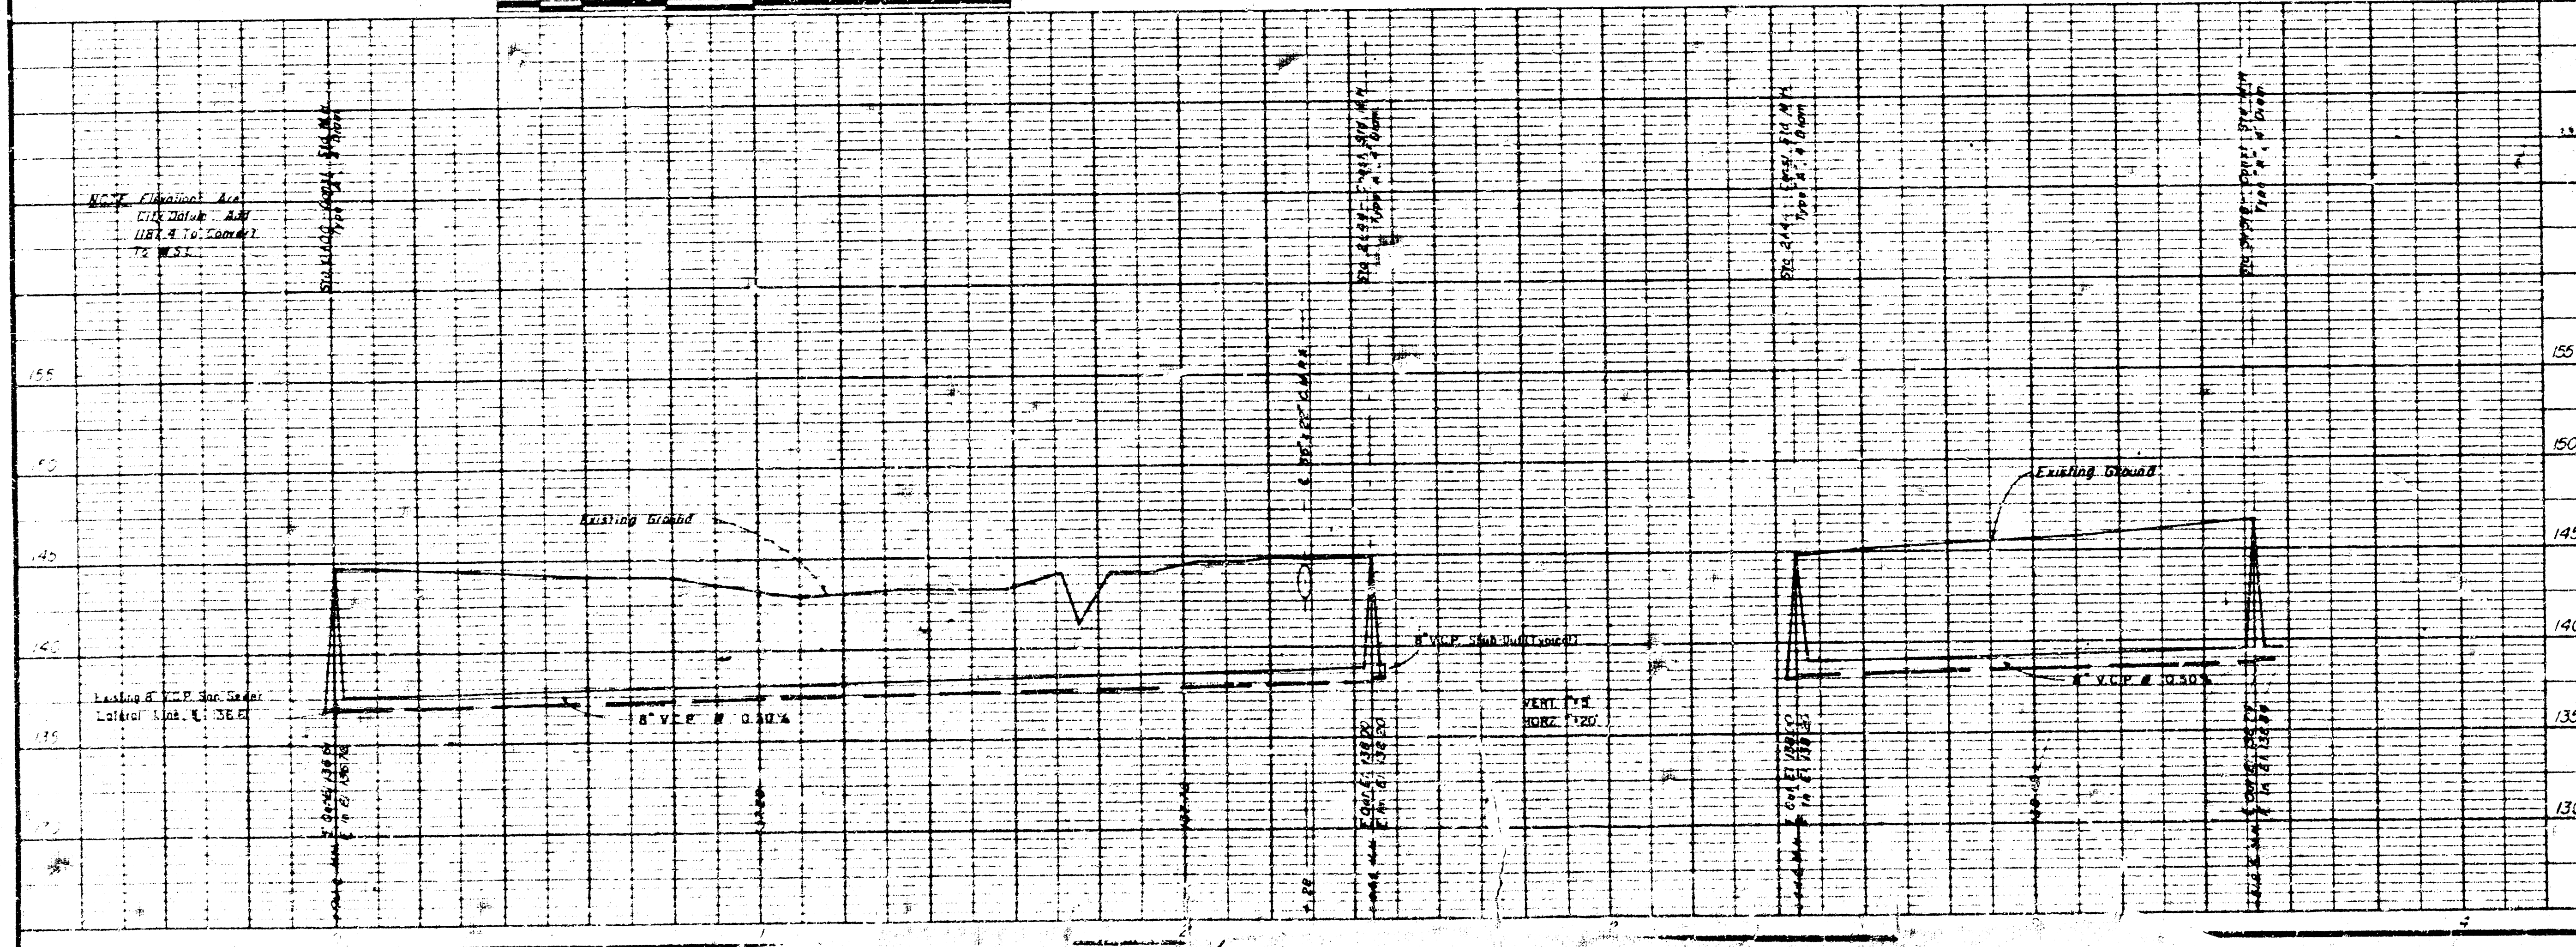

SCHAEFER SCHIRMER & ELLIN AIA 200 S. MILLSIDE - WICHITA, KANSAS 67201 TEL. 261-1111		DEPARTMENT OF THE NAVY MIDWEST DIVISION NAVAL RESERVE TRAINING CENTER WICHITA, KANSAS	
DATE: _____ DRAWN BY: _____ CHECKED BY: _____ APPROVED BY: _____	DATE: _____ DATE: _____ DATE: _____	DATE: _____ DATE: _____ DATE: _____	DATE: _____ DATE: _____ DATE: _____

