

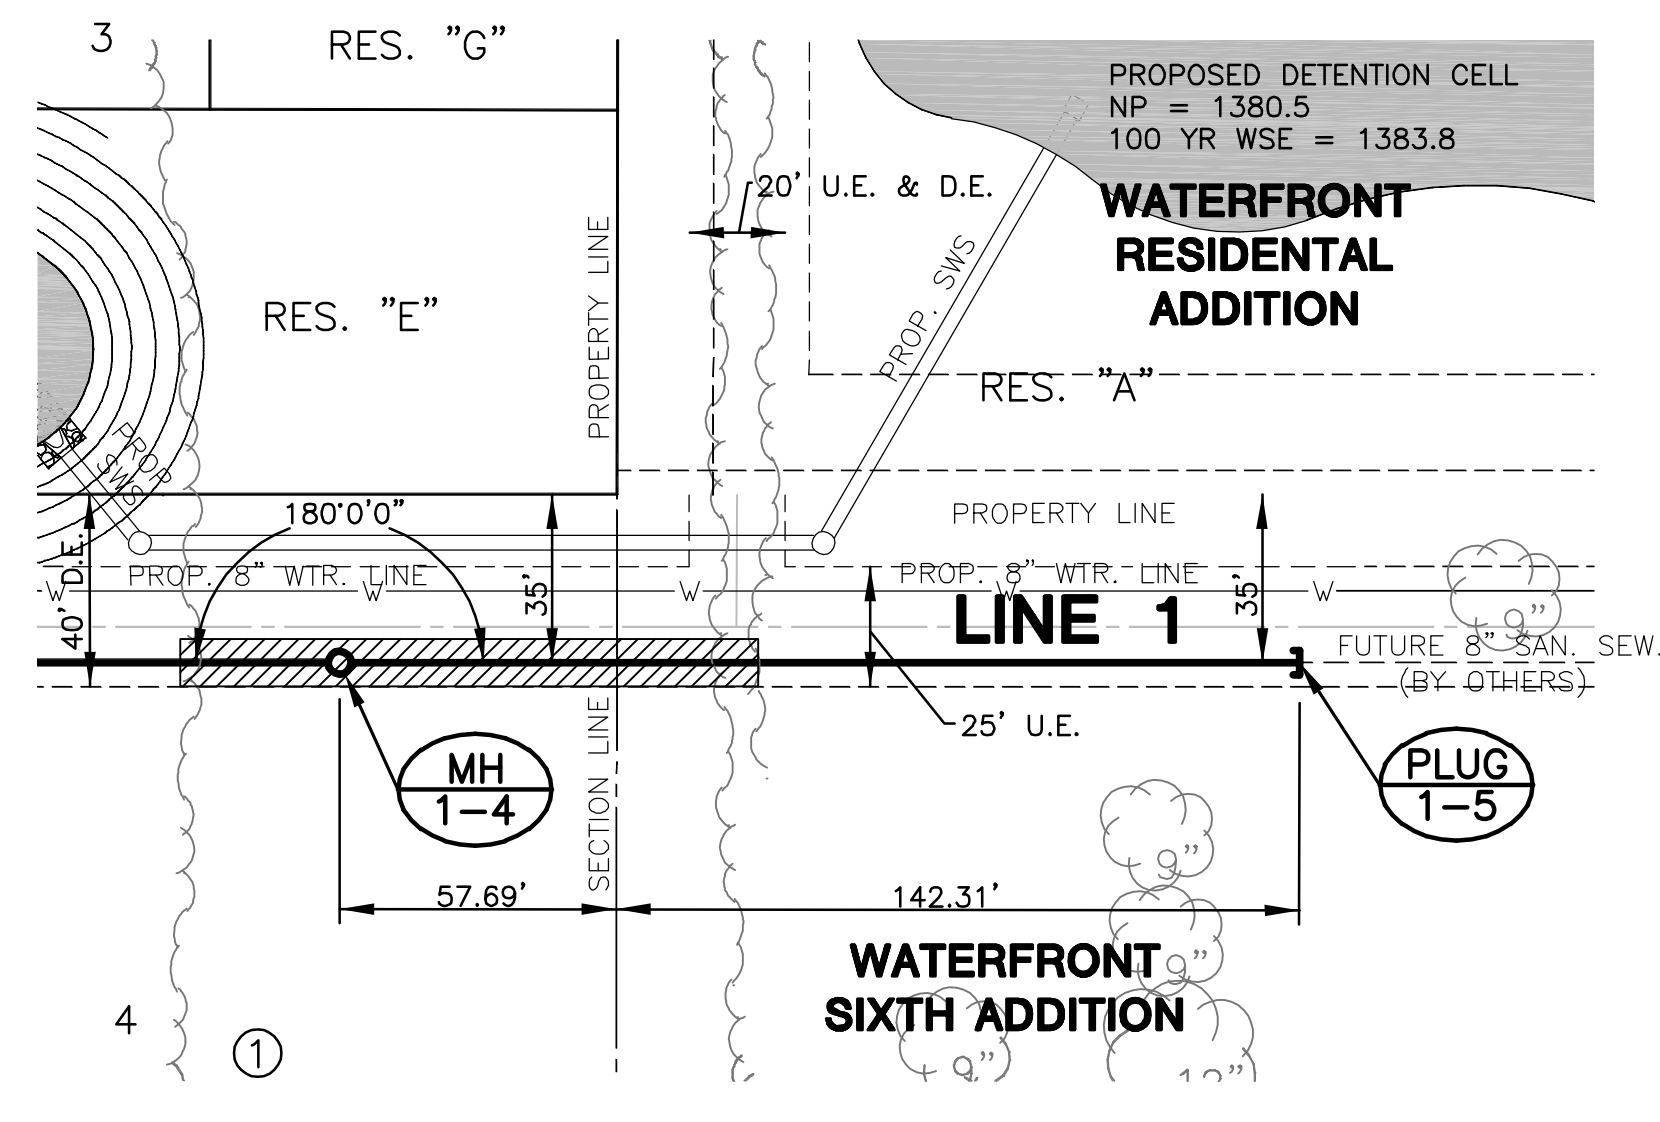



**SANITARY SEWER PLANS FOR  
WATERFRONT SIXTH ADDITION  
PHASE 1**

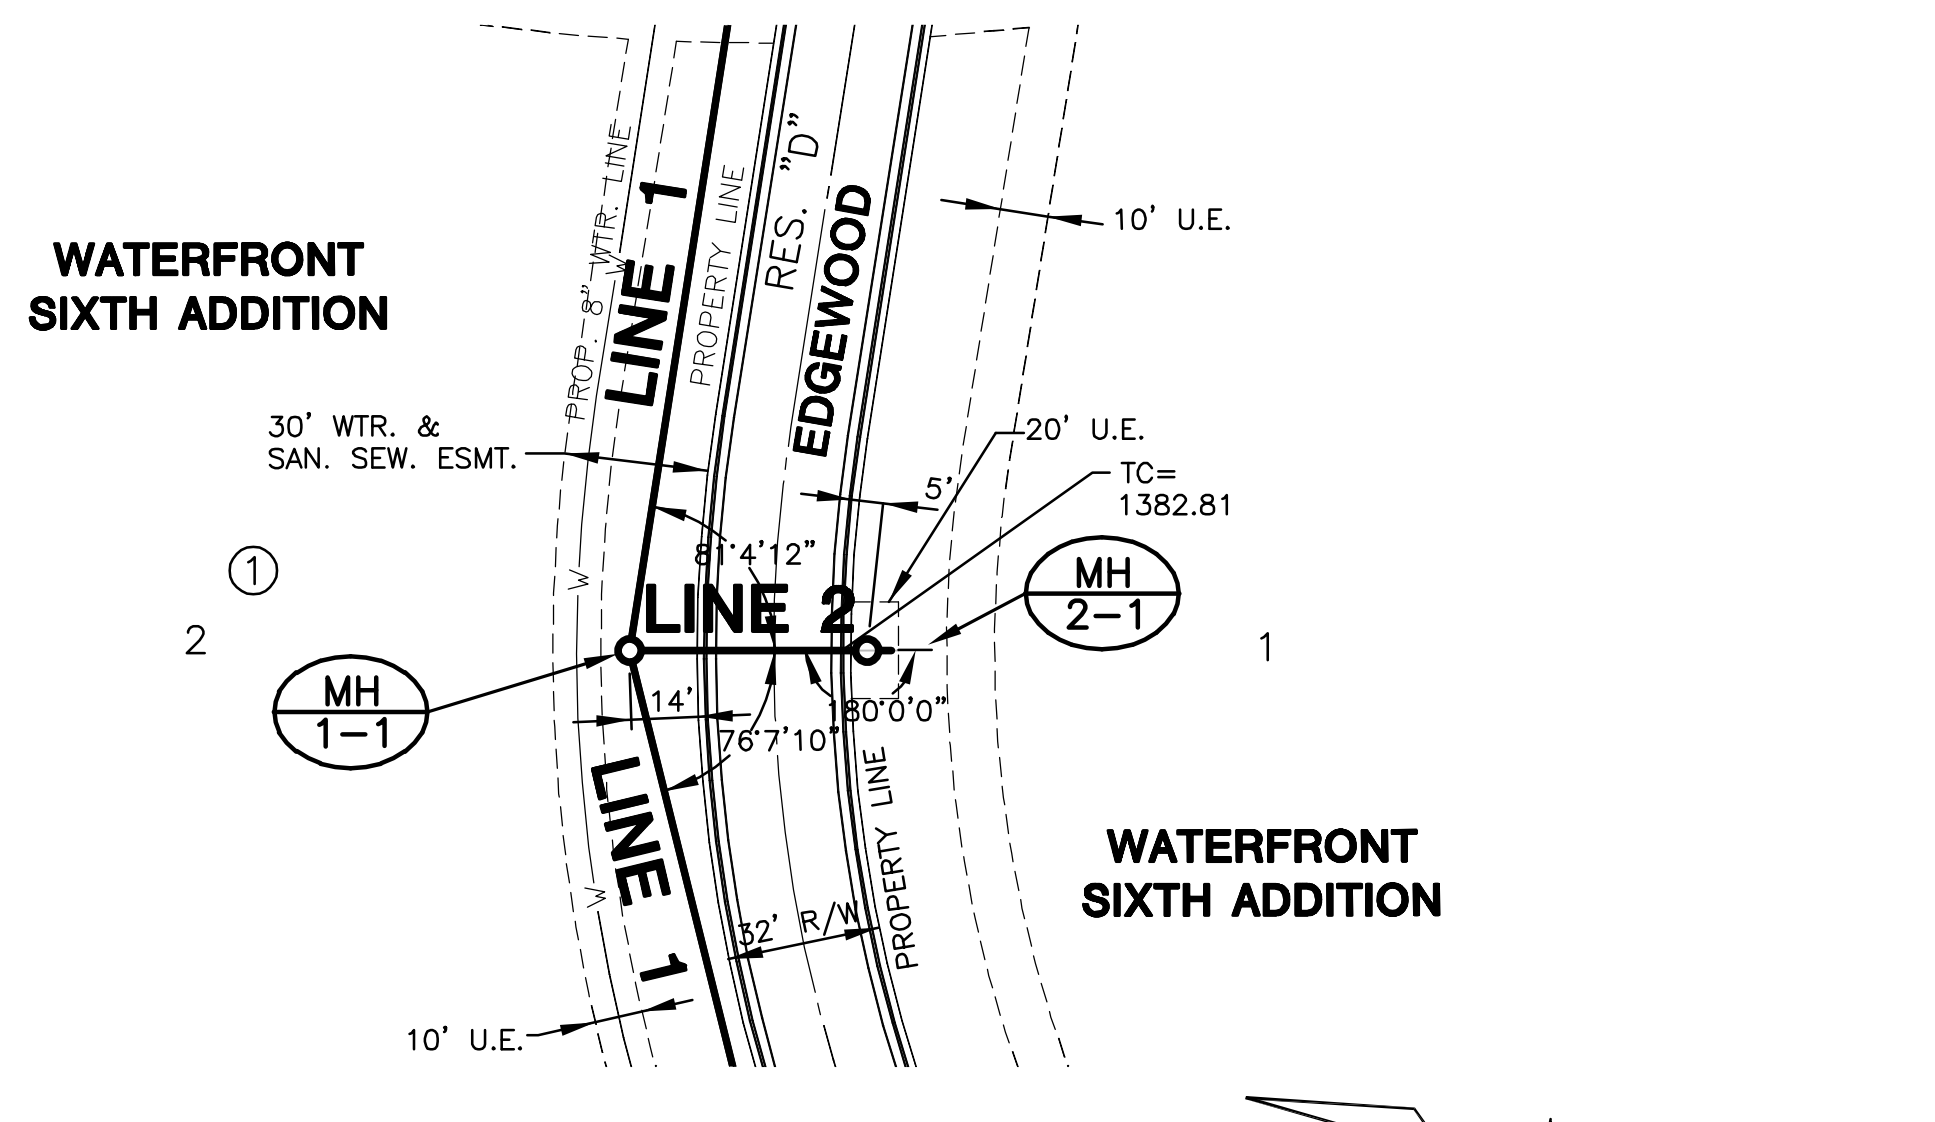

**PLAN LINE 1**

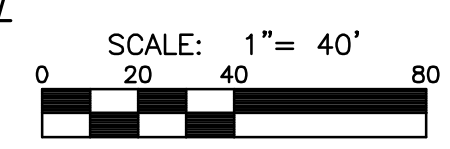

**PLAN LINE 2**

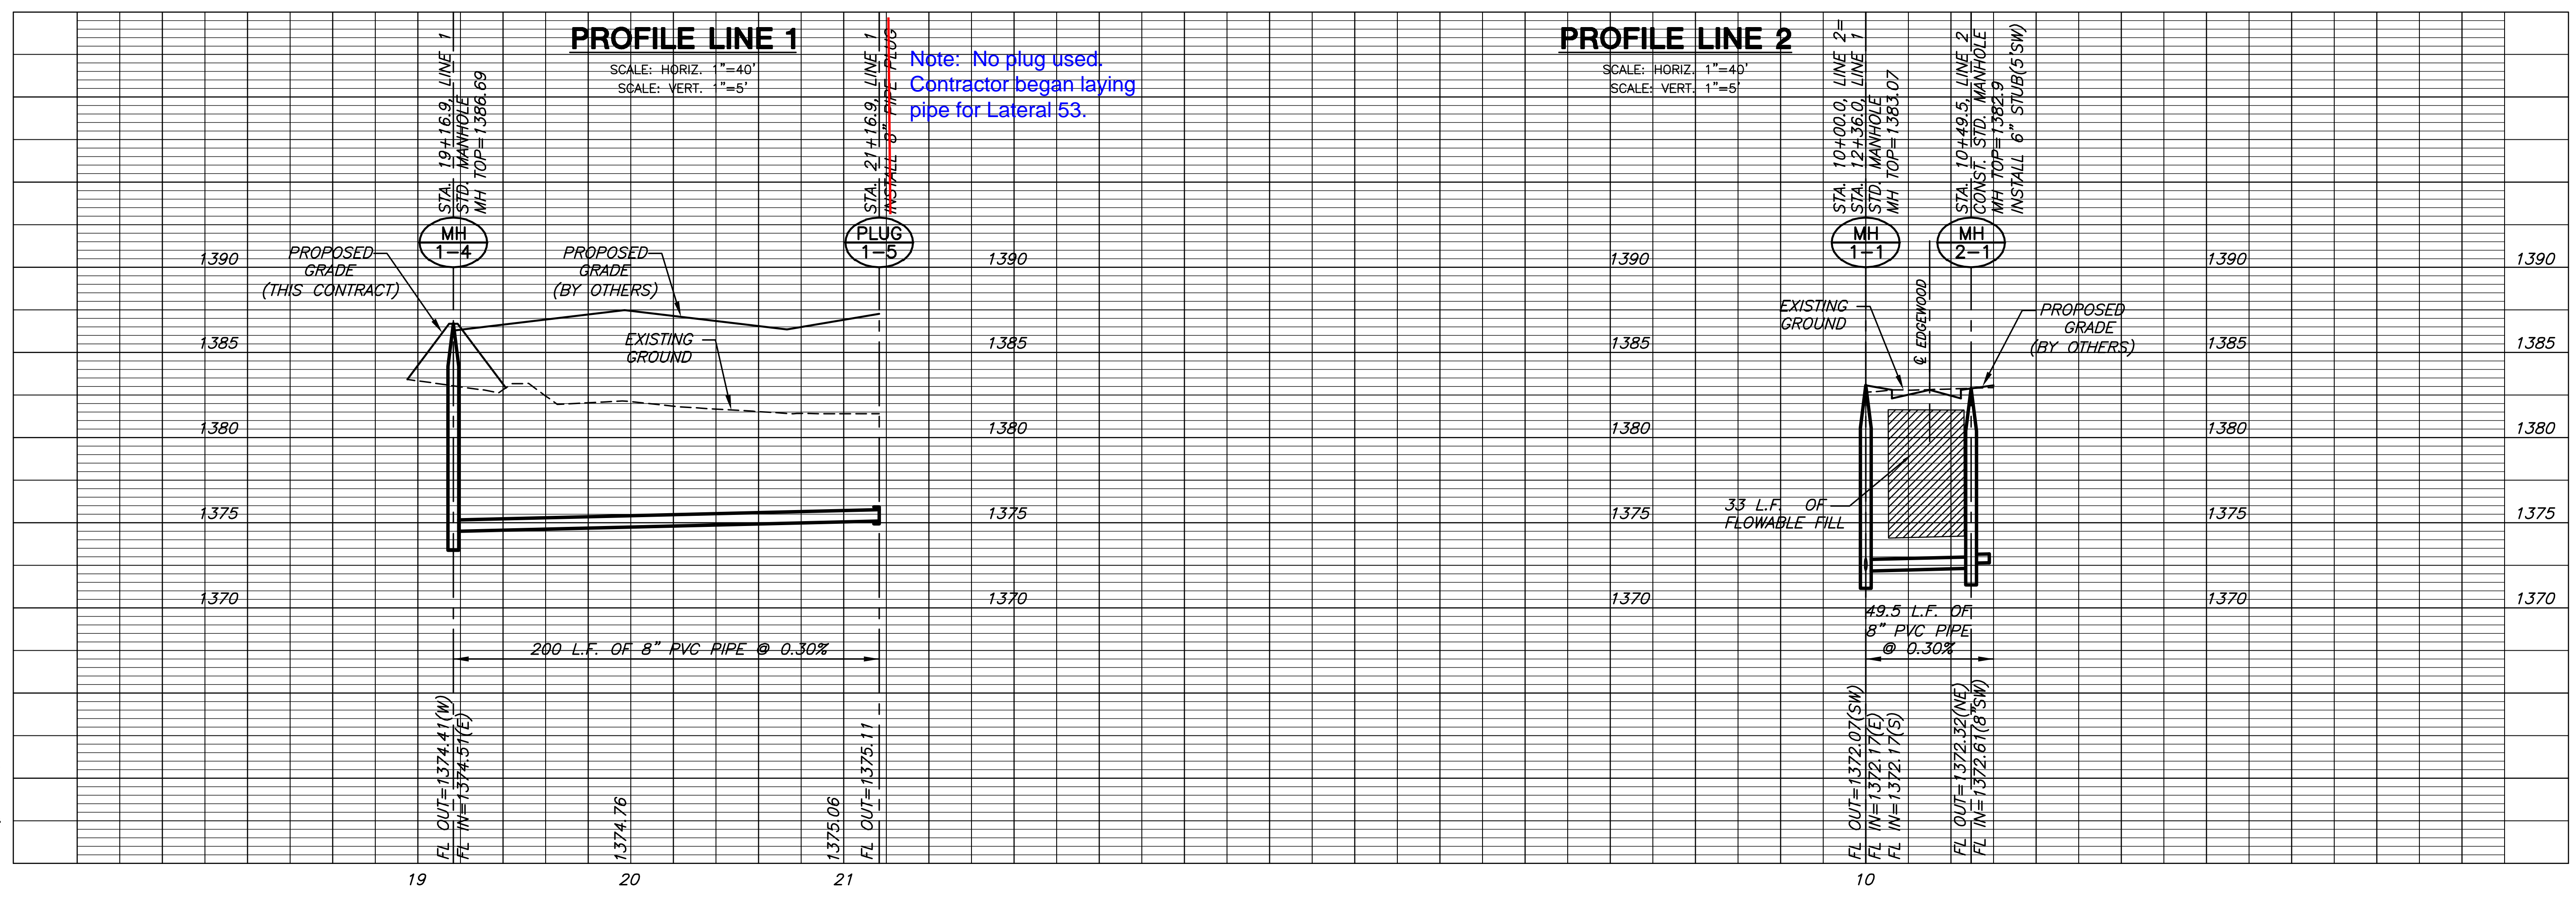

**LINE 1&2  
PLAN &  
PROFILE**  
SHEET TITLE  
468-84427  
PROJECT NUMBER

DESIGN BY: SRS  
DRAWN BY: MKEC  
CHECKED BY: DFL

ISSUED: OCTOBER 2007  
REVISED:

SHEET NO.  
**4 of 11**

PLOTED: Wednesday, October 24, 2007 @ 10:32AM

J:\CIVIL\06266\DWG\SAN\6TH\_ADDITION\PHASE1\06266B2.DWG