

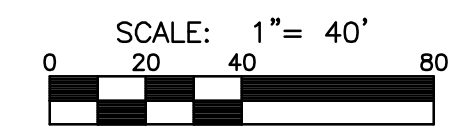


**SANITARY SEWER PLANS FOR  
THE WATERFRONT RESIDENTIAL ADD.**

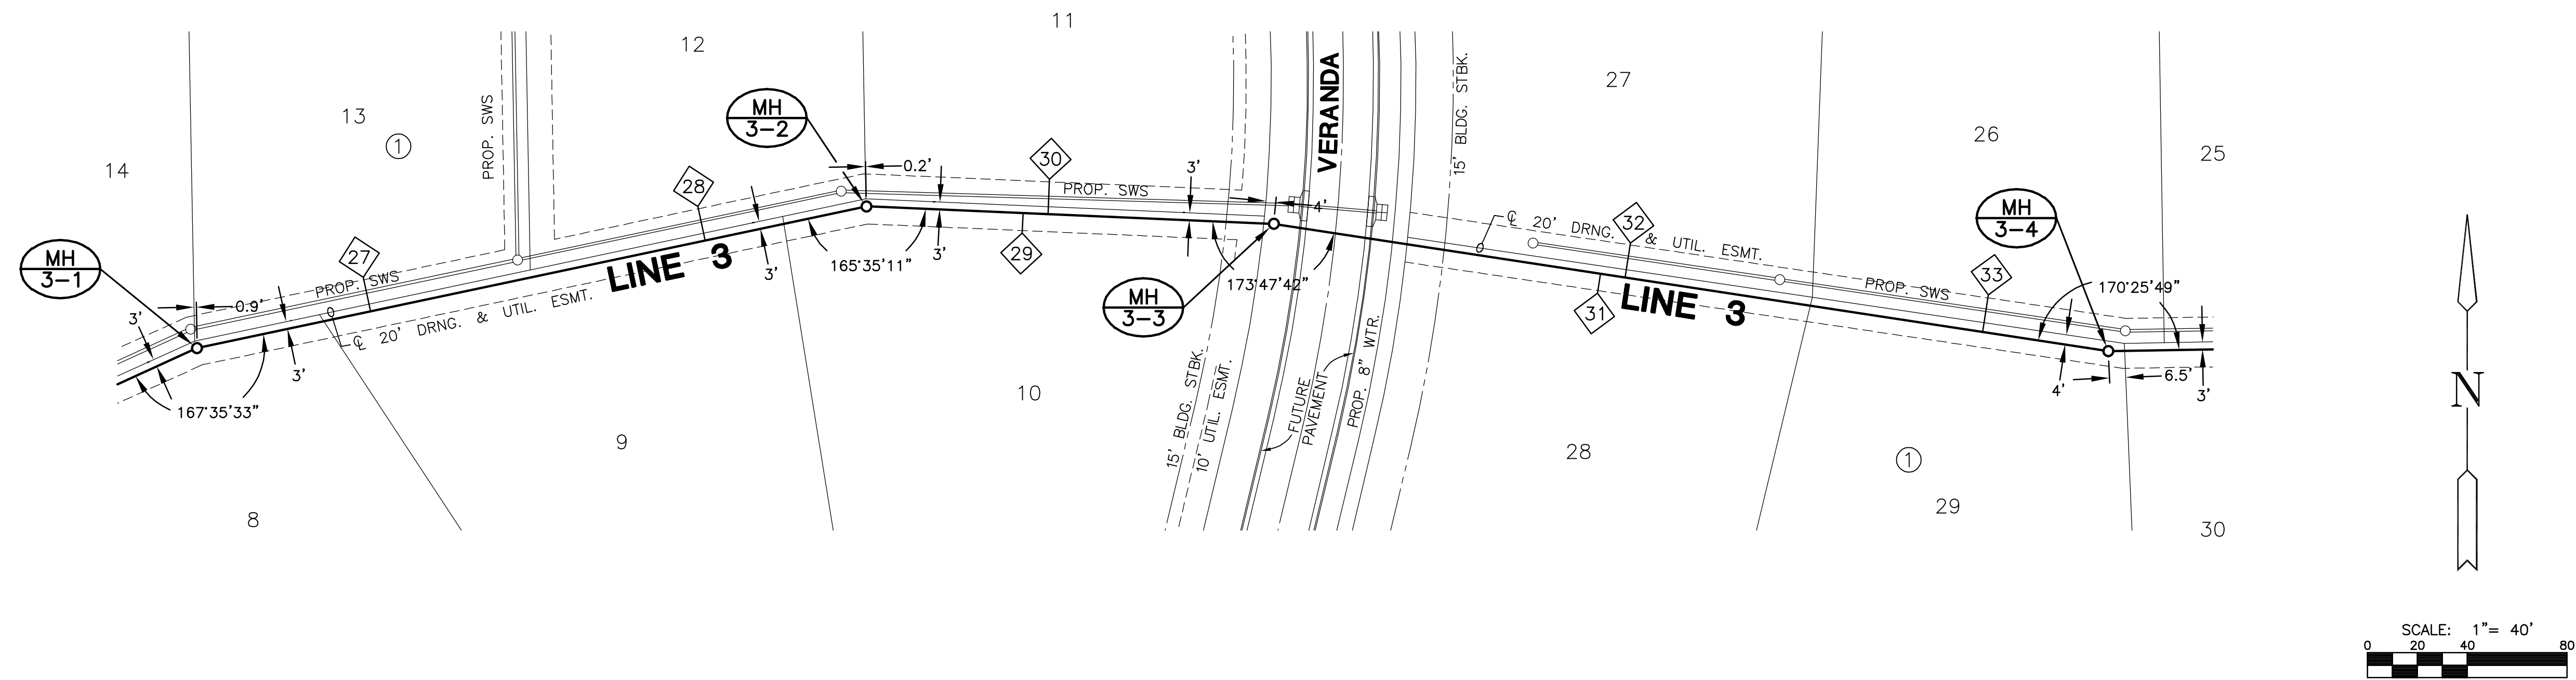

**PLAN LINE 3**

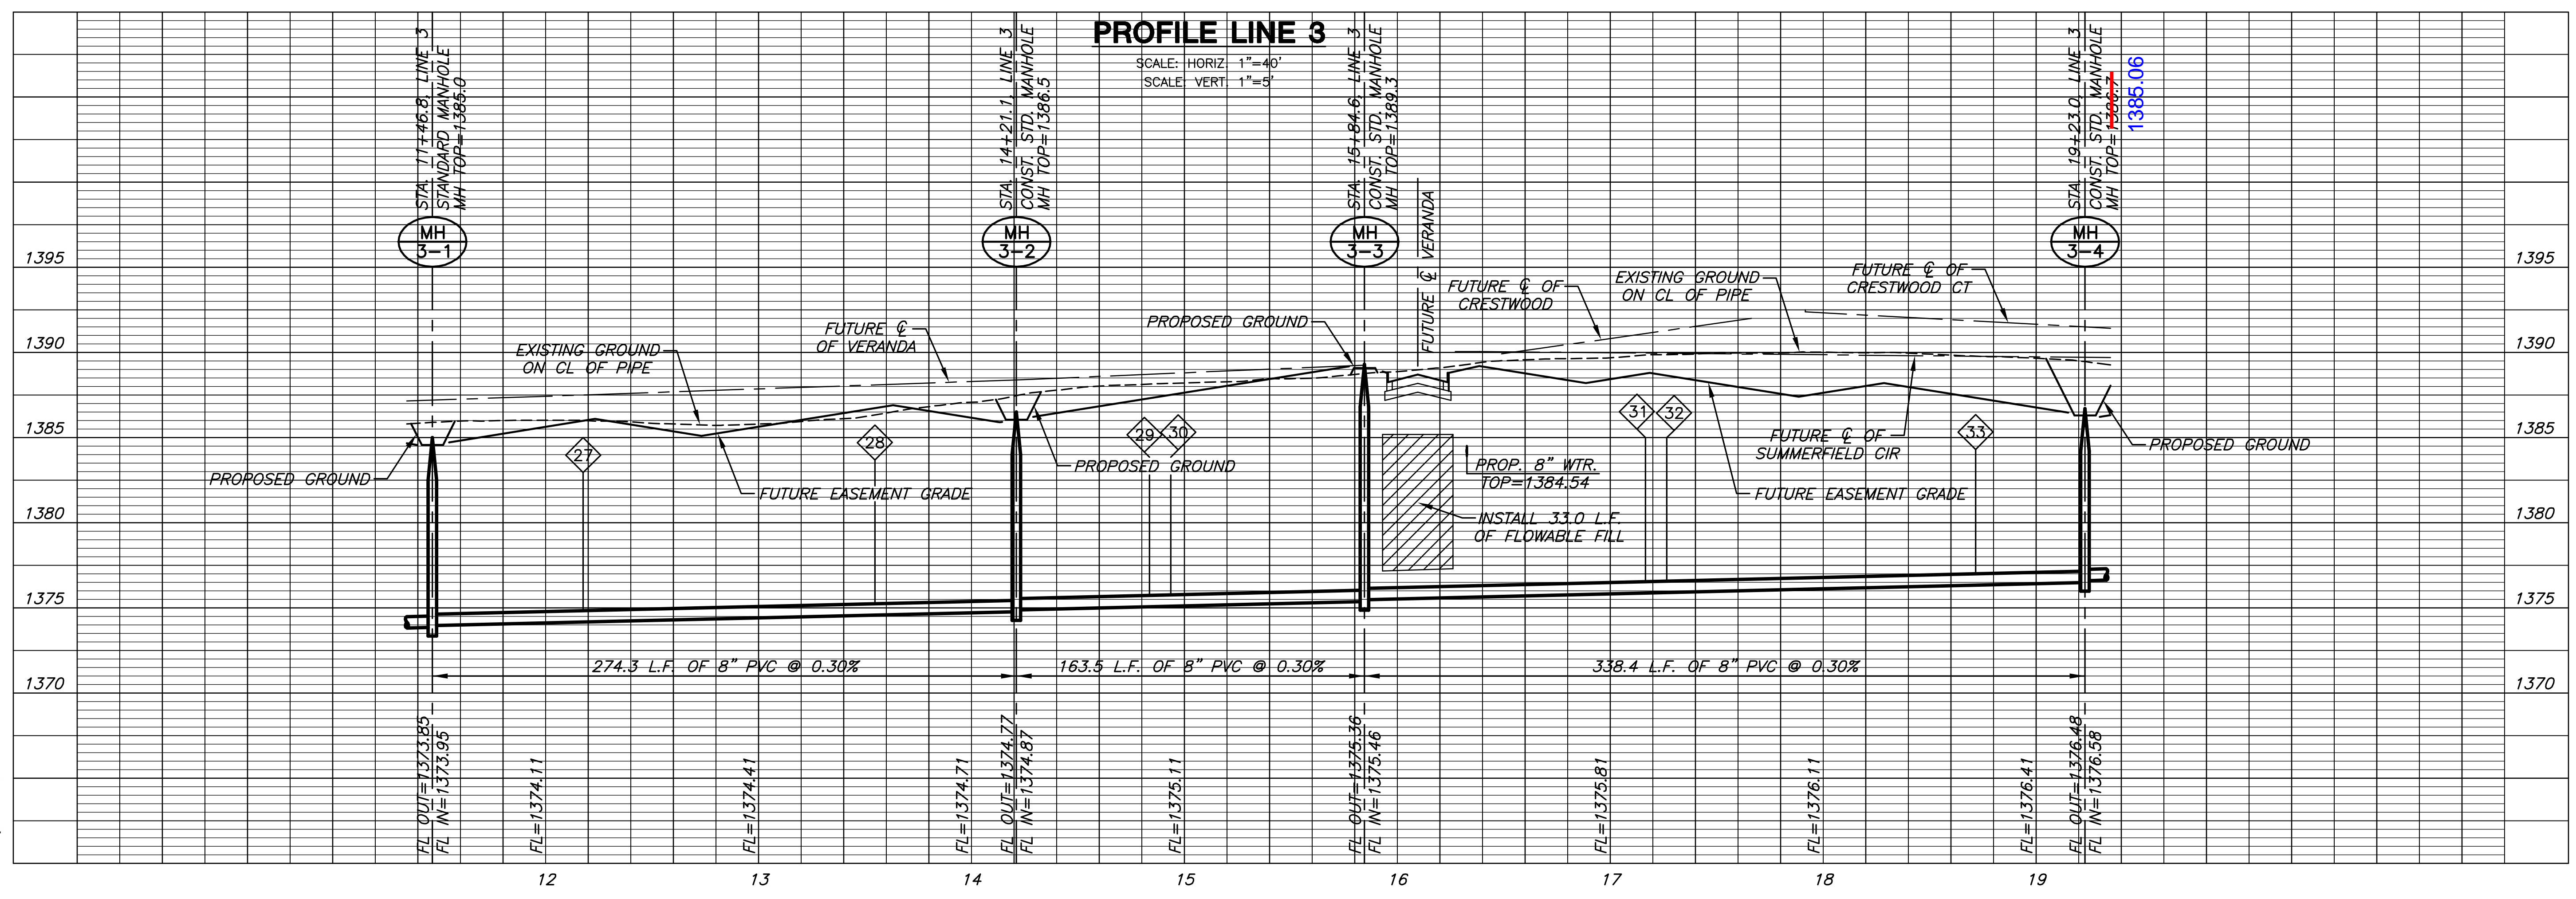

PLOTED: Tuesday, October 30, 2007 @ 04:46PM

J:\CIVIL\06266\WVA\SAN\RESIDENTIAL\06266\_B6.DWG

**LINE 3**  
SHEET TITLE  
468-84422  
PROJECT NUMBER

DFL  
DESIGN BY  
DMU  
DRAWN BY  
GJA  
CHECKED BY

ISSUED  
October 2007  
REVISED

SHEET NO.  
**10 of 20**