


SCALES:
 1" = 20' HOR
 1" = 5' VER

LEGEND
 SW = SIDEWALK
 UGE = UNDERGROUND ELECTRIC
 SWS = STORM SEWER WATER
 (c) = CALCULATED ELEVATION

- NOTE:
1. ALL DATUM IS USGS.
USGS DATUM - 1187.4 = CITY DATUM
 2. BENCH MARK NO.1 = C.O.W. BENCH MARK.
TOP OF HUBGUARD, NORTHWEST CORNER OF BRIDGE
AT MAIZE ROAD & SECOND ST. ELEV. = 1328.66
BENCH MARK NO.2 = CHISELLED CROSS, NORTH SIDE
OF RIM OF STORM WATER SEWER MANHOLE LOCATED
158 FEET SOUTH OF THE CENTERLINE OF MAIZE CT.
AND 5' WEST OF THE WEST CURB LINE OF MAIZE RD.
ELEV. 1322.09
 3. PIPE SHALL BE GROUTED TO MANHOLE
WALLS USING WATER-TIGHT GROUT.
 4. CONTRACTOR SHALL SHAPE FLOOR OF MANHOLE
PER DETAIL, SHEET 3.

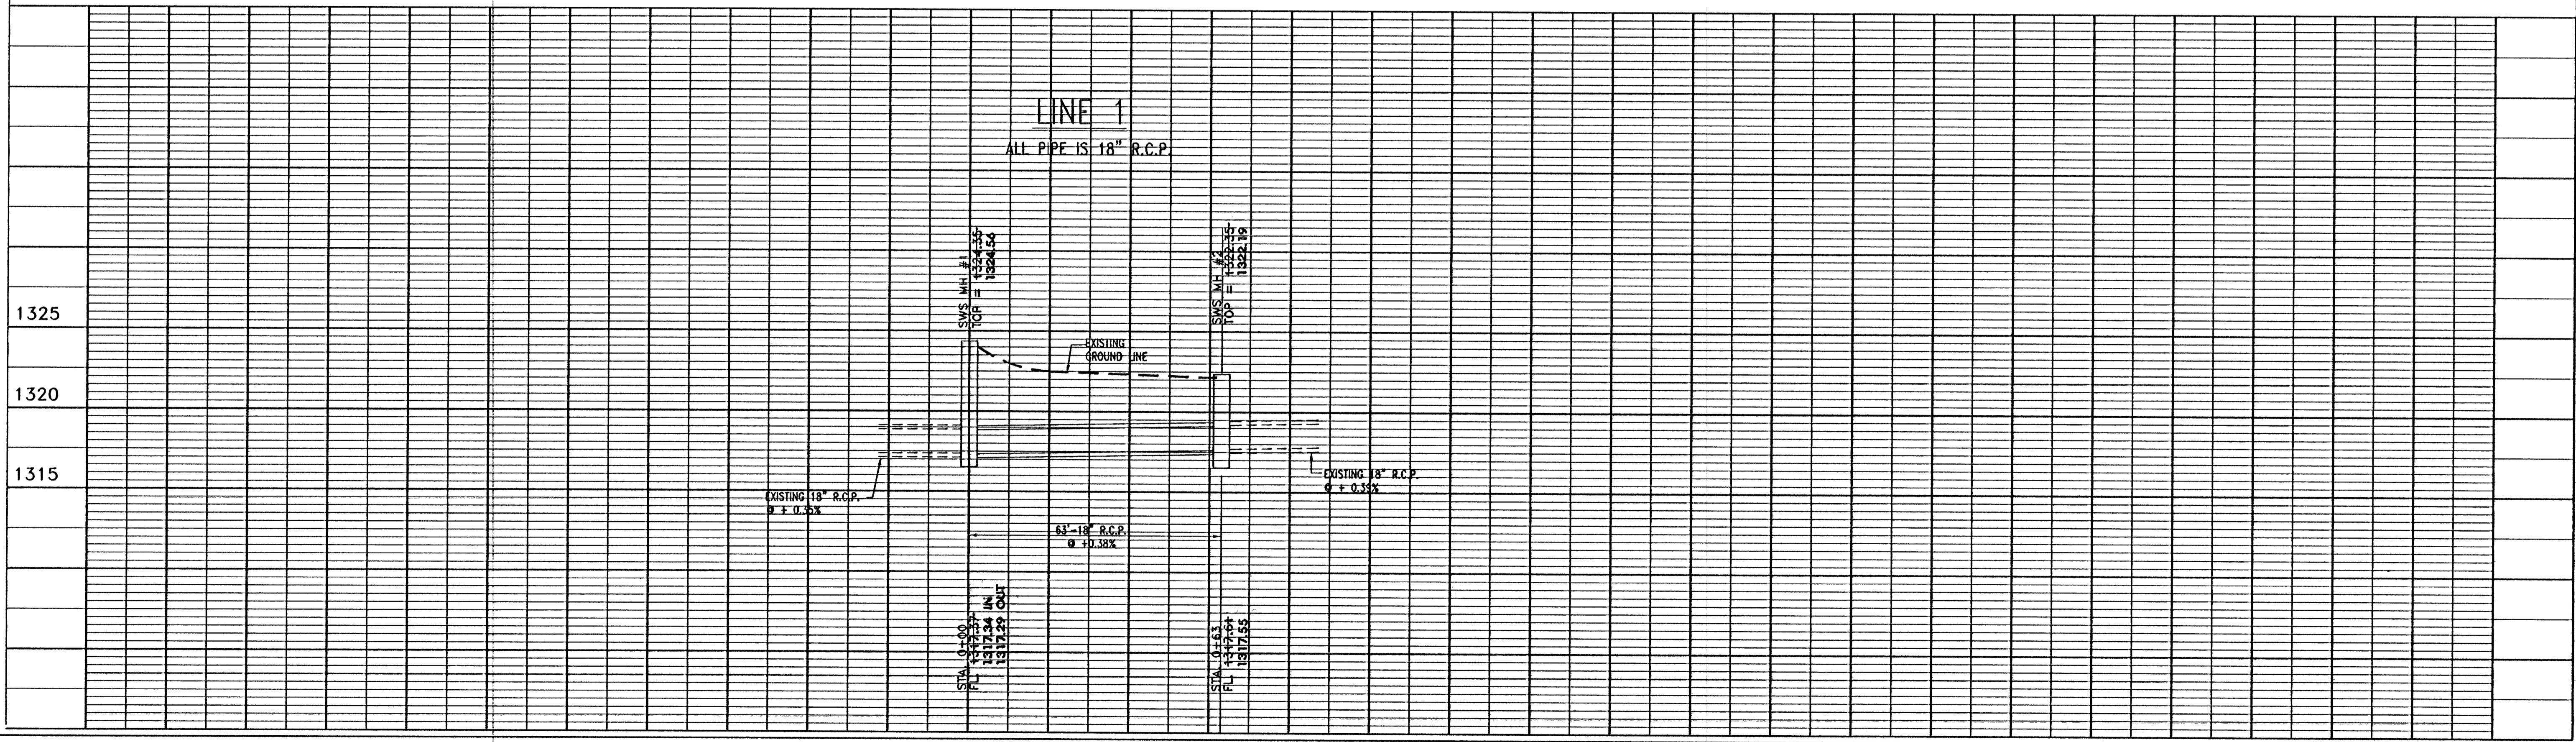

AS-BUILT 7-31-2007

REISS & GOODNESS ENGINEERS
 2100 WEST 21st STREET
 WICHITA, KANSAS 67203
 (316) 832-0213

REVISION	DIRECTORY	DRAWN BY	FILE NAME	CHECKED BY	DESIGNED BY
	ROB/MISC/TREEHOUSE	C.E.	LEARNING_CTR	LEARNING CENTER	R.P.

STORM WATER SEWER REPLACEMENT

CUSTOMER LOTS 1 & 2, PARK WEST PLAZA ADDITION, WICHITA, KANSAS

SCALE: NOTED	PROJECT NO. S10508
DATE: 12/18/06	SHEET: 2 OF 7