



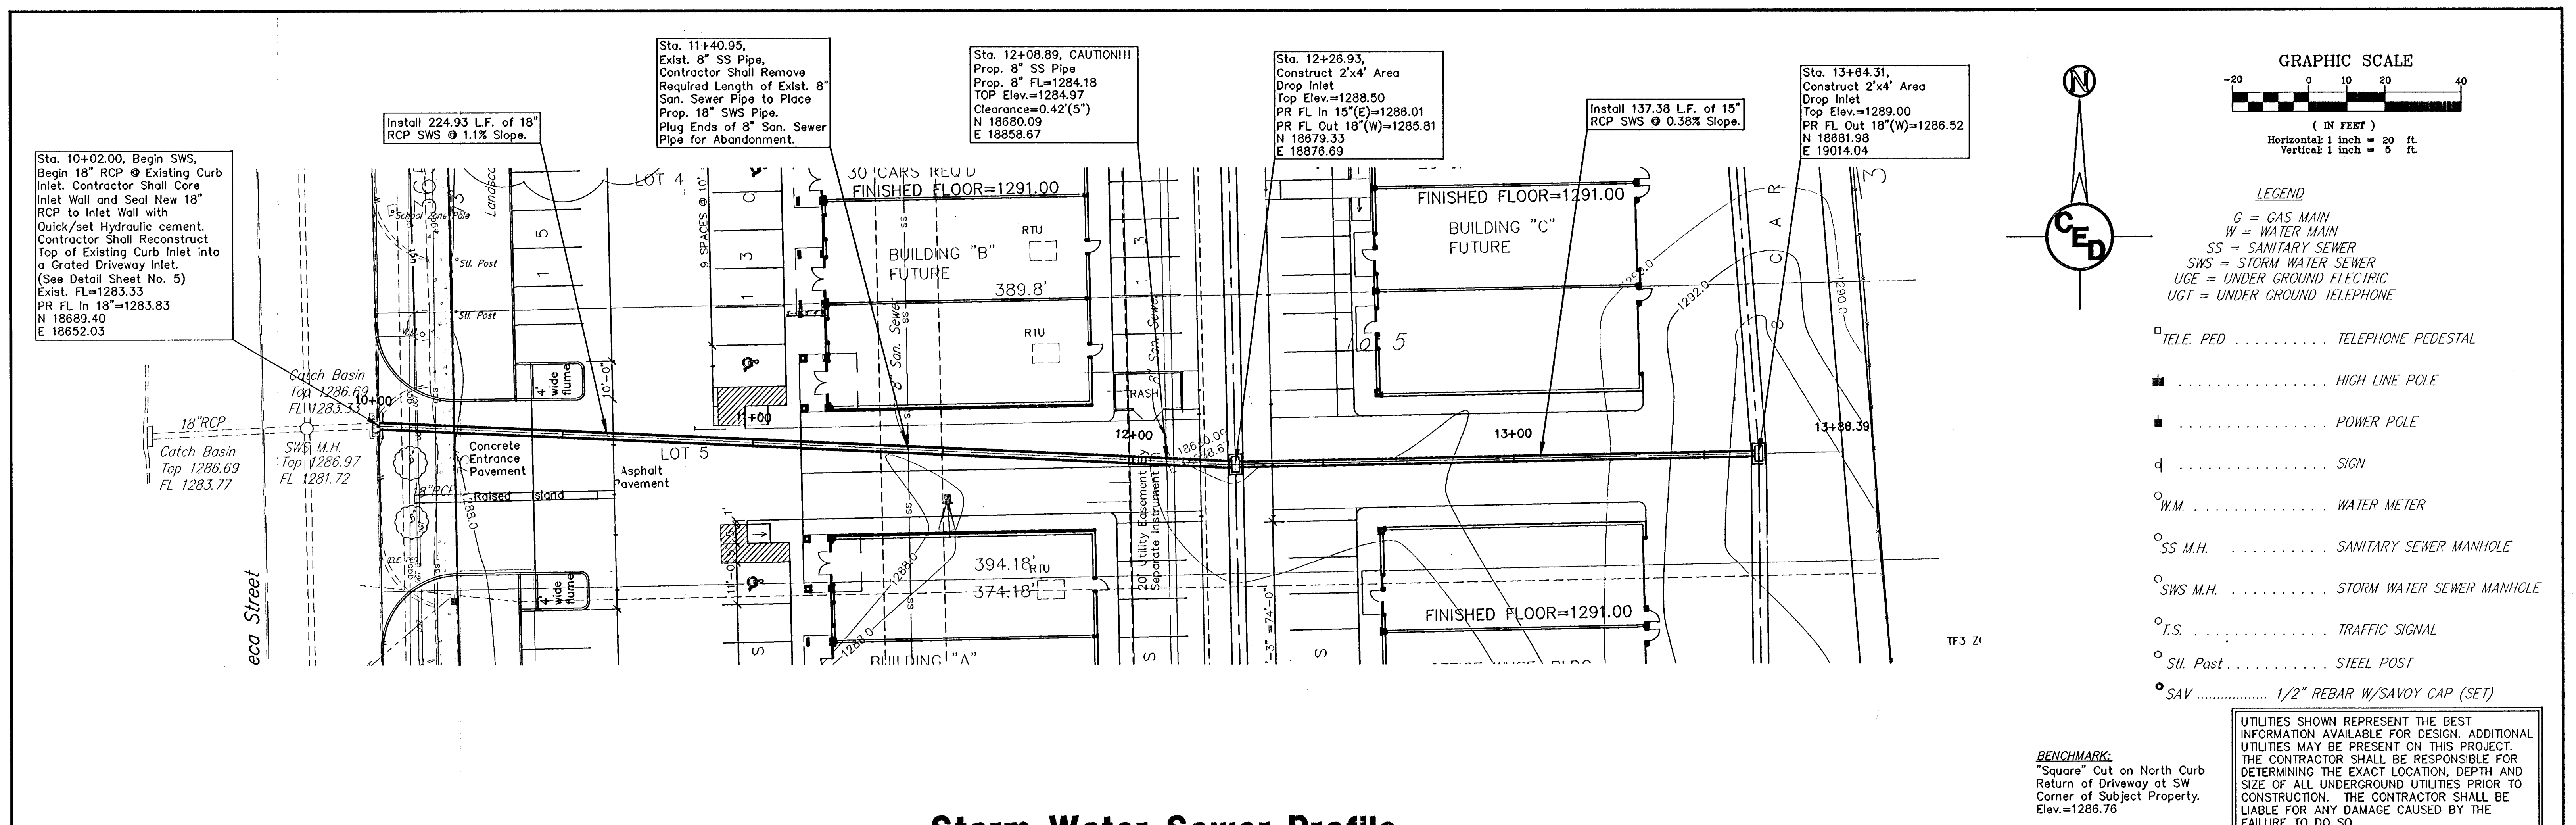

Storm Water Sewer Profile

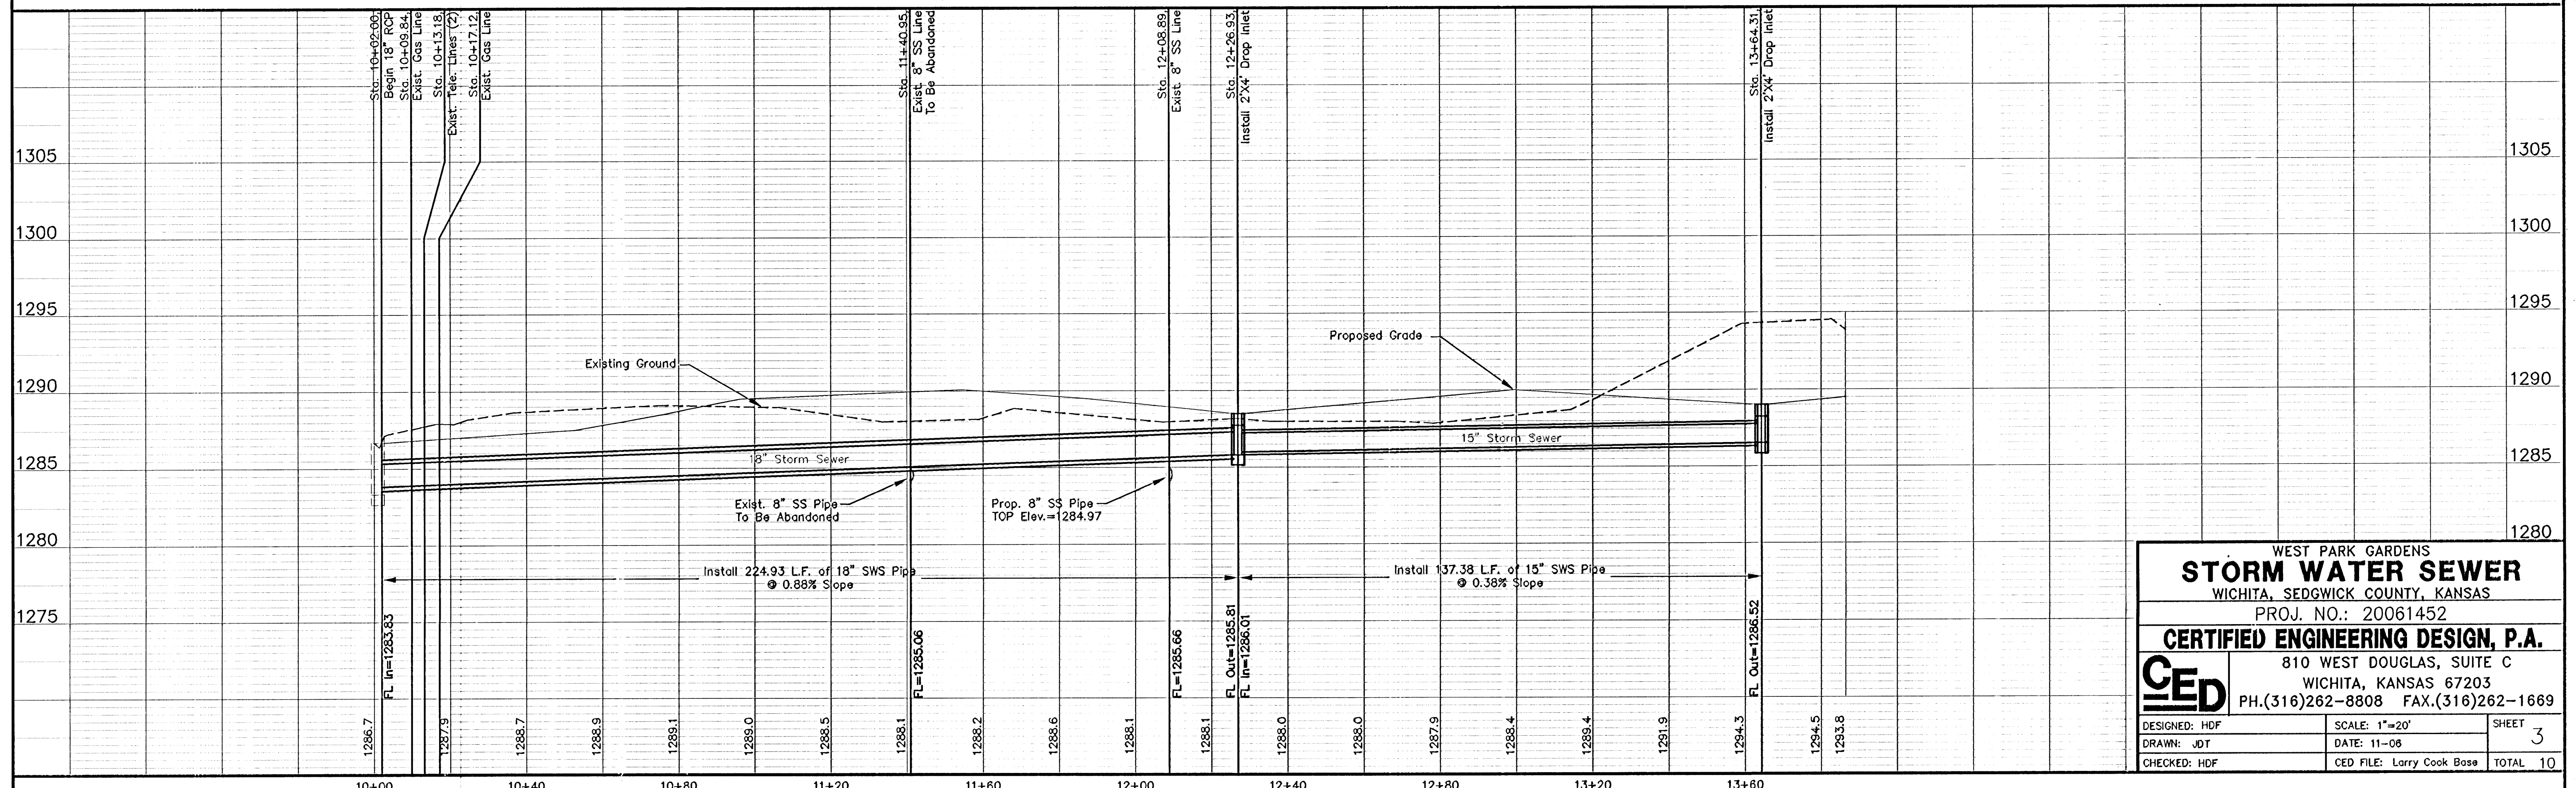

WEST PARK GARDENS		
STORM WATER SEWER		
WICHITA, SEDGWICK COUNTY, KANSAS		
PROJ. NO.: 20061452		
CERTIFIED ENGINEERING DESIGN, P.A.		
810 WEST DOUGLAS, SUITE C		
WICHITA, KANSAS 67203		
PH.(316)262-8808 FAX.(316)262-1669		
DESIGNED: HOF	SCALE: 1"=20'	SHEET 3
DRAWN: JOT	DATE: 11-06	
CHECKED: HOF	CEI FILE: Larry Cook Base	TOTAL 10

AS-BUILT 9-14-07
T.H.-CED