

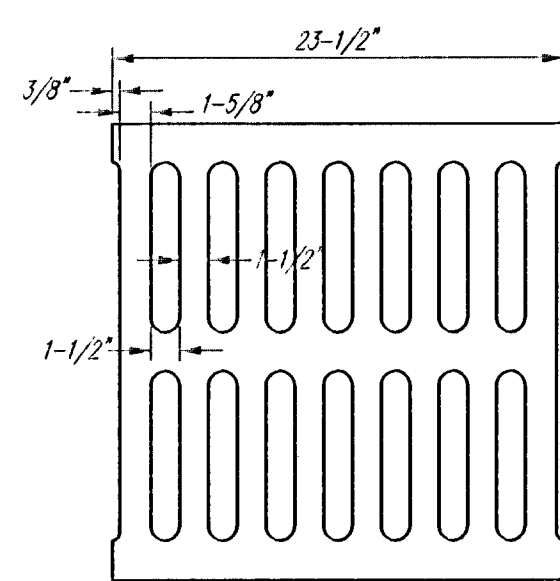


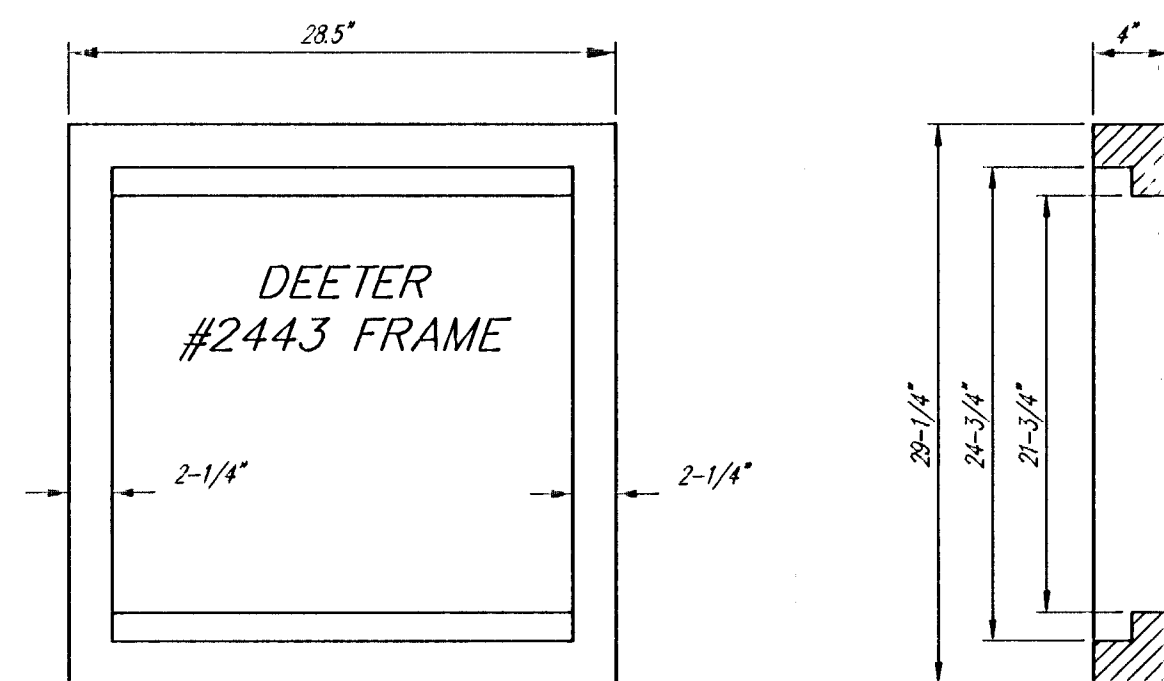




DEETER #2433 GRATE

24" x 24" Frame and Grate Detail



NOTE: Grates shall be imprinted on the top surface with "CITY OF WICHITA" using letters at least 1" in height. Other marking methods may be approved by the engineer.

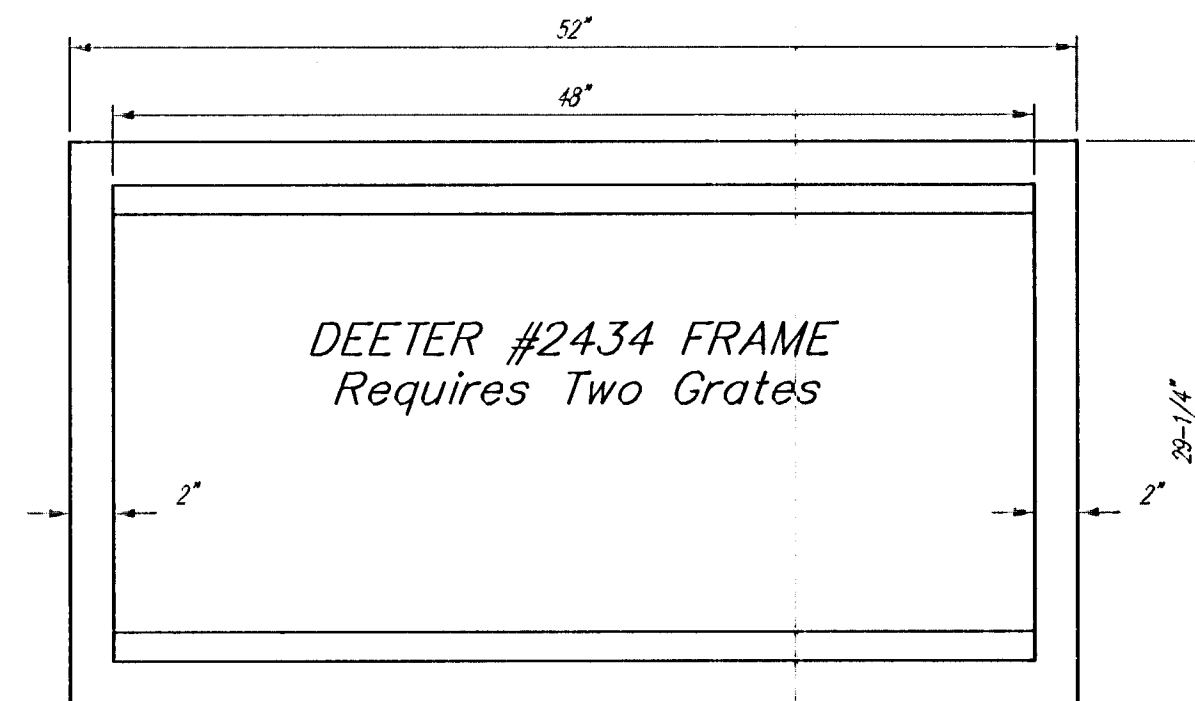

Double 24" x 24" Frame Detail

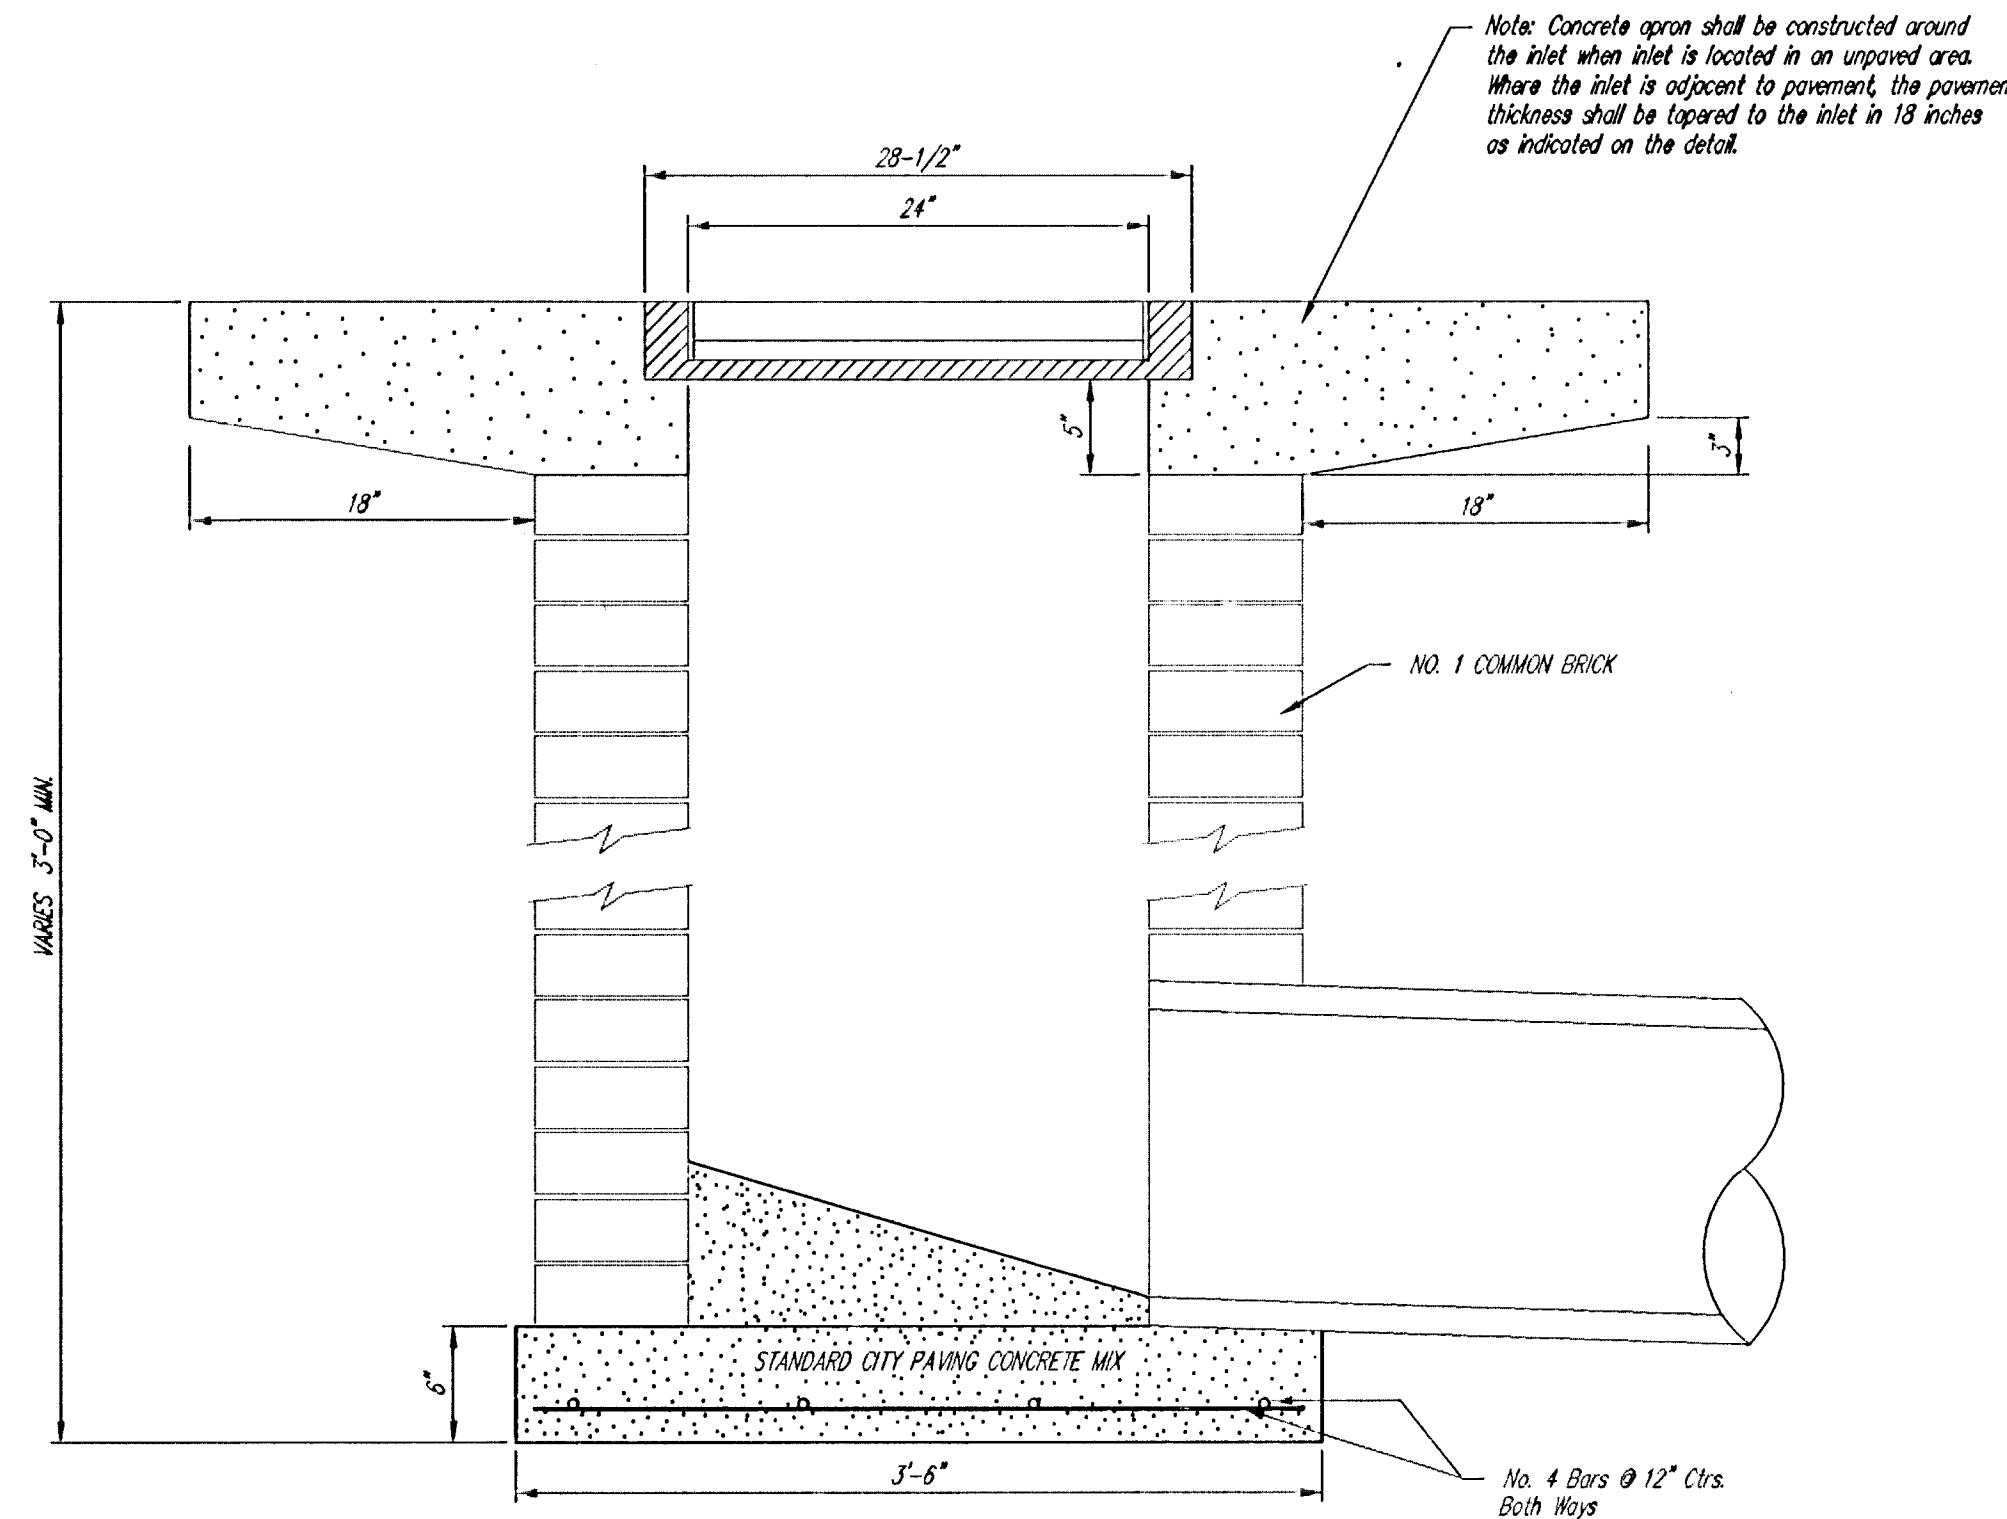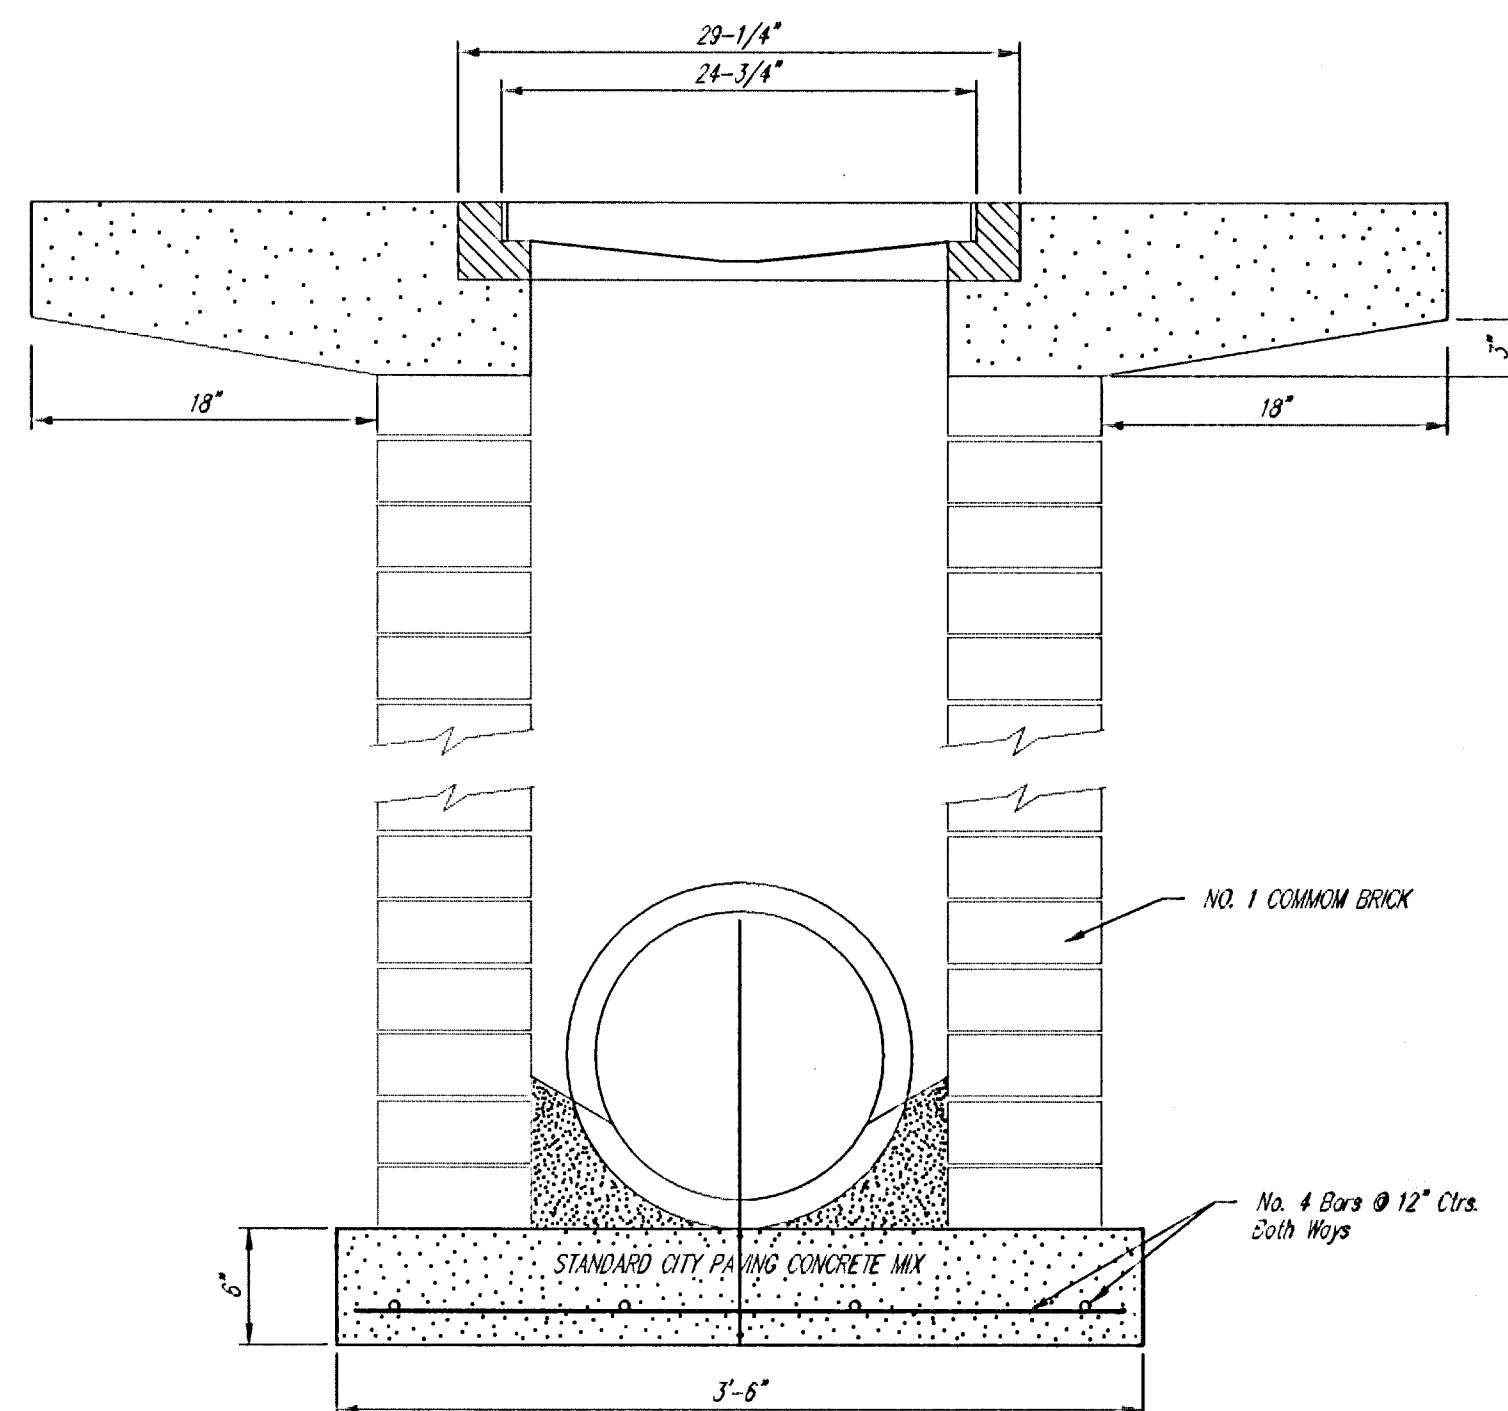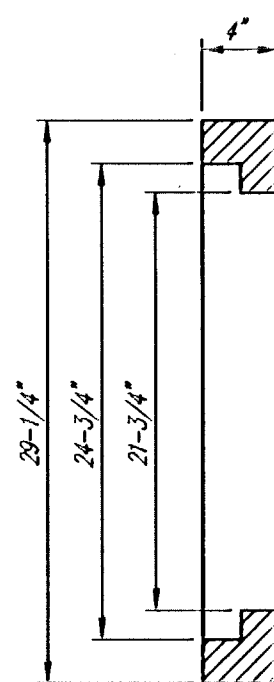

Note: Concrete apron shall be constructed around the inlet when inlet is located in an unopened area. Where the inlet is adjacent to pavement, the pavement thickness shall be tapered to the inlet in 18 inches as indicated on the detail.

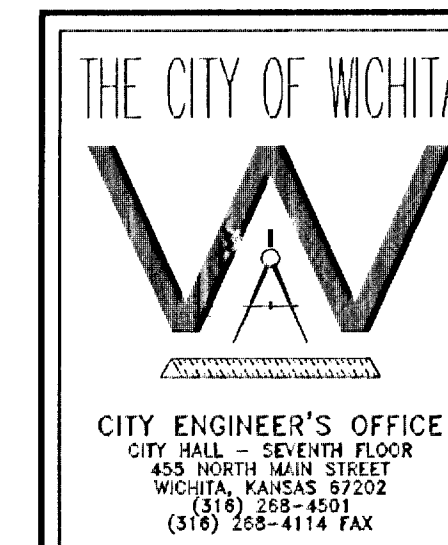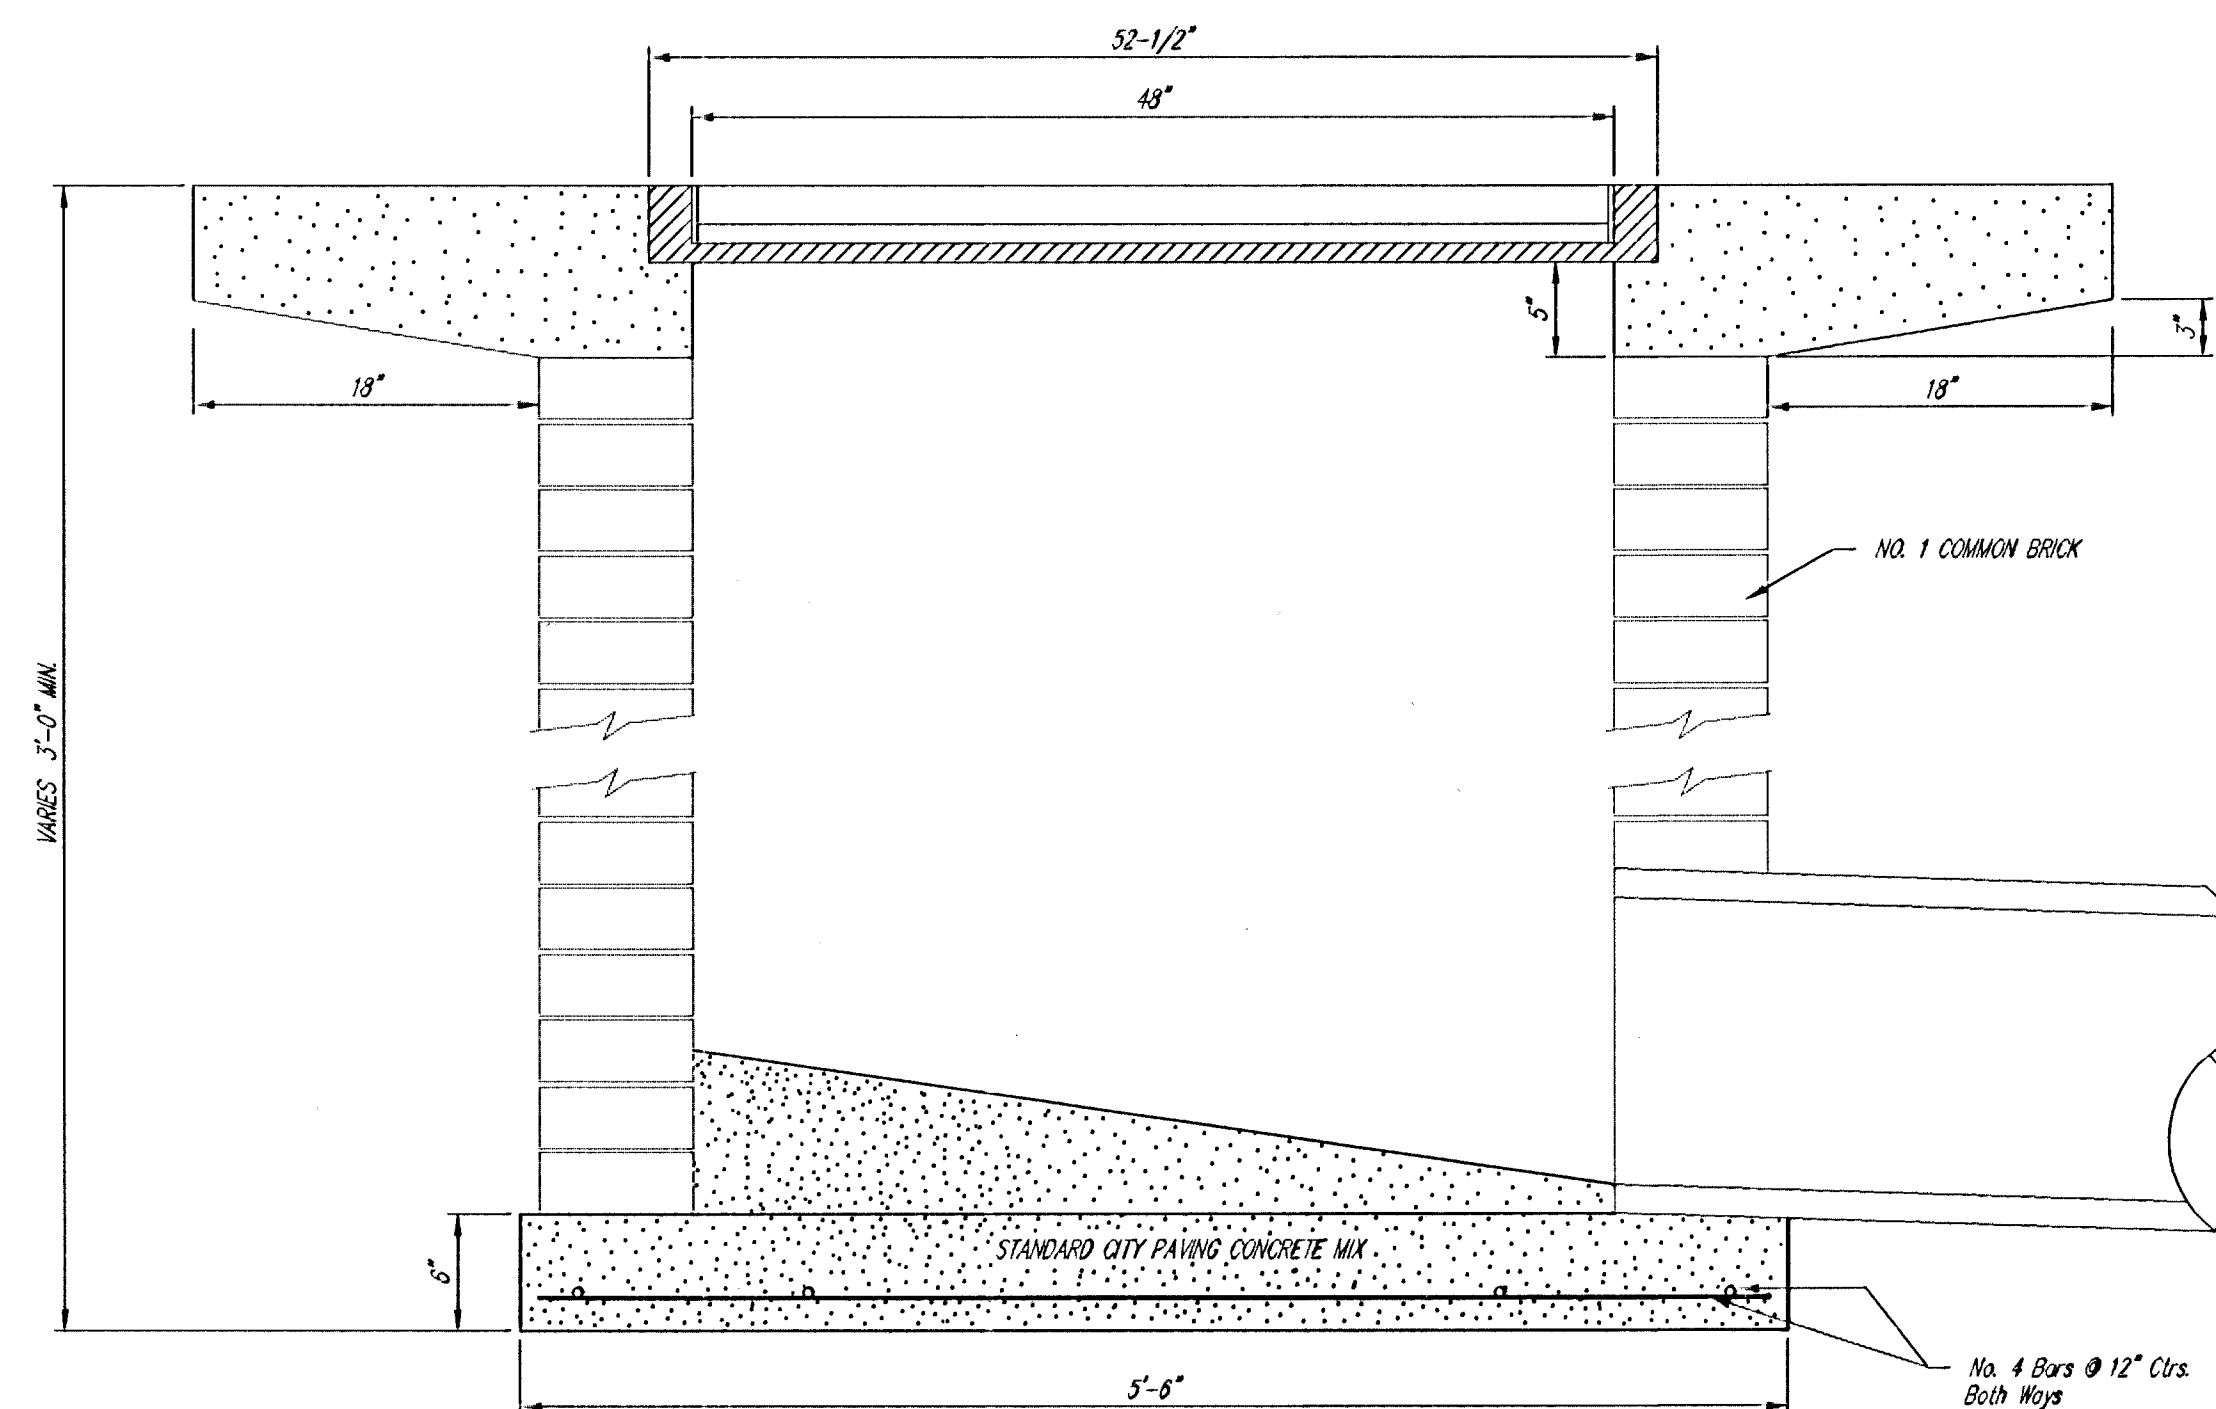

DROP INLET 2' X 2' / 2' X 4'	
M. E. LINDEBAK P.E. - CITY ENGINEER	
PROJECT NUMBER 1744 PPS	INDEX CODE 607861
DATE MAR 96	SHEET 4 OF 10

AS-BUILT 9-14-07
T.N.-C&D