


NOTE:
CONTRACTOR TO VERIFY
LOCATION AND ELEVATION OF
EXIST. 8\"/>

PLAN LINE 2

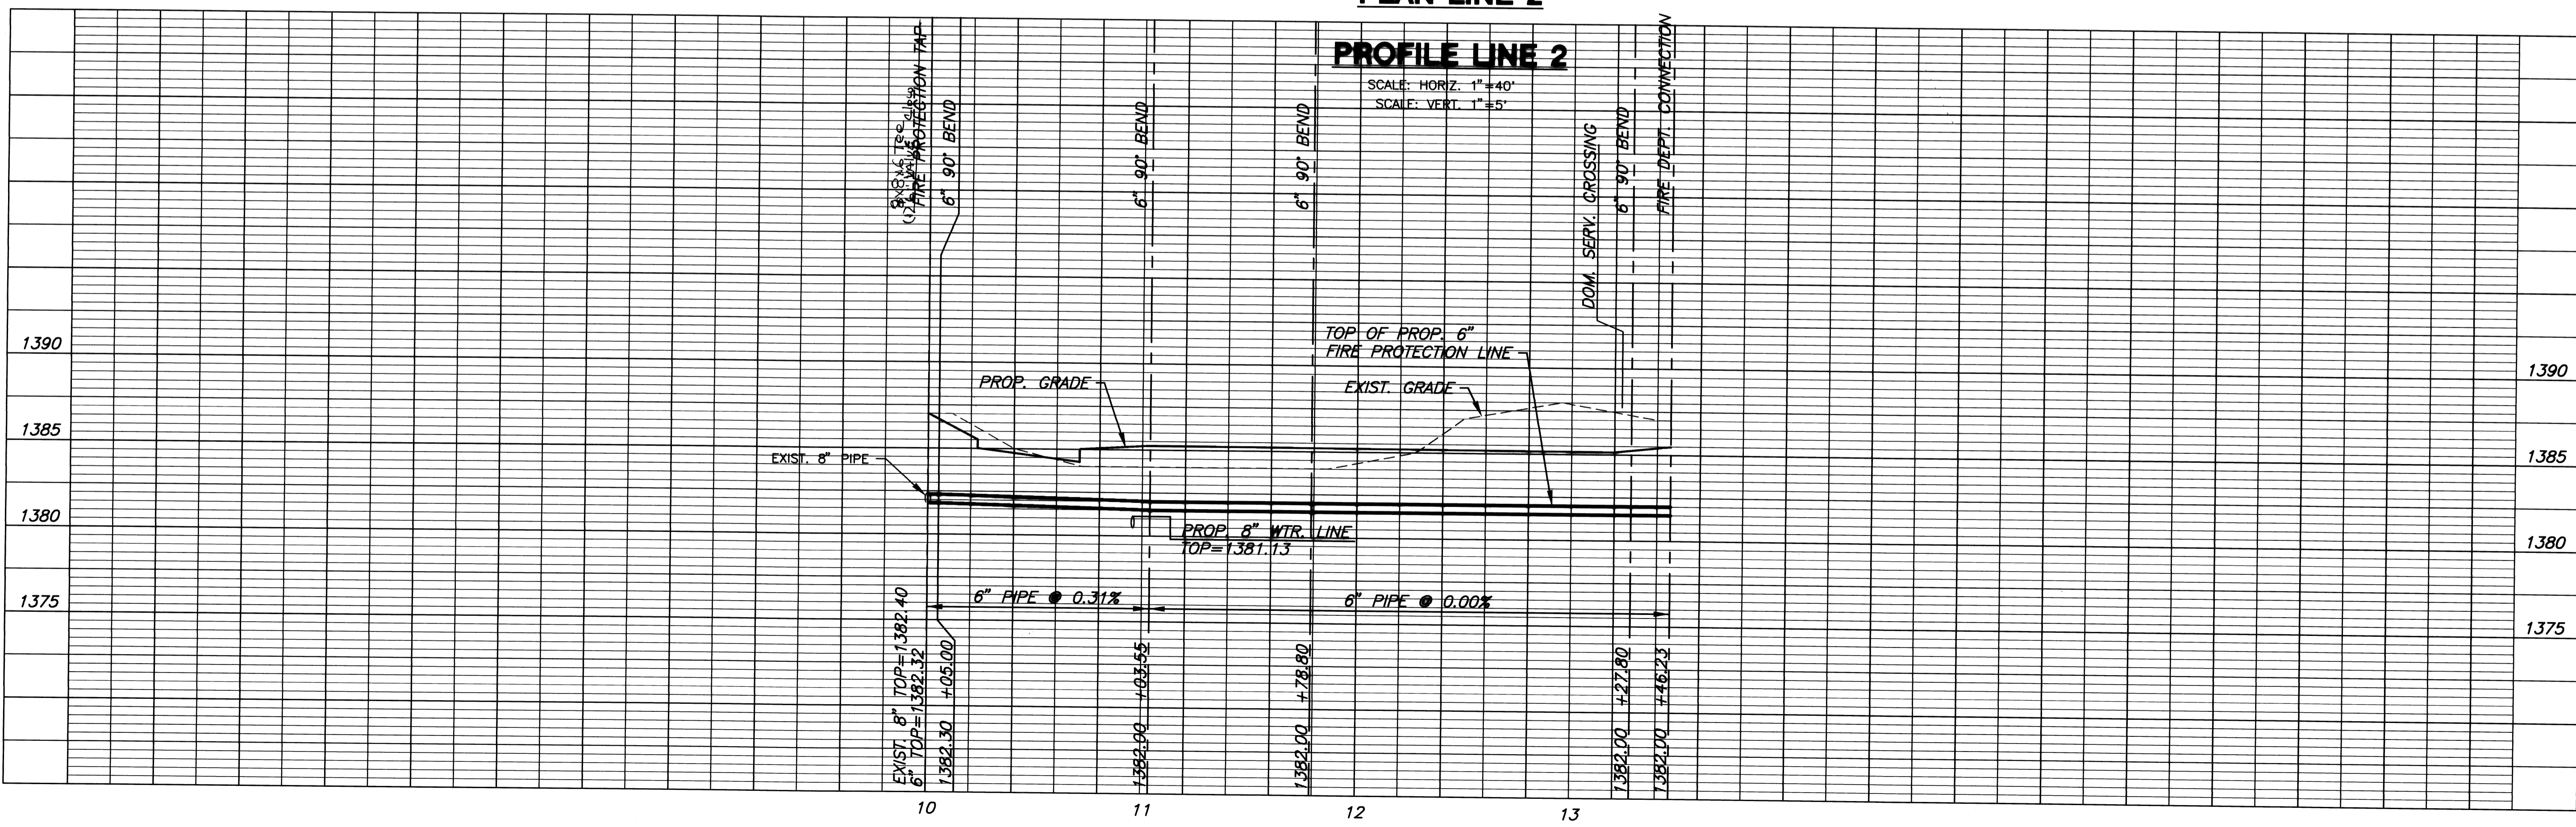

**PRIVATE WATER
LINE 2**
SHEET TITLE
07704
PROJECT NUMBER

DESIGN BY: SRS
DRAWN BY: MK
CHECKED BY: MAB

ISSUED: January 2008
REVISED: April 2008 (Paving)

SHEET NO.
3 of 4