

# WATER MAIN AND SERVICES TO SERVE SPRING HILL SUITES PART OF LOT 12, BLK 1, THE GATEWAY 2ND ADD. PRIVATE PROJECT NUMBER 1328 PPW (607853)

## BENCHMARK

- BENCHMARK 1** BENCH MARK: CHISELED SQUARE ON BACK OF CURB, AT THE SOUTH END OF CURB ON THE EAST SIDE OF GREENWICH ROAD, 100± SOUTH OF 13TH STREET NORTH ELEVATION = 1308.037 (NGVD29)
- BENCHMARK 2** BENCH MARK: CHISELED SQUARE ON TO OF CURB AT EAST END OF CENTER MEDIAN AT THE NORTH ENTRANCE TO RESIDENCE INN, NORTH OF RESIDENCE INN BUILDING ELEVATION = 1390.29 (NGVD29)



## GENERAL NOTES

- Contractor will be required to provide a minimum notice of 48 hours to utility companies prior to starting any excavation as follows:  

Kansas One-Call	687-2470
-----------------	----------

The Contractor must notify the following in case of an emergency:

Cox Communications	262-0661
Kansas Gas Service	383-8600
Westar Energy	383-8600
Aquila Energy	1-800-303-0357
AT&T	1-800-286-8313
City of Wichita Water Department	268-6000
City of Wichita Sewer Maintenance	268-6000
- All water mains and appurtenances shall be installed in accordance with City of Wichita, Kansas, Standard Specifications for the Construction of City Projects, and current policy on construction of public works improvements by private contract.
- Opening and closing water valves shall be done slowly to prevent damage to the water distribution system from water hammer. All valves closed by the Contractor must be reopened as new construction permits. Project inspector must ascertain that any valve closed by the Contractor is reopened. Contractor will be permitted to operate water valves only when the project inspector assigned to the project is present.
- The Contractor shall give all property owners and/or tenants of developed property directly abutting the construction of this project a minimum of ten (10) days advance notice prior to start of construction.
- The Contractor shall be responsible for preserving property irons. The Contractor will be required to re-establish any property irons which are damaged or destroyed by his construction operations. Such irons shall be re-established by a licensed land surveyor in accordance with state laws.
- No work shall begin on this project before required bonds are submitted to the City of Wichita, and the project inspector has been notified.
- All areas of public R/W disturbed by construction of this project are to be restored in accordance with Administrative Regulation AR 6.5 of the City of Wichita.

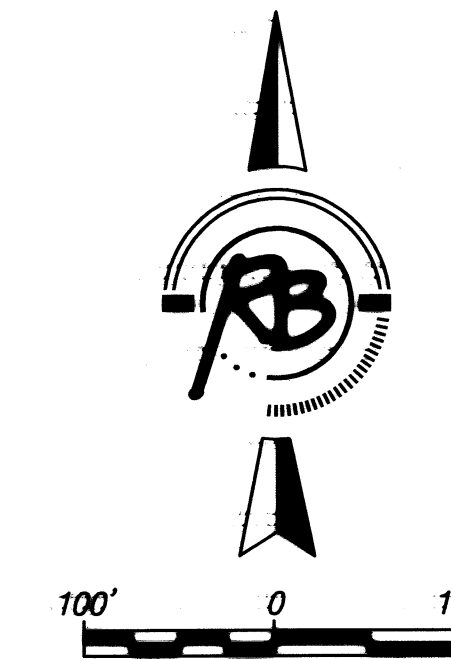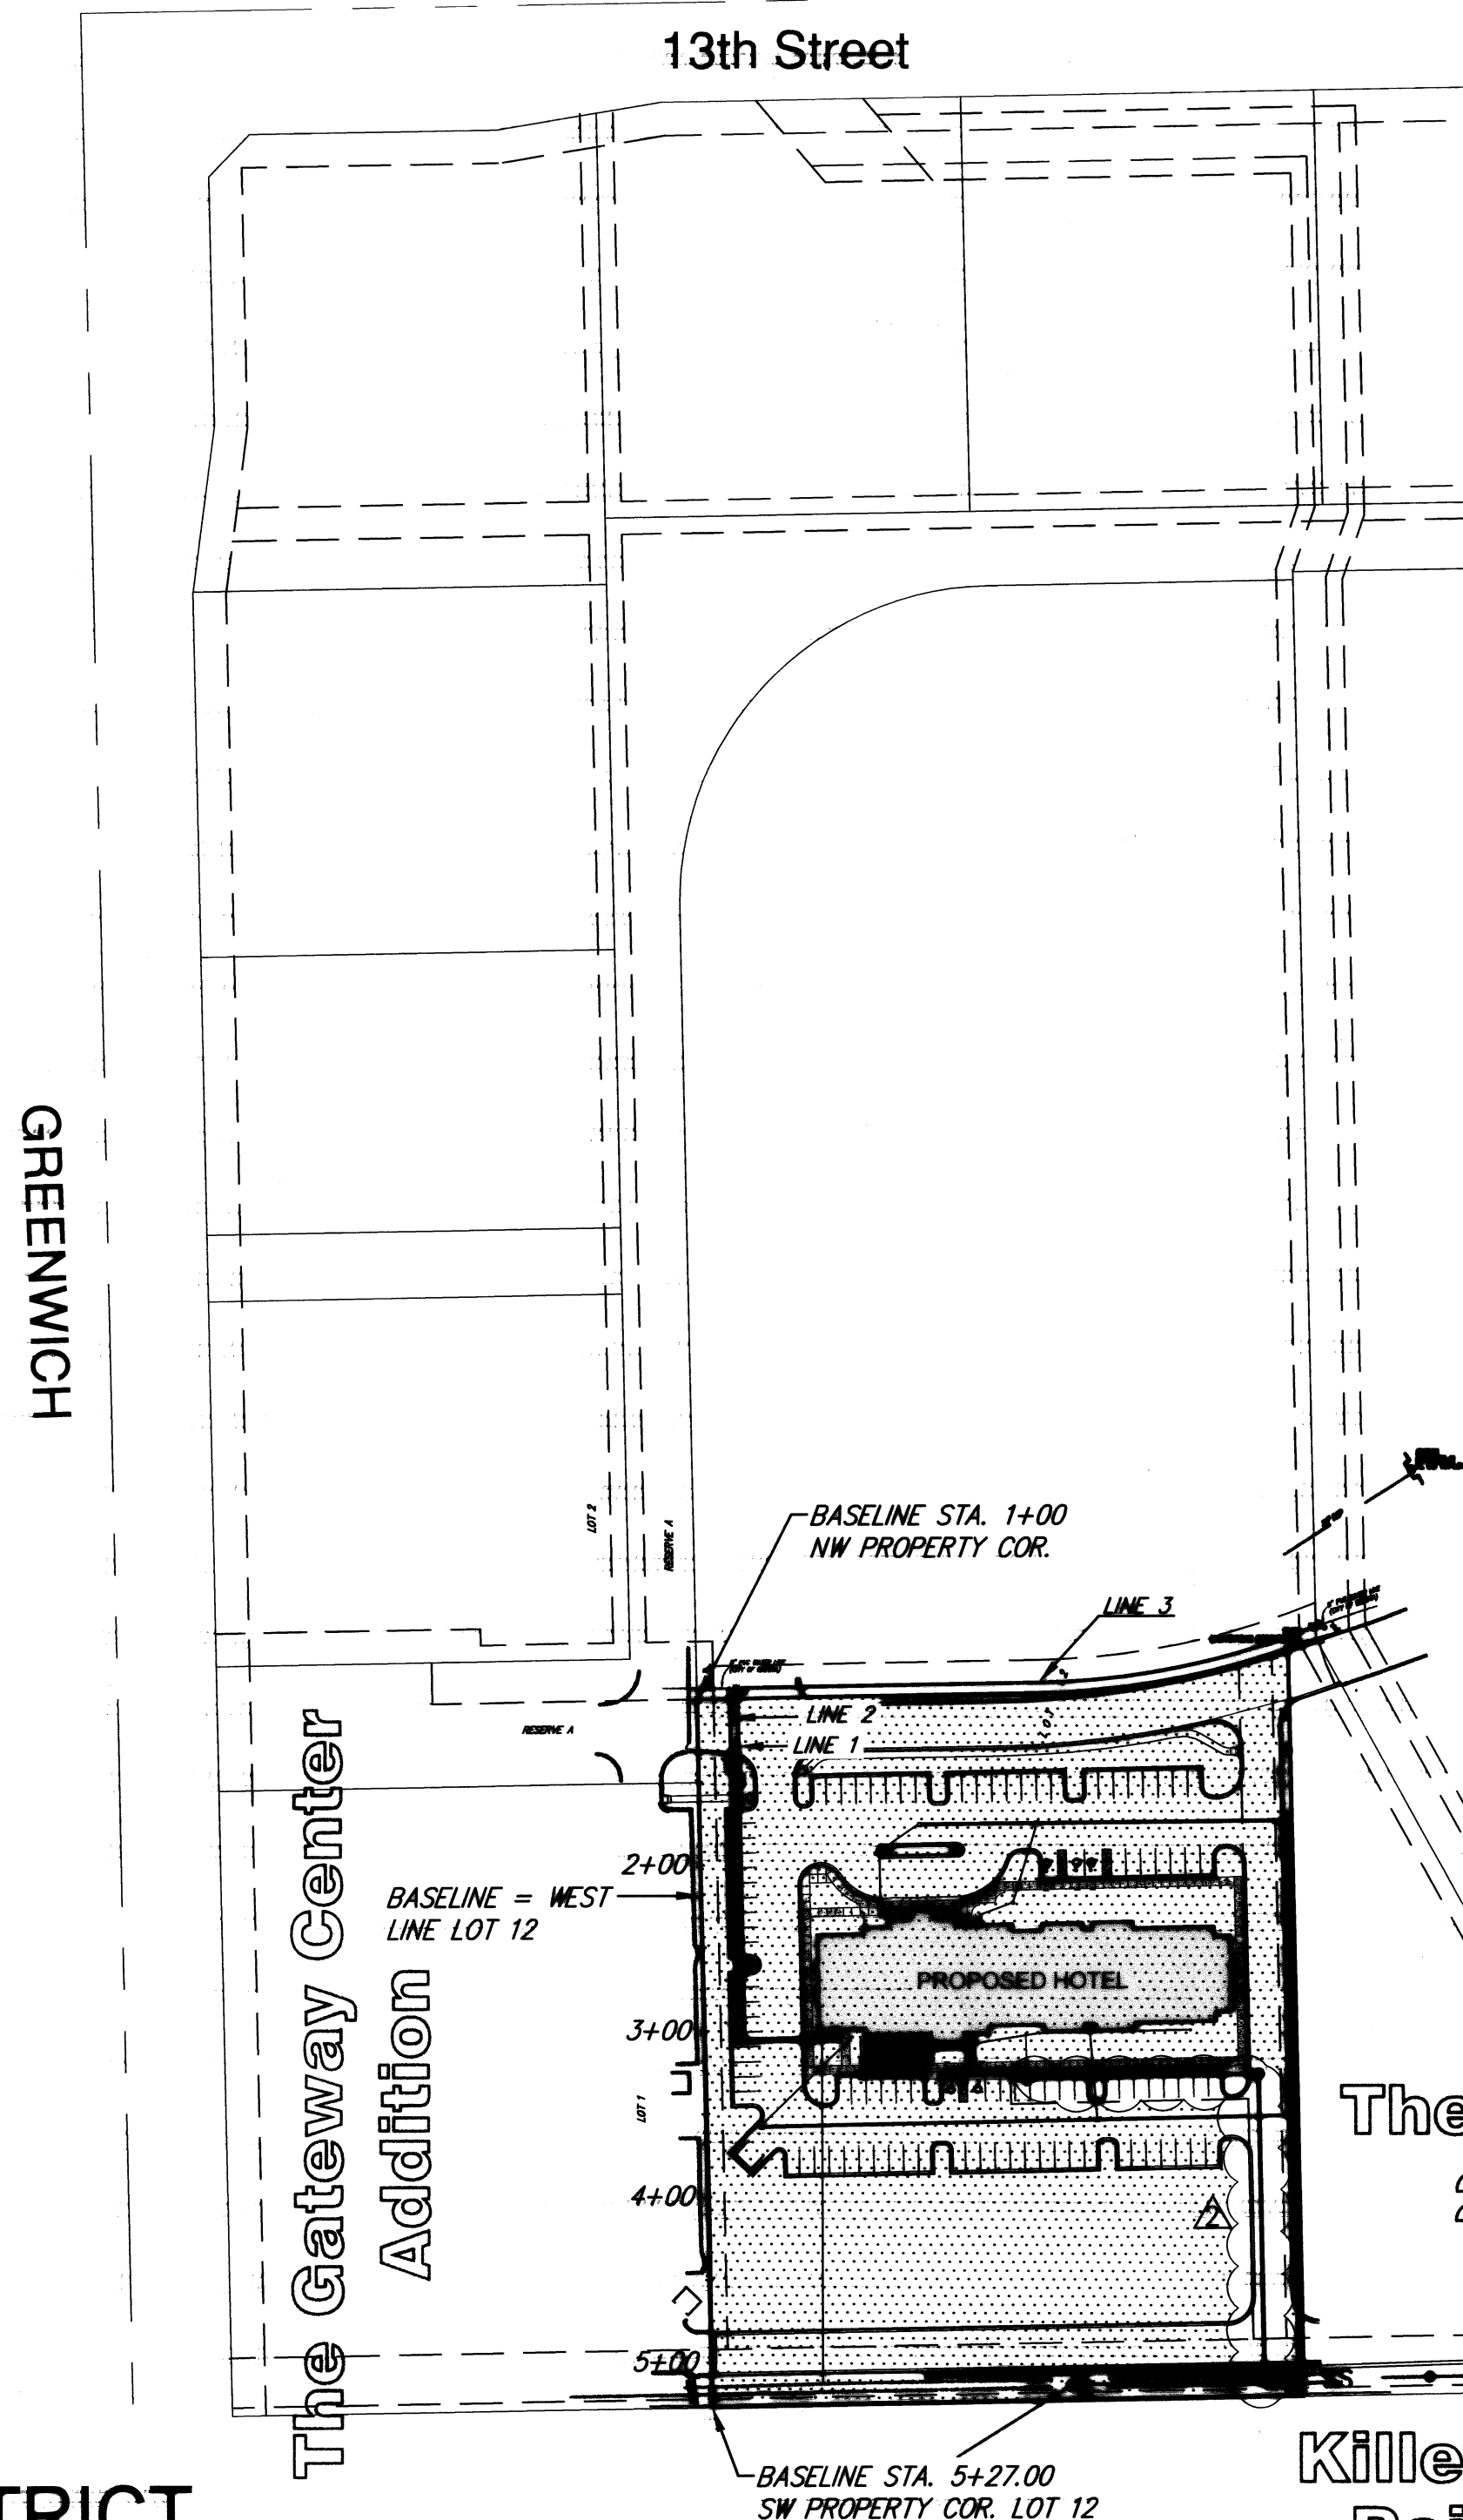

## INDEX

- COVER SHEET
- WATER PLAN & PROFILE LINES 1 & 2
- WATER PLAN & PROFILE LINE 3
- WATER ASSEMBLY DETAILS
- WATER VAULT DETAILS

APPROVED AS NOTED  
BY CITY OF WICHITA

Public Works *[Signature]* 4/16/08


Water & Sewer *[Signature]*

Fire Dept. *[Signature]* 4-21-08

NOTE TO CONTRACTORS

**PUBLIC PROPERTY:**  
Inspection and testing for the waterline is to be provided by a Licensed Consulting Engineering Firm under contract with the Owner/Developer. Said inspection to be in accordance with the City of Wichita standard construction engineering practices and certified by a Licensed Professional Engineer. No work shall be performed in dedicated easements or public right-of-way by the Contractor without such inspection nor shall any work be commenced without written authorization by the City Engineer. All Construction and Materials shall comply with the City of Wichita Specifications and Standards (on file and available in the City Engineer's Office).

**PRIVATE PROPERTY**  
Installation, inspection and testing for the fire protection line is to be performed by a City of Wichita certified fire protection contractor in accordance with the fire codes as adopted by the City of Wichita. All materials and construction practices for the fire protection line shall comply with the fire codes as adopted by the City of Wichita (available from the City of Wichita Fire Department). The contractor shall not commence work without notification of and approval of the Wichita Fire Department.

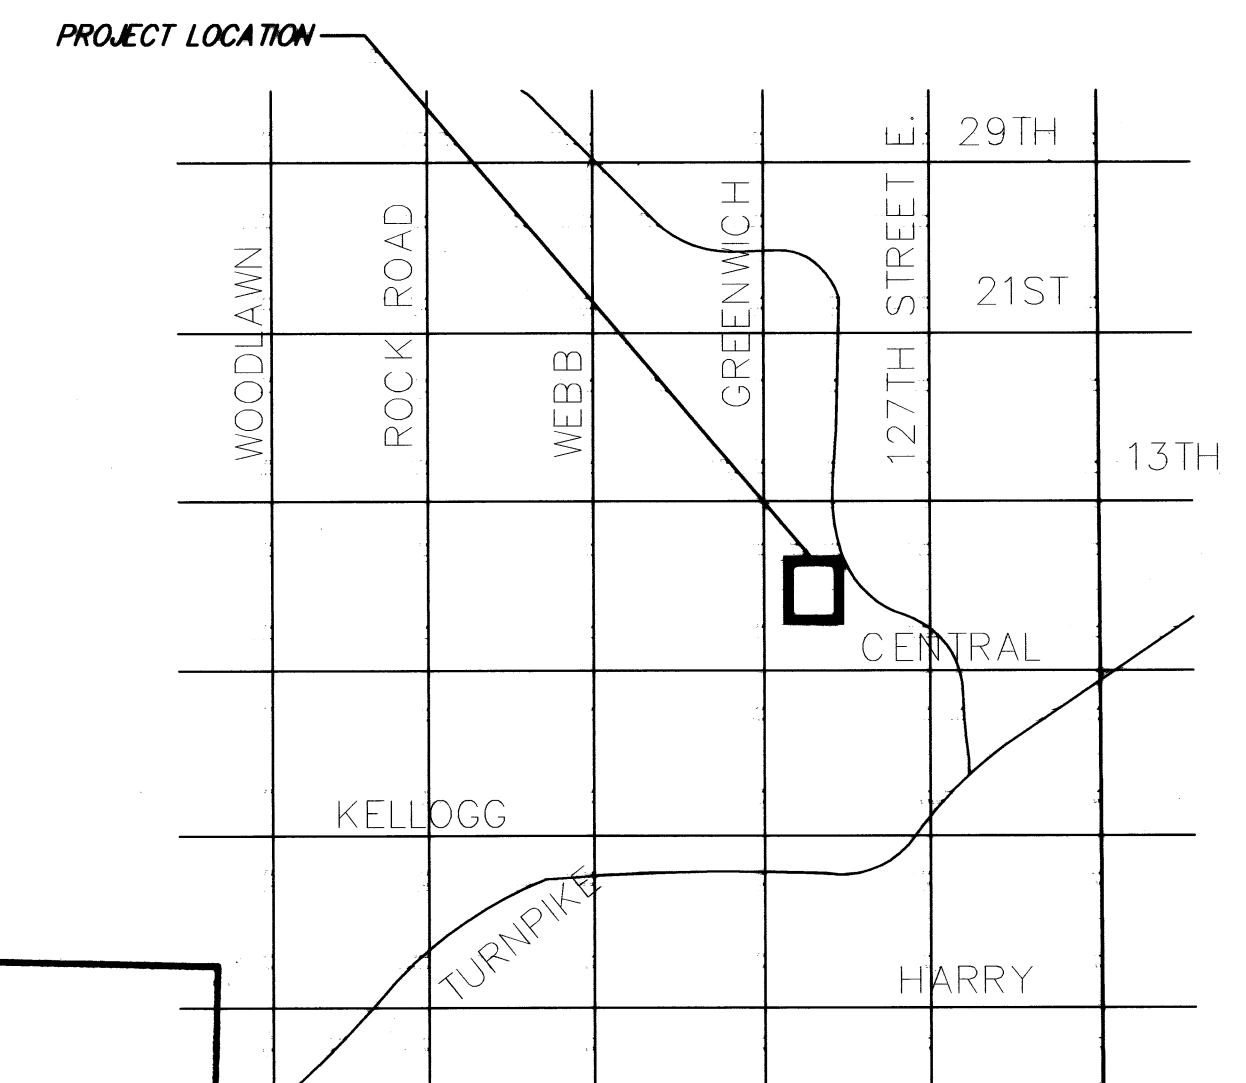

## VICINITY MAP

**AS BUILTS:**

CONTRACTOR: Ewertz Exc.

INSPECTOR: Larry Gann

COMPANY: K.E. Miller

DATE: 9/17/08

IMPROVEMENT DISTRICT

**CITY OF WICHITA, KANSAS**  
**JAMES L. ARMOUR, P.E. - CITY ENGINEER**

**Ruggles & Bohm, P.A.**  
Engineering, Surveying, Land Planning

924 North Main  
Wichita, Kansas 67203  
www.rbkansas.com

(316) 264-8008  
(316) 264-4621 fax  
E-mail: info@rbkansas.com