

# STORM & SANITARY SEWER PLANS TO SERVE THE HOME DEPOT ADDITION

PRIVATE PROJECT NO. 1700 PPS  
OCA #607861  
CITY OF WICHITA  
SEDGWICK COUNTY, KANSAS


### GENERAL NOTES:

- THE CONTRACTOR WILL BE REQUIRED TO PROVIDE A MINIMUM ADVANCE NOTICE OF FOURTY-EIGHT (48) HOURS TO UTILITY COMPANIES PRIOR TO STARTING ANY EXCAVATION AS FOLLOWS:  

KANSAS ONE-CALL	1-800-344-7233
-----------------	----------------

THE CONTRACTOR MUST NOTIFY THE FOLLOWING IN CASE OF EMERGENCY:

KANSAS GAS SERVICE	1-316-832-3177
WESTAR ENERGY	1-316-261-6859
SOUTHWESTERN BELL TELEPHONE COMPANY	1-316-268-3122
CITY OF WICHITA WATER DEPARTMENT	1-316-268-4555
CITY OF WICHITA SEWER MAINTENANCE	1-316-268-4341
- THE CONTRACTOR SHALL BE RESPONSIBLE FOR PRESERVING PROPERTY IRONS. THE CONTRACTOR SHALL BE REQUIRED TO RE-ESTABLISH ANY PROPERTY IRONS WHICH ARE DAMAGED OR DESTROYED BY HIS CONSTRUCTION OPERATIONS. SUCH IRONS SHALL BE RE-ESTABLISHED BY A LICENSED LAND SURVEYOR IN ACCORDANCE WITH STATE LAWS.
- EXISTING UTILITIES AND THEIR LOCATIONS, AS SHOWN ON THE PLANS REPRESENT THE BEST INFORMATION OBTAINABLE FOR DESIGN. LOCATION INFORMATION HAS BEEN OBTAINED FROM THE VARIOUS COMPANIES AND IS EITHER FROM COMPANY UTILITY DRAWINGS OR COMPANY PROVIDED FIELD LOCATIONS. THE PLAN LOCATIONS SHOWN ARE NOT GUARANTEED. ADDITIONAL EXISTING UTILITIES MAY ALSO BE ENCOUNTERED.
- RUBBLE FROM THE REMOVAL OF MISCELLANEOUS STRUCTURES AND EXCESS EXCAVATION WHICH IS TO BE WASTED SHALL BE DISPOSED OF ON SITES TO BE PROVIDED BY THE CONTRACTOR. THESE SITES SHALL BE APPROVED BY THE ENGINEER AS TO SUITABILITY, APPEARANCE AND SITE LOCATION. LOCATIONS THAT, IN THE OPINION OF THE ENGINEER, WILL LEAVE AN UNSIGHTLY APPEARANCE WILL NOT BE APPROVED. ALL DISPOSAL SITES MUST BE APPROVED BY THE KANSAS DEPARTMENT OF HEALTH AND ENVIRONMENT. MATERIAL EITHER STOCKPILED OR DISPOSED OF IN A FLOOD PLAIN WOULD REQUIRE A KANSAS STATE BOARD OF AGRICULTURE PERMIT. ANY MATERIAL DUMPED IN WATERS OF THE UNITED STATES OR WETLANDS IS SUBJECT TO U.S. CORPS OF ENGINEERS PERMITTING REGULATIONS. ANY MATERIAL BURIED OR STOCKPILED BEYOND APPROVED CONSTRUCTION LIMITS WOULD REQUIRE ADDITIONAL ARCHEOLOGICAL INVESTIGATIONS UNLESS BURIED IN A PREVIOUSLY APPROVED BORROW LOCATION.
- UNLESS SHOWN OR STATED OTHERWISE ON THESE DRAWINGS, MATERIALS AND CONSTRUCTION SHALL BE IN ACCORDANCE WITH CITY OF WICHITA SPECIFICATIONS.
- SITE RESTORATION AND PREPARATION SHALL BE SUBSIDIARY TO THE PROJECT.

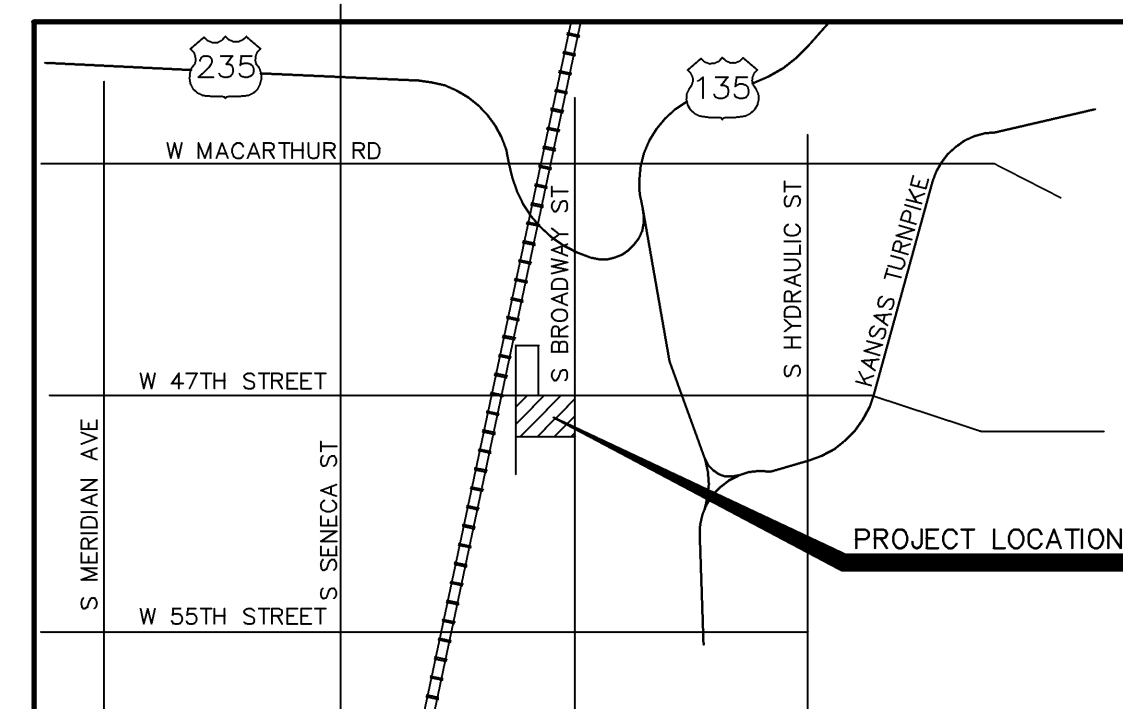

VICINITY MAP  
NOT TO SCALE



LEON D OSBOURN  
PROFESSIONAL ENGINEER

Larkin Excavating - Contractor  
Date Released - 09/22/08  
As-Built  
APR 10/21/08

WARRANTY / DISCLAIMER  
THE DESIGNS REPRESENTED IN THESE PLANS ARE IN ACCORDANCE WITH ESTABLISHED PRACTICES OF CIVIL ENGINEERING FOR THE DESIGN FUNCTIONS AND USES INTENDED BY THE OWNER AT THIS TIME. HOWEVER, NEITHER KAW VALLEY ENGINEERING, INC NOR ITS PERSONNEL CAN OR DO WARRANTY THESE DESIGNS OR PLANS AS CONSTRUCTED, EXCEPT IN THE SPECIFIC CASES WHERE KAW VALLEY ENGINEERING PERSONNEL INSPECT AND CONTROL THE PHYSICAL CONSTRUCTION ON A CONTEMPORARY BASIS AT THE SITE.

### CONTACT PERSON:

SAMUEL D. MALINOWSKY, P.E., KAW VALLEY ENGINEERING, INC. 785-762-5040

### CAUTION - NOTICE TO CONTRACTOR

THE CONTRACTOR IS SPECIFICALLY CAUTIONED THAT THE LOCATION AND/OR ELEVATION OF EXISTING UTILITIES AS SHOWN ON THESE PLANS IS BASED ON RECORDS OF THE VARIOUS UTILITY COMPANIES AND, WHERE POSSIBLE, MEASUREMENTS TAKEN IN THE FIELD. THE INFORMATION IS NOT TO BE RELIED ON AS BEING EXACT OR COMPLETE. THE CONTRACTOR MUST CALL THE APPROPRIATE UTILITY COMPANY AT LEAST 48 HOURS BEFORE ANY EXCAVATION TO REQUEST EXACT FIELD LOCATION OF UTILITIES. IT SHALL BE THE RESPONSIBILITY OF THE CONTRACTOR TO RELOCATE ALL EXISTING UTILITIES WHICH CONFLICT WITH PROPOSED IMPROVEMENTS SHOWN ON THE PLANS. **THE CONTRACTOR SHALL EXPOSE EXISTING UTILITIES AT LOCATIONS OF POSSIBLE CONFLICTS PRIOR TO ANY CONSTRUCTION.**

### SAFETY NOTICE TO CONTRACTOR

IN ACCORDANCE WITH GENERALLY ACCEPTED CONSTRUCTION PRACTICES, THE CONTRACTOR WILL BE SOLELY AND COMPLETELY RESPONSIBLE FOR CONDITIONS OF THE JOB SITE, INCLUDING SAFETY OF ALL PERSONS AND PROPERTY DURING PERFORMANCE OF THE WORK. THIS REQUIREMENT WILL APPLY CONTINUOUSLY AND NOT BE LIMITED TO NORMAL WORKING HOURS.

APPROVED AS NOTED  
BY CITY ENGINEER OF WICHITA

STORM SEWERS \_\_\_\_\_


SANITARY SEWERS \_\_\_\_\_

### NOTE TO CONTRACTOR

INSPECTION AND TESTING FOR THIS PROJECT IS TO BE PROVIDED BY A LICENSED CONSULTING ENGINEERING FIRM UNDER CONTRACT WITH THE OWNER / DEVELOPER. SAID INSPECTION TO BE IN ACCORDANCE WITH THE CITY OF WICHITA STANDARD CONSTRUCTION ENGINEERING PRACTICES AND CERTIFIED BY A LICENSED PROFESSIONAL ENGINEER. NO WORK SHALL BE PERFORMED IN DEDICATED EASEMENTS OR THE PUBLIC RIGHT-OF-WAY BY THE CONTRACTOR WITHOUT SUCH INSPECTION NOR SHALL ANY WORK BE COMMENCED IN DEDICATED EASEMENTS OR PUBLIC RIGHT-OF-WAY WITHOUT WRITTEN AUTHORIZATION BY THE CITY ENGINEER.

### INDEX TO SHEETS:


- TITLE SHEET
- PROJECT CONTROL PLAN & GENERAL LAYOUT SHEET
- SANITARY SEWER PLAN AND PROFILE - LINE "A" & "B"
- 4-5. STORM SEWER LINE "A" - PLAN AND PROFILE
6. STORM SEWER LINE "B" & "D" - PLAN AND PROFILE
7. STORM SEWER LINE "C" - PLAN AND PROFILE
8. STANDARD TYPE "P" MANHOLES
9. STANDARD TYPE I CURB INLET - 5'-0" OPENING
10. STANDARD TYPE I CURB INLET - 10'-0" OPENING
- 11-14. SOIL EROSION BMP DETAILS
15. DETAILS

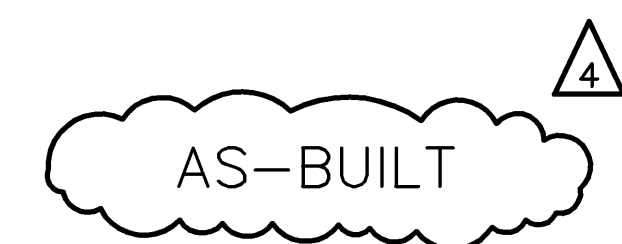

### BENCHMARKS:

- BM #1: CITY OF WICHITA BENCHMARK - 2 1/2" BRASS DISC FOUND AT THE NORTHEAST CORNER OF THE TRAFFIC SIGNAL POLE CONCRETE BASE AT THE SOUTHWEST QUADRANT OF 47TH STREET SOUTH & BROADWAY. CITY OF WICHITA DATUM=87.44 MSL ELEV=1274.84
- BM #2: CHISELED SQUARE FOUND IN TOP OF CONCRETE LIGHT POLE BASE ON NORTH SIDE OF POLE. WEST OF WEST ENTRANCE INTO BURGER KING. CITY OF WICHITA DATUM=87.69 MSL ELEV=1275.09
- BM #3: CHISELED SQUARE SET, 0.5' EAST OF CORNER OF CURB ON TOP OF CURB AT SOUTHWEST CORNER OF PARKING LOT FOR DOLLAR GENERAL. CITY OF WICHITA DATUM=87.28 MSL ELEV=1274.68
- BM #4: NORTHEAST CAP BOLT ON FIRE HYDRANT AT SOUTHEAST CORNER OF OLD GROCERY STORE. CITY OF WICHITA DATUM=87.76 MSL ELEV=1275.16
- BM #5: CHISELED SQUARE SET AT NORTHWEST CORNER OF CURB INLET AT NORTHWEST QUADRANT OF 48TH STREET SOUTH AND BROADWAY. CITY OF WICHITA DATUM=86.01 MSL ELEV=1273.41

AS BUILT PLANS	5-13-08	REV	DATE	DESCRIPTION	DSN	DWN	CHK
REVISED PER ADDENDUM "A"	2-1-08	3					
REVISED PER CITY	12-21-08	2					
REVISED PER CITY	11-27-08	1					
INITIAL ISSUE	8-18-08	0					
<b>THE HOME DEPOT ADDITION</b> <b>47TH STREET SOUTH &amp; BROADWAY AVENUE</b> <b>WICHITA, KANSAS</b>							
<b>TITLE SHEET</b>							
PROJ. NO. <b>A06 2806</b> DATE <b>AUG 2006</b> DESIGNER <b>SDM</b> DRAWN BY CFN <b>2806DTS</b> JL SHEET <b>1 OF 15</b> REV <b>4</b>							
2319 NORTH JACKSON P.O. BOX 1304 JUNCTION CITY, KANSAS 66441 785-762-5040 FAX 785-762-7744 E-MAIL jc@kveing.com WEB SITE www.kveing.com KAW VALLEY ENGINEERING, INC. - CONSULTING ENGINEERS Offices: Junction City, Mo., Kansas City, Mo., Lenexa, Ks.							

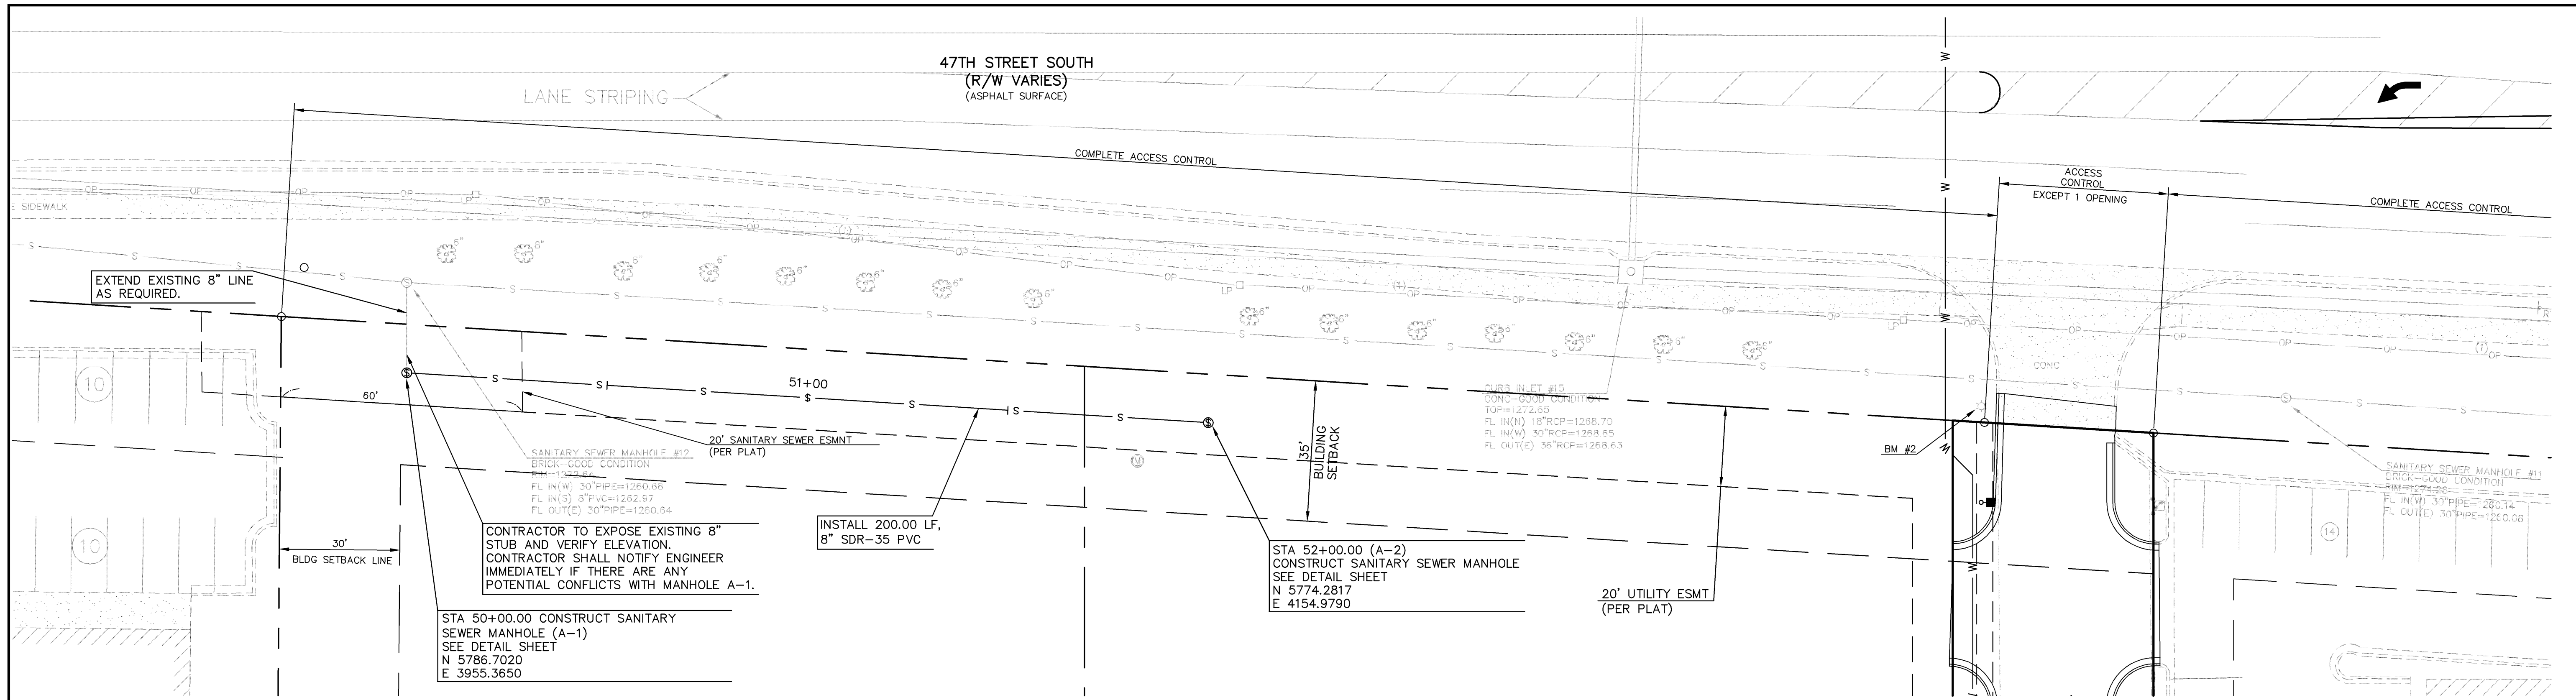


REV	DATE	DESCRIPTION
4	5-13-08	AS BUILT PLANS
2	12-21-08	REVISED PER CITY
1	11-27-08	REVISED PER CITY
0	8-18-08	INITIAL ISSUE





2319 NORTH JACKSON  
 P.O. BOX 1304  
 JUNCTION CITY, KANSAS 66441  
 785-762-5040 FAX 785-762-7744  
 E-MAIL jc@kveing.com  
 WEB SITE www.kveing.com

KAW VALLEY ENGINEERING, INC. - CONSULTING ENGINEERS  
 Offices: Junction City, ks. Kansas City, Mo. Lenexa, Ks.

THE HOME DEPOT ADDITION 47TH STREET SOUTH & BROADWAY AVENUE WICHITA, KANSAS	
PROJ. NO.	A06_2806
DATE	AUG 2006
DESIGNER	SDM
DRAWN BY	JL
CFN	2806SPP
SHEET	3 OF 15
SANITARY SEWER LINE "A" & "B" - PLAN & PROFILE	
DSN	DWN
CHK	CHK

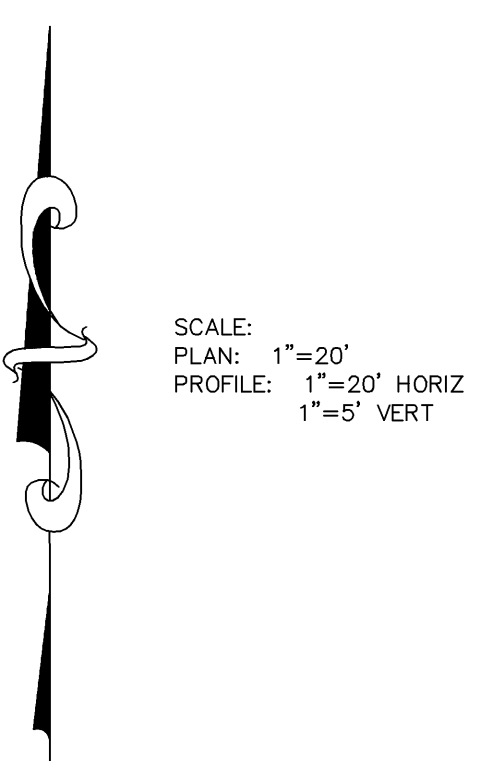



SCALE:  
 PLAN: 1"=20'  
 PROFILE: 1"=20' HORIZ  
 1"=5' VERT

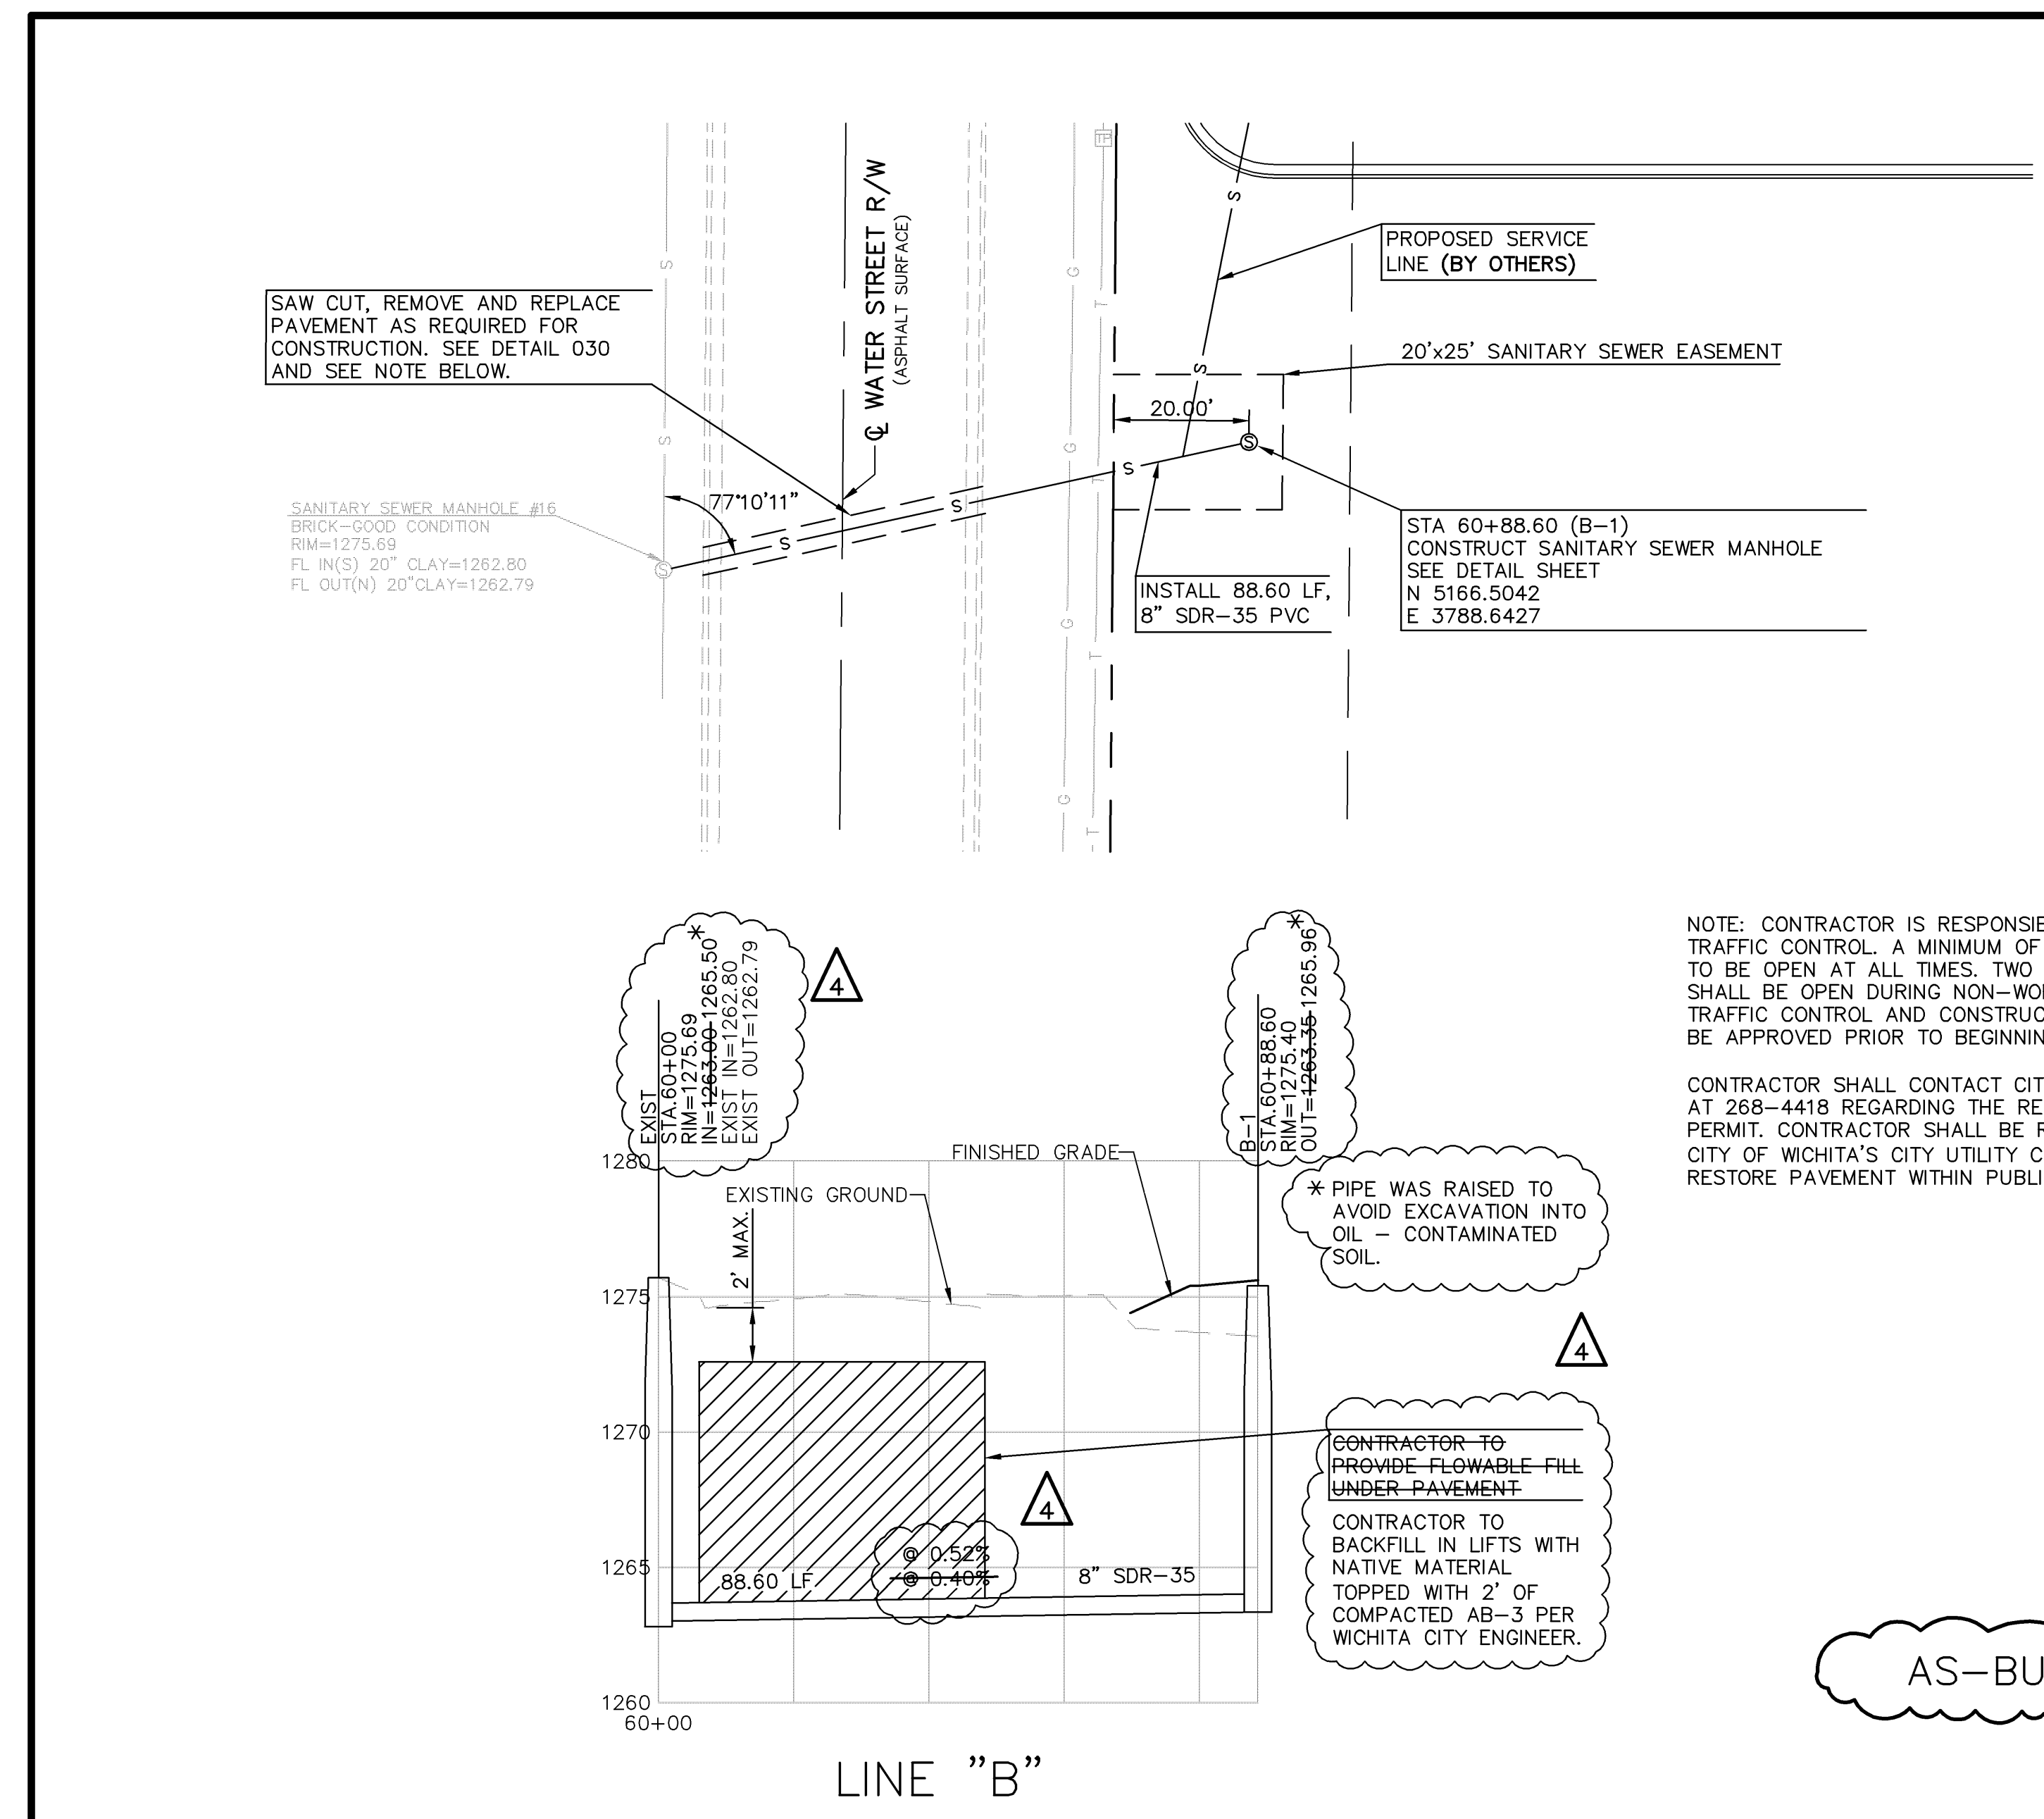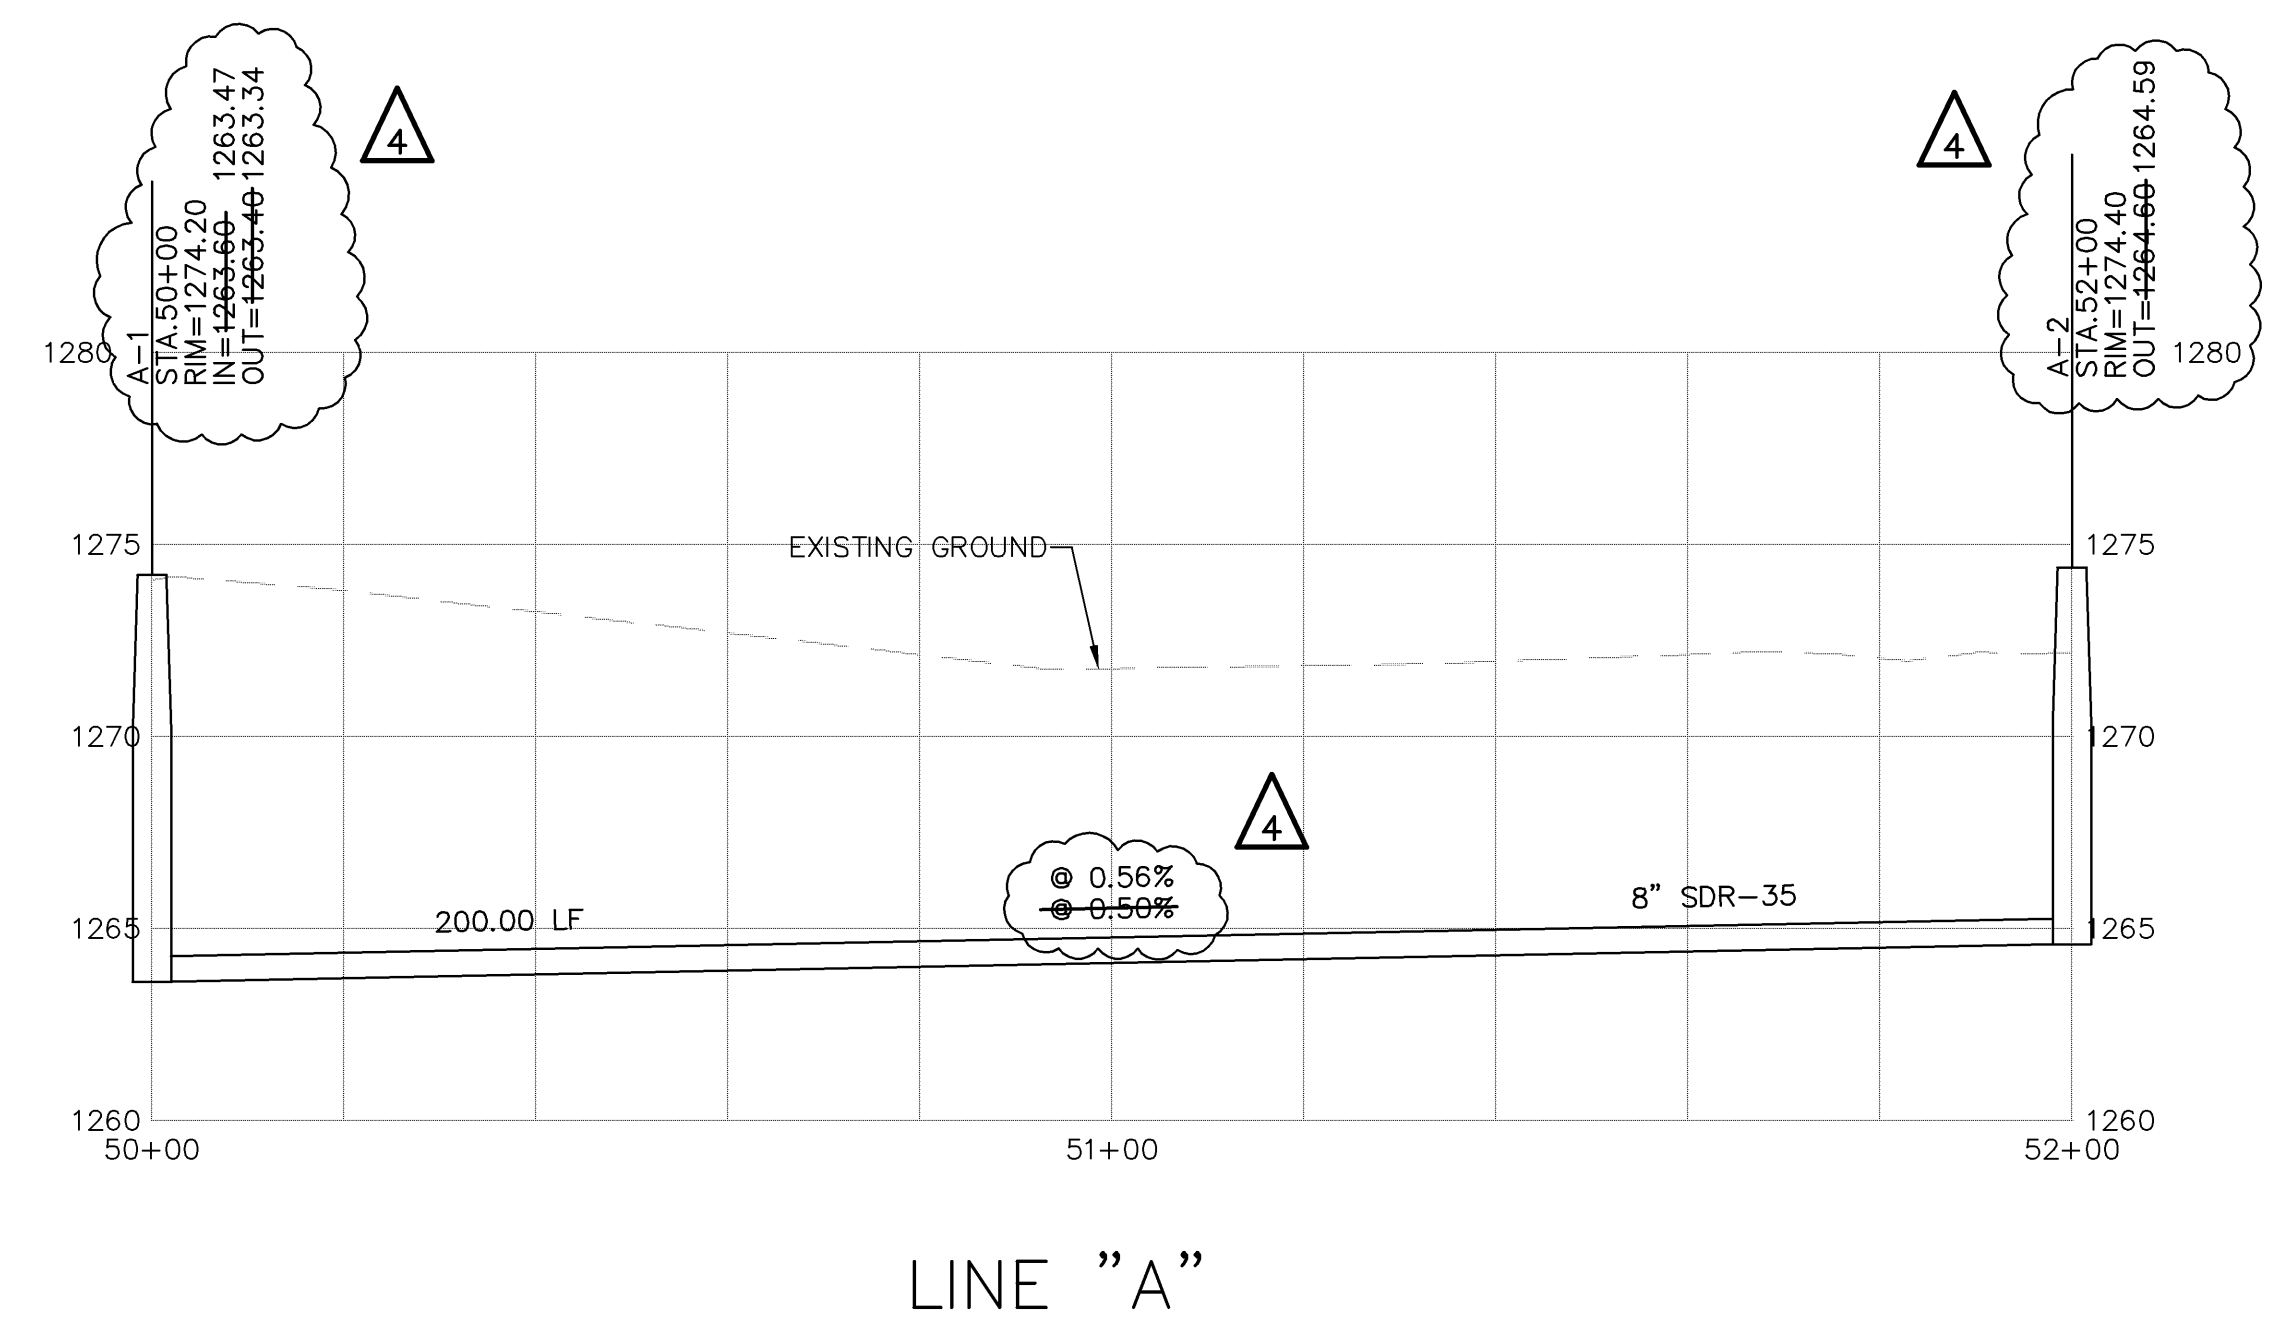

NOTE: CONTRACTOR IS RESPONSIBLE FOR PROVIDING ALL TRAFFIC CONTROL. A MINIMUM OF ONE LANE OF TRAFFIC TO BE OPEN AT ALL TIMES. TWO LANES OF TRAFFIC SHALL BE OPEN DURING NON-WORKING TIMES. PROPOSED TRAFFIC CONTROL AND CONSTRUCTION SEQUENCING MUST BE APPROVED PRIOR TO BEGINNING CONSTRUCTION.

CONTRACTOR SHALL CONTACT CITY ENGINEER'S OFFICE AT 268-4418 REGARDING THE REQUIRED UTILITY CUT PERMIT. CONTRACTOR SHALL BE REQUIRED TO USE THE CITY OF WICHITA'S CITY UTILITY CUT CONTRACTOR TO RESTORE PAVEMENT WITHIN PUBLIC RIGHT-OF-WAY.


AS-BUILT

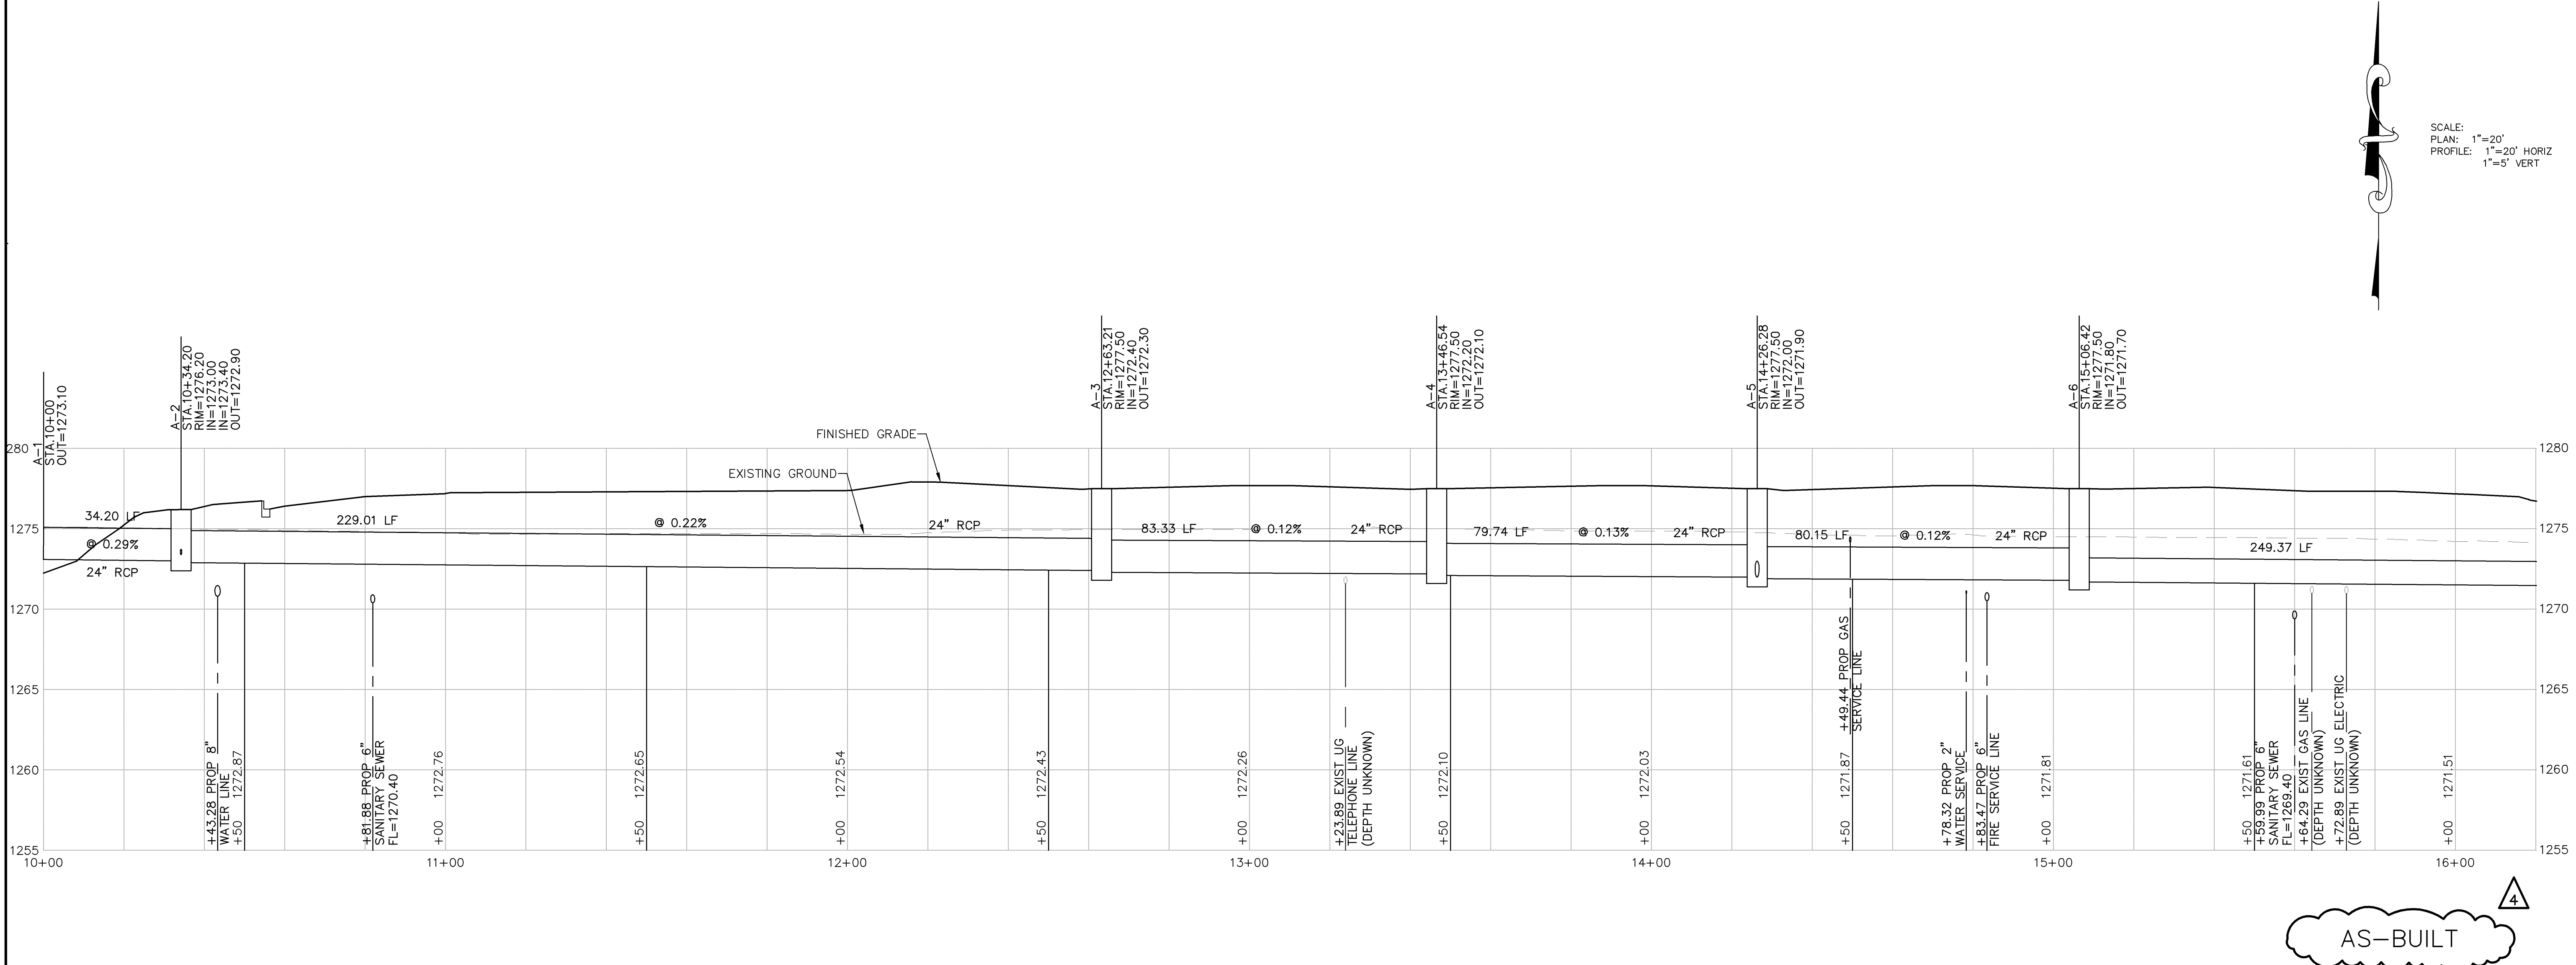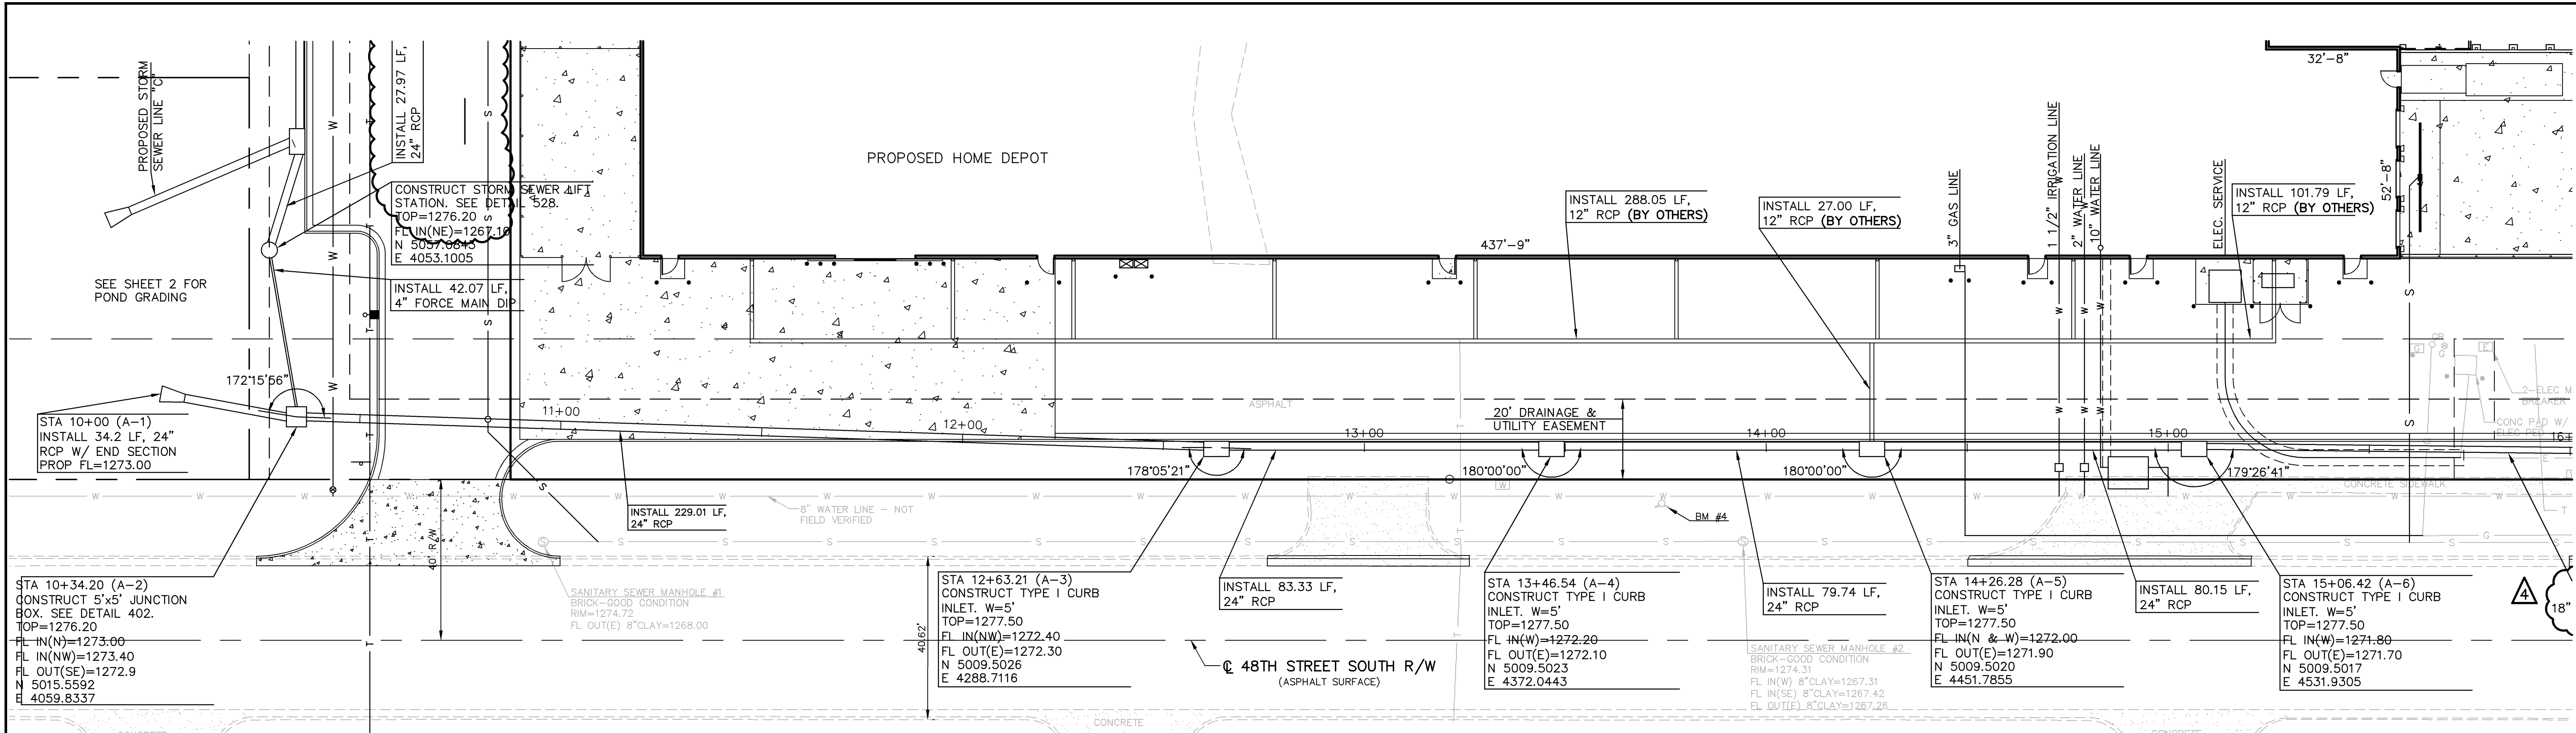


AS-BUILT

SCALE:  
PLAN: 1"=20'  
PROFILE: 1"=20' HORIZ  
1"=5' VERT

PROJ. NO. A06_2806		DATE AUG 2006		DESIGNER SDM		DRAWN BY JL		CFN 2806DPP		SHEET 4 OF 15	
THE HOME DEPOT ADDITION 47TH STREET SOUTH & BROADWAY AVENUE WICHITA, KANSAS		STORM SEWER LINE 'A' - PLAN & PROFILE		KAW VALLEY ENGINEERING, INC. - CONSULTING ENGINEERS Offices: Junction City, ks. Kansas City, Mo. Lenexa, ks.				2319 NORTH JACKSON P.O. BOX 1304 JUNCTION CITY, KANSAS 66441 785-762-5040 FAX 785-762-7744 E-MAIL jk@kveing.com WEB SITE www.kveing.com		5-13-08 AS BUILT PLANS 11-27-06 REVISED PER CITY 8-18-06 INITIAL ISSUE	
REV	DATE	DESCRIPTION		DSN	DWN	CHK					

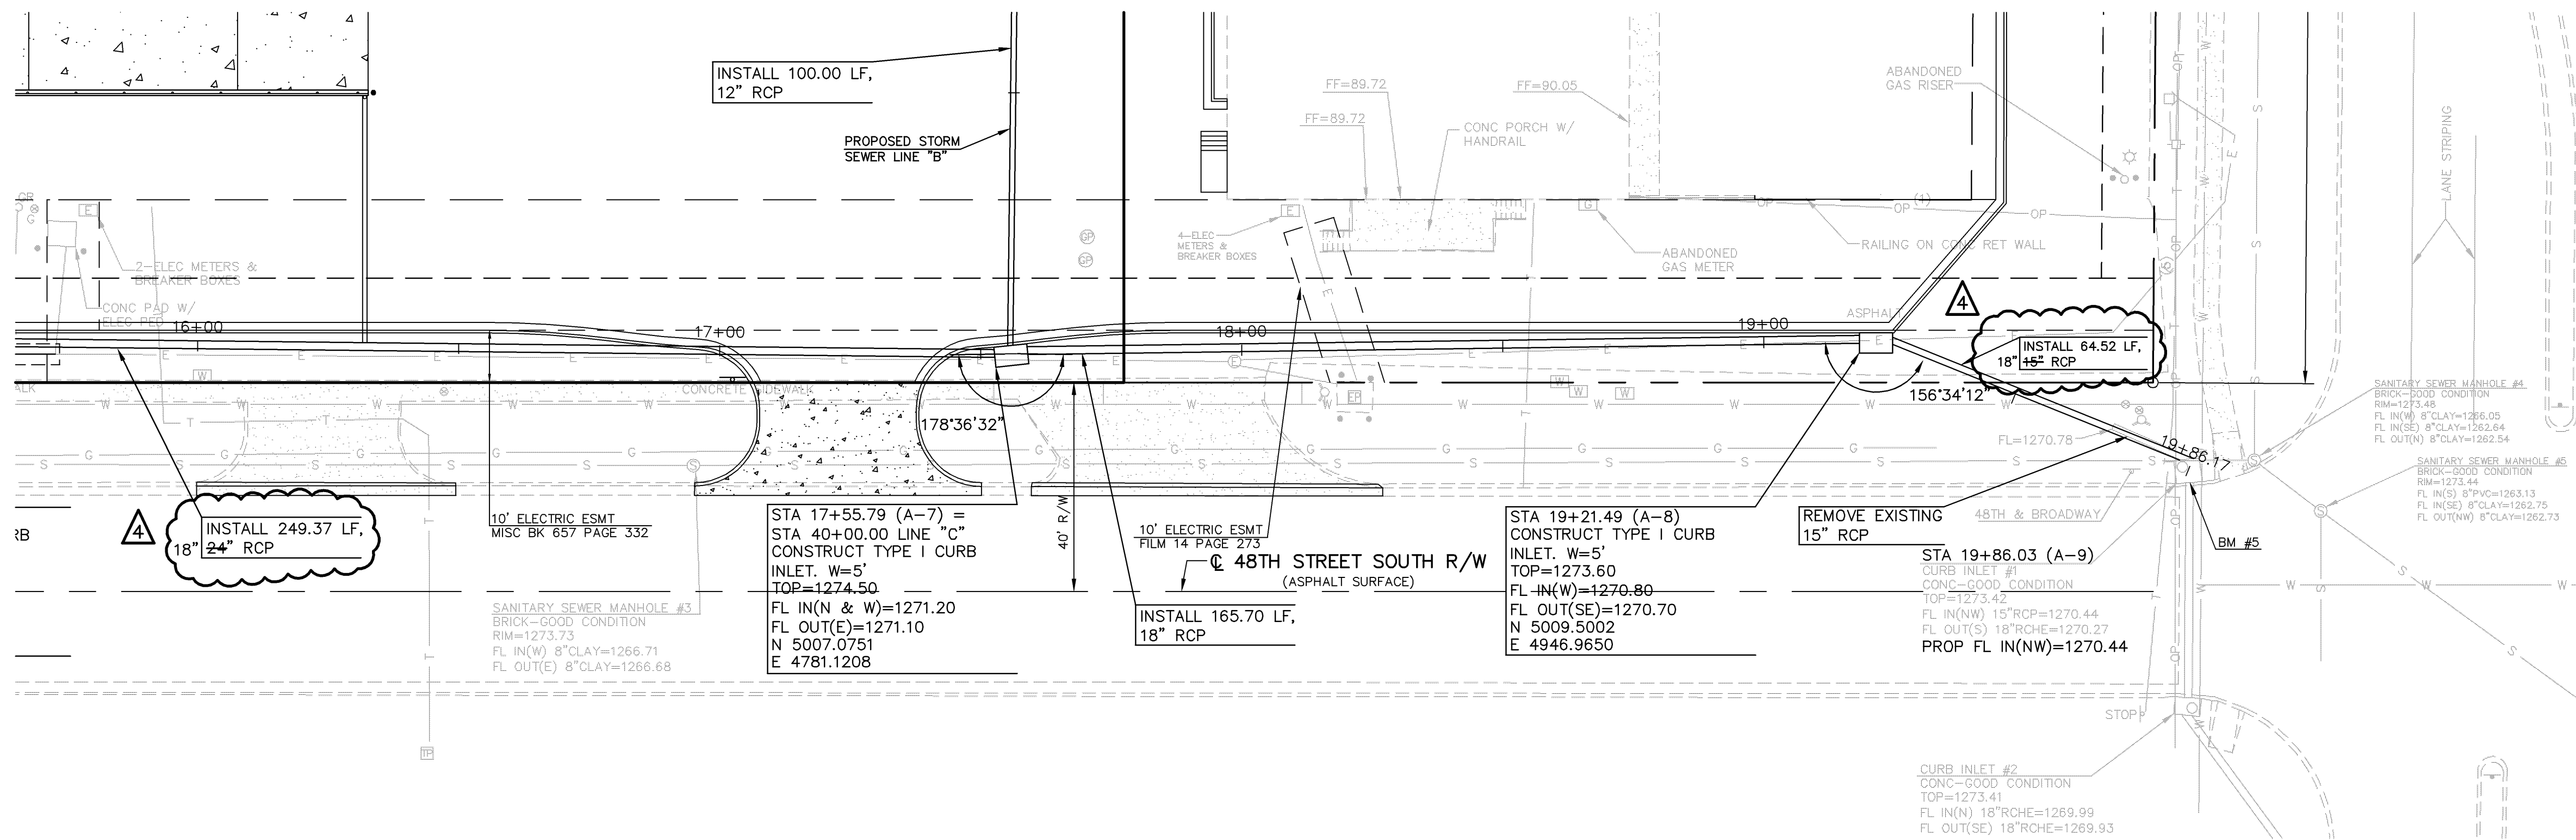

SCALE: 1"=20'  
 PLAN: 1"=20' HORIZ  
 PROFILE: 1"=5' VERT

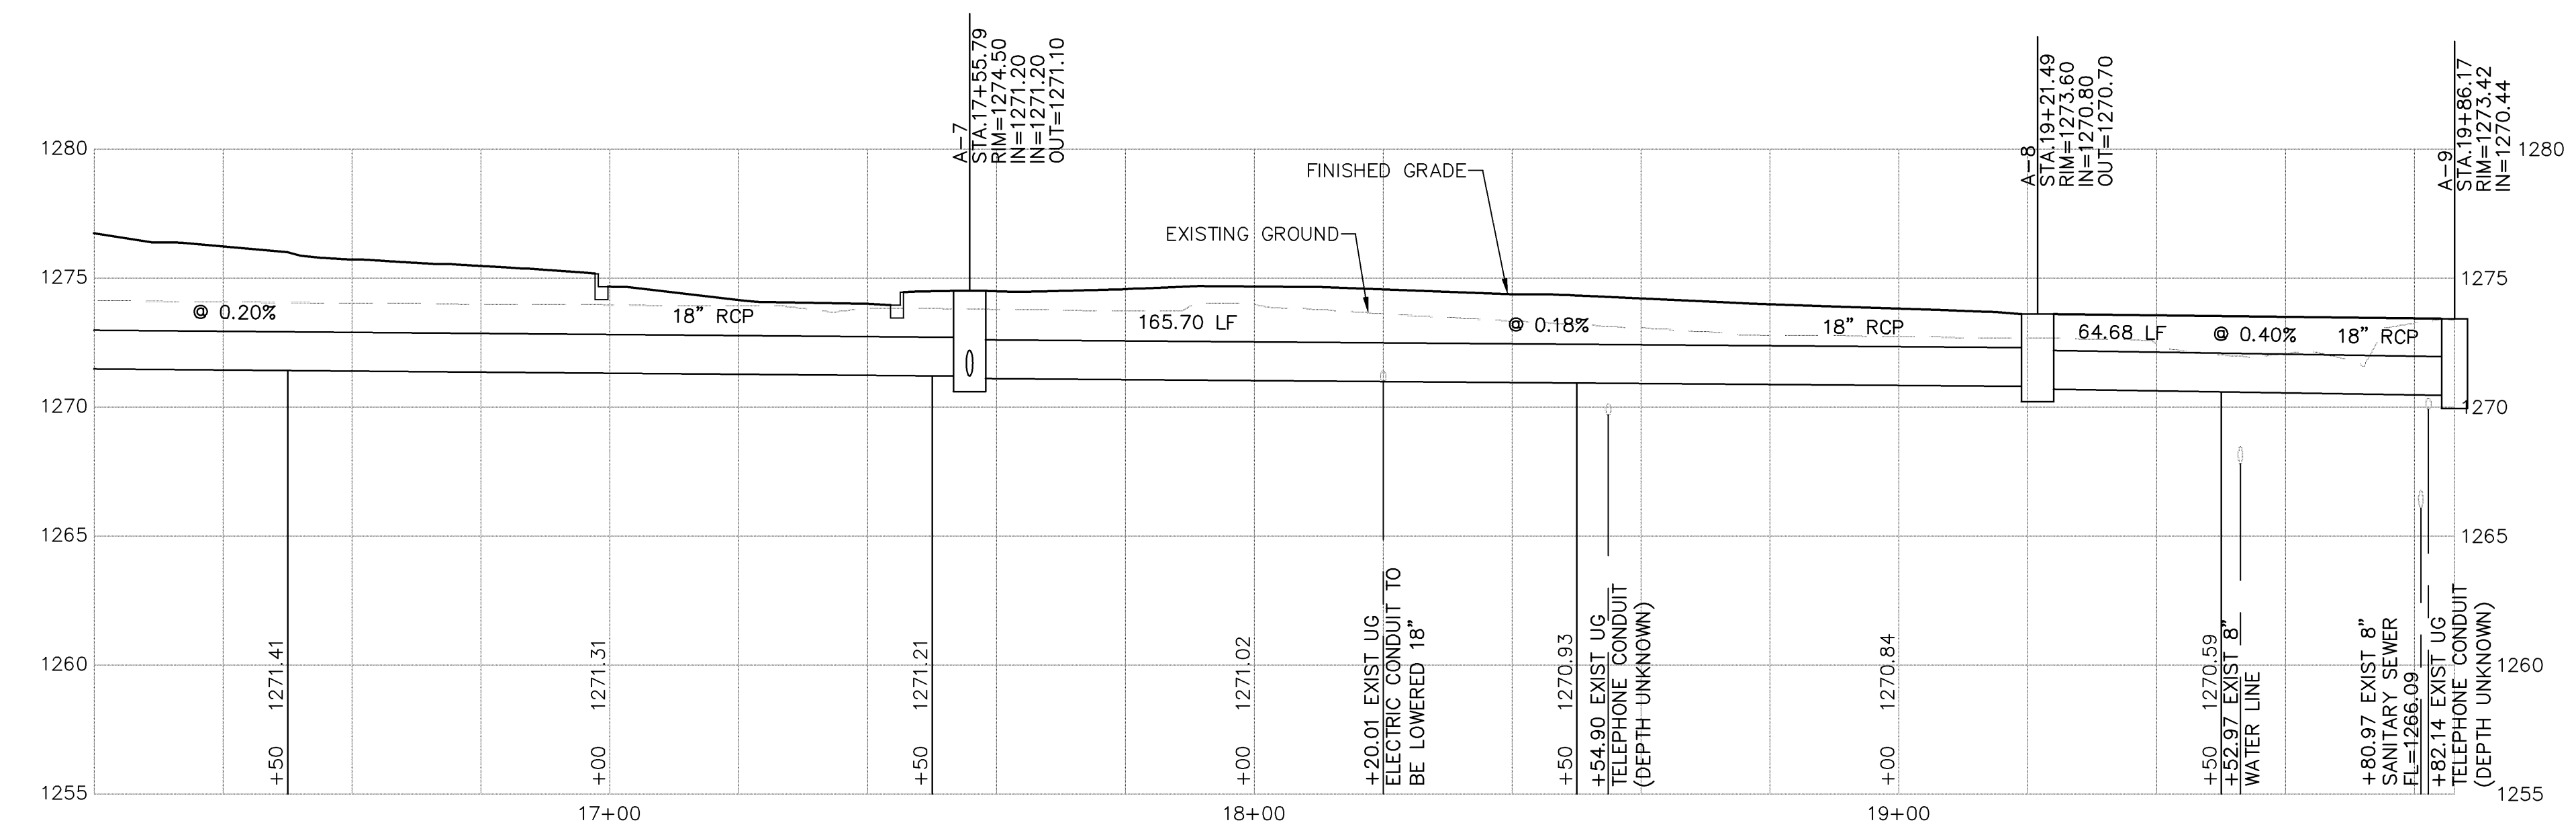


AS-BUILT

ELEVATION DATUM REVISED TO M.S.L.


PROJ. NO. A06 2806		DATE AUG 2006		DESIGNER SDM		DRAWN BY JL		CFN 2806DPP		SHEET 5 OF 15					
THE HOME DEPOT ADDITION 47TH STREET SOUTH & BROADWAY AVENUE WICHITA, KANSAS		STORM SEWER LINE 'A' - PLAN & PROFILE		KAW VALLEY ENGINEERING, INC. - CONSULTING ENGINEERS Offices: Junction City, ks. Kansas City, Mo. Lenexa, Ks.				2319 NORTH JACKSON P.O. BOX 1304 JUNCTION CITY, KANSAS 66441 785-762-5040 FAX 785-762-7744 E-MAIL jk@kveing.com WEB SITE www.kveing.com		4 5-13-08 AS BUILT PLANS 1 11-27-06 REVISED PER CITY 0 8-18-06 INITIAL ISSUE		REV DATE DESCRIPTION		DSN DWN CHK	

G:\A06\_2806\DESIGN\STORM & SANITARY\AS BUILT\2806DPP.dwg, 5/13/2008 9:07:57 AM, jll


THIS DRAWING SHALL NOT BE UTILIZED BY ANY PERSON, FIRM, OR CORPORATION IN WHOLE OR IN PART WITHOUT THE SPECIFIC PERMISSION OF KAW VALLEY ENGINEERING, INC.

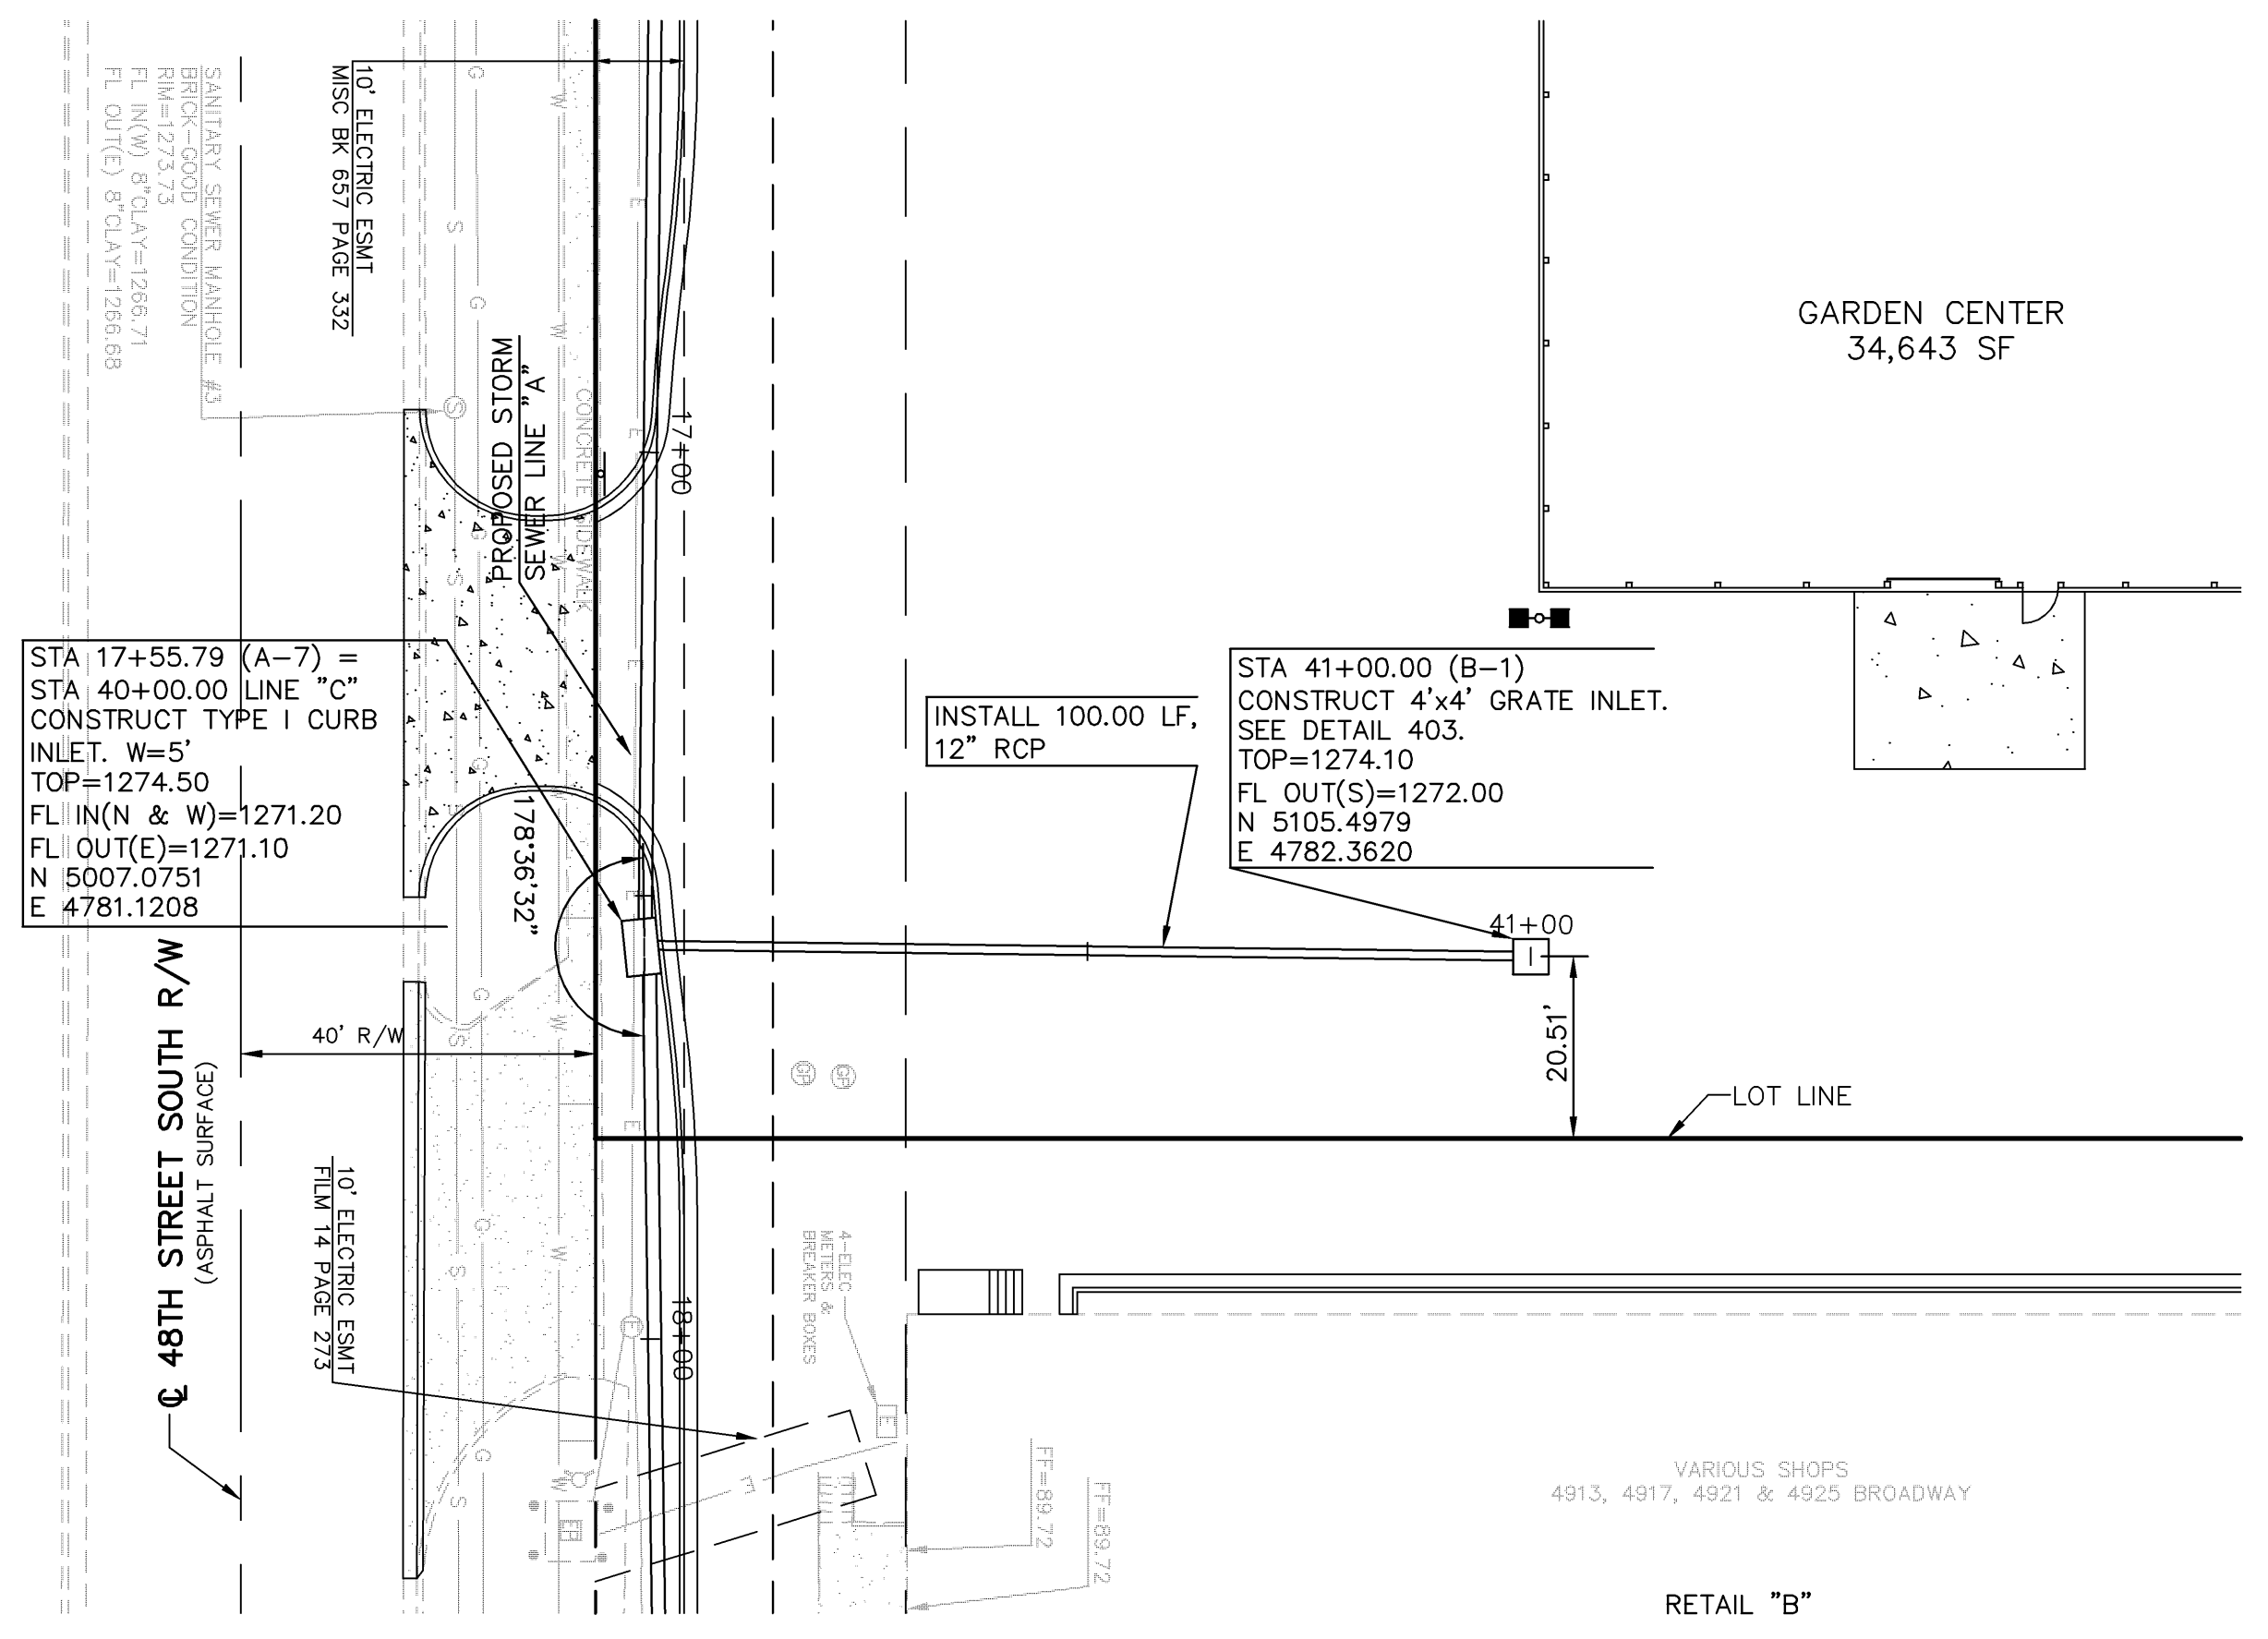


SCALE:  
 PLAN: 1"=20'  
 PROFILE: 1"=20' HORIZ  
 1"=5' VERT

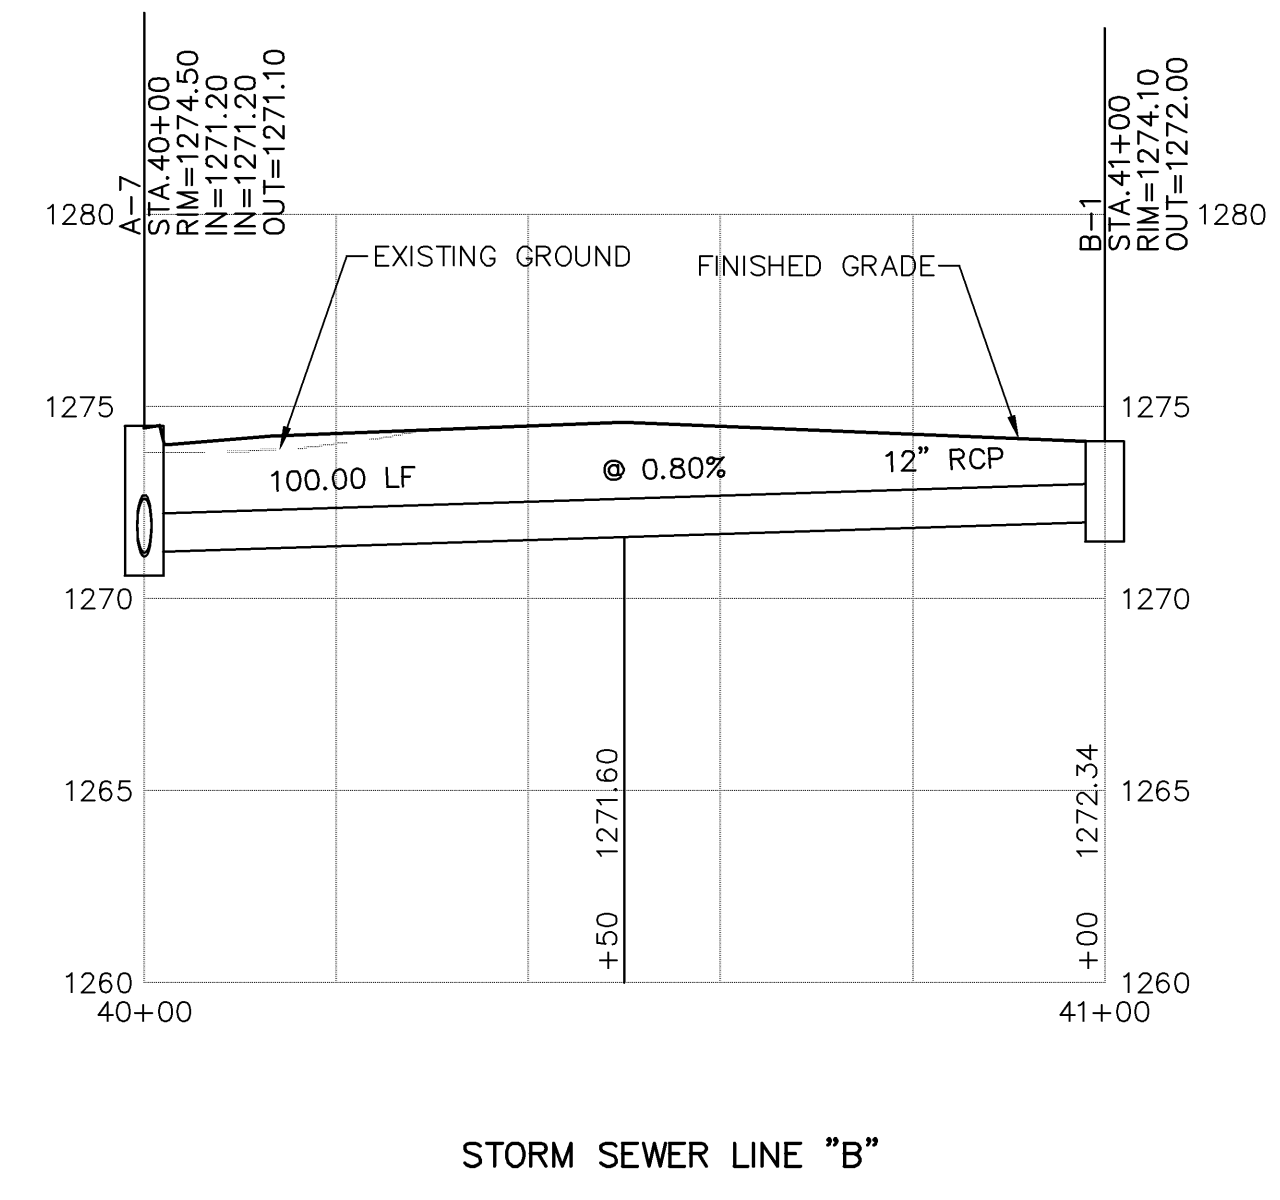

STORM SEWER LINE "B"

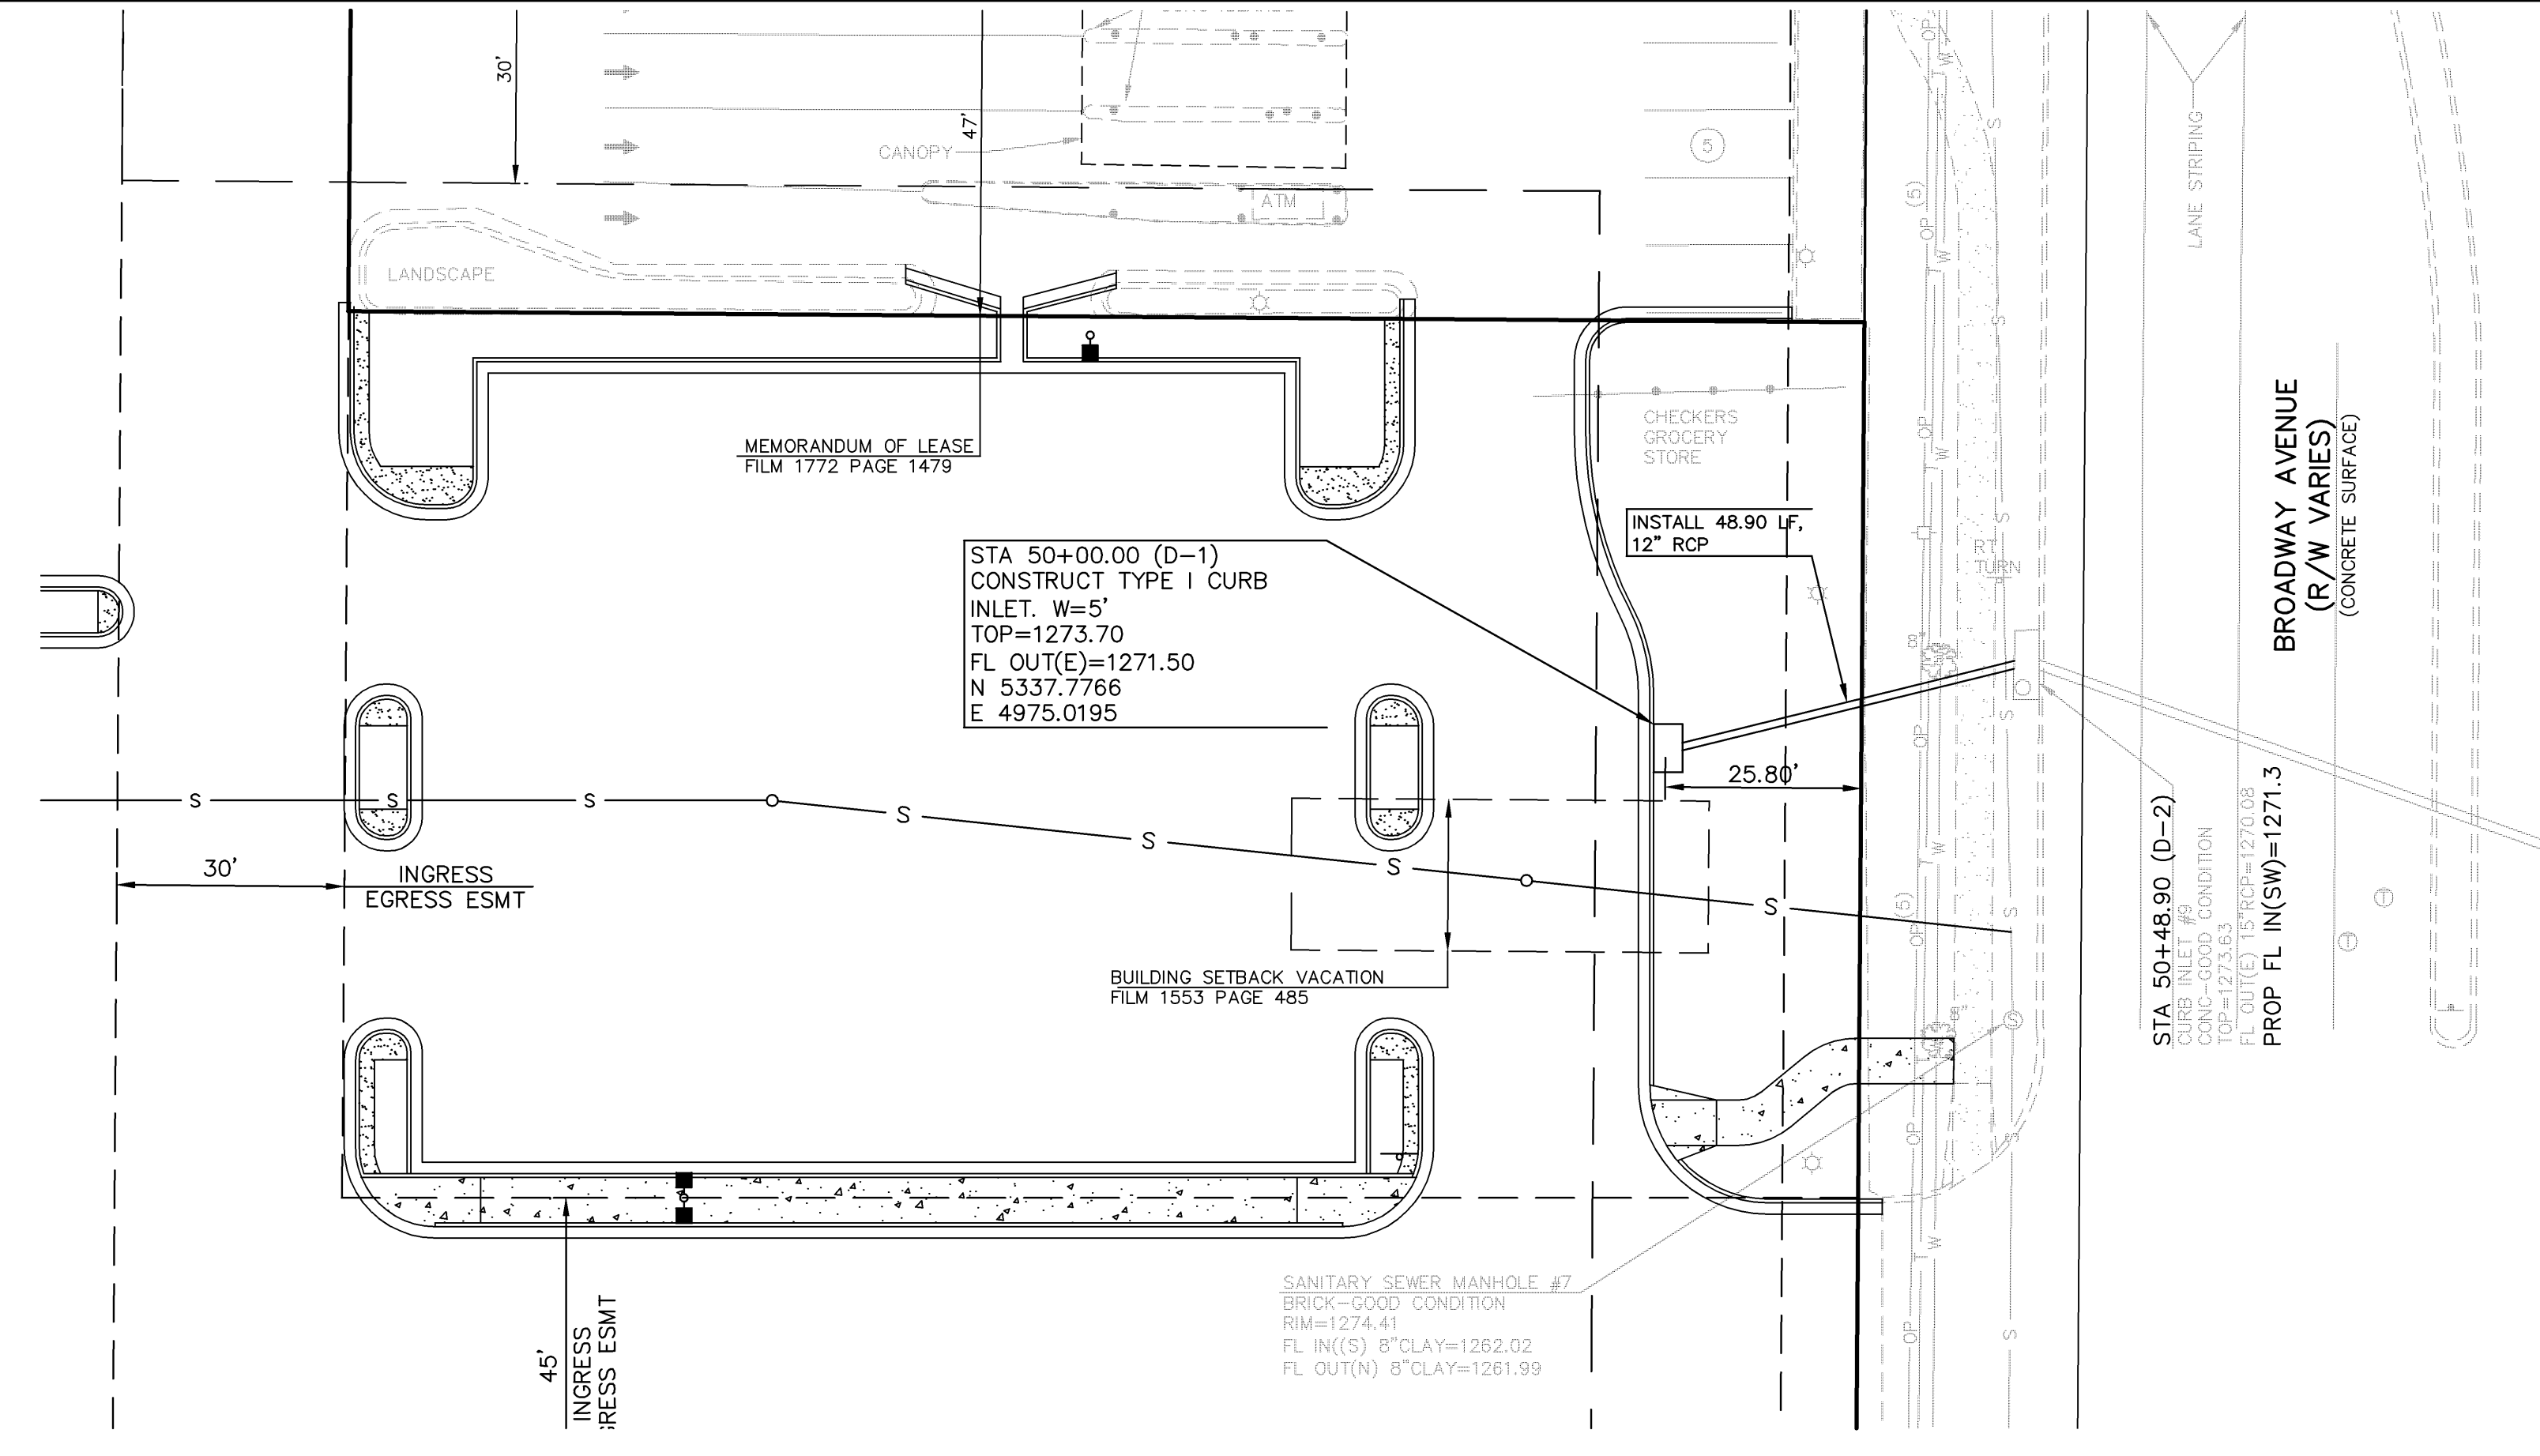



ELEVATION DATUM REVISED TO M.S.L.

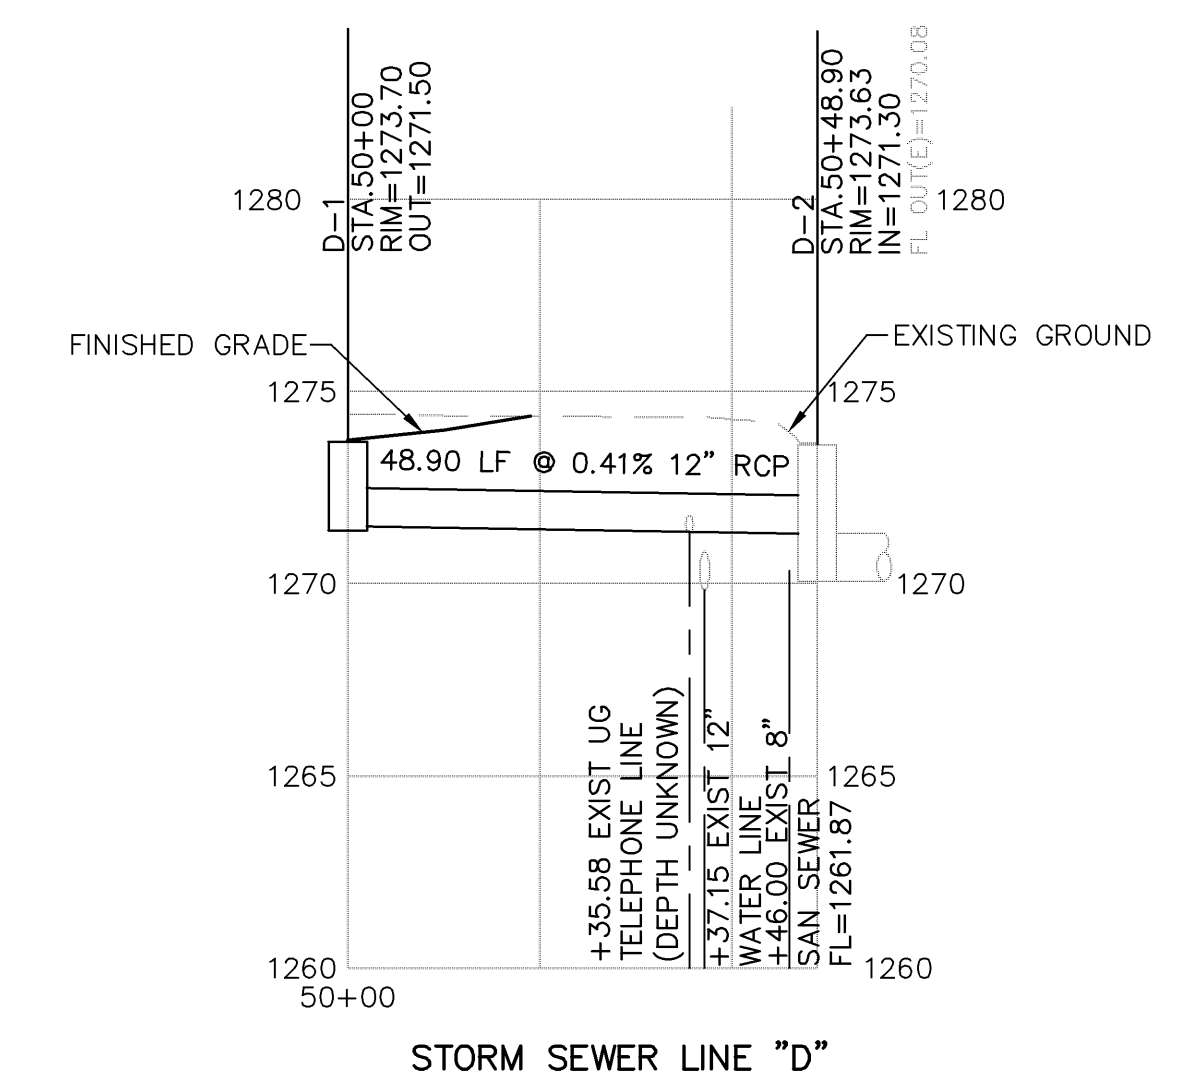


STORM SEWER LINE "D"

AS-BUILT

<b>KAW VALLEY ENGINEERING, INC. - CONSULTING ENGINEERS</b> Offices: Junction City, ks. Kansas City, Mo. Lenexa, ks.	
2319 NORTH JACKSON P.O. BOX 1304 JUNCTION CITY, KANSAS 66441 785-762-5040 FAX 785-762-7744 E-MAIL jcv@kveing.com WEB SITE www.kveing.com	
<b>THE HOME DEPOT ADDITION</b> 47TH STREET SOUTH & BROADWAY AVENUE WICHITA, KANSAS	
<b>STORM SEWER LINE "B" &amp; "D" - PLAN &amp; PROFILE</b>	
PROJ. NO.	A06_2806
DATE	AUG 2006
DESIGNER	SDM
DRAWN BY	JL
CFN	2806DPP
SHEET	4
REV	4
REV	3
REV	2
REV	1
REV	0
REV	4
REV	5
REV	6
REV	474
REV	

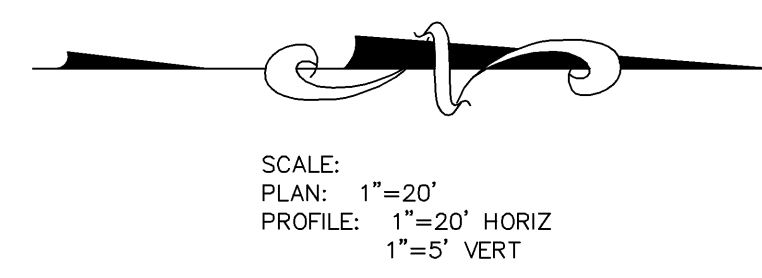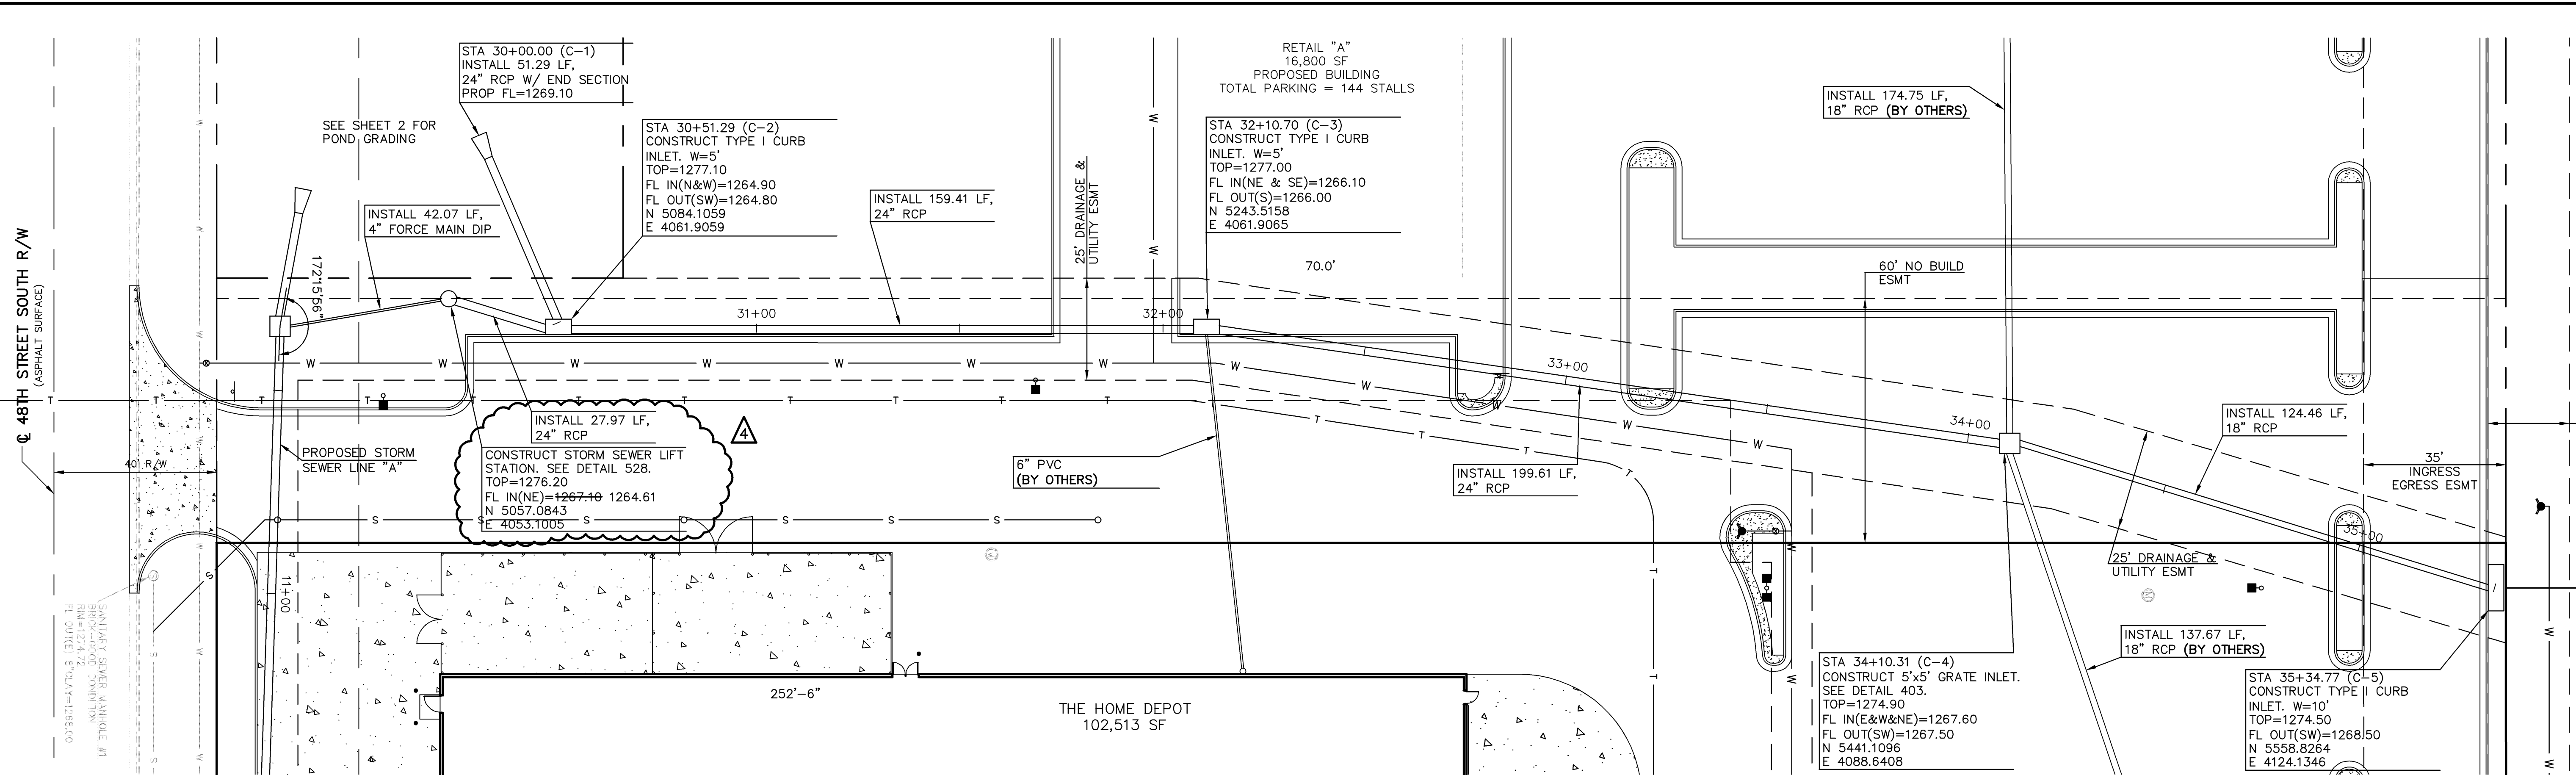

ELEVATION DATUM REVISED TO M.S.L.

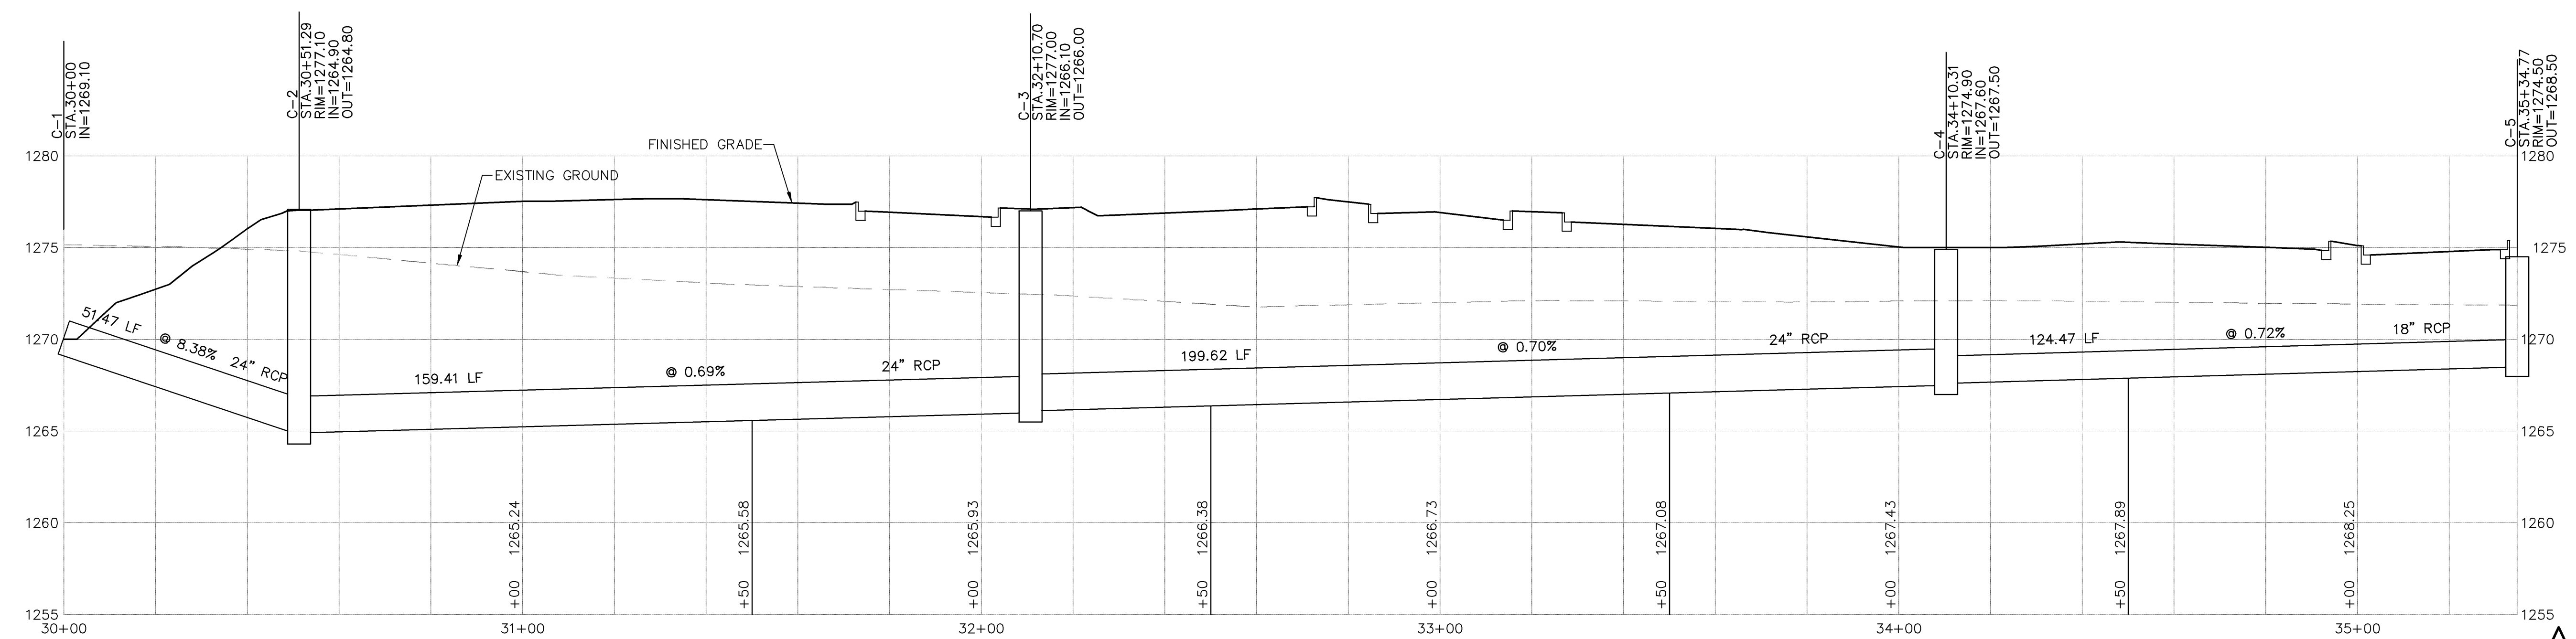

AS-BUILT

PROJ. NO.	A06 2806
DATE	AUG 2006
DESIGNER	SDM
DRAWN BY	JL
CFN	2806DPP
SHEET	7 OF 15

REV	DATE	DESCRIPTION
4	5-13-08	AS BUILT PLANS
3	2-1-08	REVISED PER ADDENDUM "A"
1	11-27-06	REVISED PER CITY
0	8-18-06	INITIAL ISSUE

**THE HOME DEPOT ADDITION**  
 47TH STREET SOUTH & BROADWAY AVENUE  
 WICHITA, KANSAS

**STORM SEWER LINE "C" - PLAN & PROFILE**

**KAW VALLEY ENGINEERING, INC.** - CONSULTING ENGINEERS  
 Offices: Junction City, ks, Kansas City, Mo., Lenexa, Ks.

2319 NORTH JACKSON  
 P.O. BOX 1304  
 JUNCTION CITY, KANSAS 66441  
 785-762-5040 FAX 785-762-7744  
 E-MAIL jc@kveing.com  
 WEB SITE www.kveing.com

Professional Engineer License No. 9772