


AS-BUILT PLANS  
 CONTRACTOR: APAC  
 INSPECTOR: JEFF CARTWRIGHT, MKEC ENGINEERING  
 PDF BY: SMB, MKEC ENGINEERING

### FOLIAGE 4TH ADDITION



### FOLIAGE 4TH ADDITION

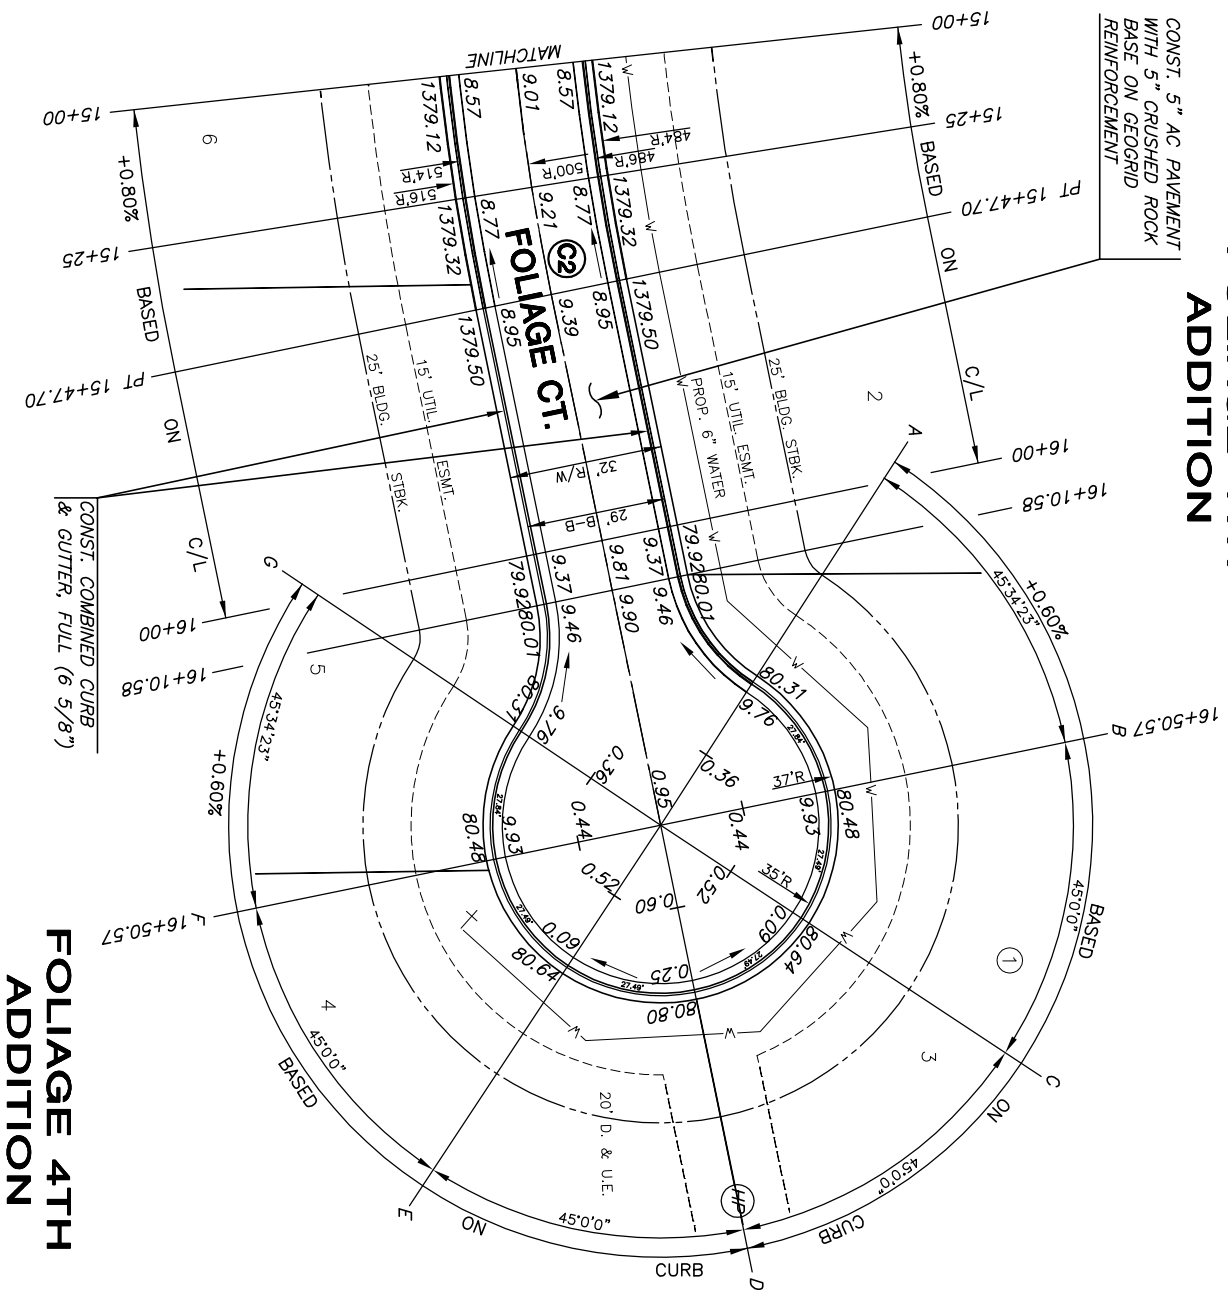

**LEGEND**

- + STREET SIGN & SIGN LOCATION  
 (SEE SIGN ASSEMBLY TABLE  
 FOR TYPE & STATION OF SIGN)
- (C1) CURVE TABLE REFERENCE
- VALLEY GUTTER

AS-BUILT MARCH 2009

**MKEC**  
 ENGINEERING  
 CONSULTANTS, INC.  
 411 N. WEBB ROAD  
 WICHITA, KS 67208  
 316-684-9600

## PAVING PLANS FOR FOLIAGE FOURTH ADDITION PHASE 1

**FOLIAGE COURT  
 PAVING**

SHEET TITLE  
 04274  
 PROJECT NUMBER

DESIGN BY: SRS  
 DRAWN BY: JWC  
 CHECKED BY: DFL

ISSUED: May 2008  
 REVISED:

SHEET NO.  
 6 of 15