
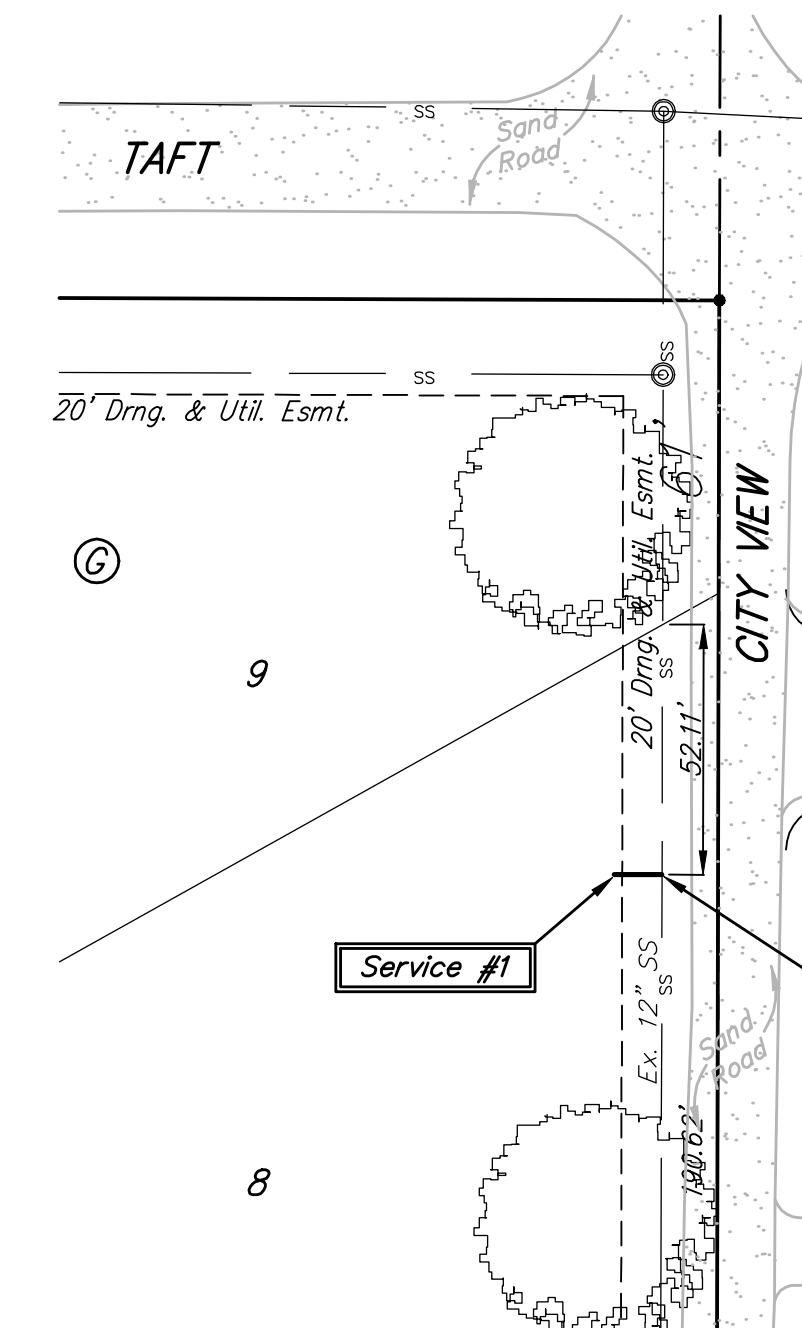


BENCHMARKS:

BM #1: "C" Cut on Top of Curb at West Line of Lot 7, Block A, Auburn Hills 5th Addition. Elev. = 207.73 (City Datum)

BM #2: Disc in Back of Curb, North of Front Corner Common to Lots 23 and 24, Block D, Auburn Hills 12th Addition. Elev. = 191.84 (City Datum)


BM #3: "C" Cut in Middle of Curb Inlet Top Adjacent to the South Corner of Lot 15, Block B. Elev. = 193.65 (City Datum)

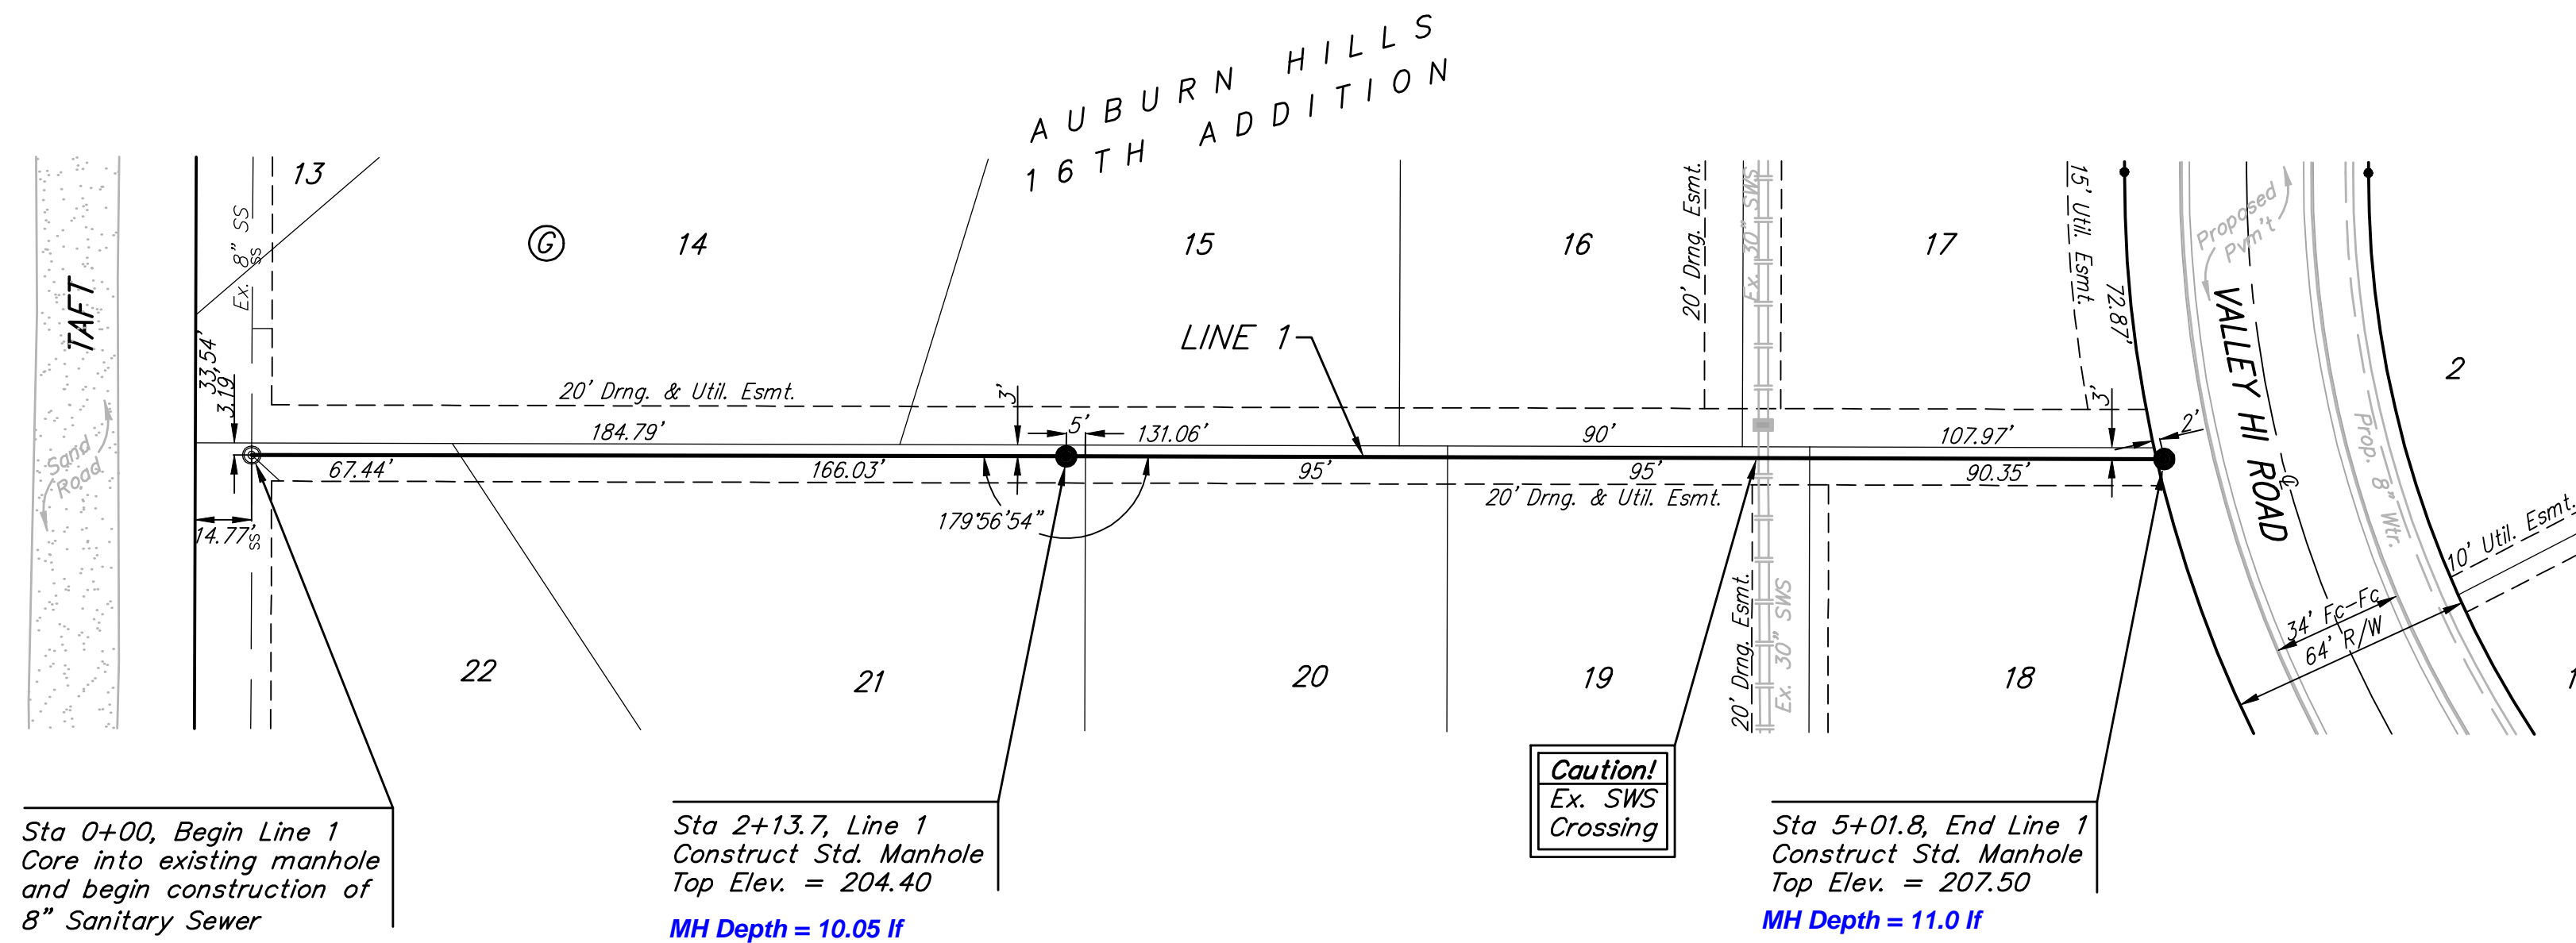

Scale: 1" = 40' Horizontal
1" = 5' Vertical
• = Iron

SEWER SERVICE TABLE

NUMBER	CONNECTION TYPE	LOCATION				FOR INFORMATION ONLY		DISTANCE FROM		
		LOT NO.	BLOCK NO.	LINE NO.	STATION/DIRECTION	APPROXIMATE LENGTH 4" PIPE	VERTICAL	HORIZONTAL	MAIN TO RISER (LT./RT.)	UPSTREAM MH
1	12" x 4" Tee	8	G	N/A	N/A	4	10			

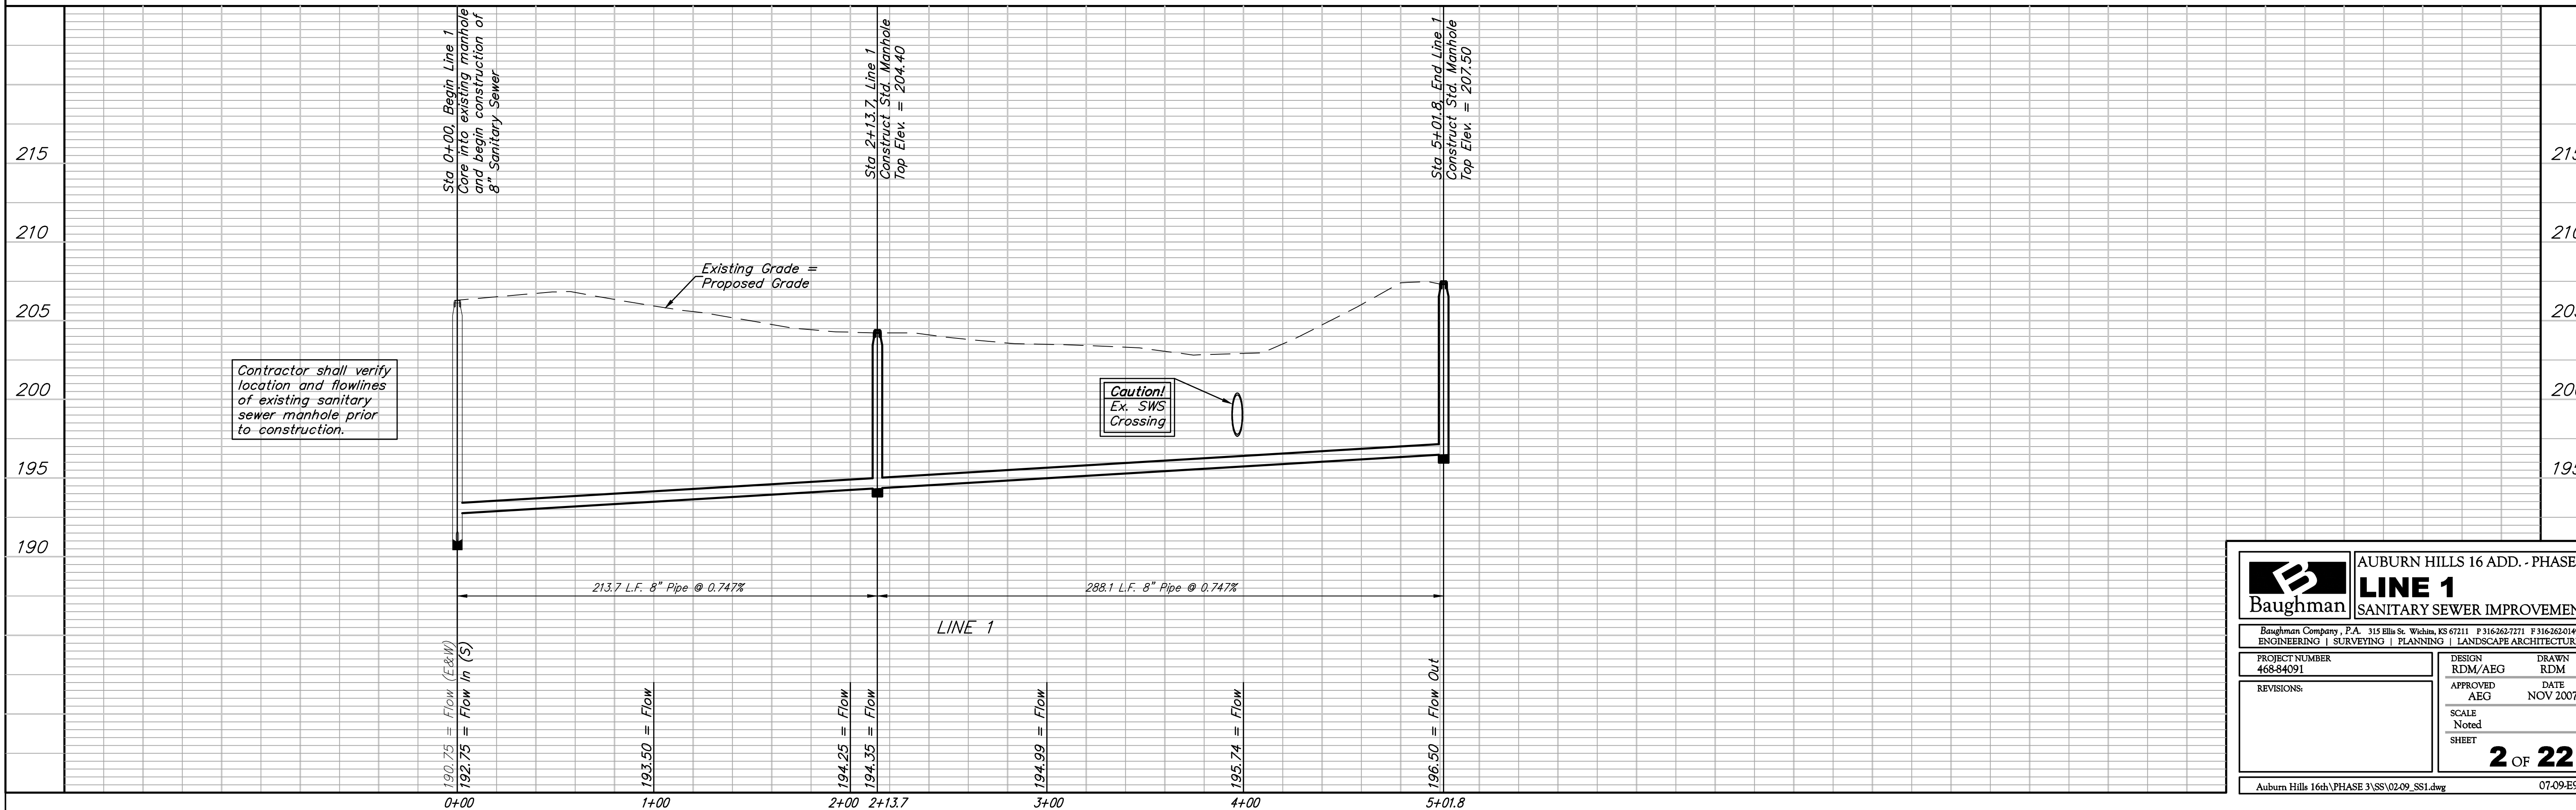

Baughman AUBURN HILLS 16 ADD. - PHASE 3
LINE 1
SANITARY SEWER IMPROVEMENTS

Baughman Company, P.A. 315 Ellis St. Wichita, KS 67211 P 316-262-7271 F 316-262-0149
ENGINEERING | SURVEYING | PLANNING | LANDSCAPE ARCHITECTURE

PROJECT NUMBER 468-84091	DESIGN RDM/AEG	DRAWN RDM
APPROVED AEG	DATE NOV 2007	
REVISIONS:	SCALE Noted	SHEET 2 OF 22

Auburn Hills 16th\PHASE 3\SS\0209_SSI.dwg 07-09-E926