


# LATERAL 26, MAIN 19 OF THE SOUTHWEST INTERCEPTOR SEWER IN THE CITY OF WICHITA, KANSAS

OCA NO. 744237  
CITY OF WICHITA PROJECT NO. 468-84216  
JAMES L. ARMOUR, P.E. - CITY ENGINEER

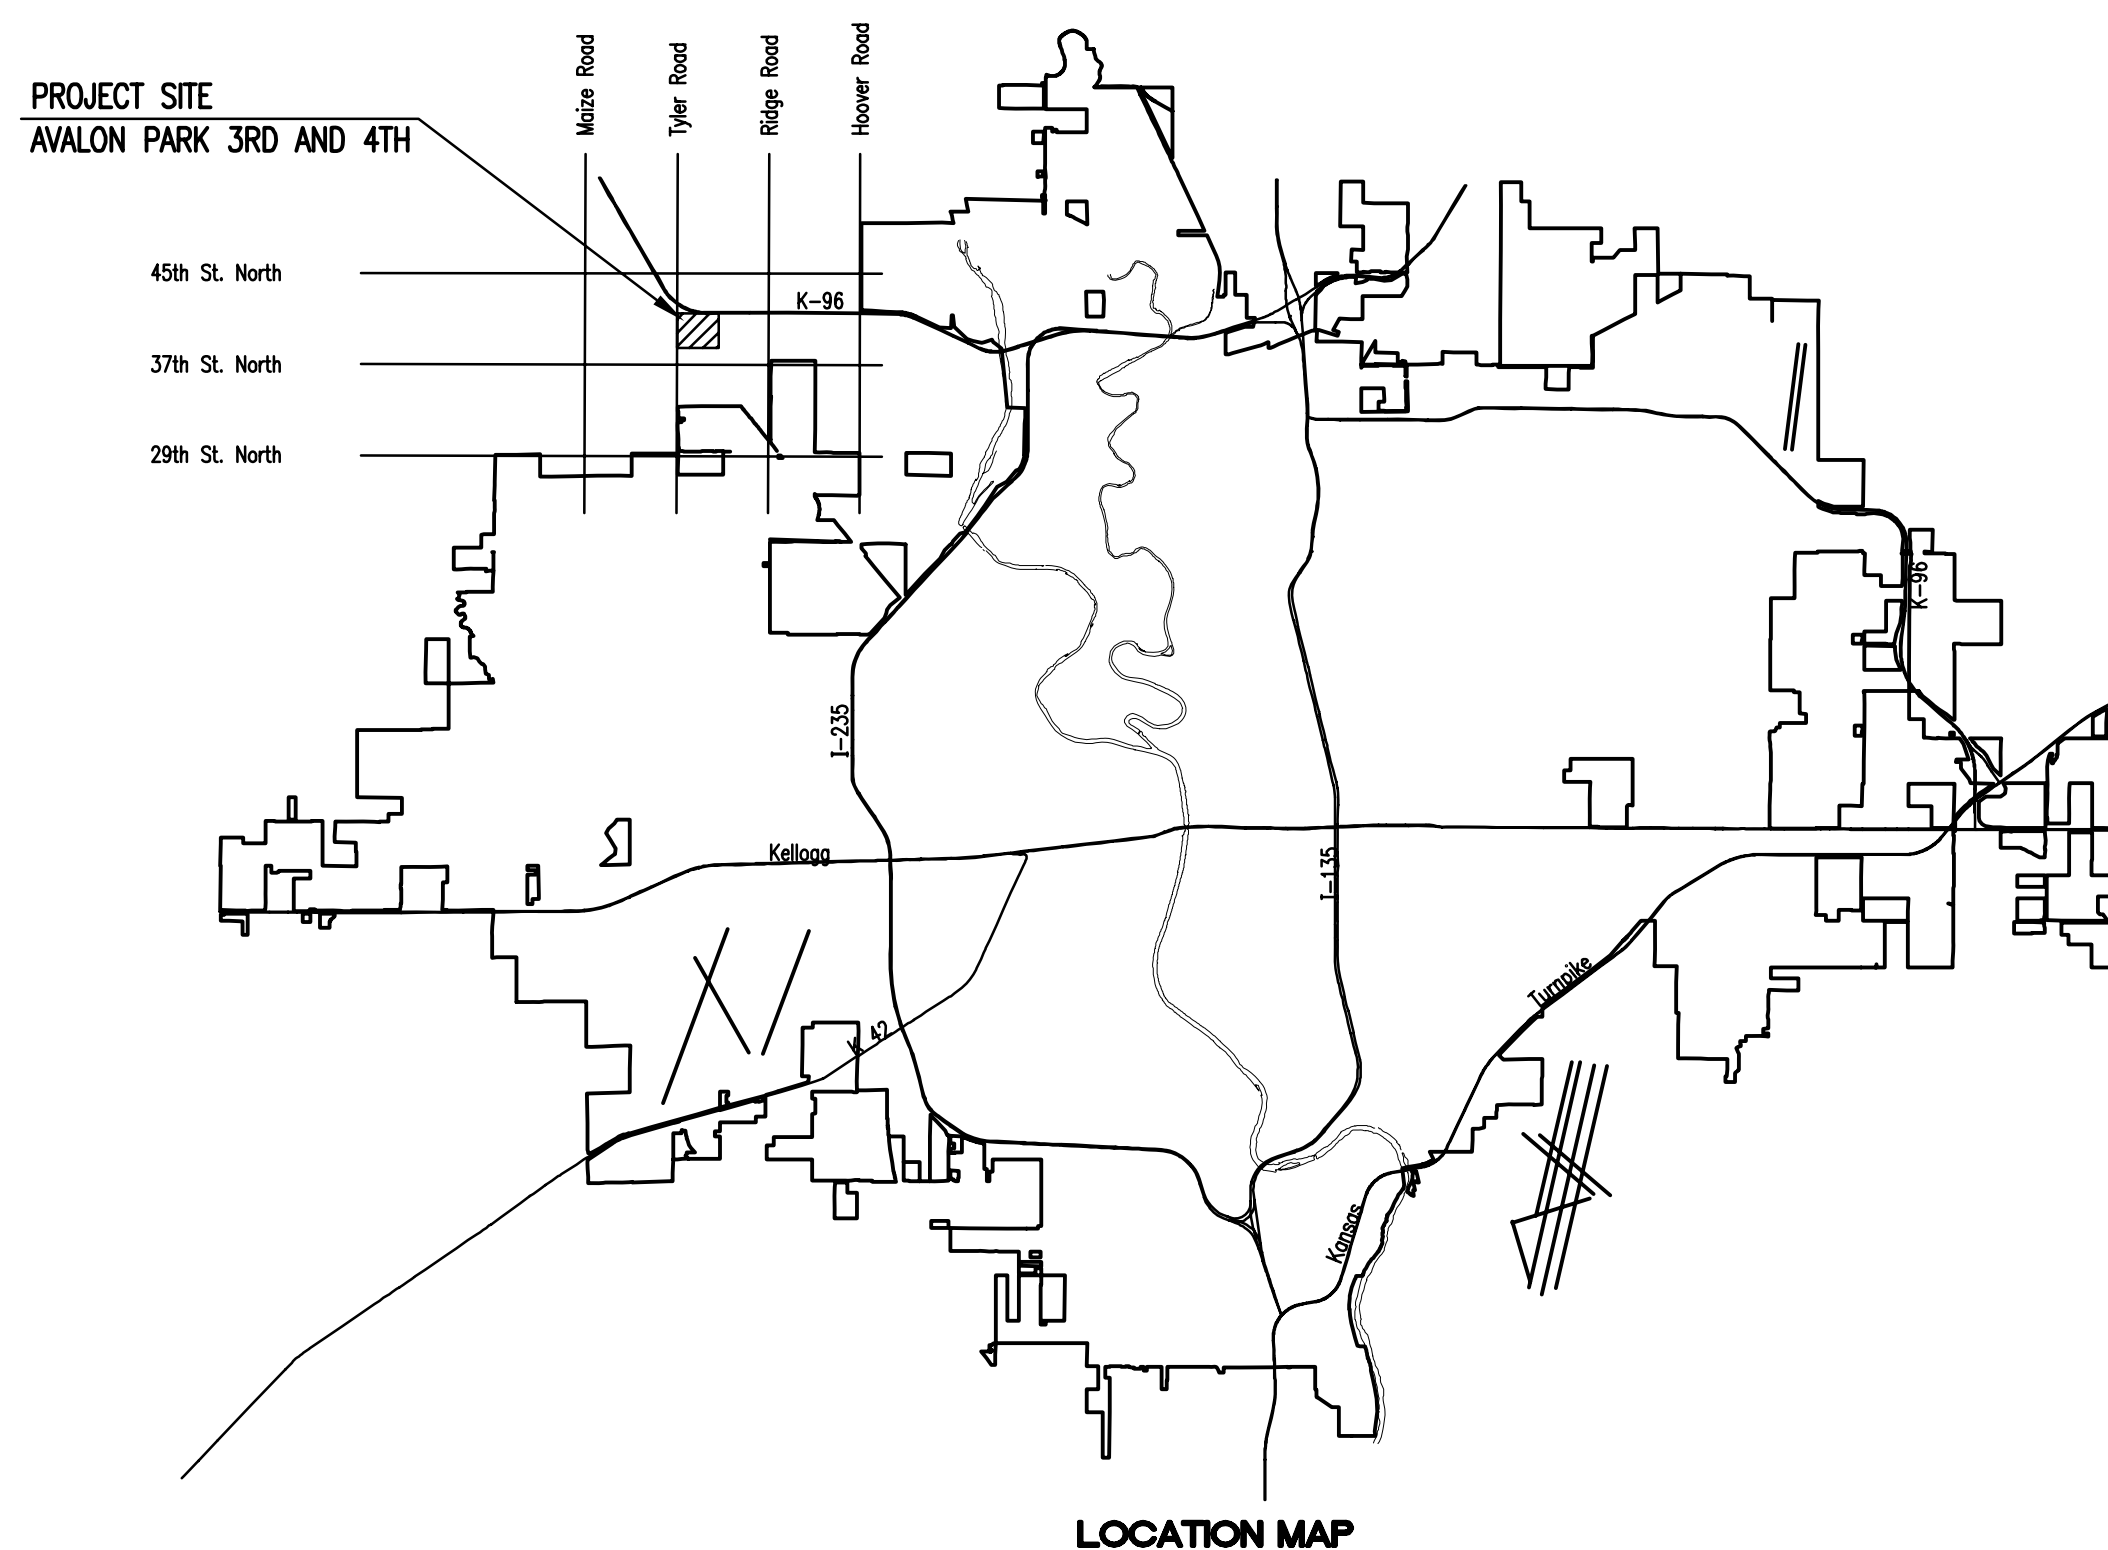

**INDEX OF SHEETS**

SHEET NO. 1	TITLE SHEET
SHEET NO. 2	KEY MAP AND GENERAL NOTES
SHEET NO. 3-4	PLATS
SHEET NO. 5	PROJECT COORDINATES
SHEET NO. 6-12	PLAN/PROFILE
SHEET NO. 13	TYPE "P" MANHOLE DETAILS
SHEET NO. 14	FRAME & COVER DETAILS
SHEET NO. 15	RISER DETAILS
SHEET NO. 16-19	SOIL EROSION BMP DETAILS

**CONSTRUCTION SCHEDULE/SEQUENCE**

THE CONTRACTOR FOR EACH OF THE FOLLOWING AVALON PARK 3RD AND 4TH PROJECTS SHALL COORDINATE THEIR EFFORTS WITH OTHER CONTRACTORS PERFORMING WORK IN THIS AREA SUCH THAT ANY NECESSARY SIMULTANEOUS CONSTRUCTION CAN PROCEED CONCURRENTLY WITHOUT CAUSING UNDUE DELAYS SO THAT CONSTRUCTION CAN BE COMPLETED WITHIN THE TIME FRAMES AS NOTED.

**SANITARY SEWER (468-84216)**  
THE CONTRACTOR SHALL SEQUENCE HIS WORK TO COMPLETE, INCLUDING TESTING AND ACCEPTANCE, THE FOLLOWING WORK: LINE 1 IN ITS ENTIRETY, LINE 3 IN ITS ENTIRETY, LINE 4 IN ITS ENTIRETY, AND THEN COMPLETE ALL REMAINING WORK. ALL WORK ON THE AVALON PARK 3RD AND 4TH - PHASE 1 SANITARY SEWER PROJECT SHALL BE COMPLETED BY SEPTEMBER 11, 2007.

**WATER DISTRIBUTION SYSTEM (448-90225)**  
THE CONTRACTOR SHALL COMPLETE THE AVALON PARK 3RD AND 4TH - PHASE 1 WATERLINE CONSTRUCTION BY OCTOBER 01, 2007. THE CONTRACTOR SHALL COORDINATE INSTALLATION OF WATERLINES WITH THE PAVING CONTRACTOR SO THAT STORM SEWERS CROSSING BELOW PROPOSED WATERLINES WILL BE INSTALLED PRIOR TO WATERLINE CONSTRUCTION.

**STORM WATER DRAIN (468-84217)**  
THE CONTRACTOR SHALL COMPLETE AVALON PARK 3RD AND 4TH - PHASE 3 STORM WATER DRAIN CONSTRUCTION BY OCTOBER 14, 2007.

**STREETS/DRAINAGE (472-84441)**  
THE CONTRACTOR SHALL COMPLETE AVALON PARK 3RD AND 4TH - PHASE 1 STREETS/DRAINAGE CONSTRUCTION BY DECEMBER 15, 2007. THE CONTRACTOR SHALL COORDINATE INSTALLATION OF STORM SEWERS WITH THE WATERLINE CONTRACTOR SO THAT STORM SEWERS CROSSING BELOW PROPOSED WATERLINES WILL BE INSTALLED PRIOR TO WATERLINE CONSTRUCTION.

Utility Contractors, Inc. - Contractor  
Woods, City - Inspector  
Released 1/2/08  
As-Built  
Risers & Stubs  
.pdf by JDL 1/16/08

**JUNE 2007**  
PLANS PREPARED BY  
**PROFESSIONAL ENGINEERING CONSULTANTS, P.A.**  
ENGINEERS  
WICHITA, KANSAS