

STORM WATER SEWER PLANS
THE GROVE AT WICHITA
LOT 1, BLOCK 1 CAMPUS CREST


LINE 1
SHEET TITLE
07008 (CC)
07254 (MKEC)
PROJECT NUMBER

DESIGN BY
SRS
DRAWN BY
JWC
CHECKED BY
GJA

ISSUED
DECEMBER 2007
REVISED
MARCH 2008


SHEET NO.
5 of 15

**CAMPUS CREST
ADDITION**

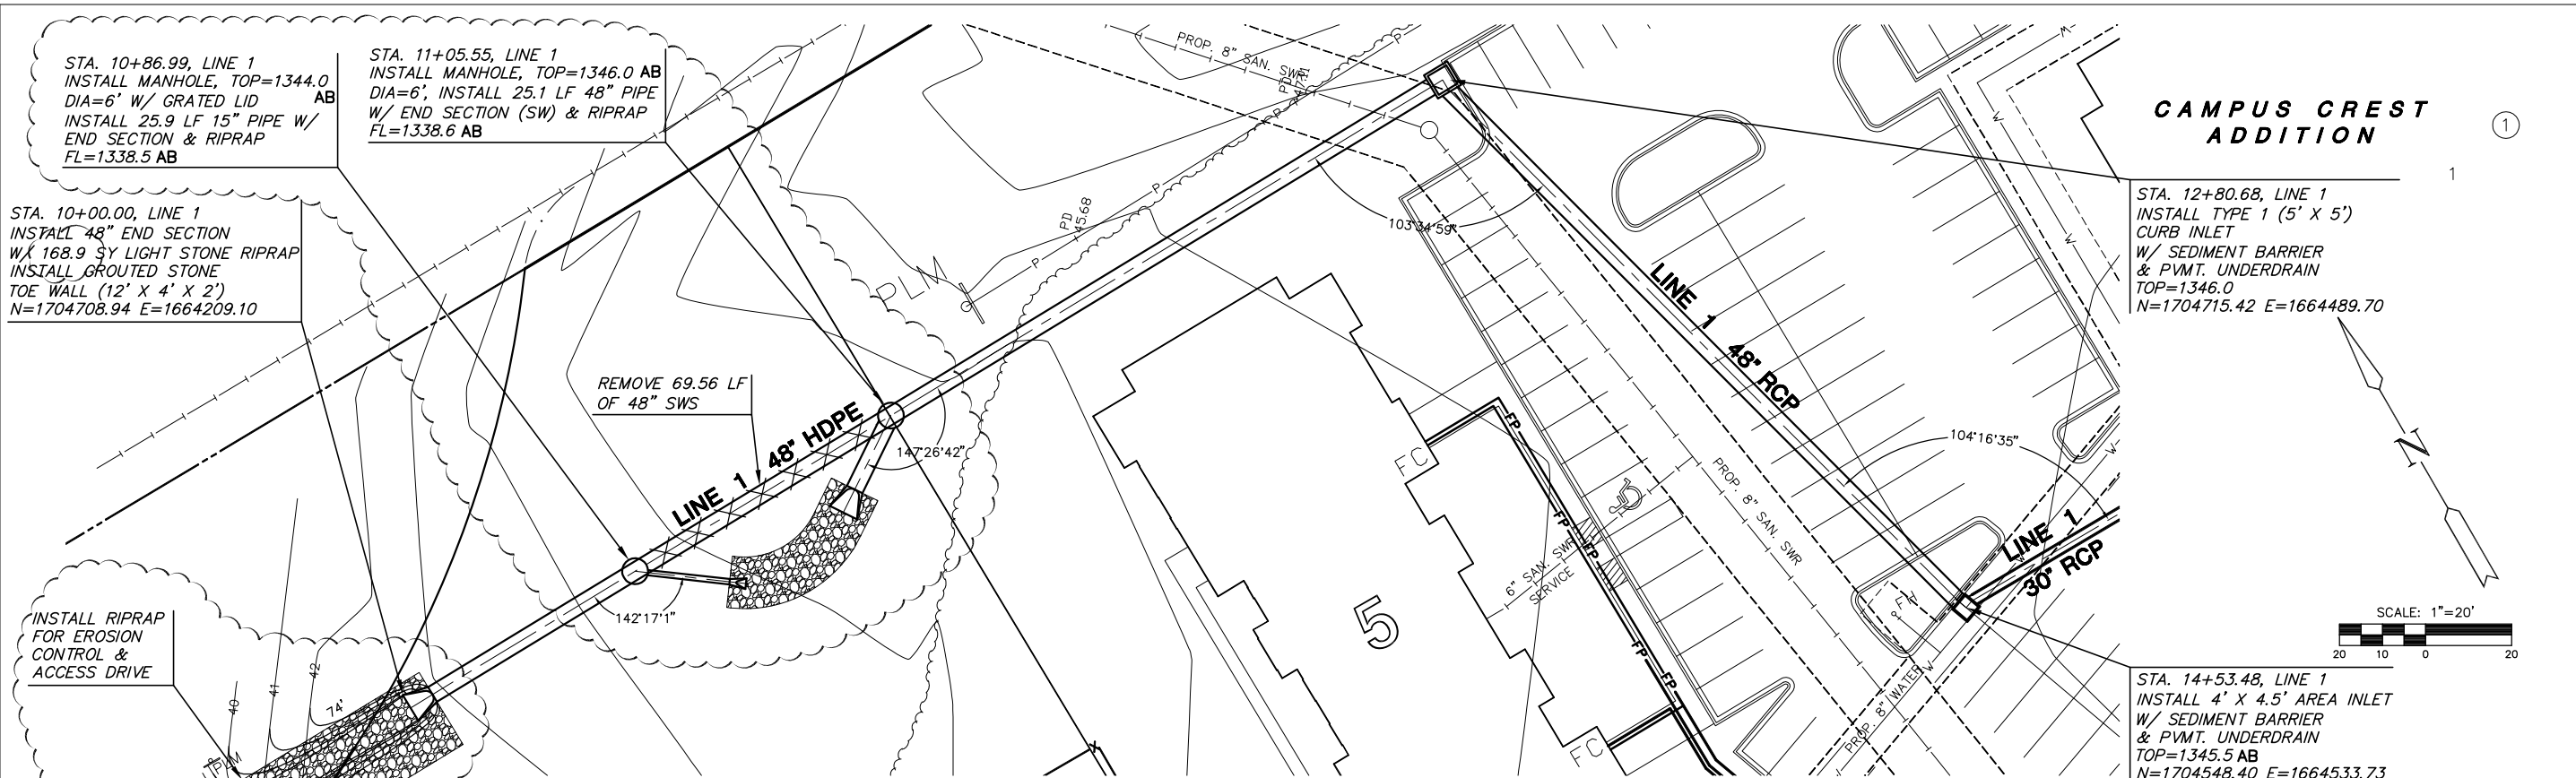

STA. 12+80.68, LINE 1
INSTALL TYPE 1 (5' X 5')
CURB INLET
W/ SEDIMENT BARRIER
& PVMT. UNDERDRAIN
TOP=1346.0
N=1704715.42 E=1664489.70


STA. 14+53.48, LINE 1
INSTALL 4' X 4.5' AREA INLET
W/ SEDIMENT BARRIER
& PVMT. UNDERDRAIN
TOP=1345.5 AB
N=1704548.40 E=1664533.73

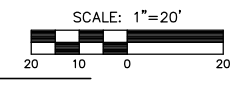

AS-BUILT 4-1-09
REVISED: 3-7-08

PROFILE LINE 1

SCALE: HORIZ. 1"=20'
SCALE: VERT. 1"=5'

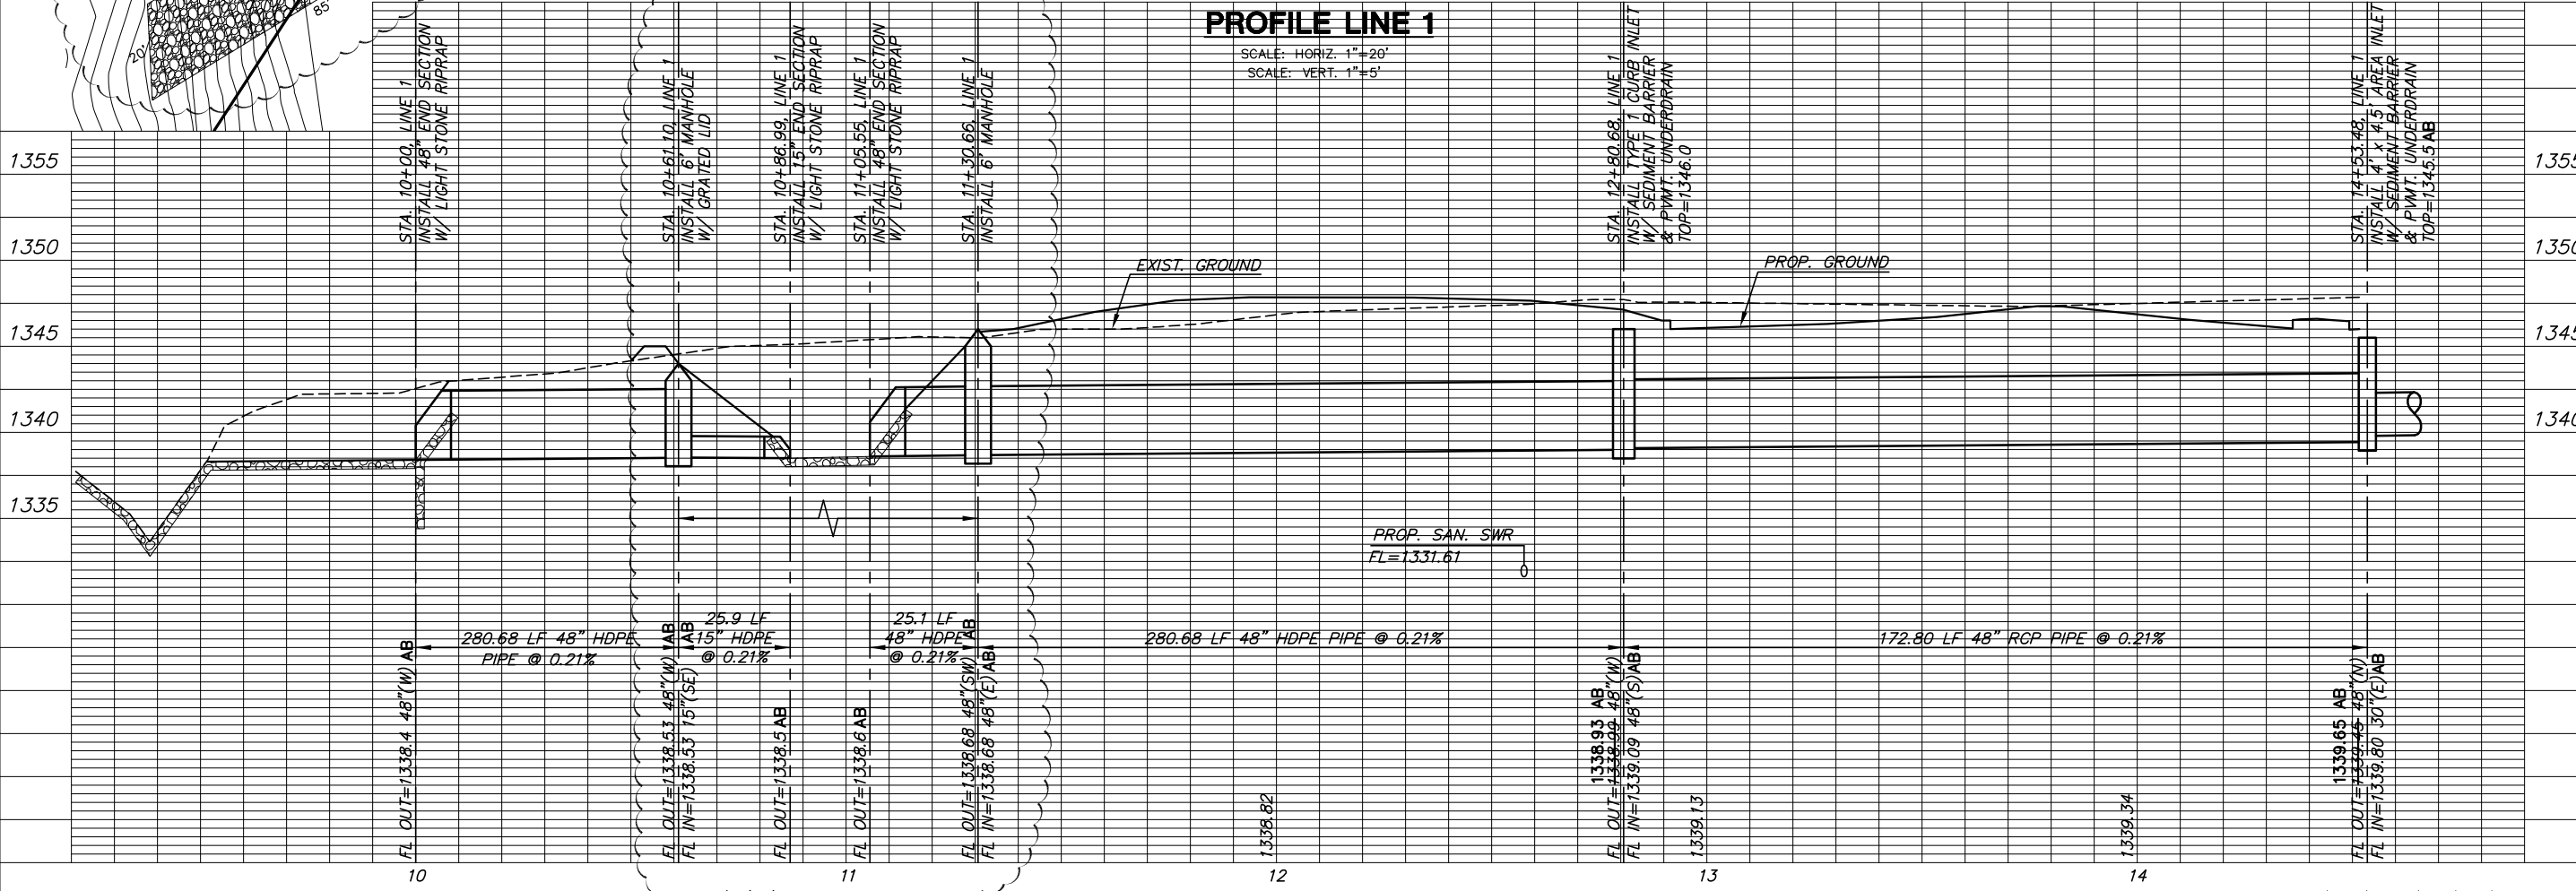

PLOTTED: Thursday, April 02, 2009 @ 02:50PM