


**STORM WATER SEWER PLANS**  
**THE GROVE AT WICHITA**

LOT 1, BLOCK 1 CAMPUS CREST

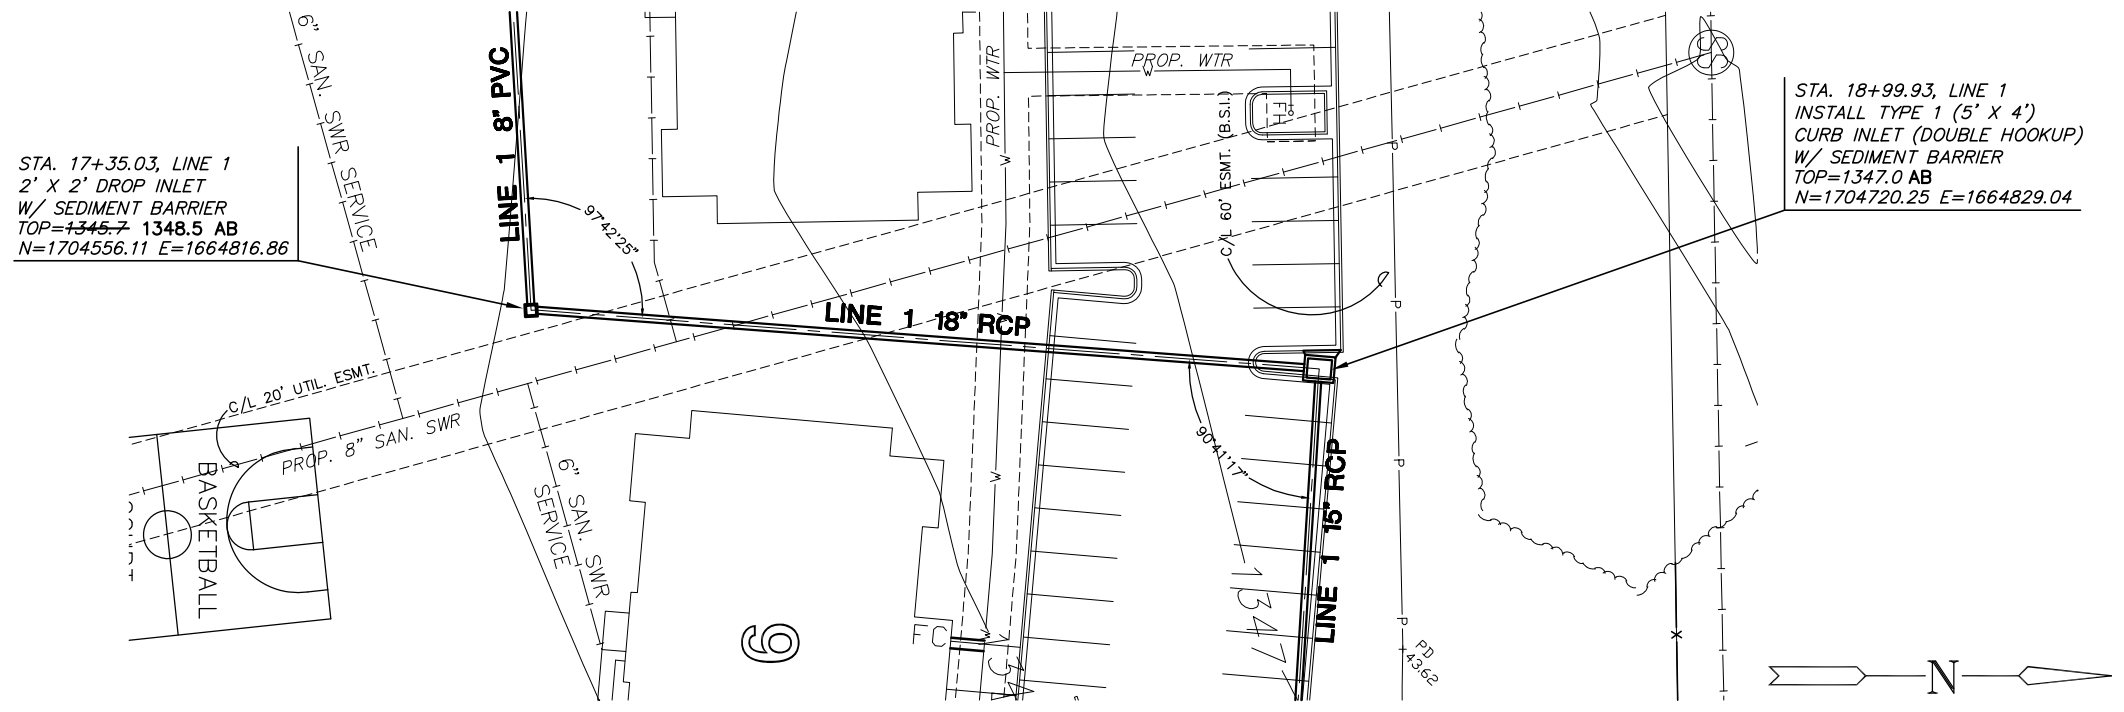


**PLAN LINE 1 (CONT.)**



**AS-BUILT 4-1-09**

**PROFILE LINE 1**

SCALE: HORIZ. 1"=20'  
SCALE: VERT. 1"=5'

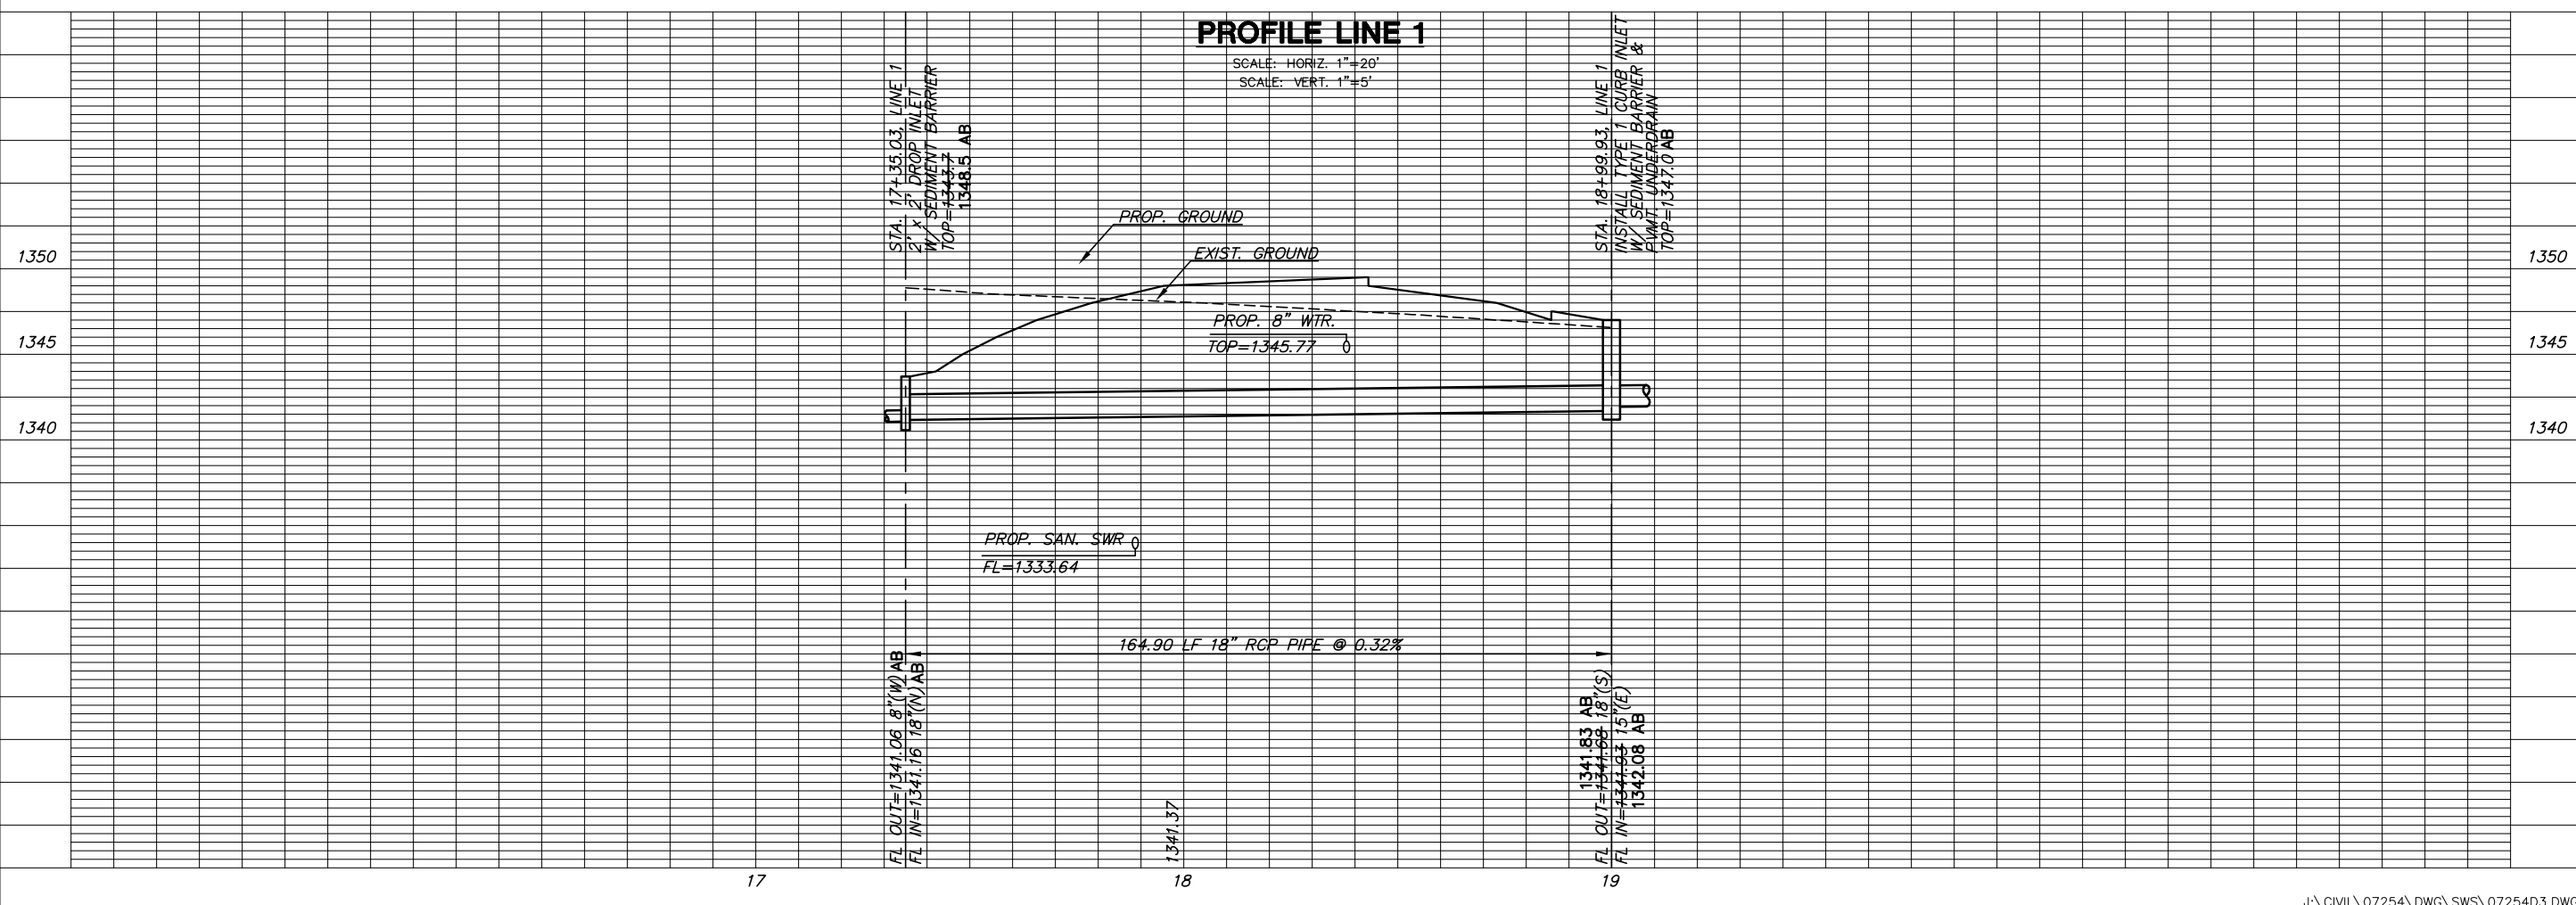

**LINE 1**  
SHEET TITLE  
07008 (CC)  
07254 (MKEC)  
PROJECT NUMBER

DESIGN BY  
**SRS**

DRAWN BY  
**JWC**

CHECKED BY  
**GJA**

ISSUED  
**DECEMBER 2007**

REVISED  
**MARCH 2008**

SHEET NO.  
**7 of 15**