


LINE 1
SHEET TITLE
07008 (CC)
07254 (MKEC)
PROJECT NUMBER

DESIGN BY SRS
DRAWN BY JWC
CHECKED BY GJA


ISSUED DECEMBER 2007
REVISED MARCH 2008

SHEET NO.
9 of 15

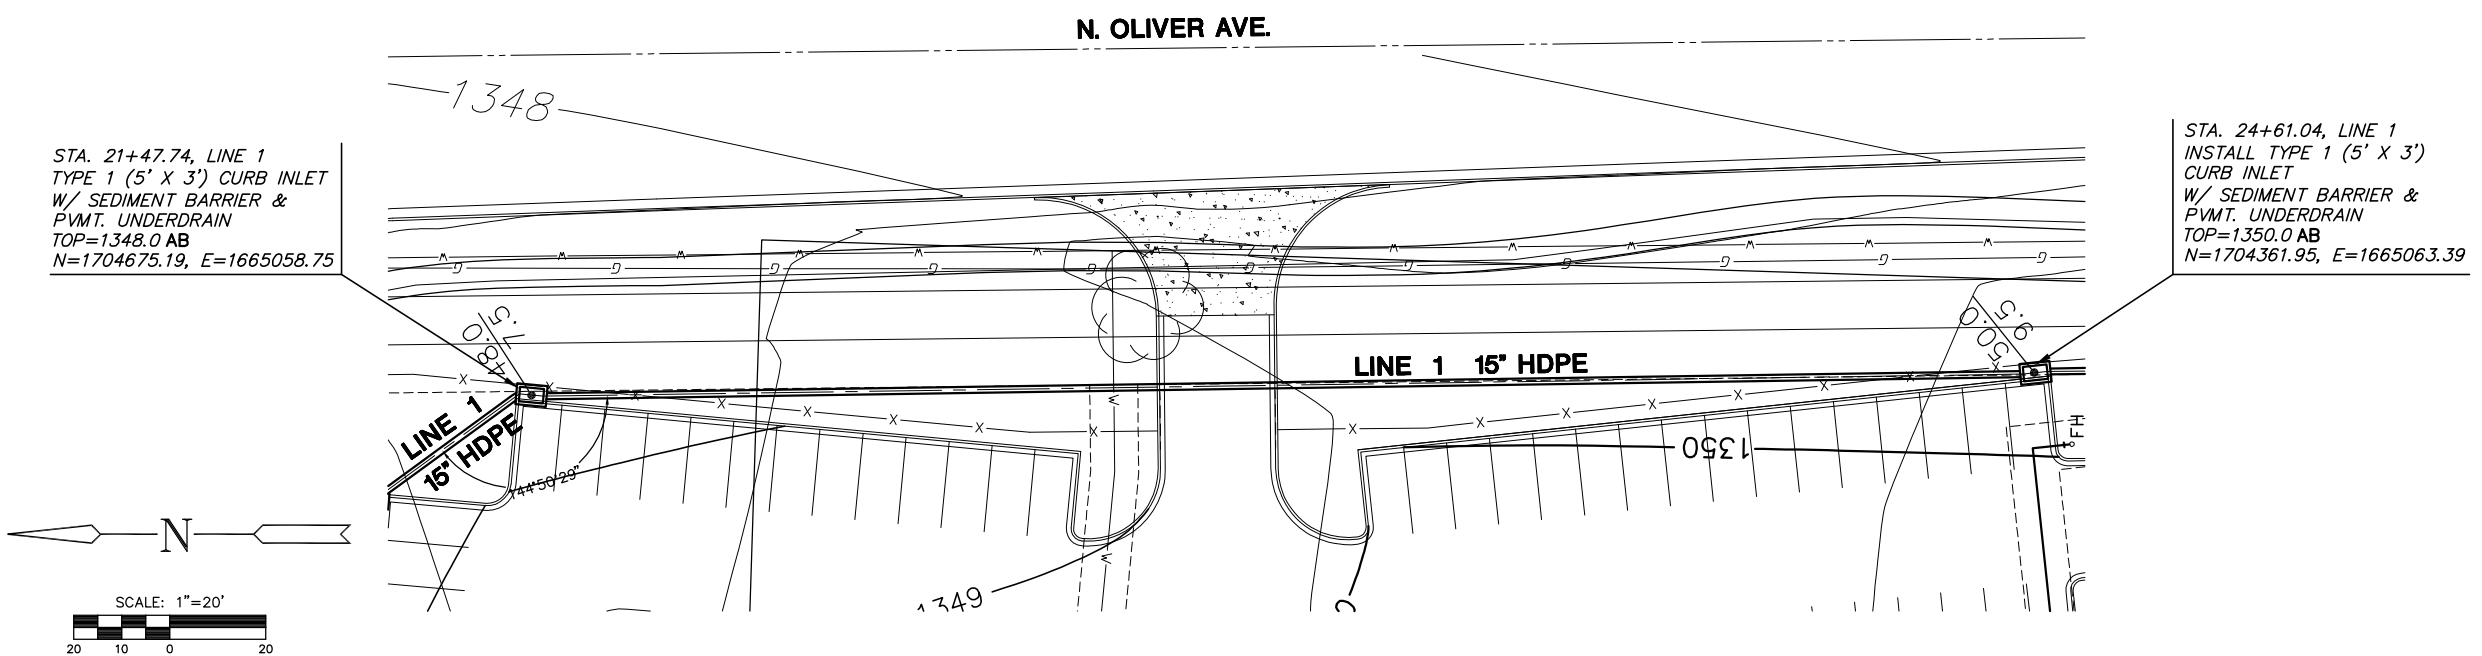


STA. 21+47.74, LINE 1
TYPE 1 (5' X 3') CURB INLET
W/ SEDIMENT BARRIER &
PVT. UNDERDRAIN
TOP=1348.0 AB
N=1704675.19, E=1665058.75

STA. 24+61.04, LINE 1
INSTALL TYPE 1 (5' X 3')
CURB INLET
W/ SEDIMENT BARRIER &
PVT. UNDERDRAIN
TOP=1350.0 AB
N=1704361.95, E=1665063.39

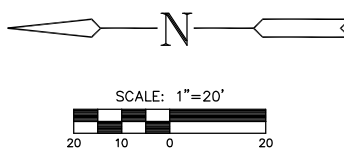

PLAN LINE 1 (CONT.)

AS-BUILT 4-1-09

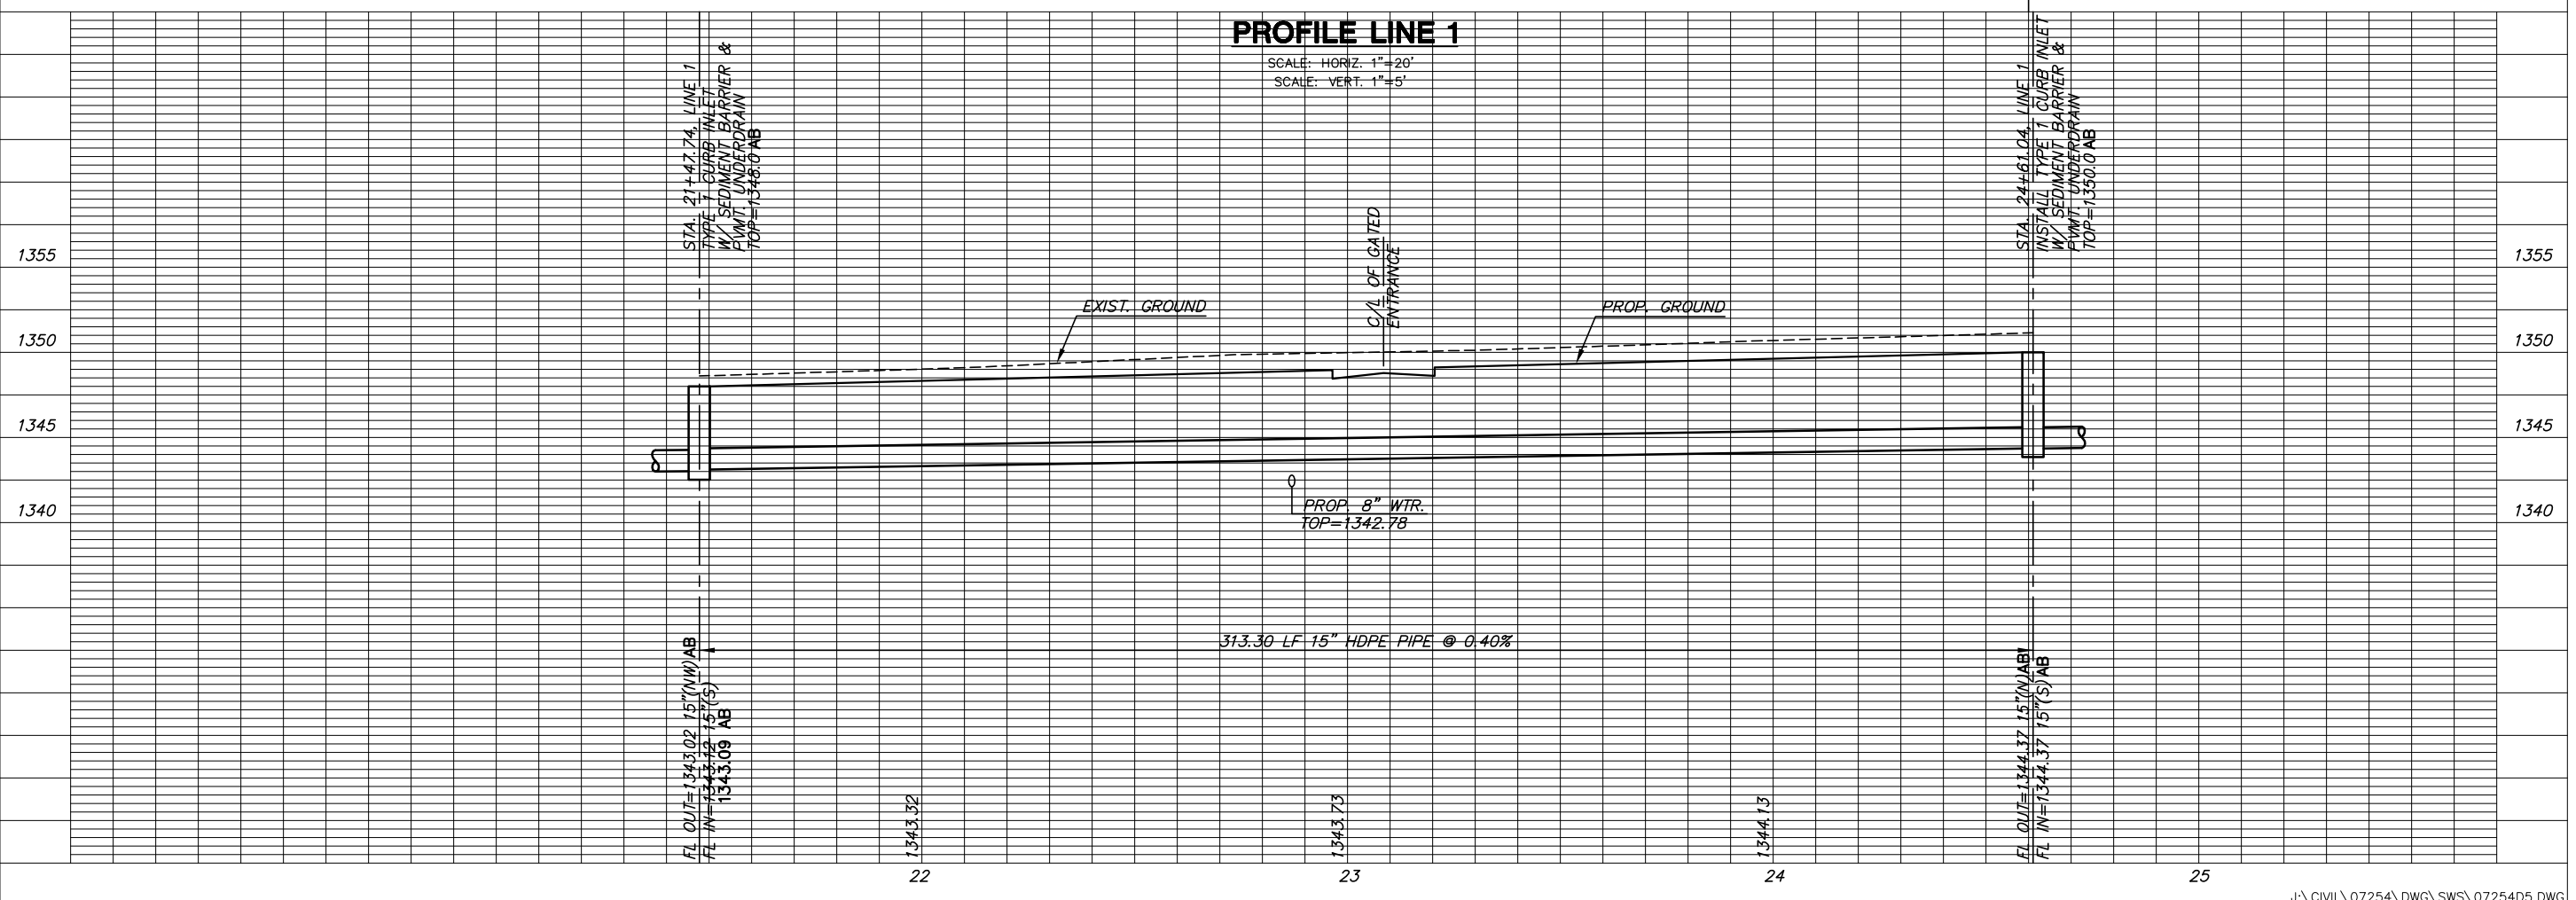

PROFILE LINE 1
SCALE: HORIZ. 1"=20'
SCALE: VERT. 1"=5'

PLOTTED: Thursday, April 02, 2009 @ 02:51PM