

LINE 1
SHEET TITLE
07008 (CC)
07254 (MKEC)
PROJECT NUMBER


DESIGN BY **SRS**
DRAWN BY **JWC**
CHECKED BY **GJA**

ISSUED **DECEMBER 2007**
REVISED **MARCH 2008**

SHEET NO.
10 of 15

STA. 24+61.04, LINE 1
INSTALL TYPE 1 (5' X 3')
CURB INLET
W/ SEDIMENT BARRIER &
P.V.M.T. UNDERDRAIN
TOP=1350.0 AB
N=1704361.95, E=1665063.39

STA. 26+81.70, LINE 1
INSTALL TYPE 1 (5' X 3')
CURB INLET
W/ SEDIMENT BARRIER &
P.V.M.T. UNDERDRAIN
TOP=1349.0 AB
N=1704141.33, E=1665066.89

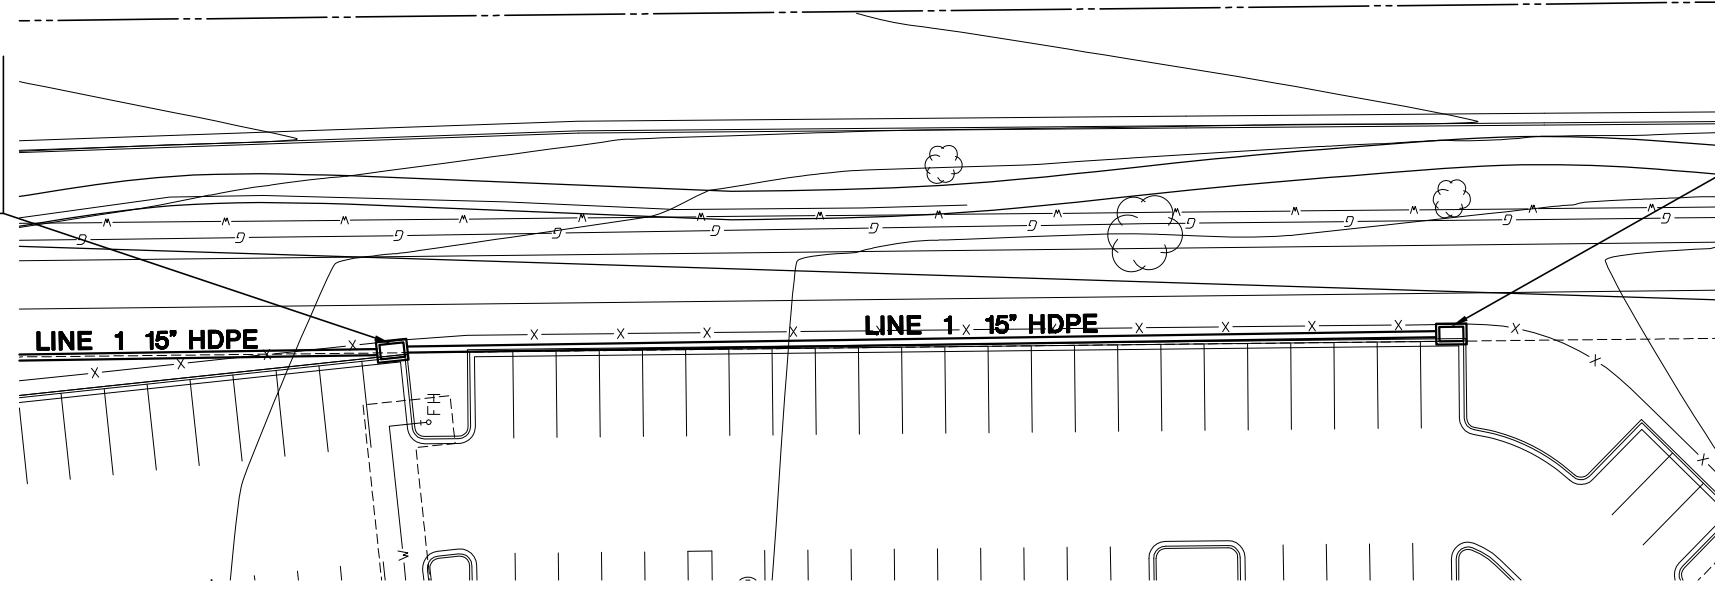

PLAN LINE 1 (CONT.)

AS-BUILT 4-1-09

PROFILE LINE 1

SCALE: HORIZ. 1"=20'
SCALE: VERT. 1"=5'

