


STA. 12+81.46, LINE 2  
2' X 4' DROP INLET  
W/ SEDIMENT BARRIER &  
PVT. UNDERDRAIN  
TOP=1346.0 1345.74 AB  
N=1704333.75 E=1664611.56


STA. 13+31.59, LINE 2  
INSTALL 2' X 4' DROP INLET  
W/ SEDIMENT BARRIER &  
PVT. UNDERDRAIN  
TOP=1346.0 1345.8 AB  
N=1704284.18 E=1664618.87

STA. 15+69.92, LINE 2  
INSTALL 2' X 4' DROP INLET  
W/ SEDIMENT BARRIER &  
PVT. UNDERDRAIN  
TOP=1345.5 AB  
N=1704048.54 E=1664654.63

**PLAN LINE 2 (CONT.)**

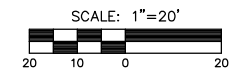

**AS-BUILT 4-1-09**

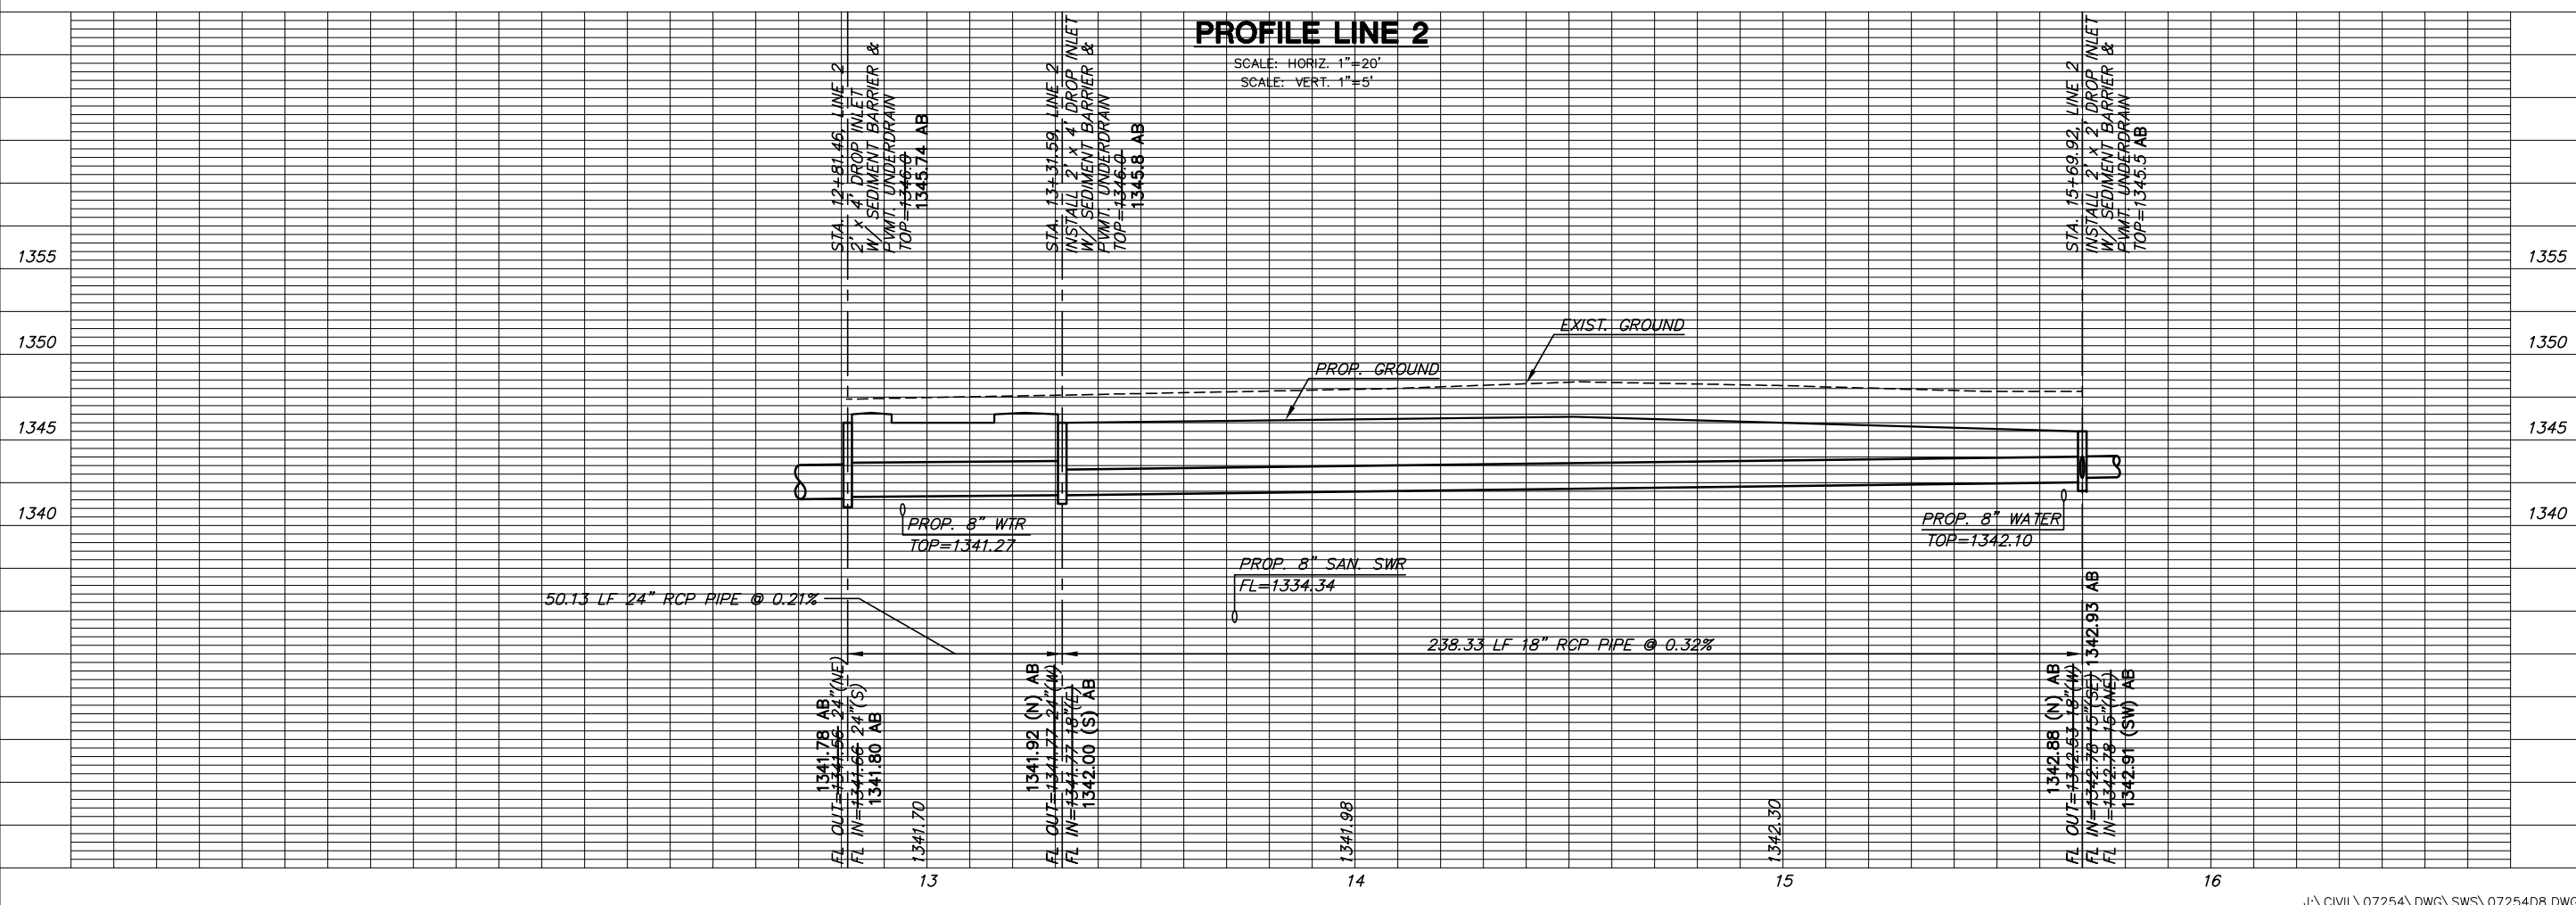

**PROFILE LINE 2**

SCALE: HORIZ. 1"=20'  
SCALE: VERT. 1"=5'

**STORM WATER SEWER PLANS**  
**THE GROVE AT WICHITA**  
LOT 1, BLOCK 1 CAMPUS CREST

**LINE 2**  
SHEET TITLE  
07008 (CC)  
07254 (MKEC)  
PROJECT NUMBER

DESIGN BY: SRS  
DRAWN BY: JWC  
CHECKED BY: GJA

ISSUED: DECEMBER 2007  
REVISED: MARCH 2008

SHEET NO.  
**12 of 15**