



BENCHMARKS:
 BM #1: "□" CUT ON TOP OF CURB, SOUTH END OF MEDIAN, LAKECREST DR. & CENTRAL AVE. ELEV. = 1332.74 NGVD29

BM #2: "□" CUT ON THE TOP OF CURB ON THE EAST SIDE OF LAKECREST CIRCLE, APPROXIMATELY 46.3 FEET SE OF THE NE CORNER OF LOT 1, BLOCK D, CRESCENT LAKES ADDITION - FIFTH PHASE, ANDOVER, KS. ELEV. = 1331.50 NGVD29

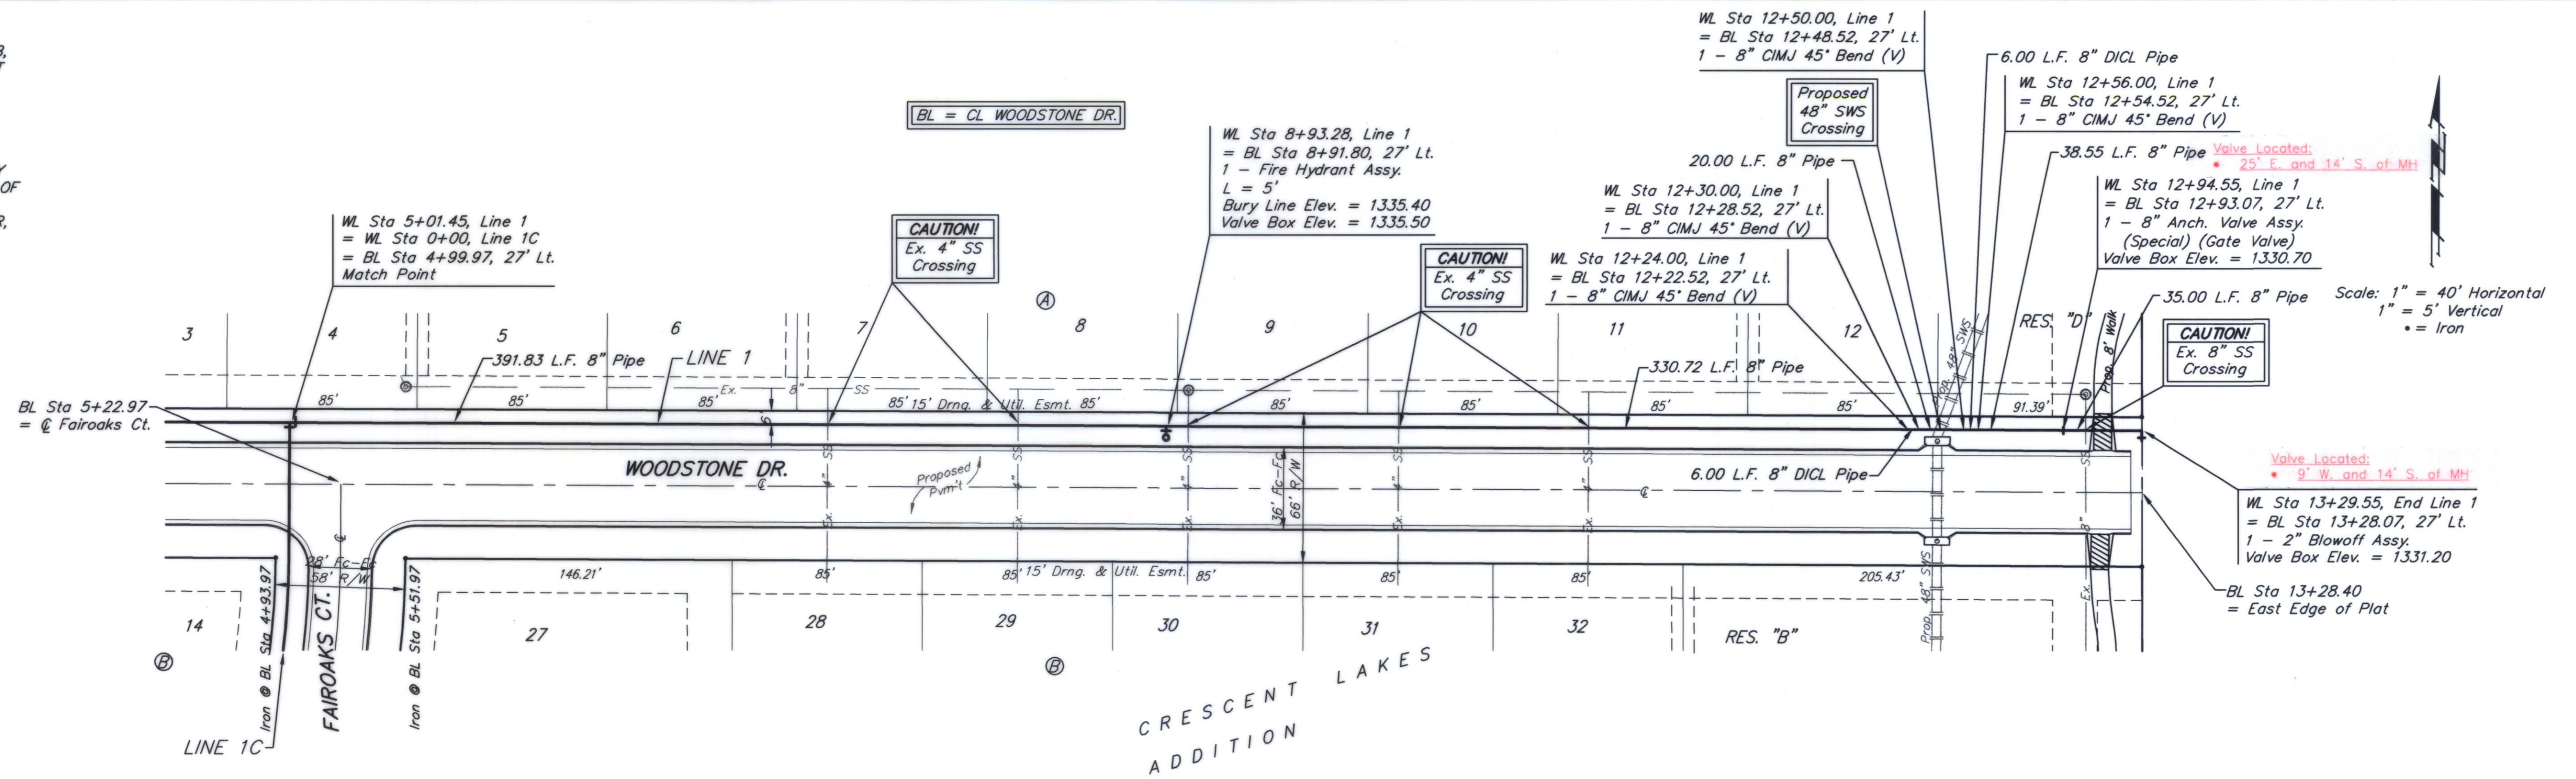

RECORD DRAWING
 M.T. 5-8-09

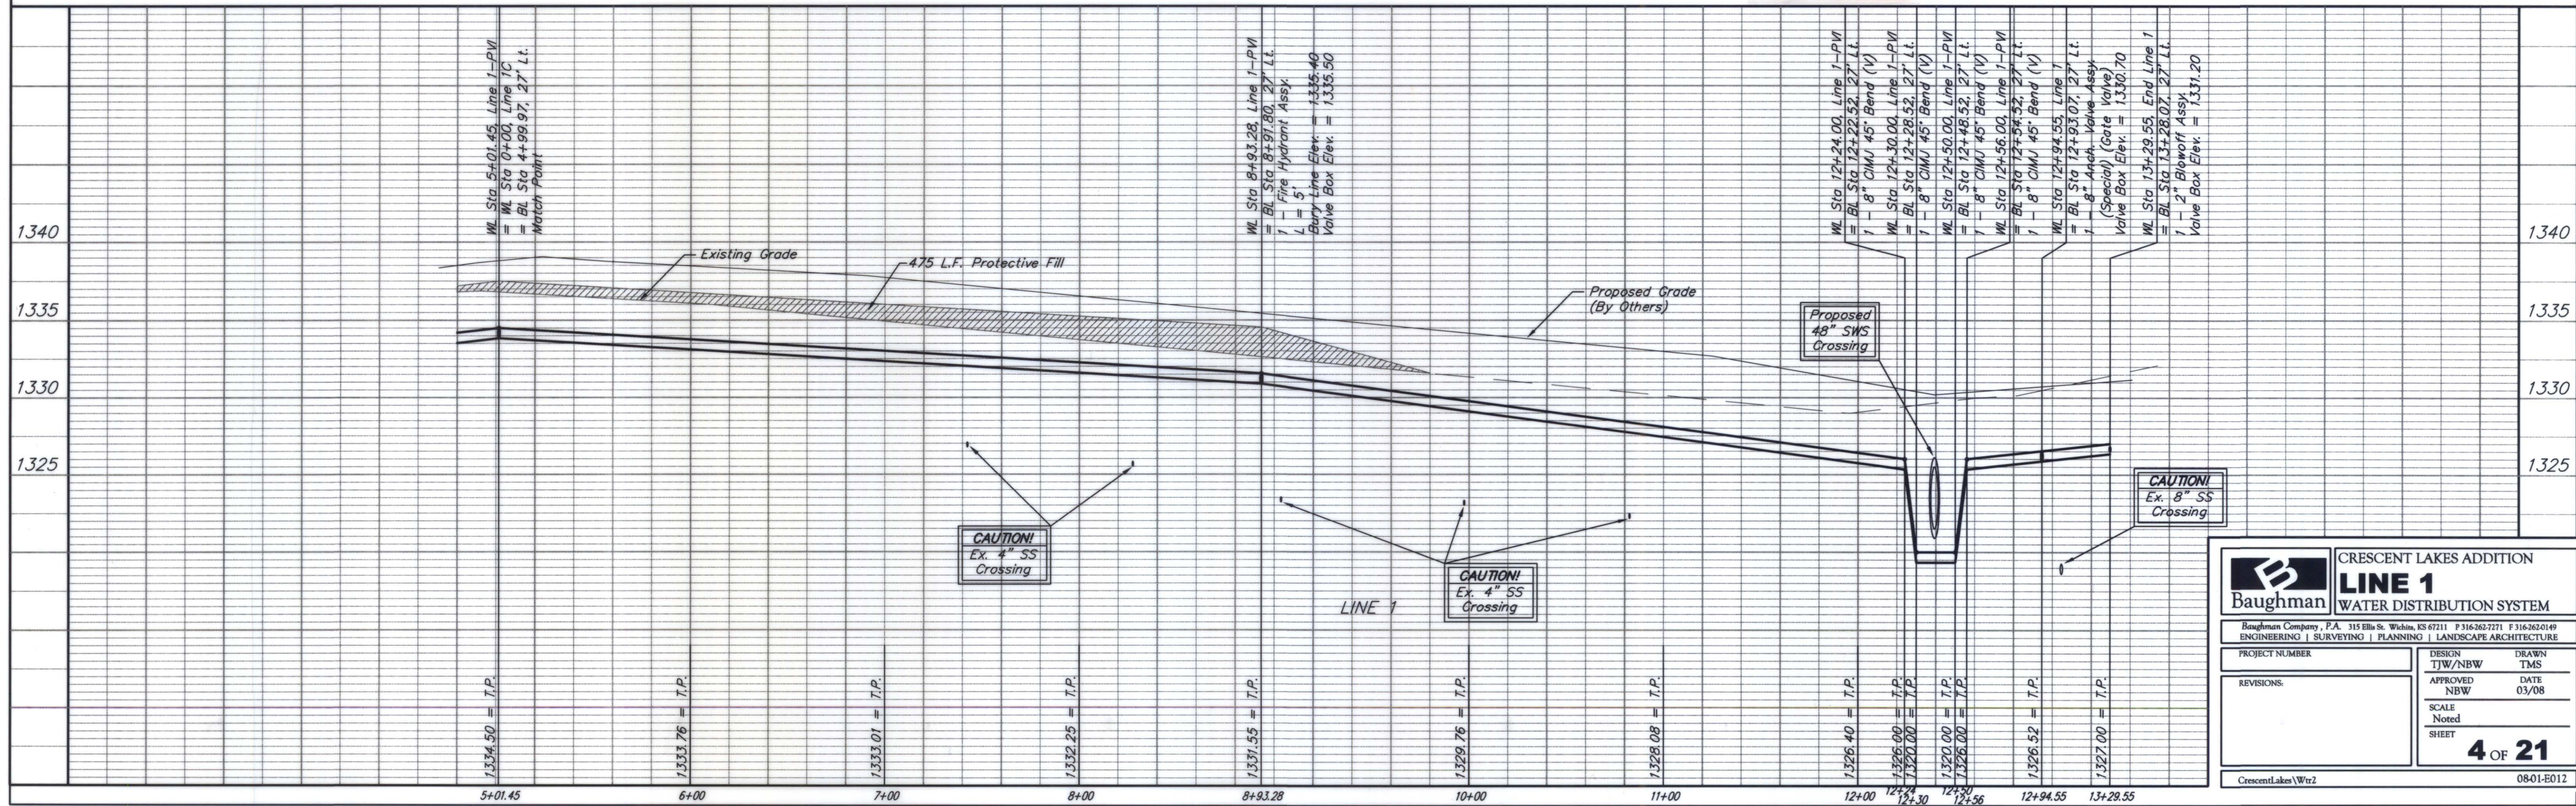

		CRESCENT LAKES ADDITION	
		LINE 1	
		WATER DISTRIBUTION SYSTEM	
<small>Baughman Company, P.A. 315 Ellis St. Wichita, KS 67211 F 3163632771 F 31636320149 ENGINEERING SURVEYING PLANNING LANDSCAPE ARCHITECTURE</small>			
PROJECT NUMBER	DESIGN	TJW/NBW	DRAWN
	APPROVED	NBW	TMS
REVISIONS:			DATE
			03/08
		SCALE	Noted
		SHEET	4 OF 21
CrescentLakes/Wtr2		0801-E012	