



BENCHMARKS:
 BM #1: "□" CUT ON TOP OF CURB,
 SOUTH END OF MEDIAN, LAKECREST
 DR. & CENTRAL AVE.
 ELEV. = 1332.74 NGVD29

BM #2: "□" CUT ON THE TOP OF
 CURB ON THE EAST SIDE OF
 LAKECREST CIRCLE, APPROXIMATELY
 46.3 FEET SE OF THE NE CORNER OF
 LOT 1, BLOCK D, CRESCENT LAKES
 ADDITION - FIFTH PHASE, ANDOVER,
 KS.
 ELEV. = 1331.50 NGVD29

Scale: 1" = 40' Horizontal
 1" = 5' Vertical
 • = Iron

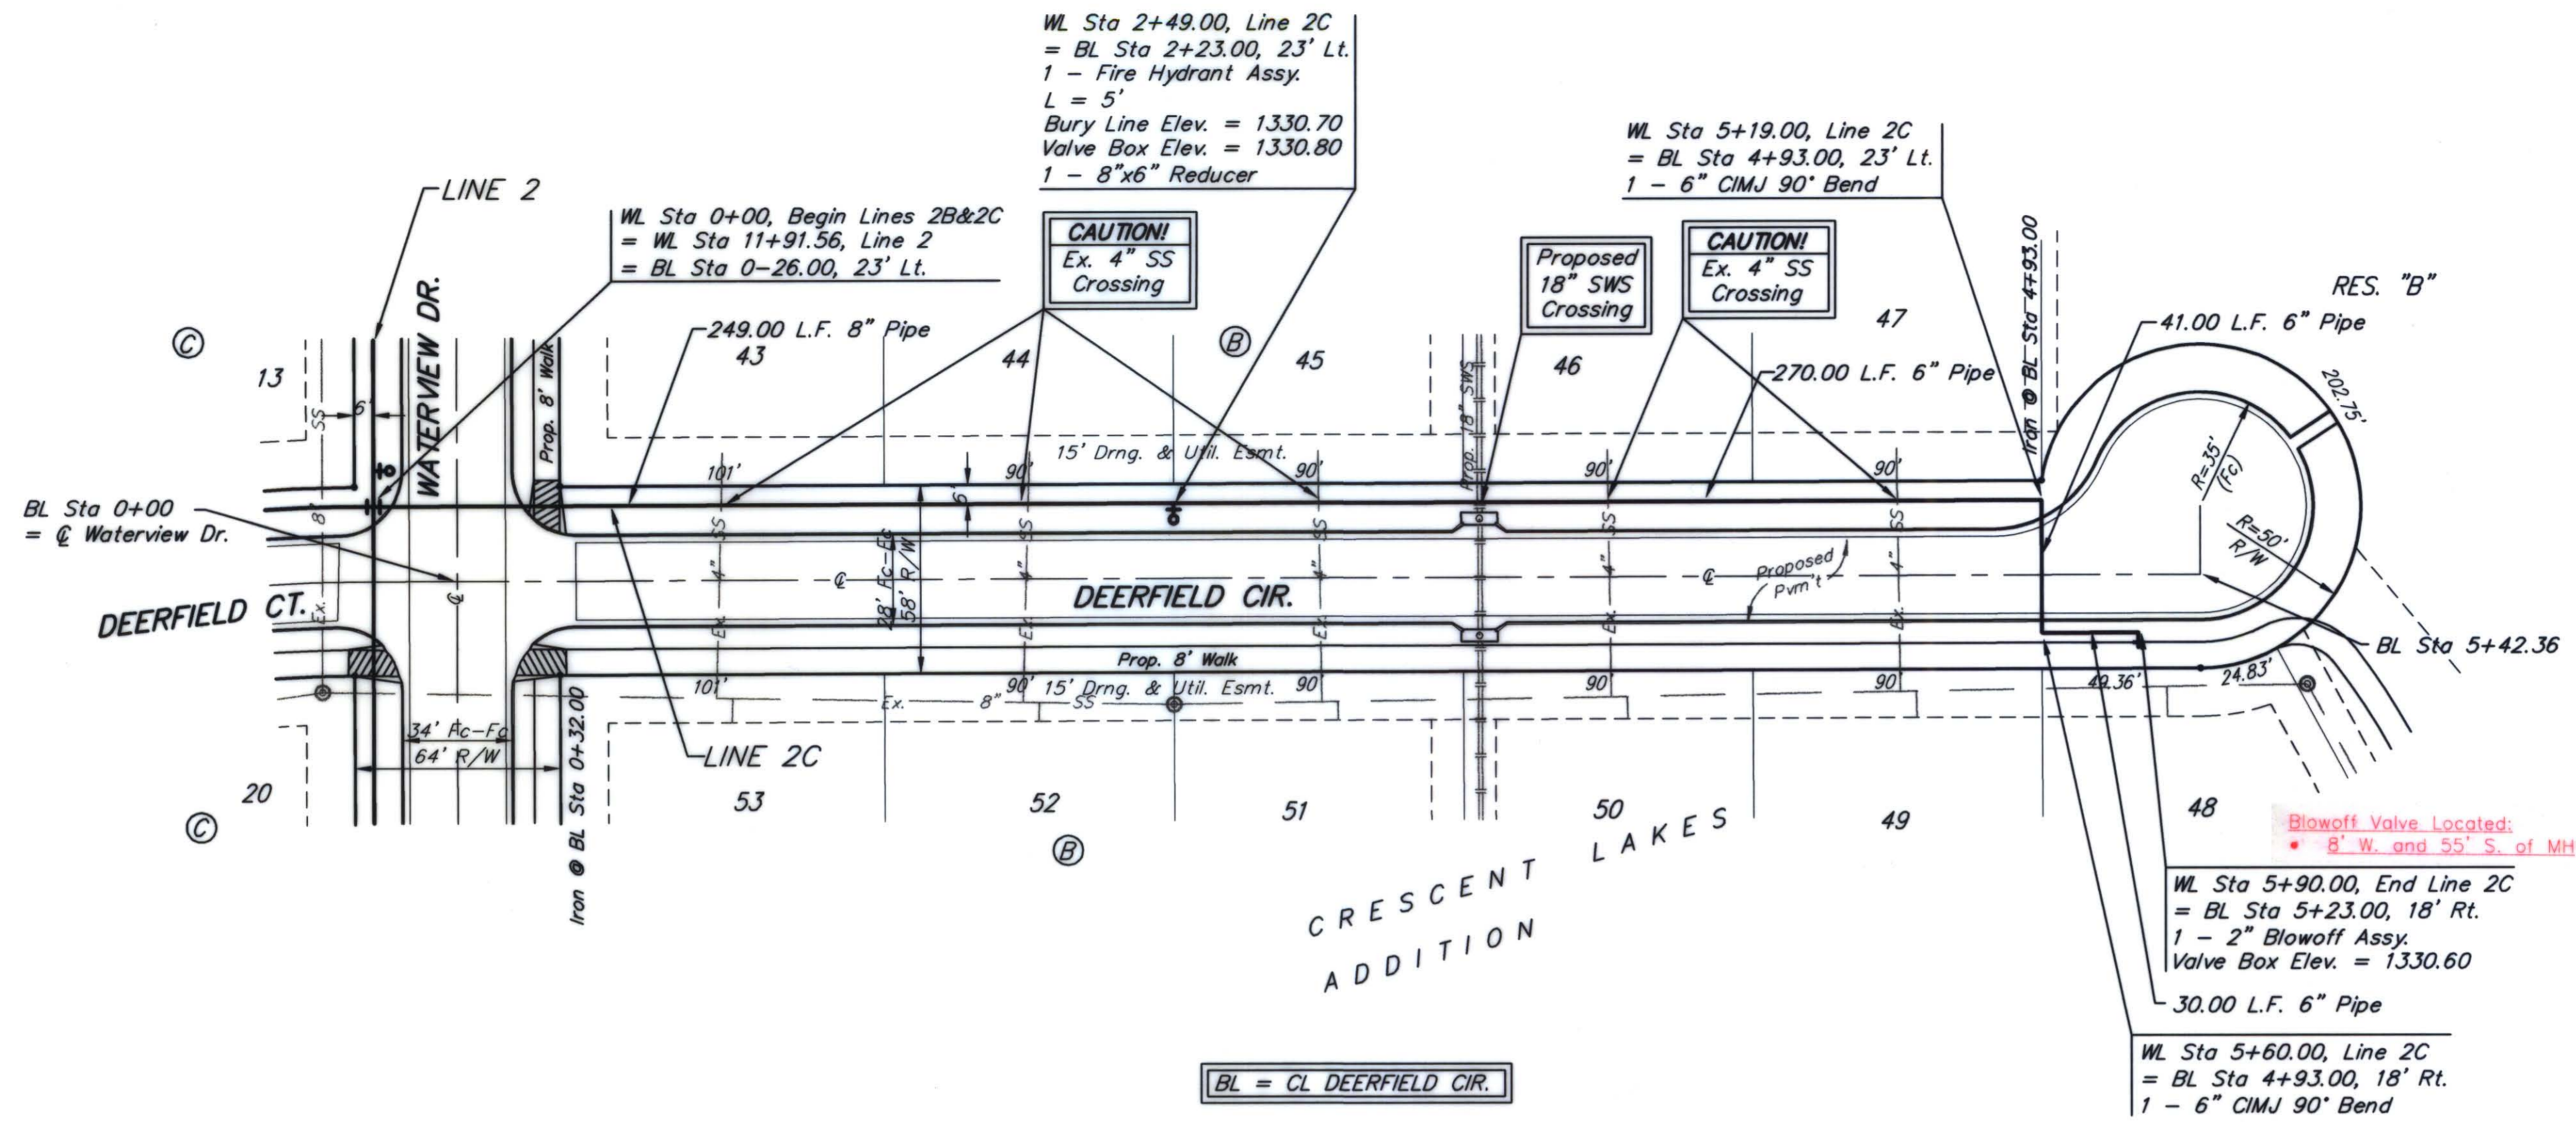

RECORD DRAWING
 5-B-09

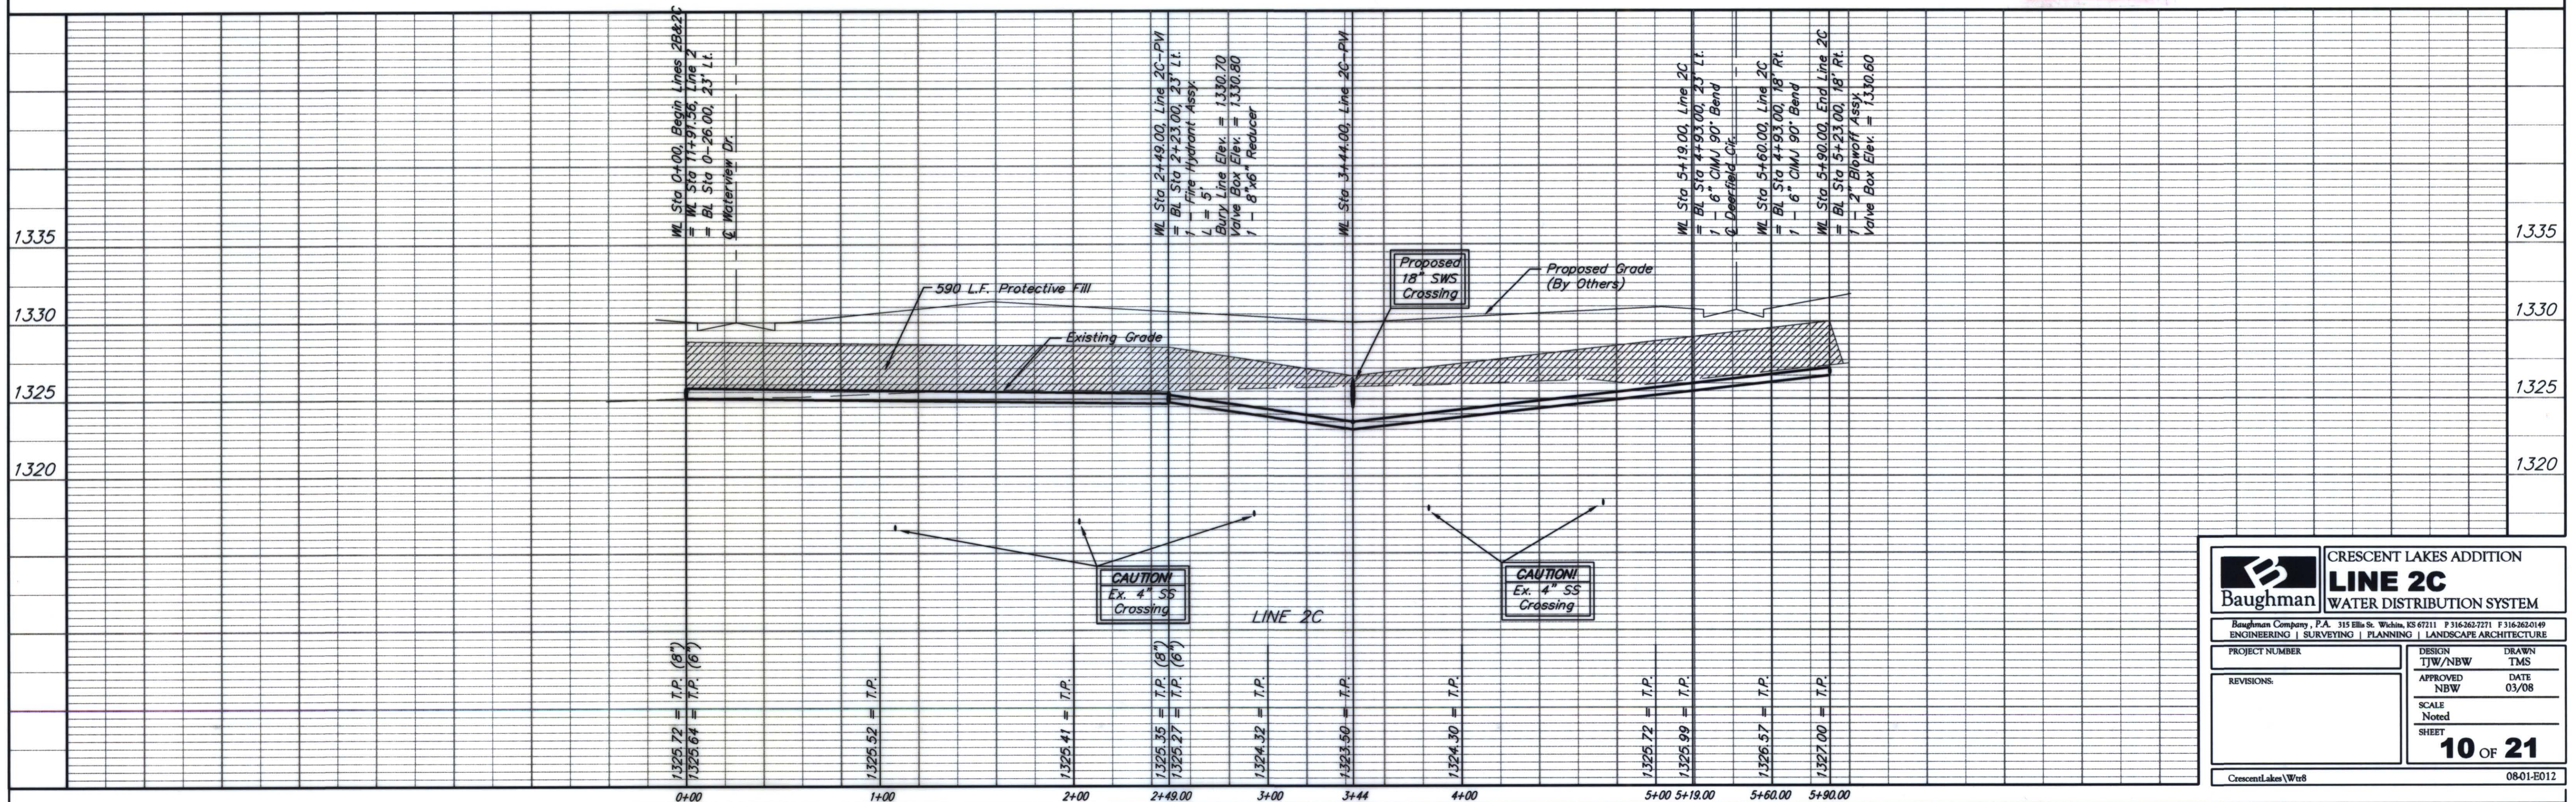

		CRESCENT LAKES ADDITION	
		LINE 2C	
Baughman Company, P.A. 315 Ellis St. Wichita, KS 67211 F 316-263-7271 F 316-262-0149		ENGINEERING SURVEYING PLANNING LANDSCAPE ARCHITECTURE	
PROJECT NUMBER	DESIGN	TJW/NBW	DRAWN
REVISIONS:	APPROVED	NBW	DATE
	SCALE	Noted	
	SHEET	10 OF 21	
CrescentLakes\W08		0801E012	