


Scale: 1" = 100'

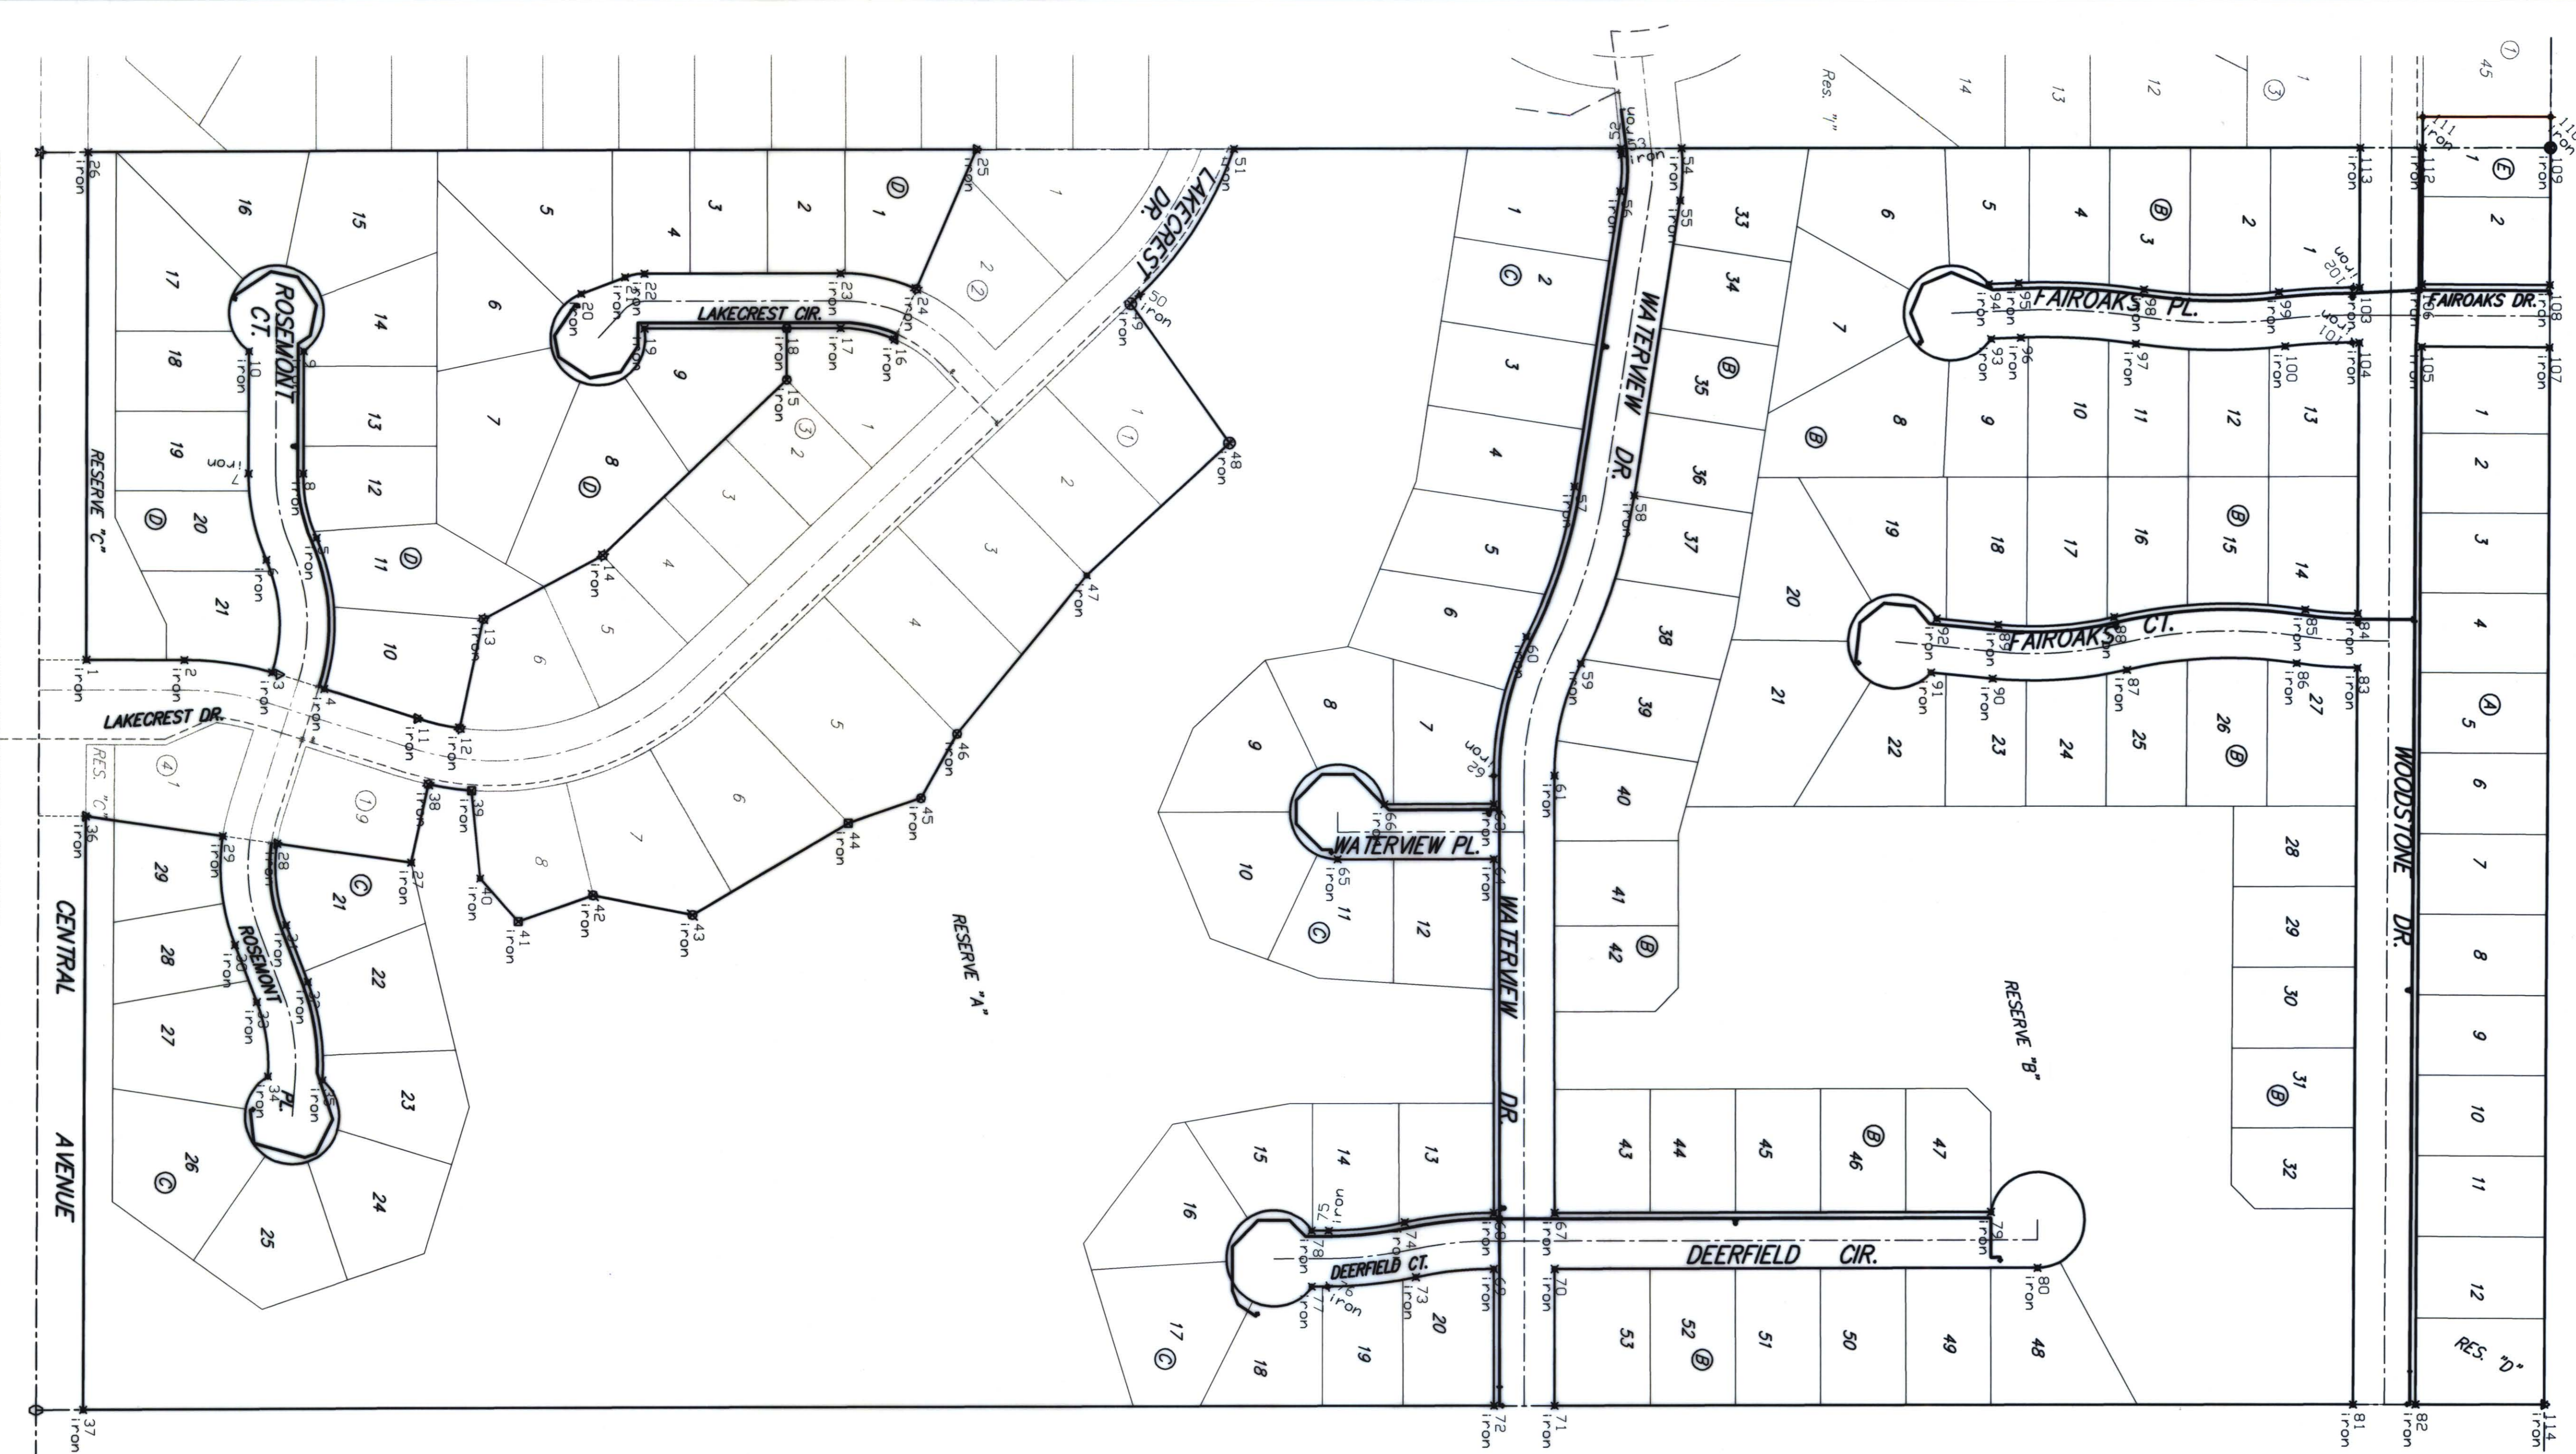

U041	1408.53811	1047.74921	1411
U042	8169.5244	647.18241	811
U043	9617.5566	8811.71521	811
U044	4247.2966	1602.71521	111
U045	10647.2966	1112.25921	111
U046	6666.5666	0021.25921	601
U047	6116.04101	6625.15921	601
U048	2614.66101	1042.15921	101
U049	814.54101	9995.91521	901
U050	7814.50201	1562.91521	901
U051	6824.10201	6316.05421	601
U052	6242.47101	6155.05421	601
U053	7456.10201	0456.24421	601
U054	0626.50201	0500.24421	001
U055	9214.47101	1646.24421	601
U056	8147.54101	3624.22221	86
U057	6918.20201	4282.41221	46
U058	1424.96101	0892.26021	96
U059	6584.86101	4982.85021	46
U060	4128.56101	2982.85021	46
U061	9694.76101	6984.09021	66
U062	1146.16901	6753.60021	26
U063	7492.28501	1408.26611	06
U064	6656.10501	0082.89021	68
U065	6096.59401	2145.16121	88
U066	7674.64501	1266.40221	48
U067	6125.24501	6065.49821	98
U068	8102.58901	6444.66221	98
U069	6665.68901	0840.64721	48
U070	4665.47501	6364.94721	48
U071	7674.64501	8488.11521	28
U072	9021.72611	6588.54721	18
U073	2636.08111	6149.11121	08
U074	8124.52111	6951.45902	64
U075	9980.00211	6580.54611	84
U076	6666.66111	1916.19611	94
U077	4666.14111	1884.29611	54
U078	5364.36311	6350.64711	44
U079	6881.06111	3620.56411	34
U080	4281.92611	8403.76511	24
U081	6340.92611	8403.10911	14
U082	1474.18111	6282.10911	04
U083	6519.18111	0282.76511	69
U084	5519.18111	6651.76511	89
U085	2074.32901	6651.09111	99
U086	1609.06701	8484.14611	69
U087	4942.06701	8882.96511	49
U088	6942.96901	1112.96511	29
U089	4901.99901	1541.96511	29
U090	7964.19901	6441.06011	19
U091	6044.71501	6624.07611	09
U092	8894.74901	9028.72911	85
U093	9847.74901	0241.74911	85
U094	5114.74901	1416.02911	45
U095	6242.24001	6556.99911	95
U096	6104.34201	1012.62411	55
U097	6096.60000	8900.07411	65
U098	6746.9666	1463.19211	15
U099	1024.15101	0460.29111	05
U100	6139.109101	6695.26111	64
U101	4291.80601	8882.76511	84
U102	2656.84701	6282.90111	44
U103	4680.81901	6524.69601	94
U104	7847.58901	9056.16601	54
U105	5814.21701	9740.45801	74
U106	1624.60901	0414.46801	54
U107	8166.91801	6466.50901	74
U108	5038.07401	6569.59401	04
U109	9964.74901	8016.95401	66
U110	5816.07901	9474.01401	86
U111	6446.66311	6244.94001	46
U112	7830.40701	0911.84001	96
U113	1268.68601	6142.66201	46
U114	6395.54601	1646.14201	46
U115	0945.00601	1145.62201	66
U116	1645.64801	1629.68201	26
U117	0847.61801	6566.09501	06
U118	0586.42401	6070.64101	66
U119	1088.33701	6744.06501	82
U120	8808.55701	4885.26601	82
U121	9606.6666	0400.05001	92
U122	5416.8666	2846.68601	62
U123	0194.82101	6244.54801	62
U124	1938.82101	6345.86301	22
U125	4719.82101	6938.71901	12
U126	8461.06101	6924.76501	02
U127	0796.98101	1566.86201	61
U128	6094.98101	6700.94801	41
U129	6241.98101	0691.60601	91
U130	4900.14201	6940.66701	61
U131	8590.82401	8844.46501	41
U132	1284.56401	6445.89401	61
U133	5644.11901	8449.64401	21
U134	6195.10901	2199.86601	11
U135	6002.01201	6144.06201	01
U136	9556.01201	2144.84201	8
U137	2374.01201	6160.84201	8
U138	8042.60401	2566.86301	6
U139	8440.04501	1502.00601	4
U140	1094.26501	0046.44201	4
U141	6620.66501	6162.26101	2
U142	6154.86501	8095.84001	1
U143	6013.903	6014.803	01

RECORD DRAWING  
M.T. 5-8-09

**CRESCENT LAKES ADDITION**

**COORDINATE SHEET**

**WATER DISTRIBUTION SYSTEM**

Baughman Company, P.A. 315 Elm St. Woburn, MA 01897 P: 316.363.2771 F: 316.363.0149  
ENGINEERING | SURVEYING | PLANNING | LANDSCAPE ARCHITECTURE

PROJECT NUMBER	DESIGN	DRAWN
	TJW/NBW	TMS
REVISIONS	APPROVED	DATE
		03/06
SCALE		
Noted		
SHEET		
<b>20</b>		<b>21</b>

CrescentLakes\WTR\records 0801-E012