



PROFILE CHECKED CHECKED  
BY DATE

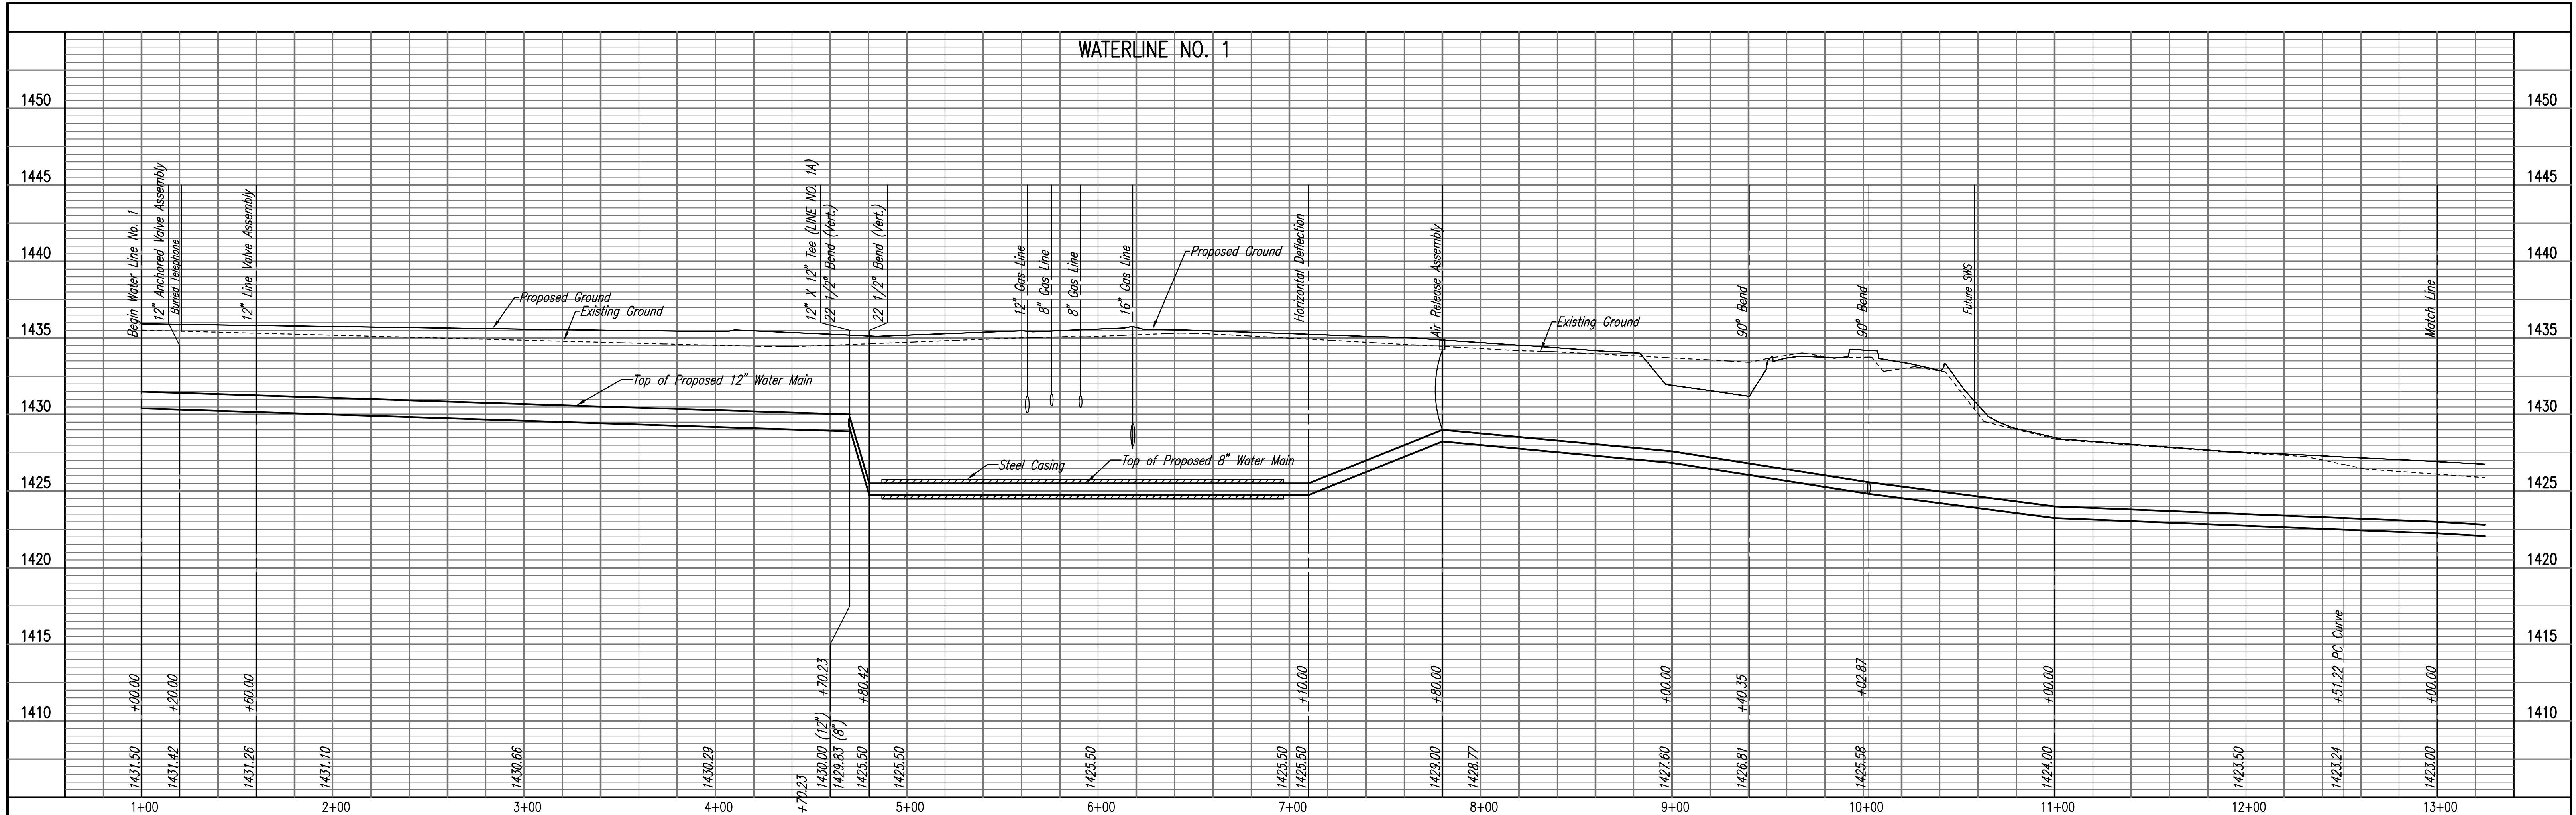

PROFILE CHECKED CHECKED  
BY DATE

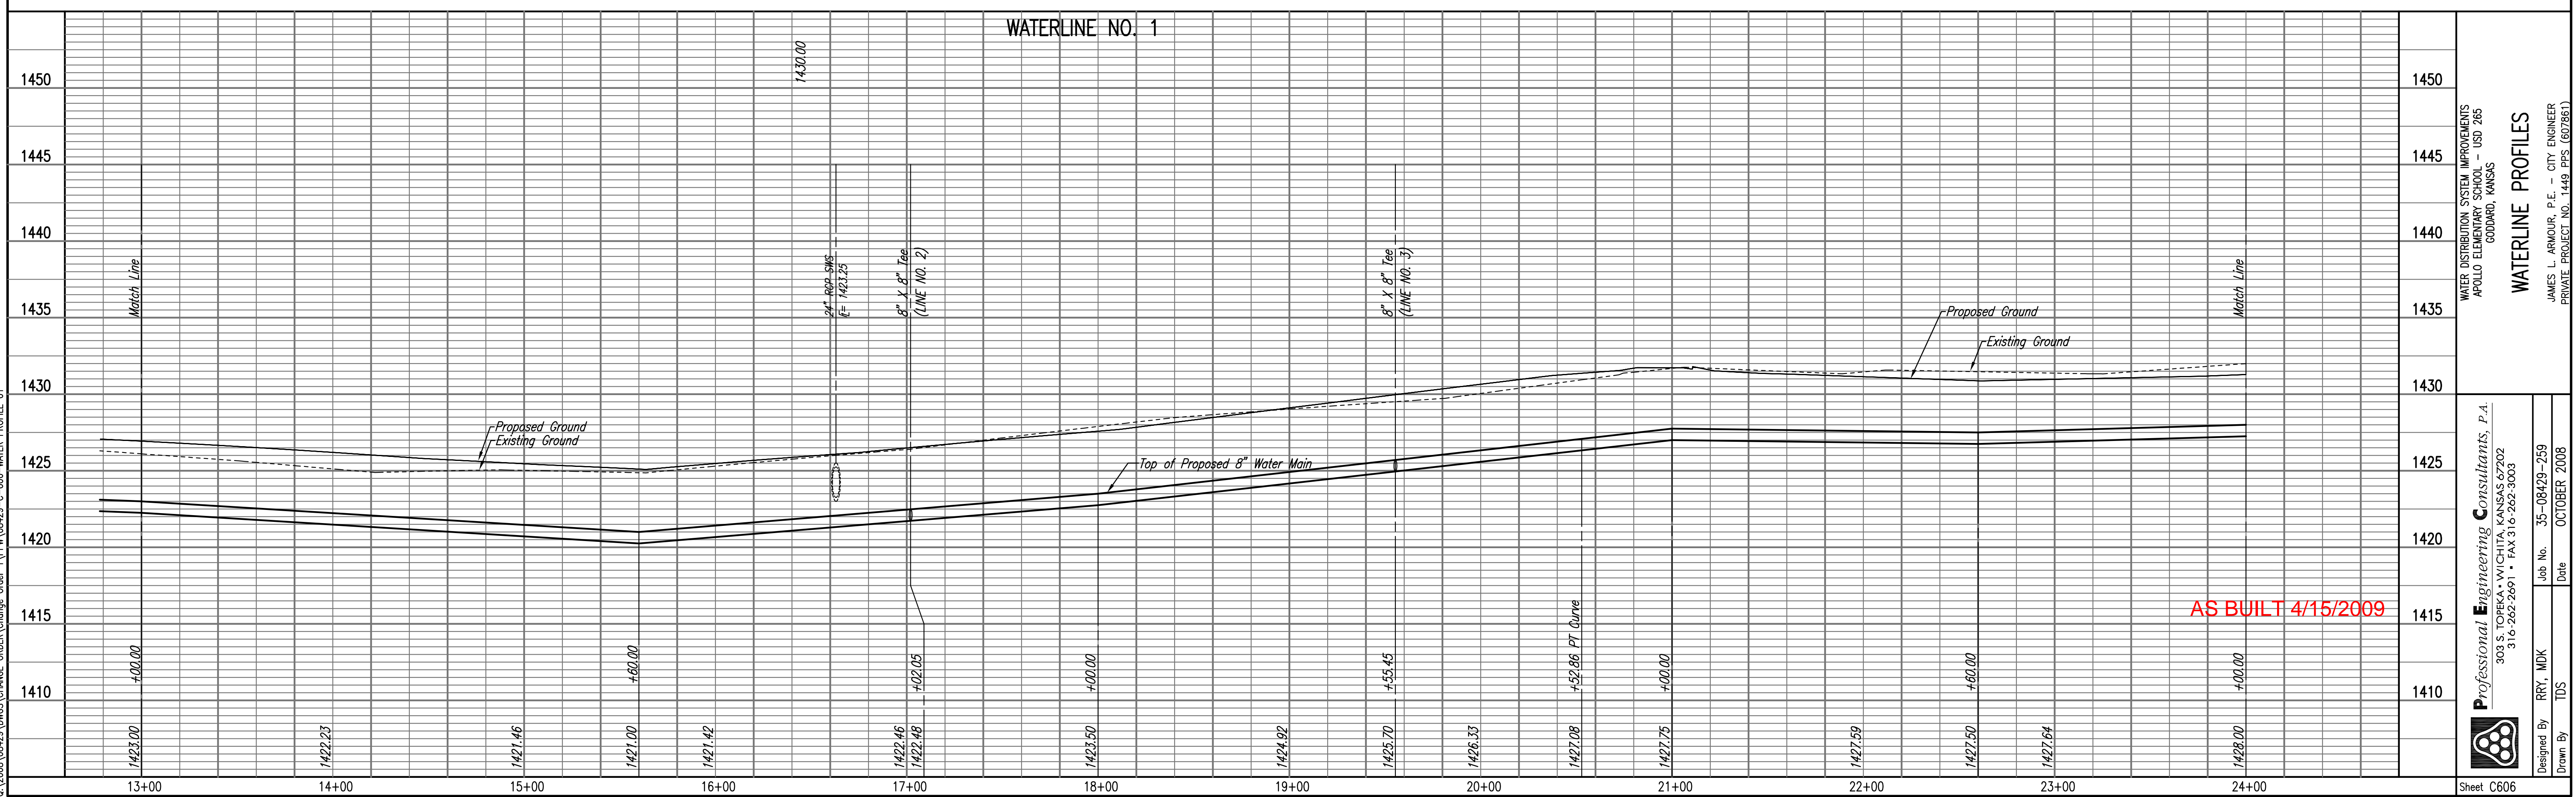

AS BUILT 4/15/2009

Saved 01-06-2009 8:13:38 AM by RWJ  
Plot Scale: 1"=40' 01-21-2009 11:59:41 AM  
C:\2008\08129\DWG\CHANGE ORDER\Change Order 1\PPM\08129-C-606-WATER PROFILE 01

**Professional Engineering Consultants, P.A.**  
303 S. TORREY WILKINSON, KANSAS 67202  
316-262-2091 • FAX 316-262-3003

Designed By: RRY, MDK  
Drawn By: TDS

Job No.: 35-08429-259  
Date: OCTOBER 2008

WATER DISTRIBUTION SYSTEM IMPROVEMENTS  
APOLLO ELEMENTARY SCHOOL - USD 265  
GODDARD, KANSAS

**WATERLINE PROFILES**  
JAMES L. ARMOUR, P.E. - CITY ENGINEER  
PRIVATE PROJECT NO. 1449 PPS (607861)

Sheet C606