

WATER DISTRIBUTION SYSTEM IMPROVEMENTS

TO SERVE
EISENHOWER MIDDLE SCHOOL
UNIFIED SCHOOL DISTRICT 265
GODDARD, KANSAS


PRIVATE PROJECT NO. 1450 PPW (607853)

CITY OF WICHITA, KANSAS

JAMES L. ARMOUR, P.E. - CITY ENGINEER

INDEX OF SHEETS

SHEET NO. C601	TITLE SHEET
SHEET NO. C602	KEY MAP AND GENERAL NOTES
SHEET NO. C603-C605	PLAN SHEETS
SHEET NO. C606-C607	PROFILE SHEETS
SHEET NO. C608	STANDARD VAULT & METER DETAILS
SHEET NO. C609	STANDARD WATER ASSEMBLY DETAILS
SHEET NO. C701-C703	SOIL EROSION BMP DETAILS

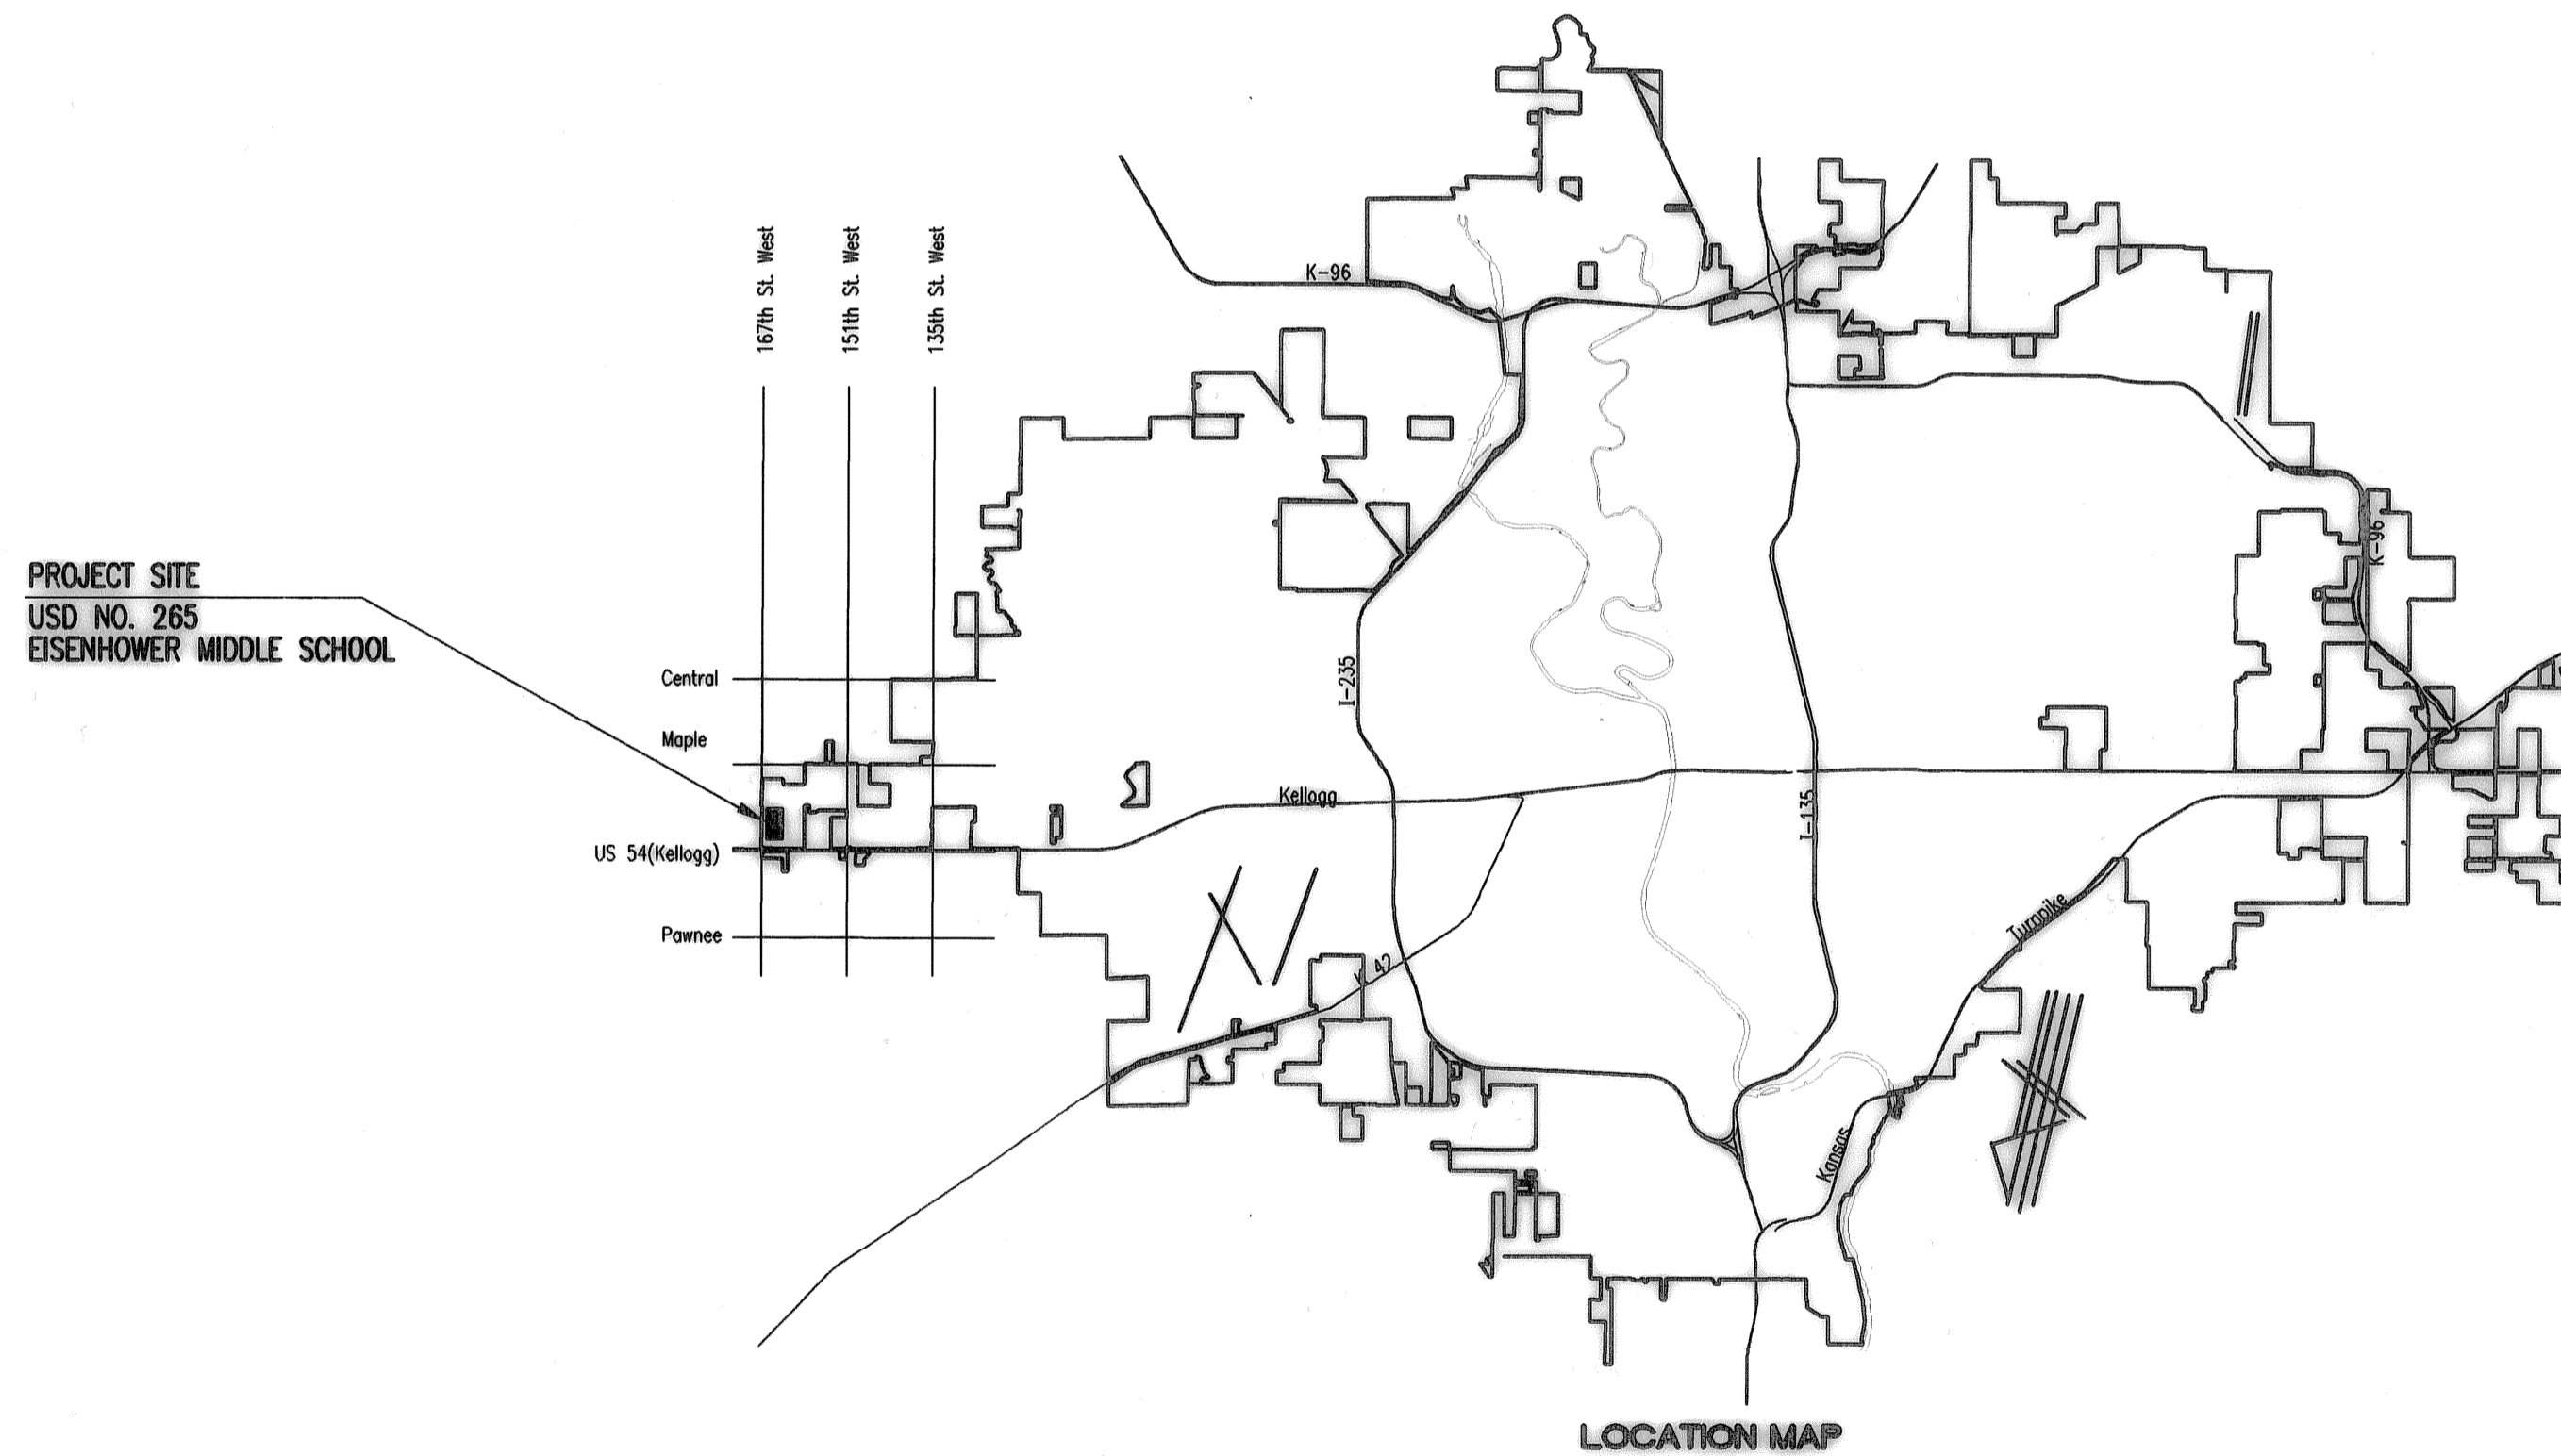

APPROVED AS NOTED
 BY CITY ENGINEER OF WICHITA,
 BY WICHITA WATER UTILITIES,
 & BY WICHITA FIRE DEPARTMENT

Water Mains (Public Works) [Signature] 1-15-09

Water Mains (Water Utilities) [Signature] 1-12-09

Fire Prot. Line WFD/ELT 1-20-09

NOTE TO CONTRACTORS

PUBLIC PROPERTY:
 Inspection and testing for the waterline is to be provided by a Licensed Consulting Engineering Firm under contract with the Owner/Developer. Said inspection to be in accordance with the City of Wichita standard construction engineering practices and certified by a Licensed Professional Engineer licensed in the State of Kansas. No work shall be performed in dedicated easements or public right-of-way by the Contractor without such inspection nor shall any work be commenced without written authorization by the City Engineer. All Construction and Materials shall comply with the City of Wichita Specifications and Standards (on file and available in the City Engineer's Office).

PRIVATE PROPERTY:
 Installation and testing for the fire protection line is to be performed by a City of Wichita licensed fire protection contractor in accordance with the fire codes as adopted by the City of Wichita. All materials and construction practices for the fire protection line shall comply with the fire codes as adopted by the City of Wichita (available from the City of Wichita Fire Department). The Contractor shall not commence work without notification and approval of the Wichita Fire Department.
 Inspection of the fire protection line is to be provided by the City of Wichita Fire Department and by a licensed Consulting Engineering Firm under contract with the Owner/Developer.
 The contractor shall not start work until the project inspector is assigned to the project and present on the site. Any work done without inspection will be required to be uncovered for inspection.

JANUARY 2009

PLANS PREPARED BY
PROFESSIONAL ENGINEERING CONSULTANTS, P.A.
 ENGINEERS
 WICHITA, KANSAS



AS BUILT 4/15/2009