


NUMBER	TYPE	LOCATION			DESIGN STATION \ DIRECTION	AS BUILT STATION \ DIRECTION	FOR INFORMATION ONLY	
		LOT NO.	BLOCK NO.	ADDITION NAME			APPROXIMATE LENGTH OF PIPE	VERTICAL
1	Single Riser	1	2	Ark Valley	3	10+91/Lt.	10'	32'
2	Single Riser	1	3	Ark Valley	3	11+27/Rt.	10'	16'
3	Single Riser	2	3	Ark Valley	3	13+10/Rt.	9'	20'
4	Single Riser	2	2	Ark Valley	3	13+60/Lt.	9'	30'
5	Manhole	3, 4	2	Ark Valley	3	15+98/Lt.	8'	30'
6	Single Riser	3	3	Ark Valley	3	16+68/Rt.	8'	20'
7	Double Riser	4, 5	3	Ark Valley	3	18+20/Rt.	8'	20'
8	Manhole	5, 6	2	Ark Valley	3	18+65/Lt.	8'	30'

NOTE: Horizontal distances are from main to cleanout
 Vertical distances are from existing ground to wye
 Cleanout to wye - 4'
 All are single wyes unless specifically noted.

The Contractor shall field verify the existing manhole stub elevations prior to the start of construction.
 The Contractor shall contact each property owner to verify the location of the riser with the property owner.

REVISED: 12/31/07
 REVISED: 12/20/07

Russell & Bohm, P.A.
 Engineering, Surveying, Land Planning
 600 Main St., Suite 200
 Wichita, Kansas 67203
 Phone: 316-261-4500
 Fax: 316-261-4501
 Email: russell@russellandbohm.com

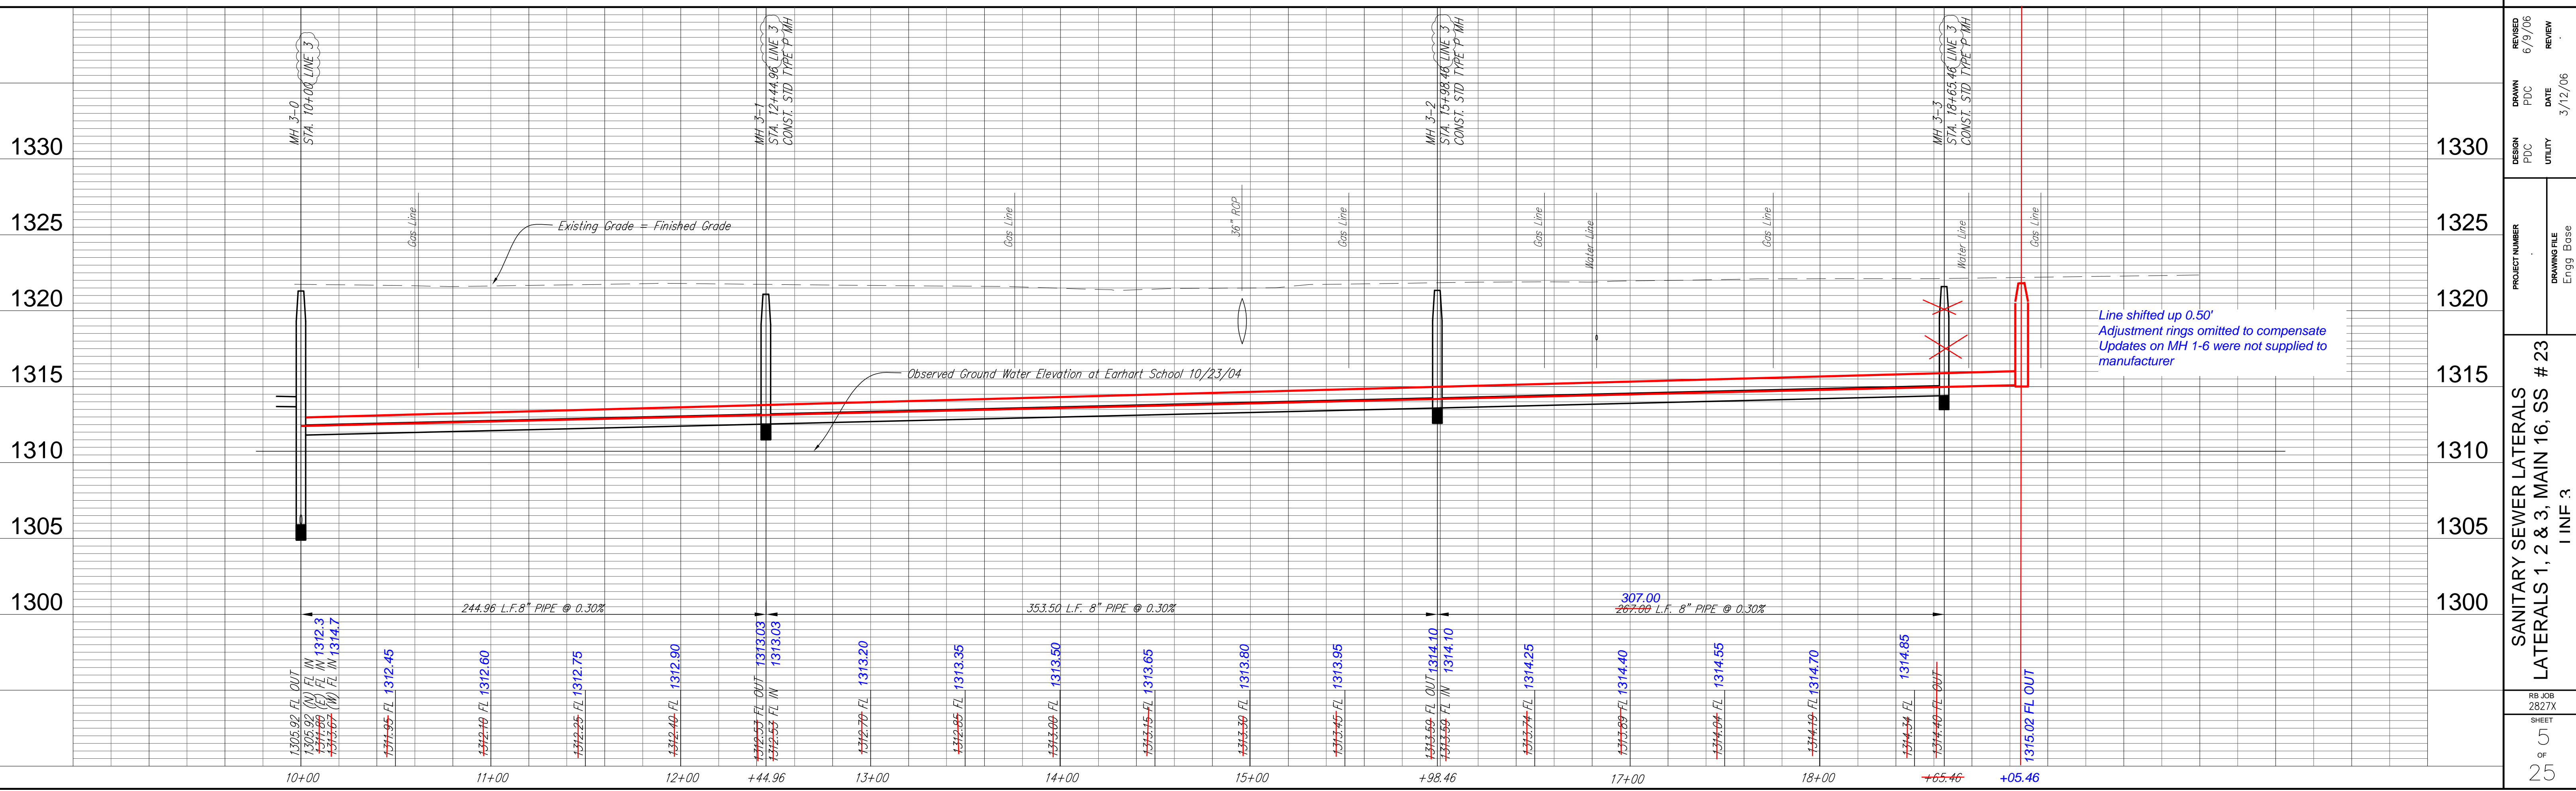

Line shifted up 0.50'
 Adjustment rings omitted to compensate
 Updates on MH 1-6 were not supplied to manufacturer

REVISIONS
 6/9/06 REVIEW
 3/12/06 DATE
 PDC UTILITY
 PROJECT NUMBER
 DRAWING FILE
 Engg Base
 SANITARY SEWER LATERALS
 LATERALS 1, 2 & 3, MAIN 16, SS # 23
 1 INF 3
 RB JOB
 2827X
 SHEET
 5
 OF
 25