


The Contractor shall field verify the existing manhole stub elevations prior to the start of construction.

The Contractor shall contact each property owner to verify the location of the riser with the property owner.

NUMBER	TYPE	LOCATION			DESIGN LINE NO.	DESIGN STATION DIRECTION	AS BUILT STATION DIRECTION	FOR INFORMATION ONLY	
		LOT NO.	BLOCK NO.	ADDITION NAME				APPROXIMATE LENGTH	4" PIPE
1	Single Riser	15	1	Riverside Acres	8	11+75/Rt.		5'	10'
2	Single Riser	3	1	Riverside Acres	8	14+68/Lt.		5'	10'
3	Single Riser	2	1	Riverside Acres	8	15+12/Lt.		4'	10'
4	Single Riser	2	1	Riverside Acres	8	15+74/Lt.		4'	10'
5	Single Riser	1	1	Riverside Acres	8	15+98/Lt.		4'	10'

REVISED: 12/31/07
REVISED: 6/27/07

Ruggles & Pohn, P.A.
Engineering, Surveying, Land Planning
900 West 10th Street
Wichita, Kansas 67203
(316) 264-4500
www.ruggles.com

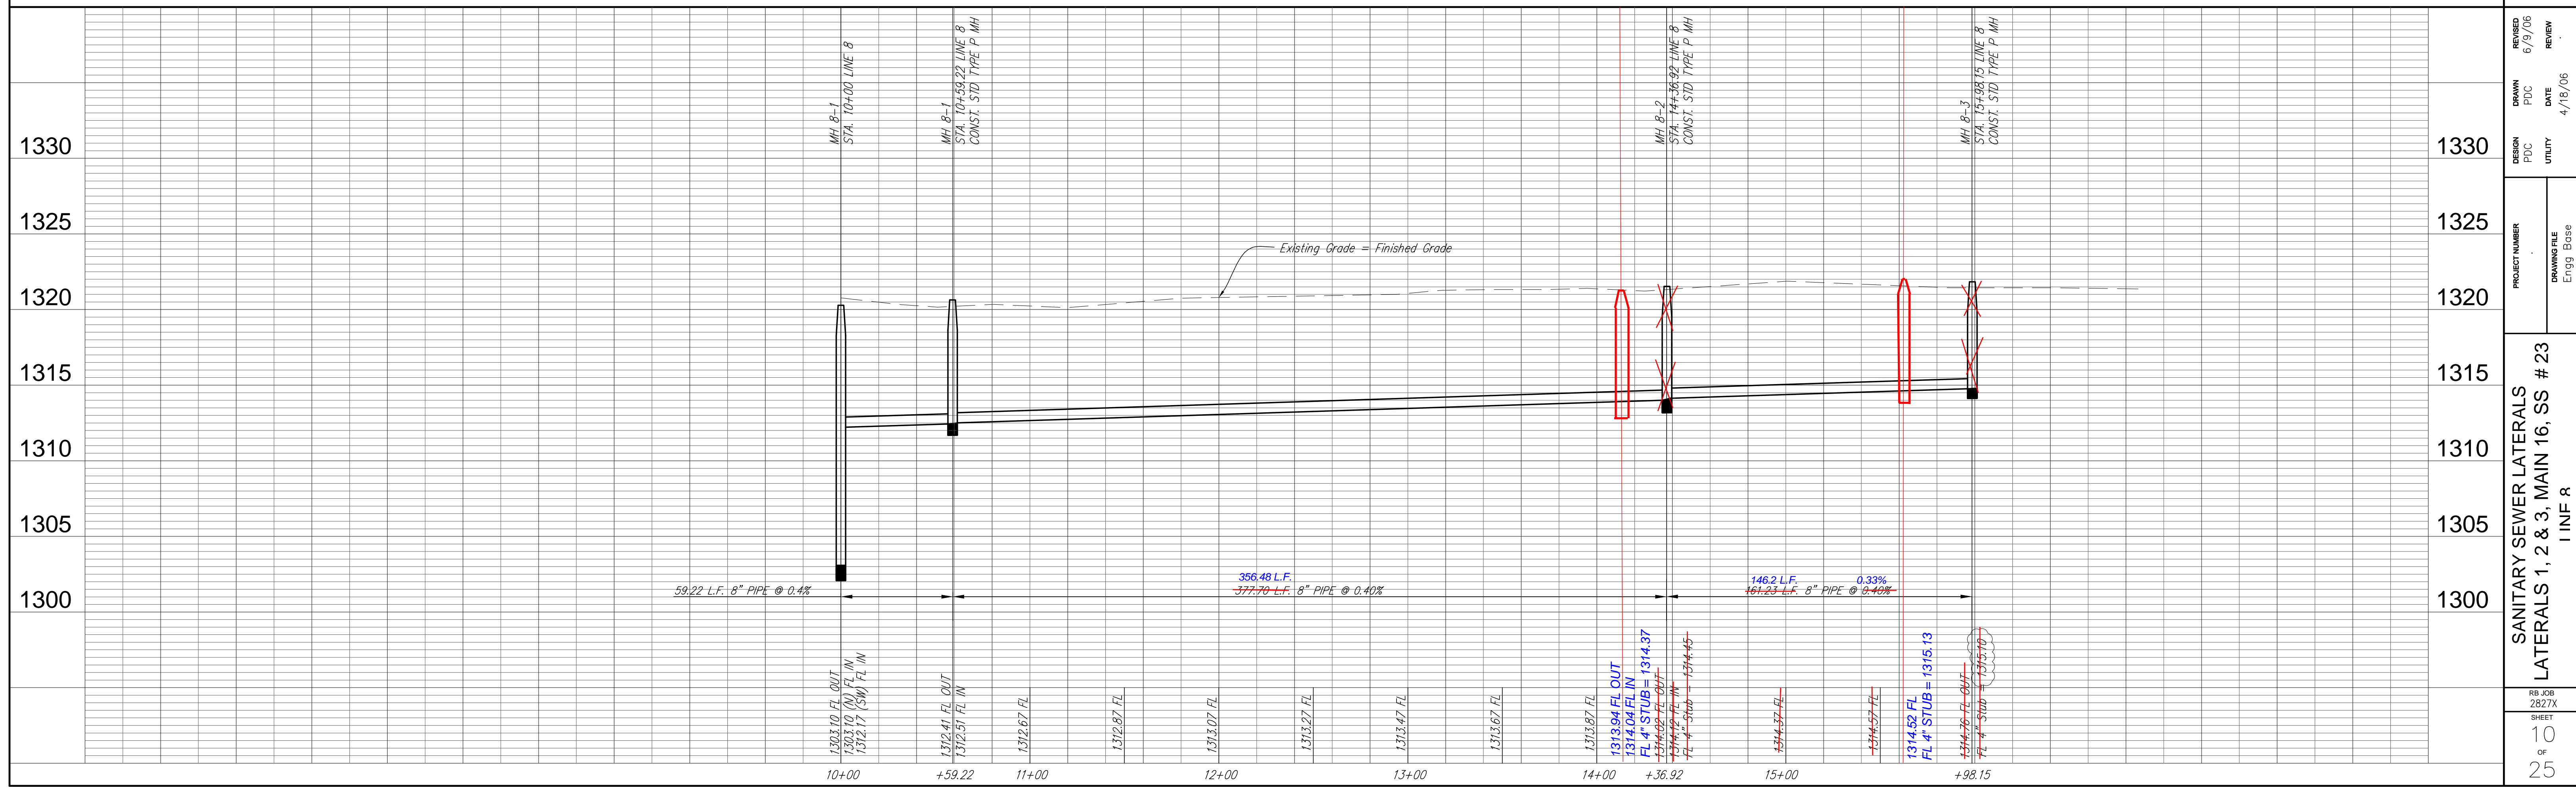

REVISIONS

REVISION	DATE	BY	REVIEW
6/9/06	PDC	PDC	REVIEW
4/18/06	DATE		

PROJECT NUMBER: 1330
DESIGN: PDC
DRAWING FILE: Engg Base

SANITARY SEWER LATERALS
LATERALS 1, 2 & 3, MAIN 16, SS # 23
1 INF R

RB JOB: 2827X
SHEET: 10 OF 25