

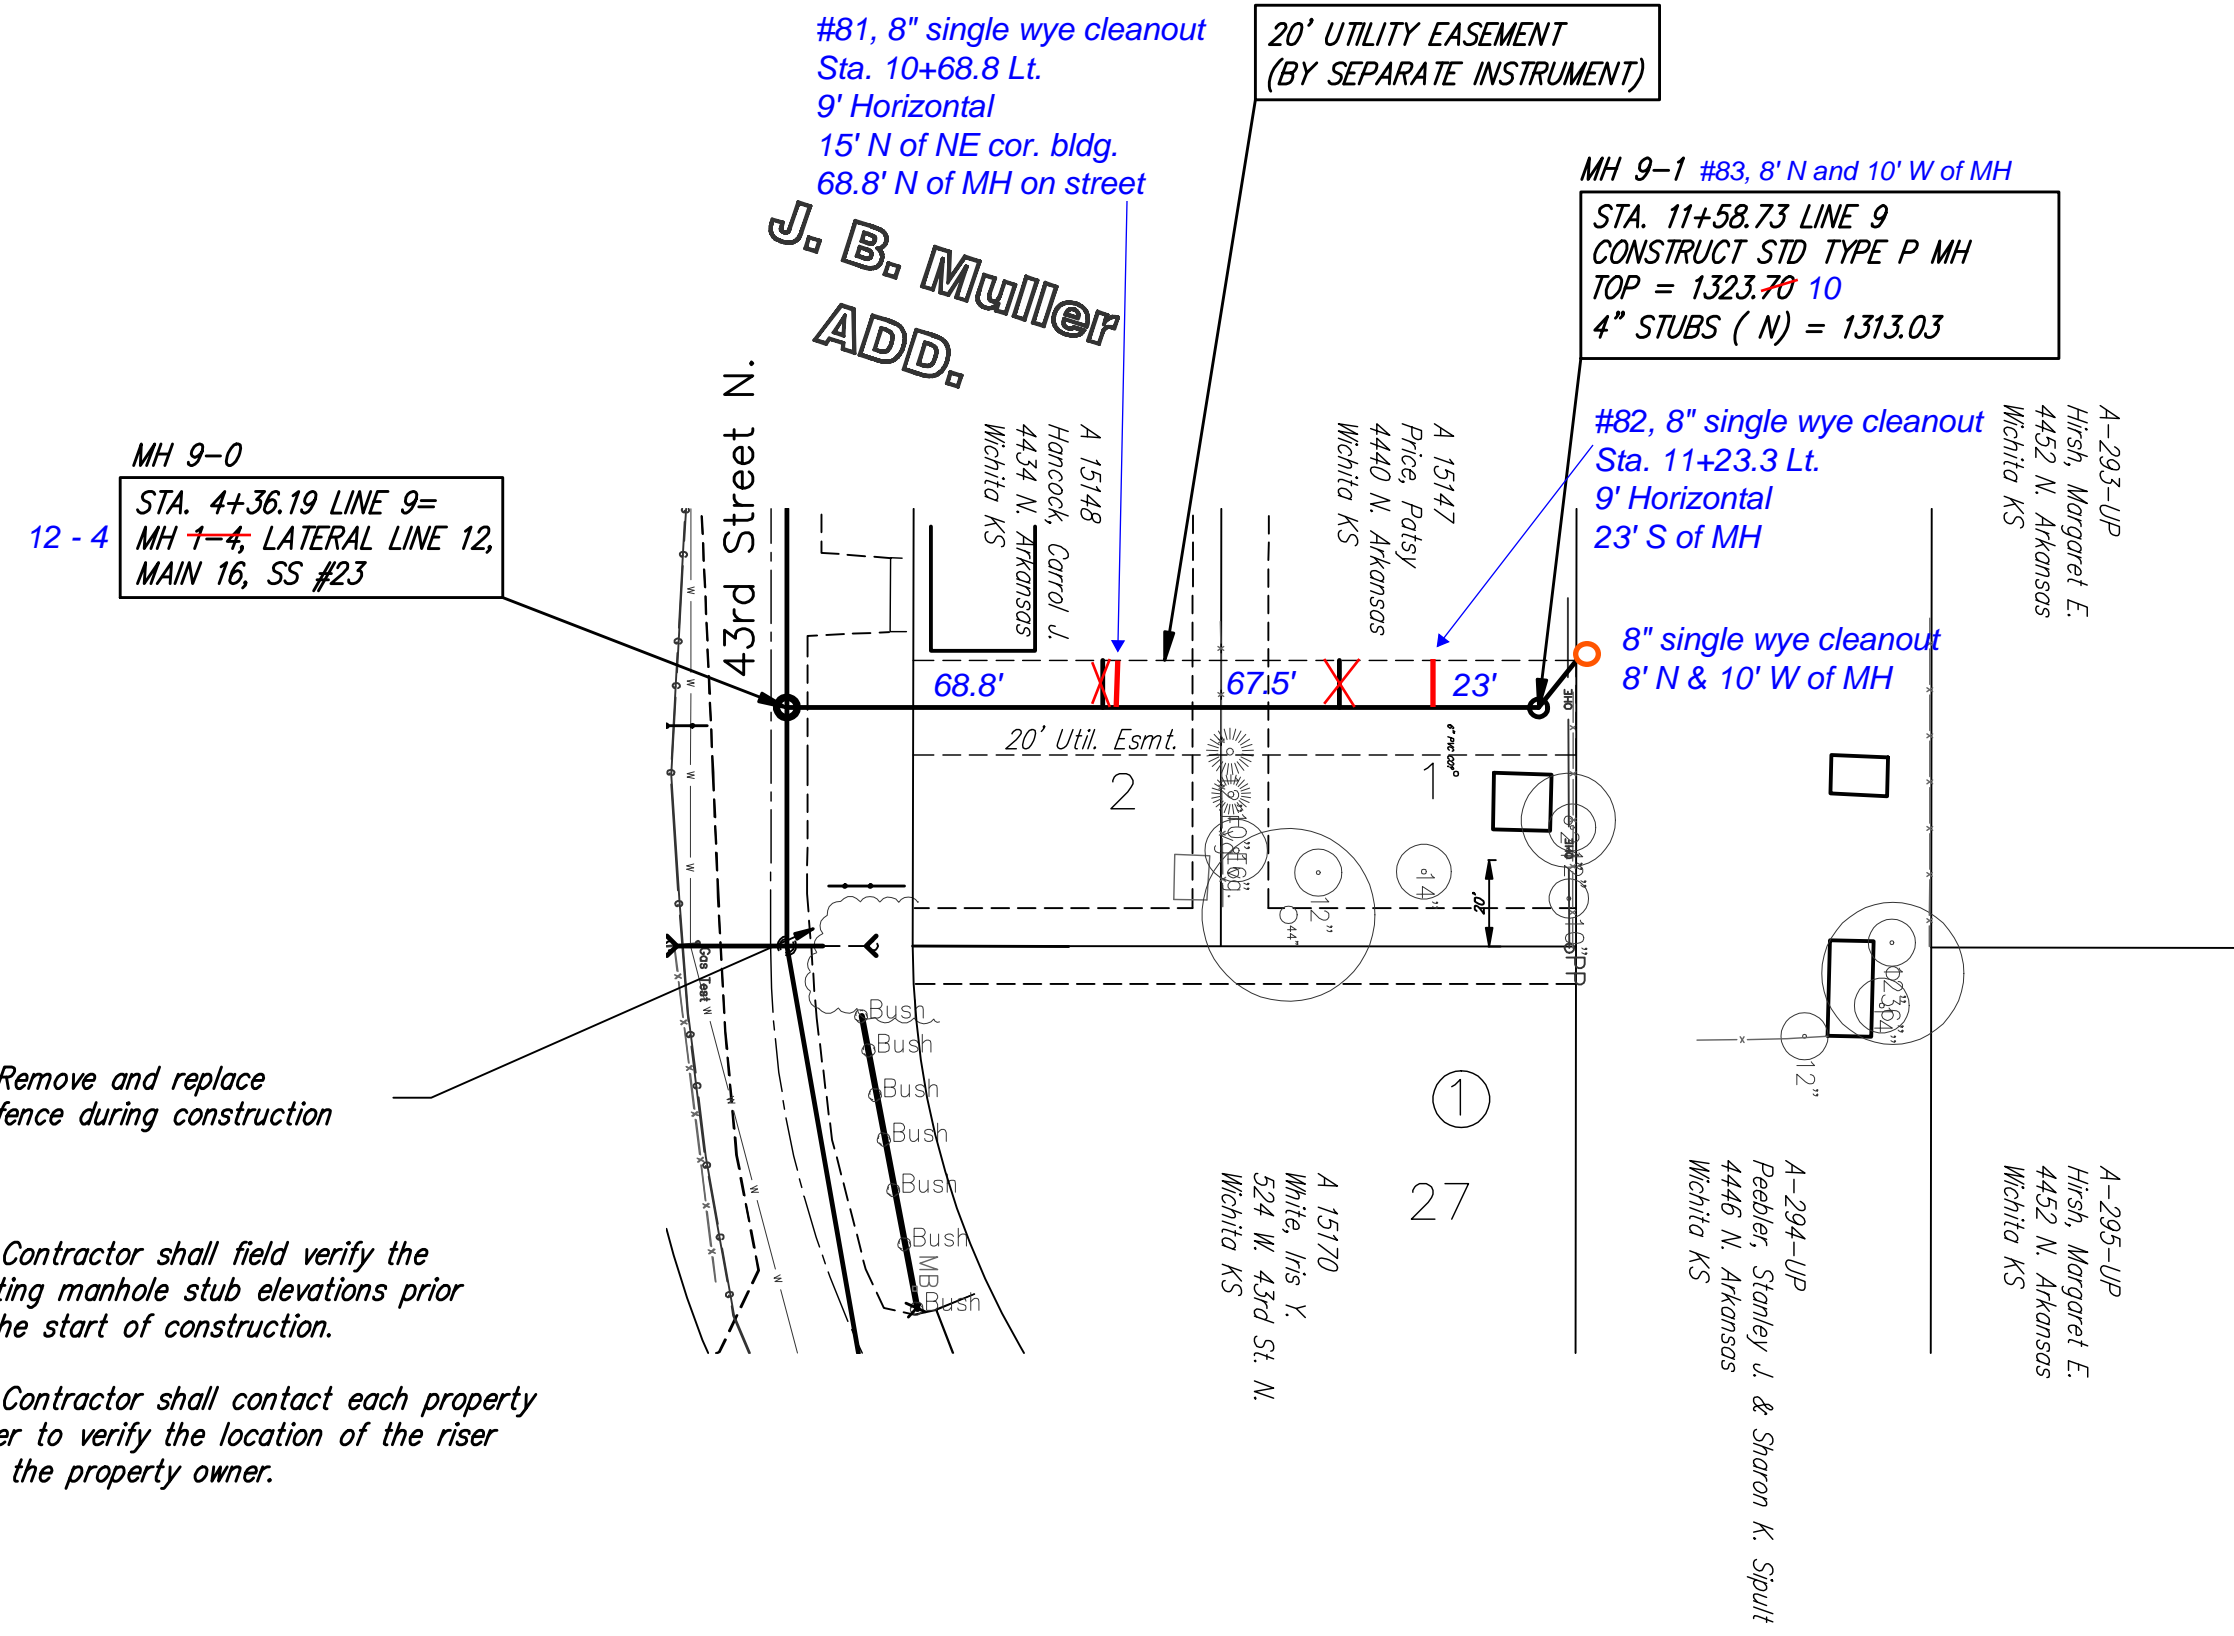


Scale 1" = 40' (Horiz.)  
1" = 5' (Vert.)

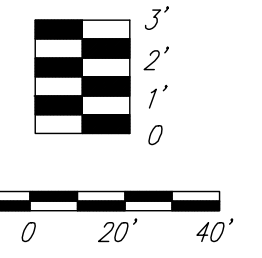

NUMBER	TYPE	LOCATION			DESIGN STATION \ DIRECTION	AS BUILT STATION \ DIRECTION	FOR INFORMATION ONLY	
		LOT NO.	BLOCK NO.	ADDITION NAME			APPROXIMATE LENGTH 4" PIPE	VERTICAL
1	Single Riser	2	1	J. B. Muller	9 10+67.8	9 11+36.3	11'	10'-9"
2	Single Riser	1	1	J. B. Muller	9 11+17/Lt. 11+36.3		11'	10'-9"
3	Single Riser	.	.	A-294-UP	9 11+58/Lt.		10'	10'
		.	.	.	.		.	.

REVISED: 6/27/07

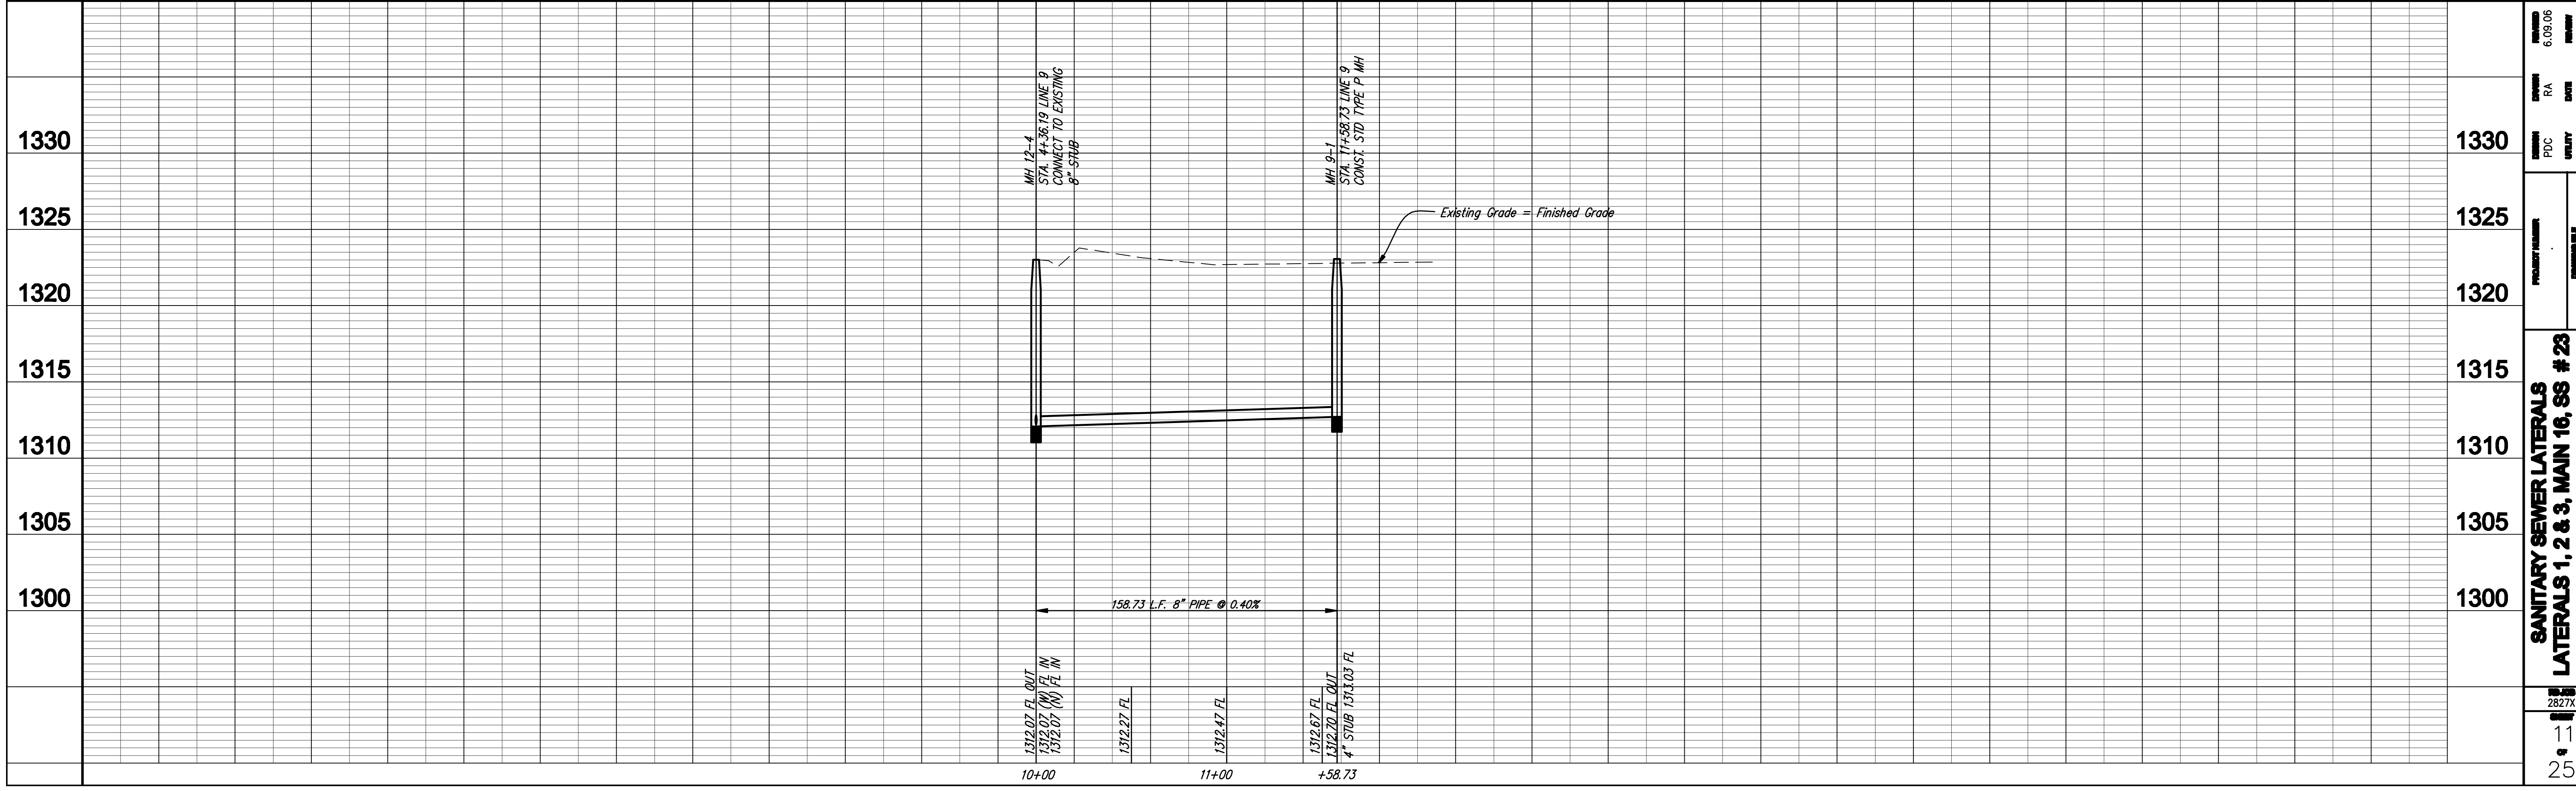

Ruggles & Doherty, P.A.  
 Engineering, Surveying, Land Planning  
 1100 N. 1st St., Suite 200  
 Wichita, KS 67202  
 Phone: 781-625-1100  
 Fax: 781-625-1101  
 Email: info@rugglesanddoherty.com



PROJECT NUMBER: 2827X  
 DATE: 6.09.06  
 RA: [blank]  
 PDC: [blank]  
 DATE: 4.22.06  
 UTILITY: [blank]

PROJECT NAME: SANITARY SEWER LATERALS  
 DRAWING NO.: 2827X  
 ENGR. BASE: [blank]

SANITARY SEWER LATERALS  
 LATERALS 1, 2 & 3, MAIN 16, SS # 23  
 LINE 9  
 11  
 25