

SEWER SERVICE TABLE

NUMBER	TYPE	LOCATION				FOR INFORMATION ONLY	
		LOT NO.	BLOCK NO.	LINE NO.	STATION \ DIRECTION	APPROXIMATE LENGTH 4" PIPE	
					VERTICAL	HORIZONTAL	
23	8" X 4" Tee	27	C	4	6+65/Rt.	5'	10'
24	8" X 4" Tee	28	C	4	7+38/Rt.	4.5'	10'
25	4" Stub w/ Riser	29	C	4	8+07.3	4'	12'
26	8" X 4" Tee	30	C	4	8+86/Rt.	4.5'	10'
27	8" X 4" Tee	31	C	4	9+60/Rt.	4.5'	10'

SEWER SERVICE TABLE


NUMBER	TYPE	LOCATION				FOR INFORMATION ONLY	
		LOT NO.	BLOCK NO.	LINE NO.	STATION \ DIRECTION	APPROXIMATE LENGTH 4" PIPE	
					VERTICAL	HORIZONTAL	
28	4" Stub w/ Riser	32	C	4	10+29.3	4.5'	9'
29	8" X 4" Tee	33	C	4	10+90/Rt.	4.5'	20'
30	4" Stub w/ Riser	34	C	4	11+41.9	4.5'	9'
31	4" Stub w/ Riser	35	C	4	12+06.9	4.5'	19'
32	8" X 4" Tee	25	C	4A	0+37/Rt.	5'	10'
33	4" Stub w/ Riser	24	C	4A	1+02.8	5'	10'

BENCHMARKS:


BM #1: COW Disc in top of curb adjacent to the fire hydrant at the SW corner of Yosemite and Lamp Cir.
Elev. = 146.73 (City Datum)

BM #2: COW Disc in top of curb adjacent to the fire hydrant on the west side of Westgate along the southwesterly line of Lot 13, Block B, Southern Ridge Addition.
Elev. = 144.10 (City Datum)

NOTE: Vertical Riser Pipe shall be extended to 2' minimum above ground water elevation and 4' maximum below proposed ground elevation.

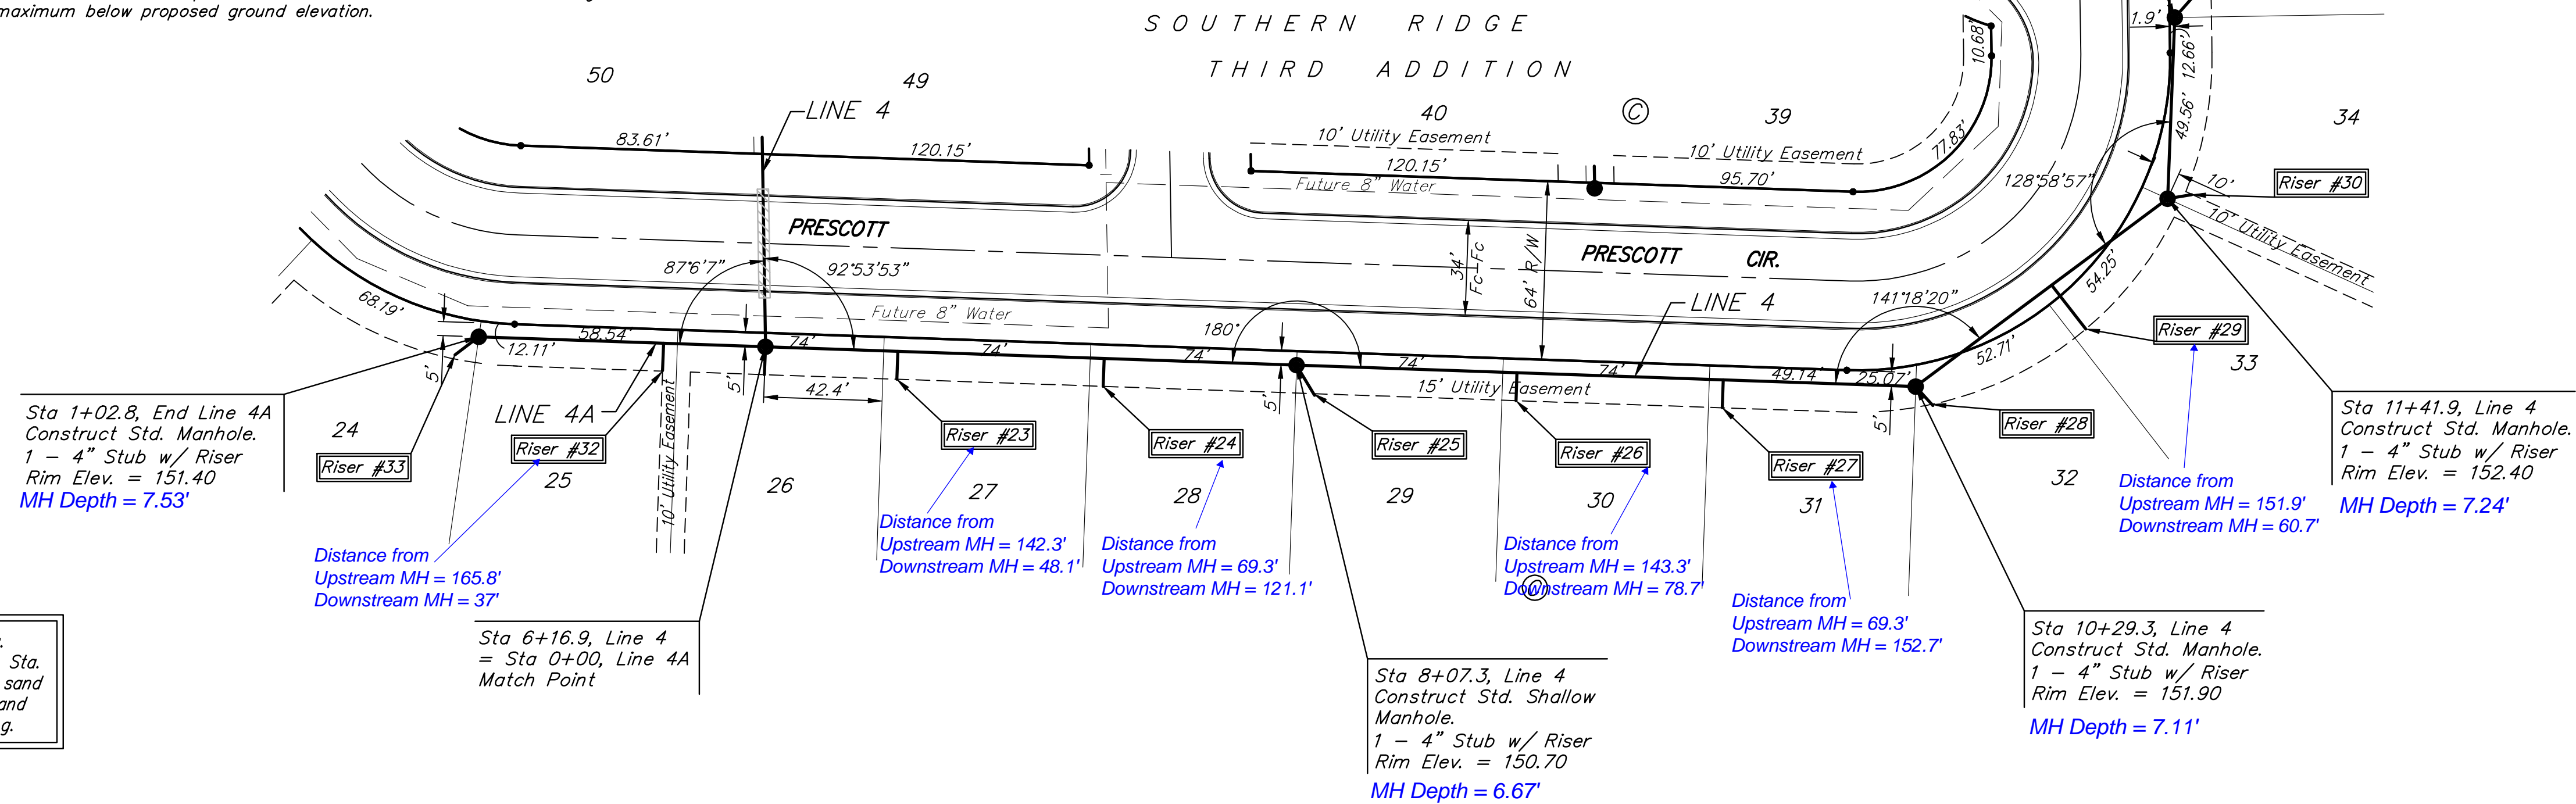

All trench and manhole excavation areas from Sta. 6+16.9 to Sta. 12+06.9, Line 6 and Sta. 0+00 to Sta. 1+02.8, Line 4A shall be backfilled with sand. The sand backfill shall be within two feet of existing grade and shall be water-jetted and vibrated during backfilling.

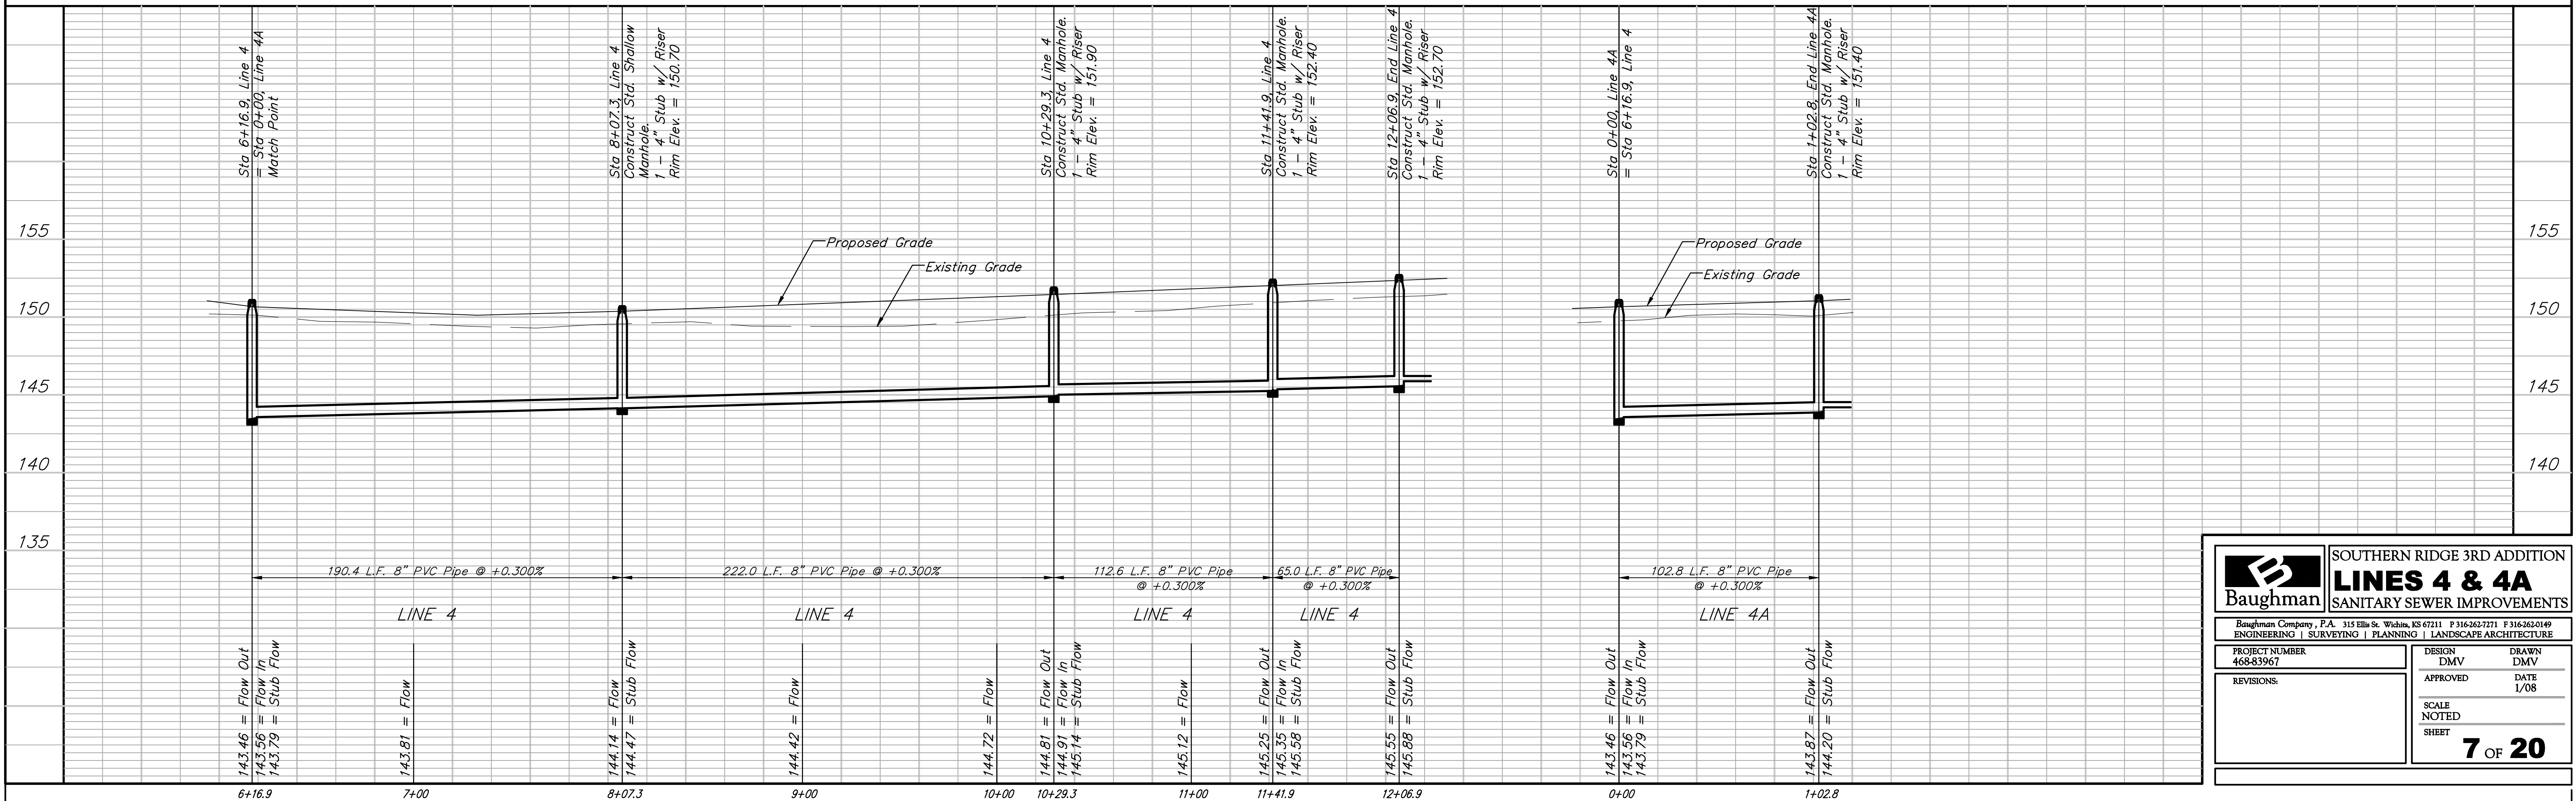

	SOUTHERN RIDGE 3RD ADDITION LINE 4 & 4A SANITARY SEWER IMPROVEMENTS	
	PROJECT NUMBER 468-83967	DESIGN DMV
REVISIONS:	APPROVED DATE 1/08	SCALE NOTED SHEET 7 OF 20