
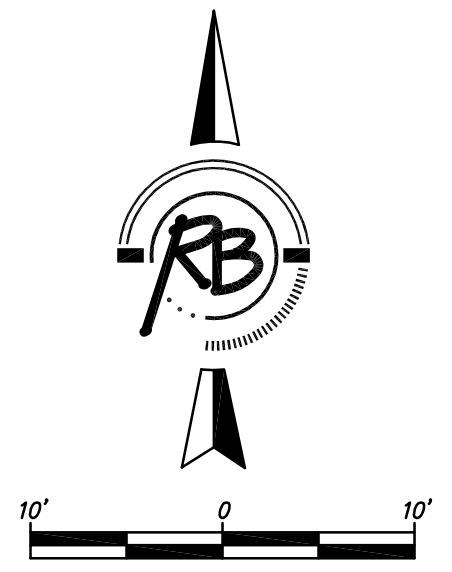



Westside United Methodist Church Add.

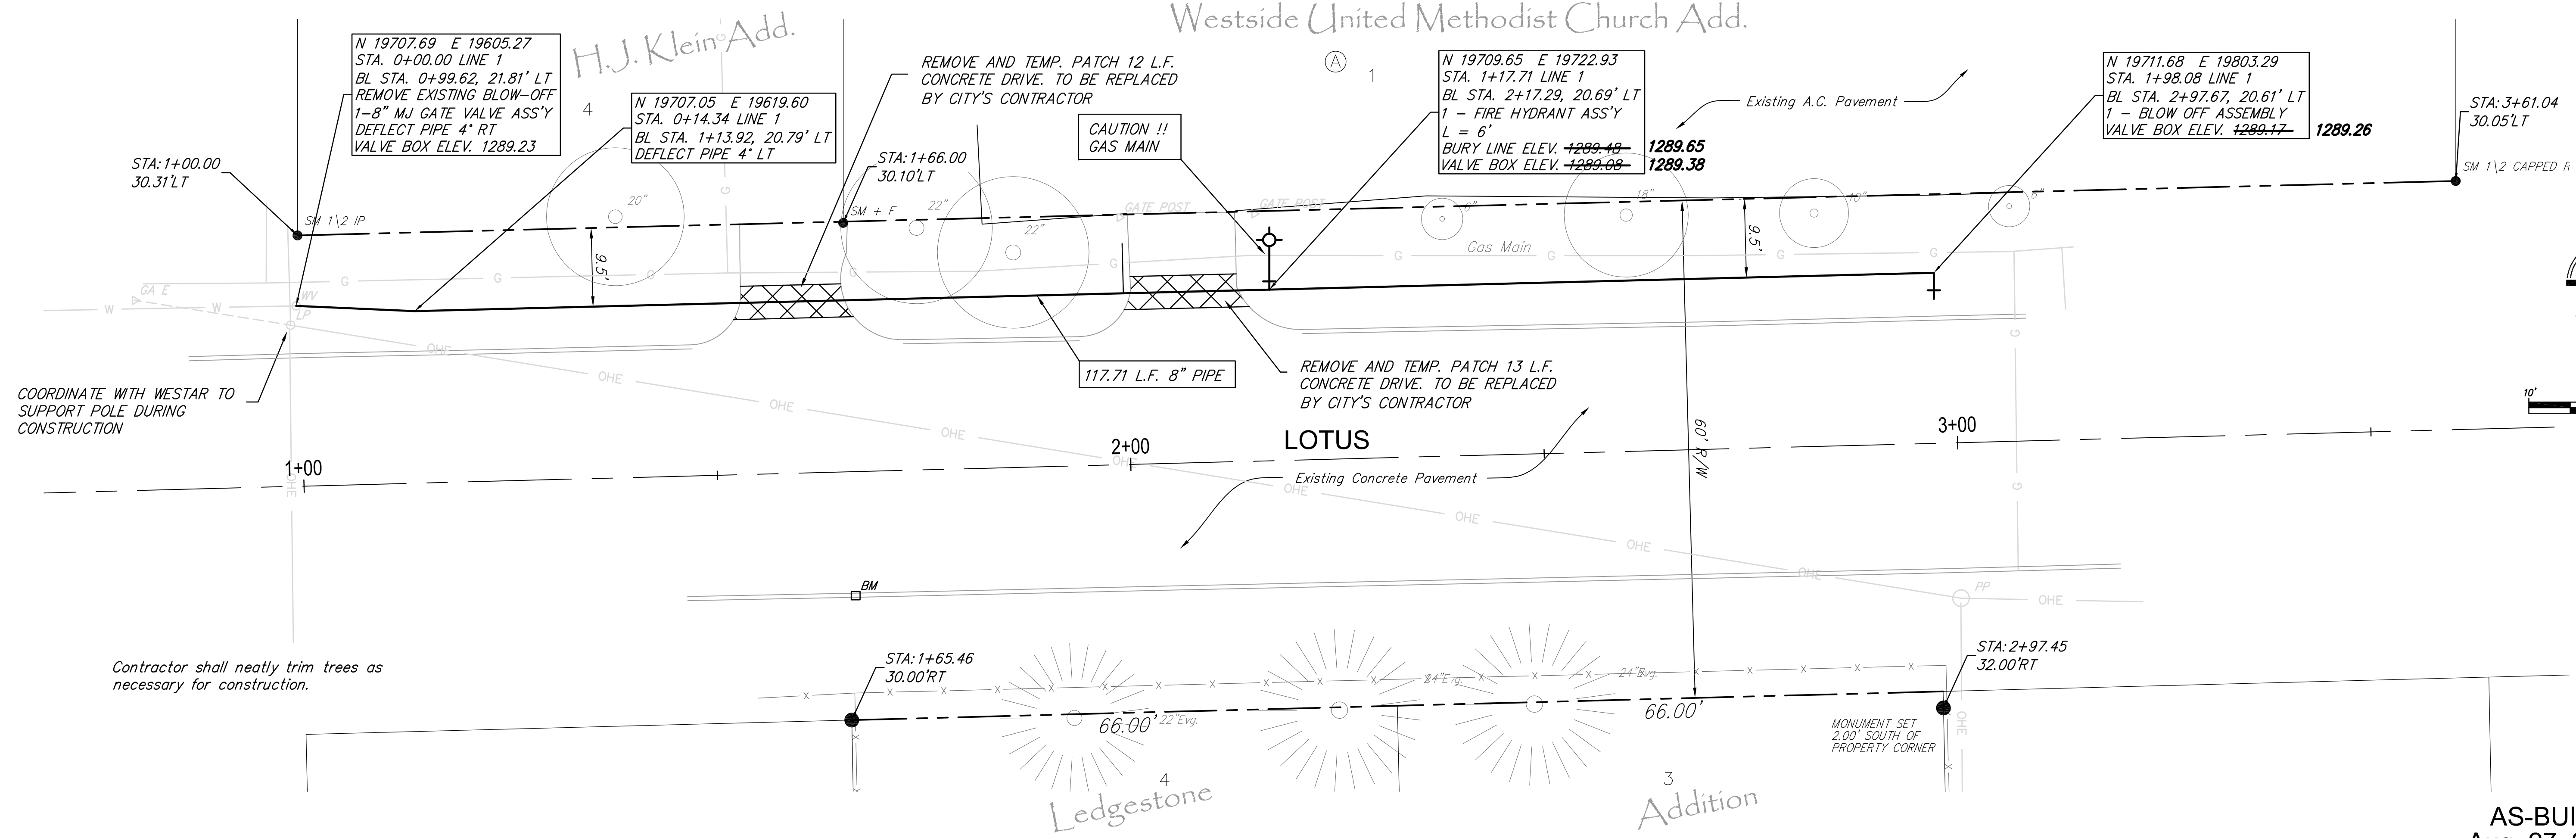

Contractor shall neatly trim trees as necessary for construction.

AS-BUILT
Aug. 27, 2009

Krugles & Bohm, P.A.
 Engineering, Surveying, Land Planning
 924 North Main
 Wichita, Kansas 67203
 Phone: 316-261-0000
 Fax: 316-261-0001
 www.kruglesandbohm.com

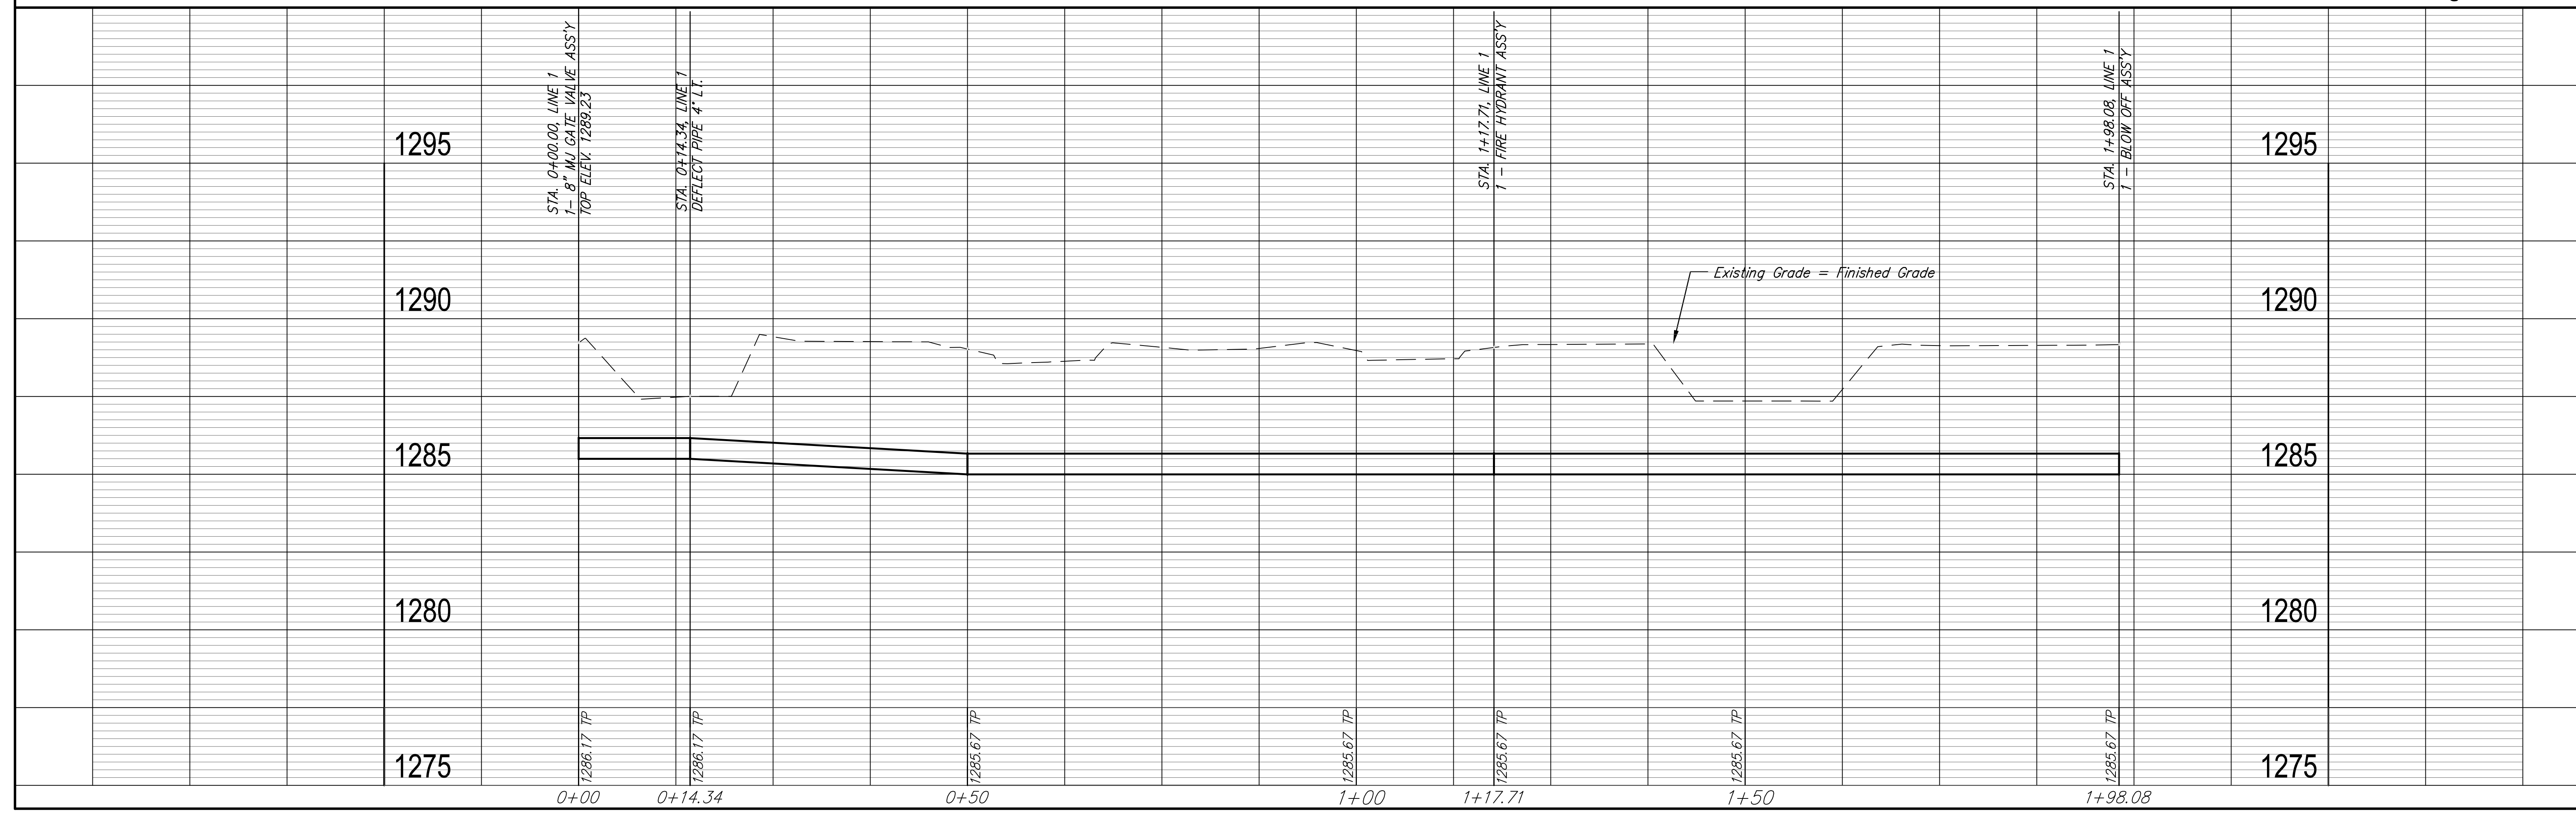

REVISION	8-27-09	REVIEW
DRAWN	RA	DATE
DESIGN	KWL	UTILITY
PROJECT NUMBER	DRAWING FILE	
PAVING IMPROVEMENTS STREET WICHITA, KANSAS		
RR JOB	3427W	
SHEET	5	