

# PRIVATE FIRE SERVICE LINE

TO SERVE


## LUBRICANT RECYCLING FACILITY

### UNIVERSAL LUBRICANT, LLC

PRIVATE PROJECT NO. 1427 PPW (607853)

## CITY OF WICHITA, KANSAS

JAMES L. ARMOUR, P.E. - CITY ENGINEER

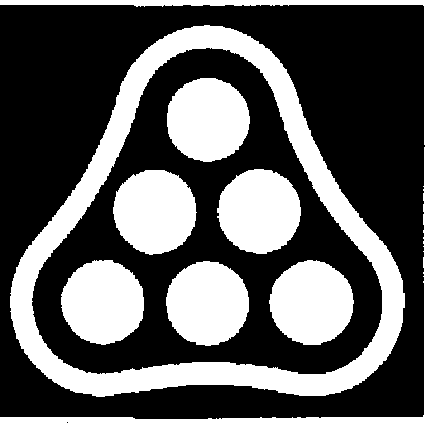


Professional  
Engineering  
Consultants

303 S. TOPEKA • WICHITA, KANSAS 67202  
316-262-2691 • FAX 316-262-3003  
www.pce1.com • designers@pce1.com

**INDEX OF SHEETS**

SHEET NO. C1.1	TITLE SHEET
SHEET NO. C1.2	KEY MAP AND GENERAL NOTES
SHEET NO. C1.3	FIRE SERVICE LINE PLAN/PROFILE
SHEET NO. C1.4	FIRE SERVICE LINE PLAN/PROFILE
SHEET NO. C1.5	FIRE SERVICE LINE PLAN/PROFILE
SHEET NO. C2.1	STANDARD WATER ASSEMBLY DETAILS
SHEET NO. C2.2	STANDARD VAULT DETAILS AND METER ASSEMBLIES
SHEET NO. C3.1-C3.3	SOIL EROSION BMP DETAILS

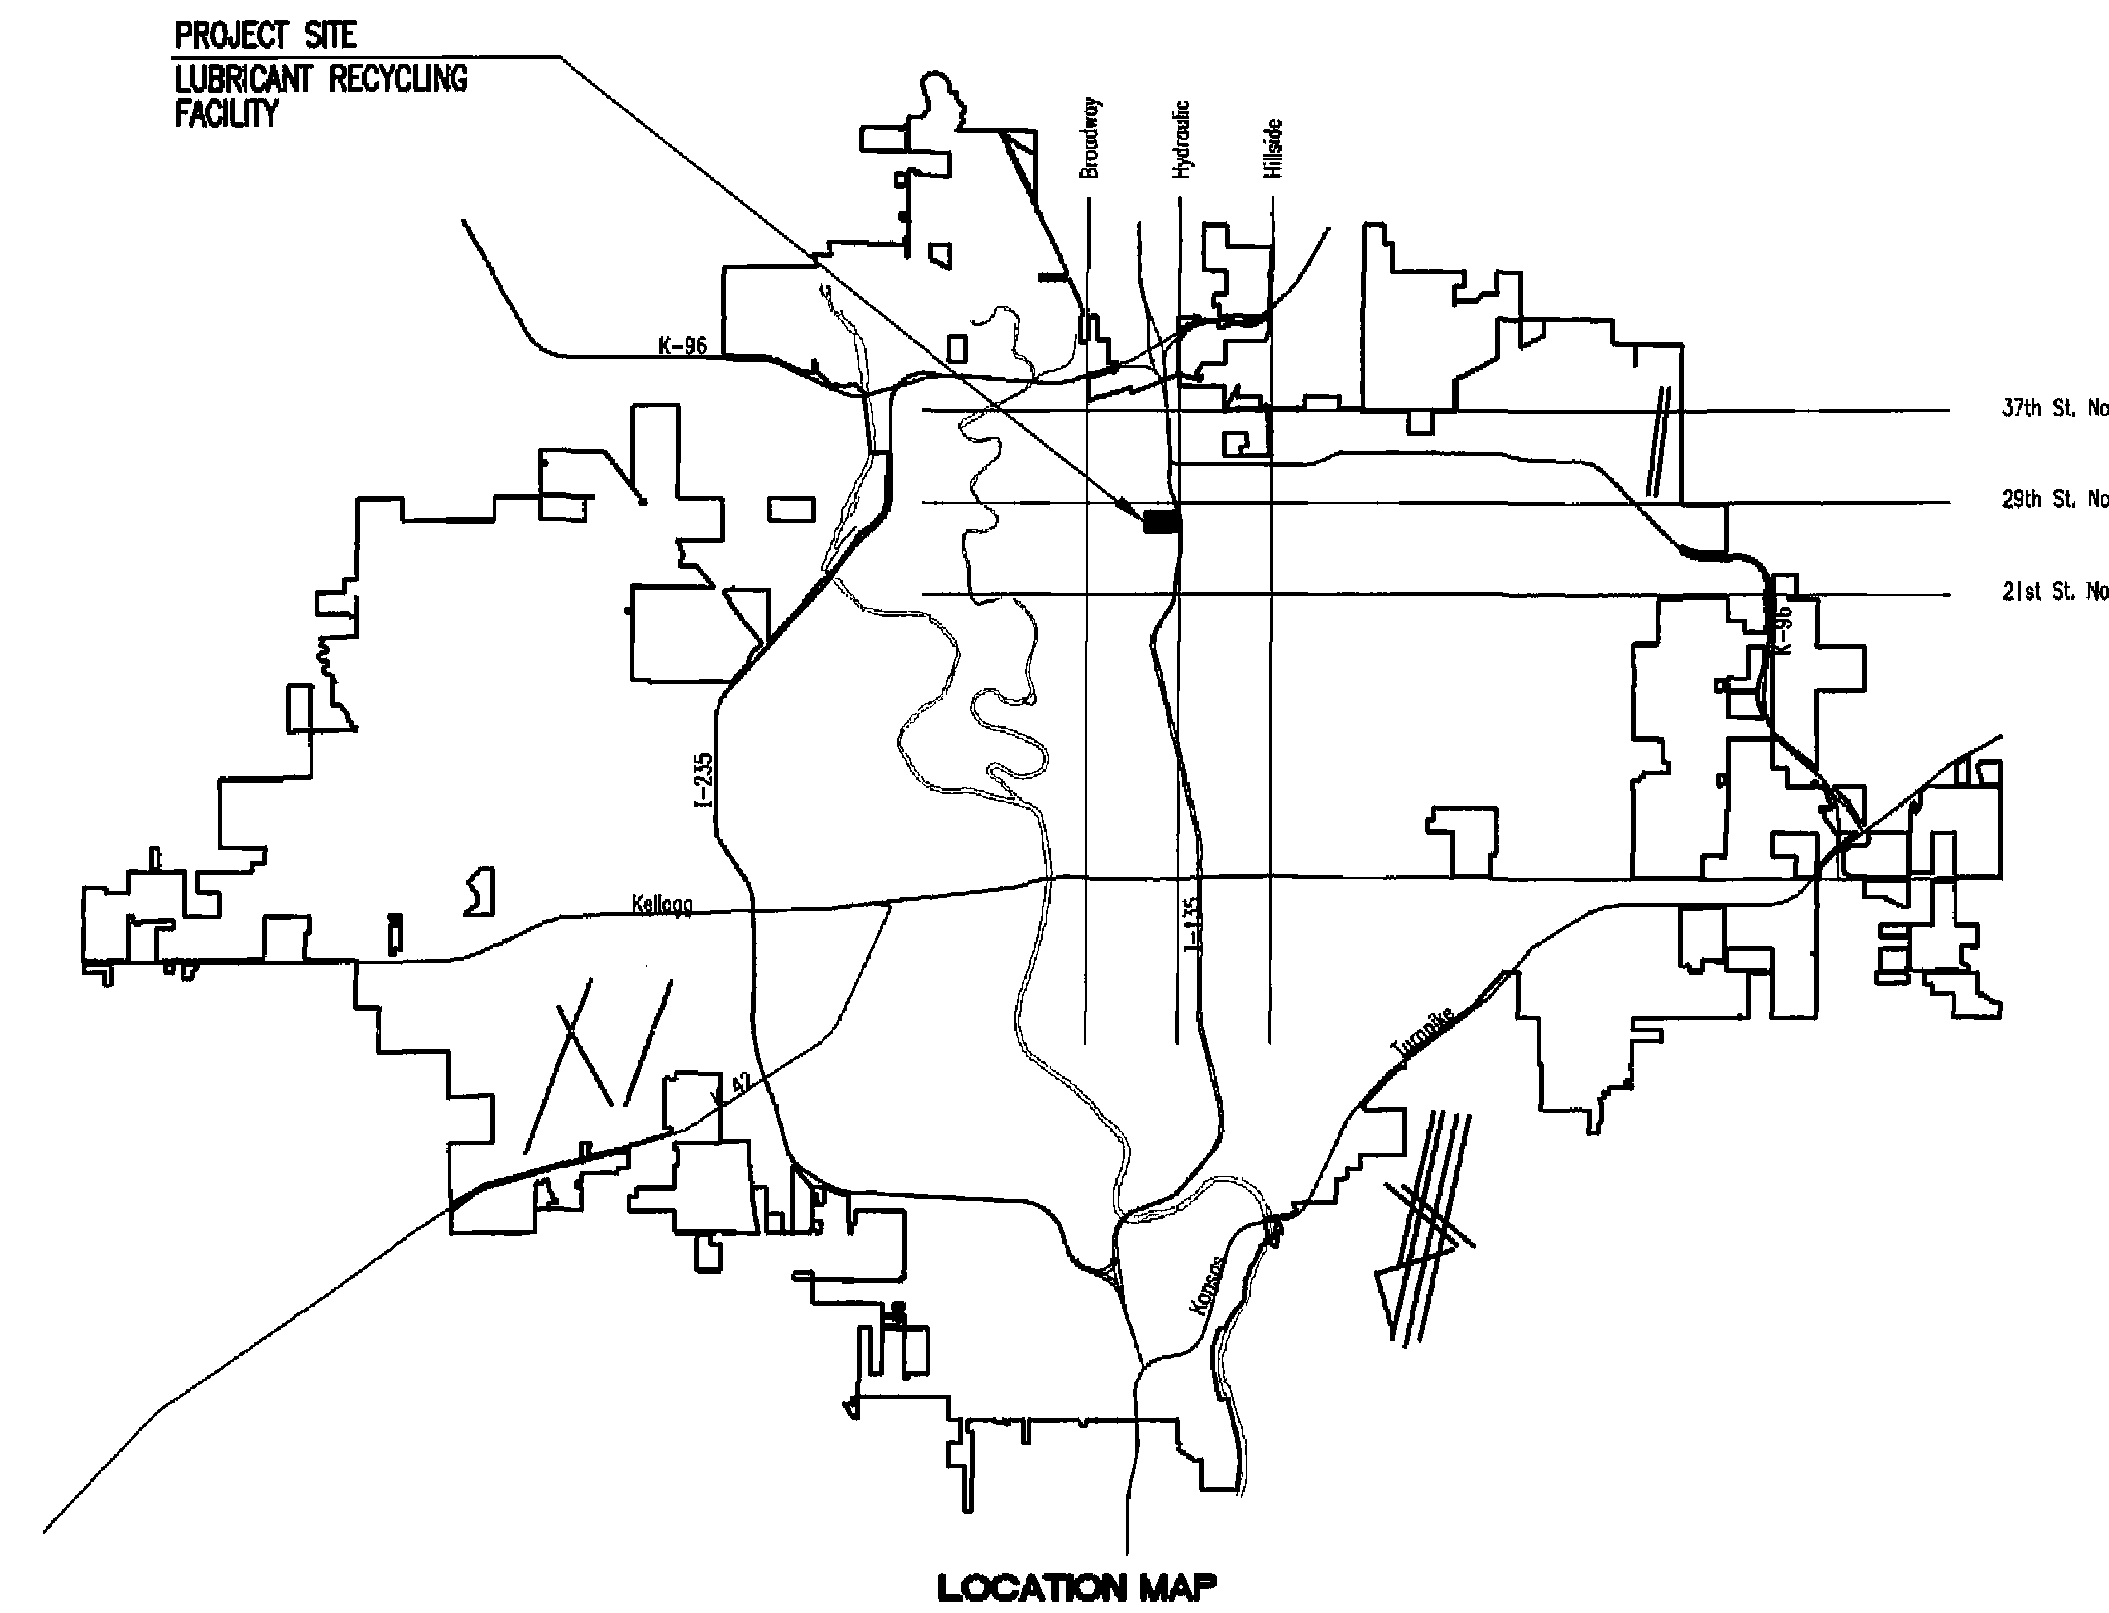

LOCATION MAP

APPROVED AS NOTED  
BY CITY ENGINEER OF WICHITA,  
BY WICHITA WATER UTILITIES  
& BY WICHITA FIRE DEPARTMENT

Water Mains (Public Works) Julianne Kallman 8-5-08


Water Mains (Water Utilities) JLP 8/1/08

Fire Prot. Line \_\_\_\_\_

**NOTE TO CONTRACTORS**

**PUBLIC PROPERTY:**  
Inspection and testing for the waterline is to be provided by a Licensed Consulting Engineering Firm under contract with the Owner/Developer. Said inspection to be in accordance with the City of Wichita standard construction engineering practices and certified by a Licensed Professional Engineer licensed in the State of Kansas. No work shall be performed in dedicated easements or public right-of-way by the Contractor without such inspection nor shall any work be commenced without written authorization by the City Engineer. All Construction and Materials shall comply with the City of Wichita Specifications and Standards (on file and available in the City Engineer's Office).

**PRIVATE PROPERTY:**  
Installation and testing for the fire protection line is to be performed by a City of Wichita licensed fire protection contractor in accordance with the fire codes as adopted by the City of Wichita. All materials and construction practices for the fire protection line shall comply with the fire codes as adopted by the City of Wichita (available from the City of Wichita Fire Department). The Contractor shall not commence work without notification and approval of the Wichita Fire Department.  
Inspection of the fire protection line is to be provided by the City of Wichita Fire Department and by a licensed Consulting Engineering Firm under contract with the Owner/Developer.  
The contractor shall not start work until the project inspector is assigned to the project and present on the site. Any work done without inspection will be required to be uncovered for inspection.

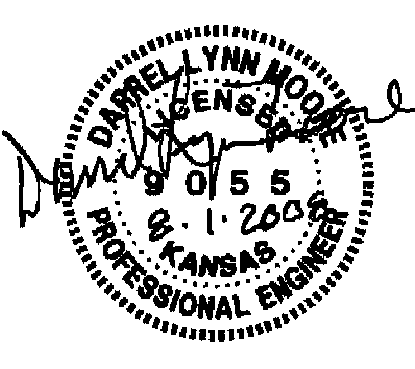

LUBRICANT RECYCLING FACILITY  
UNIVERSAL LUBRICANTS, LLC  
WICHITA, KS

**JULY 2008**

PLANS PREPARED BY

## PROFESSIONAL ENGINEERING CONSULTANTS, P.A.

ENGINEERS  
WICHITA, KANSAS

RECORD DRAWINGS  
CONTRACTOR: WILDCAT CONSTRUCTION  
INSPECTOR: STEPHEN LORSON  
.pdf by: SL Date: 9/11/2009  
Inspectors Initials Date

Inspecting Firm: P.E.C.

TITLE SHEET

JOB NO. 07172-003	<b>C1.1</b>
DATE JULY 2008	-
DRAWN CAE	<b>10</b>
CHECKED KLR	

Save: 08-06-2008 1:02:35 PM by: GBU  
Plot: Scale: 1:1 Date: 08-06-2008 2:59:55 PM  
C:\2007\07172\003\PLAN\07172-003-01-1-PPW.dwg