


WL Sta. 00+00.00 Line 1  
 BL Sta. 15+06.91 30.25 Rt  
 \*1- 12"x8" Tapping Sleeve  
 \*1- 8" Tapping Valve  
 \*1- 6" Valve Box  
 Valve Box Elev. = 1345.00  
 \*To be Installed by COW  
 \*To be Paid by Contractor  
 \*\*See Notes (this sheet)\*\*

WL Sta. 00+17.00 Line 1  
 BL Sta. 15+06.91 47.25 Rt  
 1- Fire Hydrant Assembly  
 L = 20.00', H = ~~5.00'~~ 4.50'  
 Buryline Elev. = 1346.50  
 Top of Box = 1346.50  
 1- 8" MJ Cap (S)

Lot 4, Block 1  
Hentzen Addition

**\*\* Notes \*\***  
 Contractor to field verify, size, location, depth, and material of existing water line. If location is different than shown, contractor and engineer shall determine in field an acceptable solution.

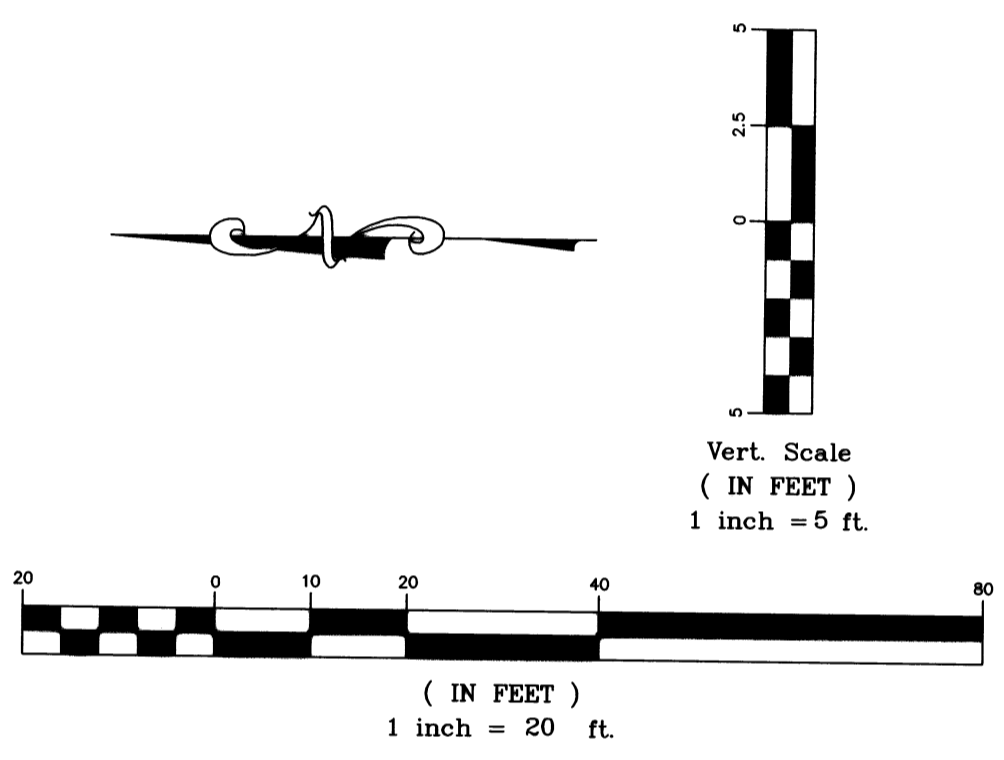

1350	Existing 12" Main	22.5" MJ Bend (vert)	22.5" MJ Bend (vert)	11.25" MJ Bend (vert)	11.25" MJ Bend (vert)	Fire Hydrant Assembly	L = 20.00', H = <del>5.00'</del> 4.50'	Buryline Elev. = 1346.50	Clow (STORZ)	1350
1340										1340
1330										
	Ex. 8" Top = 1341.16±	8" Top = 1341.00	8" Top = 1339.37 +03.25	8" Top = 1339.37 +05.25	8" Top = 1342.12 +17.00					
	0+00				0+50					

**Hentzen Addition  
Water Line  
Wichita, Kansas**

	PROJECT NUMBER			
	KEM NO. 09031	FILE ppw	DATE 06/30/09	SHEET 2
DESIGN KM	DRAWN NS	REVISED	OF 3	

516 S. Market, Wichita, KS 67202      316/264-0242