

CONSTRUCTION PLANS
FOR
ROCKY CREEK RELIEF SANITARY SEWER

MAIN 14 C, FOUR MILE CREEK



PROJECT NO. 468-84218

THE CITY OF WICHITA, KANSAS
JAMES L. ARMOUR, CITY ENGINEER

OCA NO. 624078

WILDCAT CONSTRUCTION - CONTRACTOR
REGNIER/KAVAN - CITY OF WICHITA, INSPECTORS
AS-BUILT
RELEASE DATE: 07/14/2009
PDF: APRosas 08/28/2009

MKEC
ENGINEERING
CONSULTANTS, INC.
411 N. WEBB ROAD
WICHITA, KS. 67206
316-684-9600

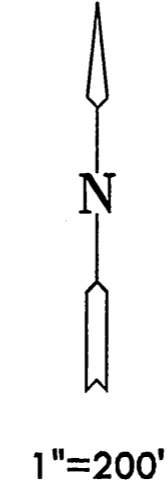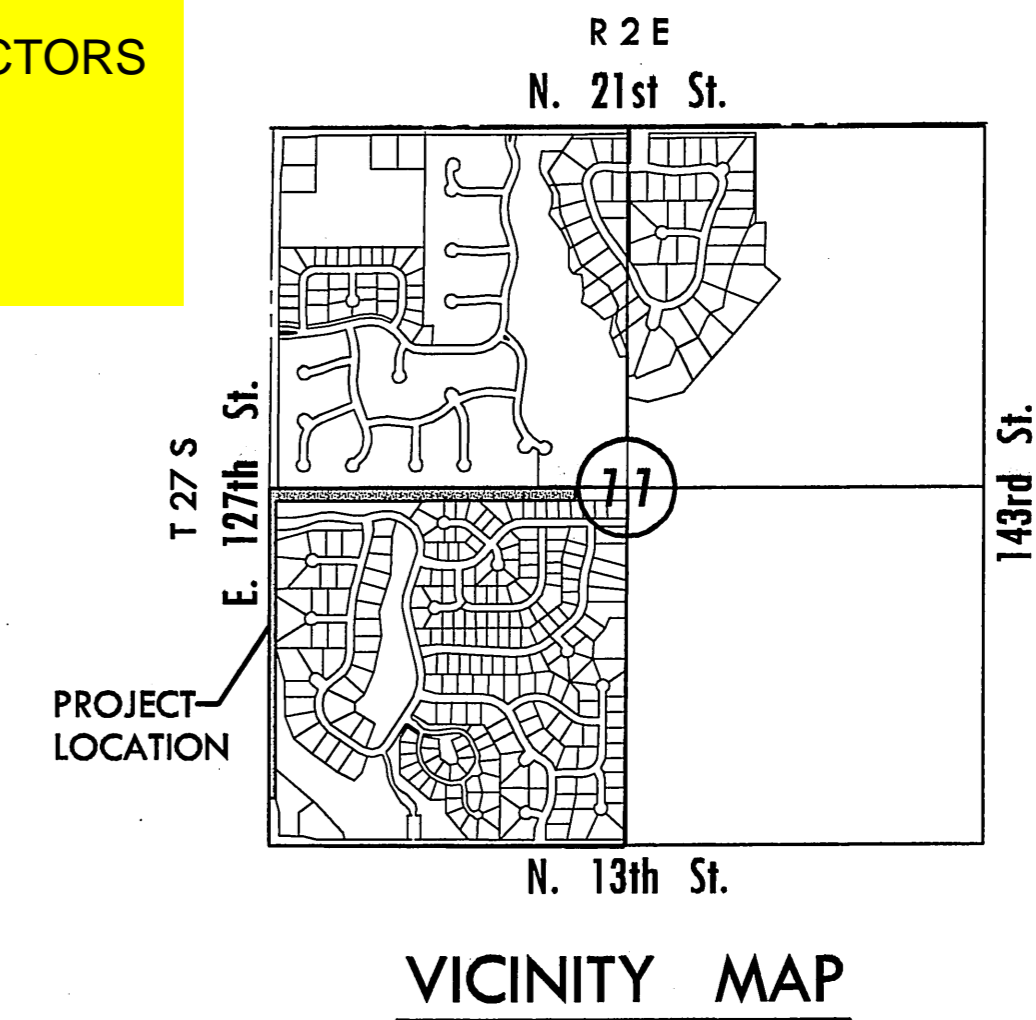

BENCHMARKS

- BM #10 Chiseled square on top of north curb of Birdwood at fire hydrant, 52' West of centerline of 127th Street East. Elev. = 1341.68 NGVD 29.
- BM #11 Chiseled square on north end of west hub guard of bridge on 127th Street East, 1438' North of centerline 13th Street North, 357' North of centerline Edgewood, 14' West of centerline 127th Street East. Elev. = 1347.53 NGVD 29.
- BM #12 Chiseled square on top of north curb Castlewood, 55' West of centerline 127th Street East. Elev. = 1353.78 NGVD 29.
- BM #13 60d spike in south leg of "H" pole High line structure, 75' North and 80' East of the centerline of the intersection of 127th Street East and the abandoned SL & SF Railway. Elev. = 1366.37 NGVD 29.
- TBM #1 Top of a 5/8" bar with red "MKEC Design Point" cap, 774' East of centerline 127th Street East, on south side of abandoned railroad grade. Horizontal control point #106. Elev. = 1366.69 NGVD 29.
- TBM #2 Top of a 5/8" bar with red "MKEC Design Point" cap, 2600 feet East of centerline 127th Street East, in center of abandoned railroad grade. Horizontal control point #107. Elev. = 1349.14 NGVD 29.
- BM #14 Chiseled square on east end of south headwall of reinforced concrete box under abandoned railroad, 125' East of the Center of Sec. 11, T. 27 S, R. 2 E. Elev. = 1347.82 NGVD 29.

INDEX TO DRAWINGS

SHEET NO.	DESCRIPTION
1	TITLE SHEET
2	MANHOLE DETAILS
4-9	LINE 1
10-11	TREE PROTECTION FENCE
12	RAILED ROCK REPLACEMENT
13	WATER RELOCATION
14	PAVING REPLACEMENT
15	ROAD CLOSING
16-19	TRAFFIC CONTROL
20-21	LANDSCAPE/SEEDING
22	BUBBLE MAP
23-27	BMP DETAILS
28-39	CROSS SECTIONS
40-42	PLATS

ROCKY CREEK RELIEF SANITARY SEWER

TITLE SHEET

SHEET TITLE
468-84218
PROJECT NUMBER

DFL / KKL / GAR
DESIGNED DRAWN CHECKED

ISSUED
June 2008

REVISED

SHEET NO.
1 of 42