


**ROCKY CREEK
RELIEF SANITARY SEWER**

LINE 1
SHEET TITLE
468-84218
PROJECT NUMBER


DFL
DESIGN BY
KKL
DRAWN BY
GAR
CHECKED BY

ISSUED
June 2008
REVISED

SHEET NO.
4 of 42

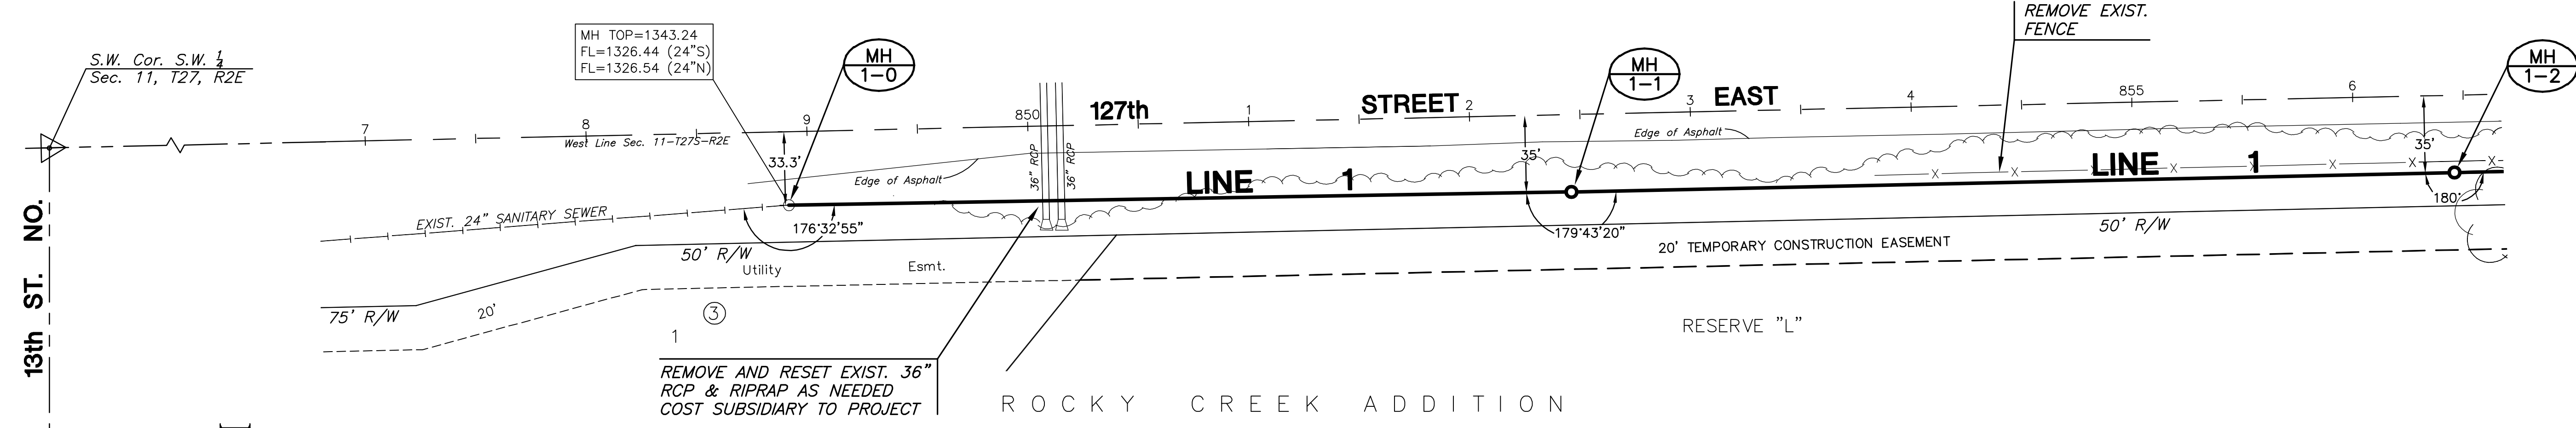

PLAN LINE 1

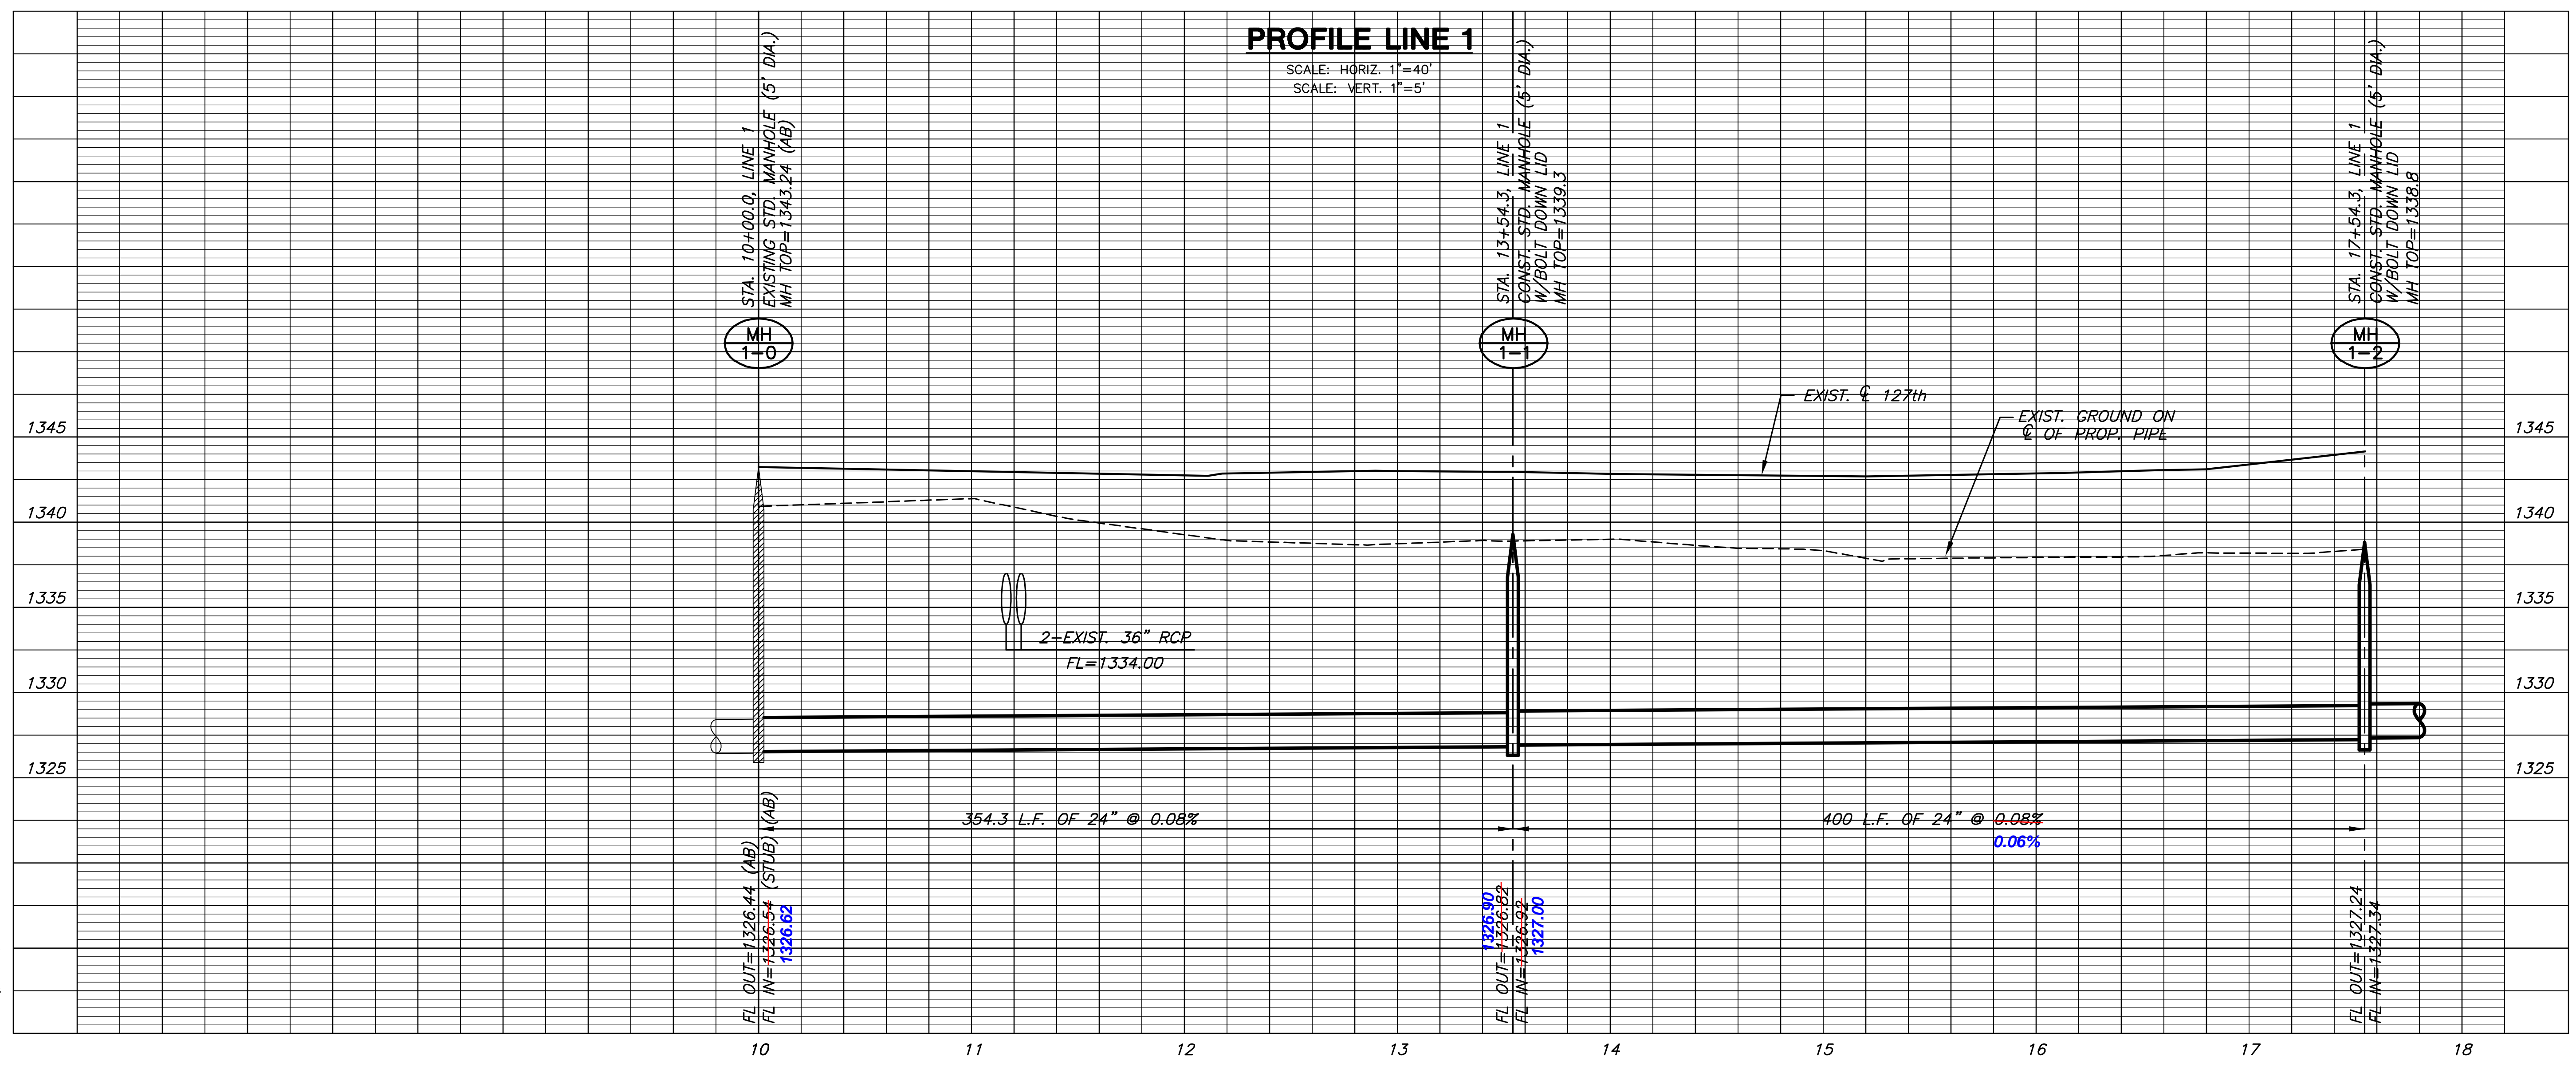

PROFILE LINE 1

PLOTTED: Wednesday, June 04, 2008 @ 02:42PM

J:\CIVIL\06693\WORK\SAN\06693_B1.DWG