

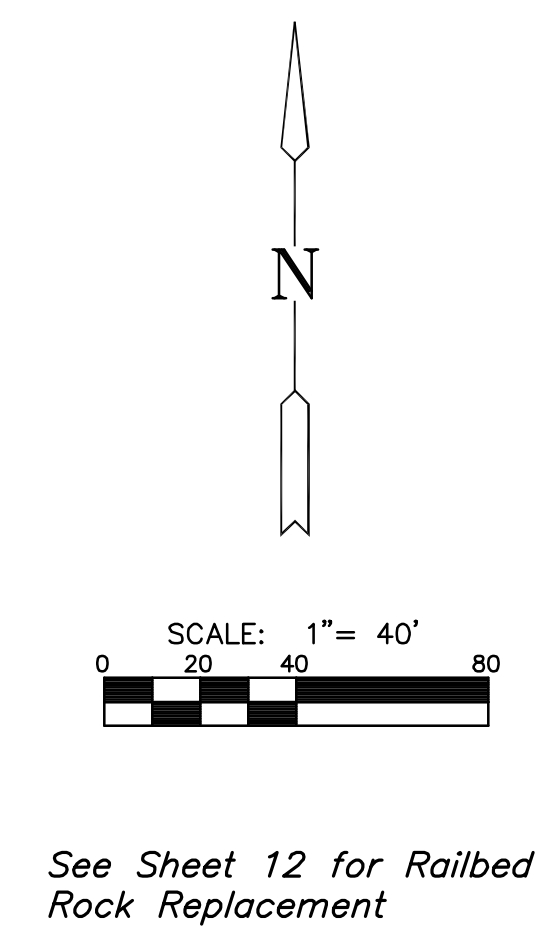


**ROCKY CREEK
RELIEF SANITARY SEWER**

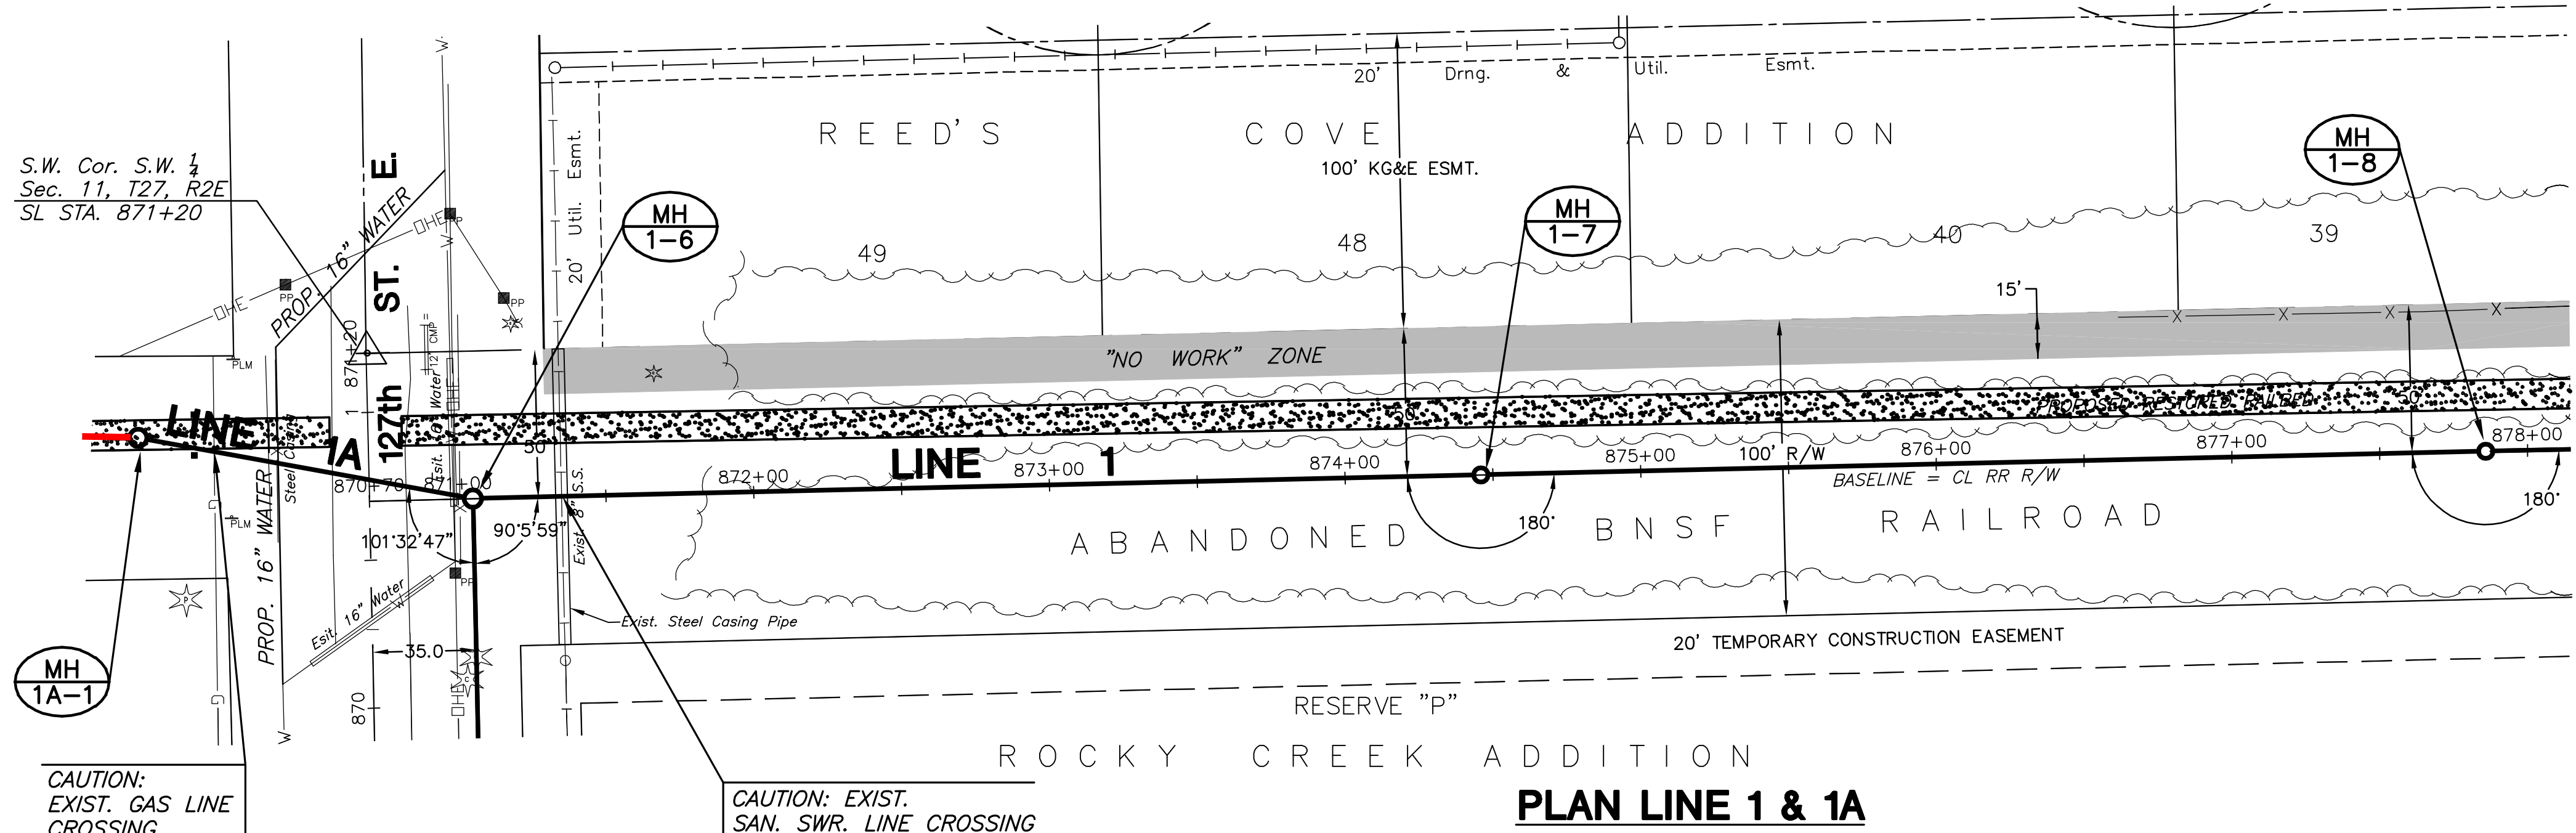

PLAN LINE 1 & 1A

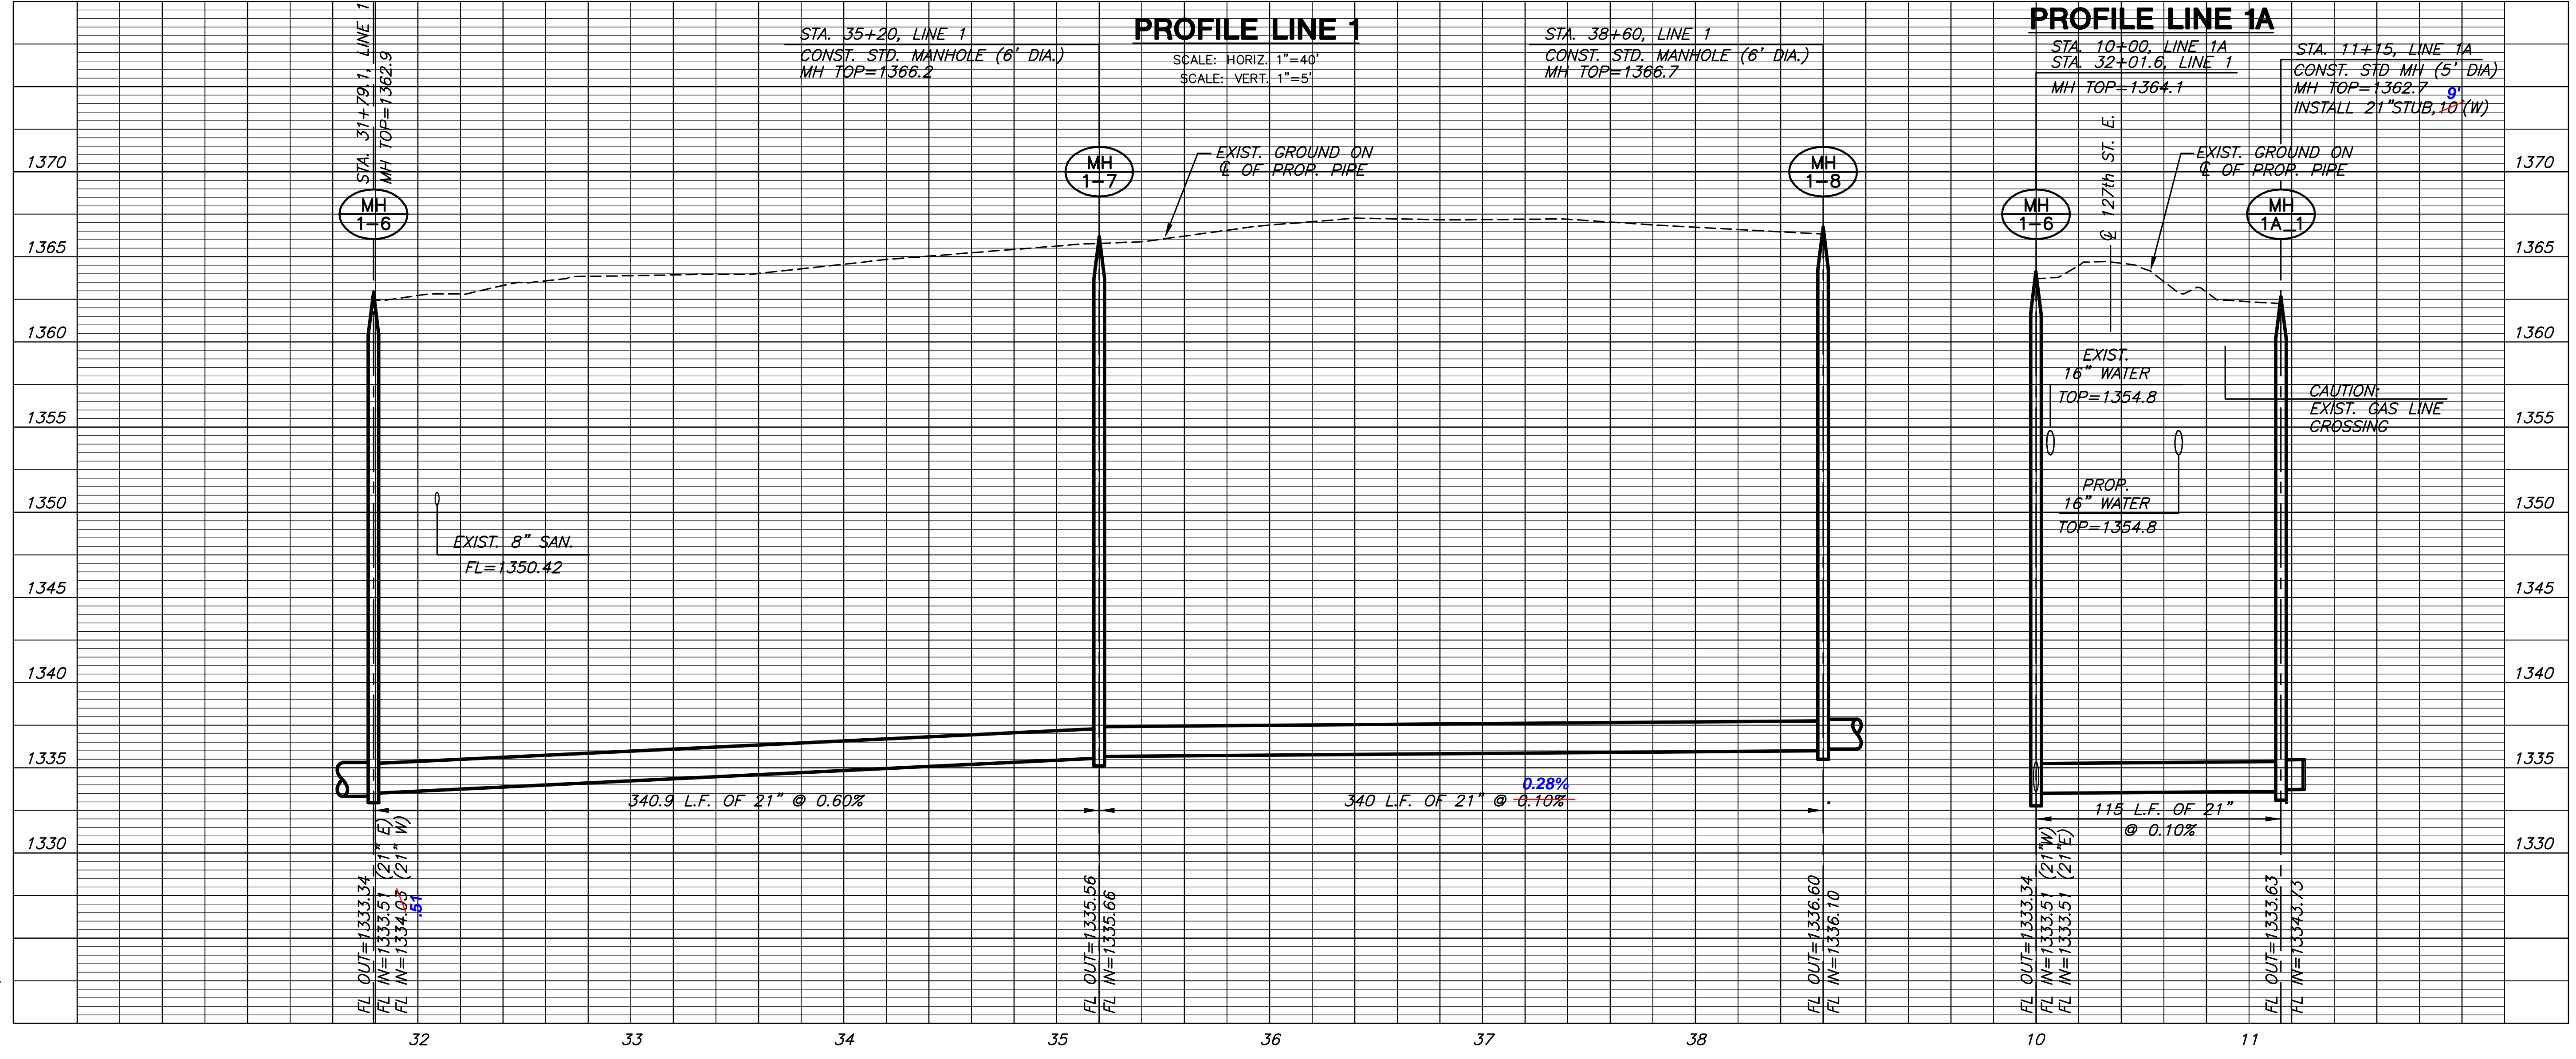

LINE 1
SHEET TITLE
468-84218
PROJECT NUMBER

DESIGN BY: DFL
DRAWN BY: KKL
CHECKED BY: GAR

ISSUED: June 2008
REVISED:

SHEET NO.
7 of 42

PLOTTED: Wednesday, June 04, 2008 @ 02:43PM

J:\CIVIL\06693\WORK\SAN\06693_B4.DWG