

# Main 29

of the

## War Industries Sewer

### CITY OF WICHITA, KANSAS

James L. Armour, P.E. City Engineer

Project Number  
468-84560  
O.C.A. Number  
744299

Wildcat Construction - Contractor  
K. Yale - City of Wichita, Inspector  
As-built  
Stubs  
Release Date: 05/20/2009  
pdf: ARosAs 08/03/2009

#### SHEET INDEX:

Title Sheet	1
Line 1	2-4
Standard Manhole Detail	5
Ring & Cover Detail	6
Erosion Control BMP's	7-10
Coordinate Sheet	11

#### GENERAL NOTES:

- Contractor will be required to provide notice to utility companies a minimum of twenty-four (24) hours prior to any excavation, as follows:

Kansas One-Call 687-2470

The Contractor must notify the following in case of an emergency:

Cox Communications	262-4270
Kansas Gas Service	1-888-482-4950
Westar Energy	383-8650
Aquila Energy	1-888-482-4950
Southwestern Bell	268-2245
City of Wichita Water Dept.	268-4563
City of Wichita Sewer Maint.	268-4024
City of Wichita Storm Sewer Maint.	268-4090
City of Wichita Traffic Maint.	268-4034
Conoco Pipeline Co.	1-800-231-2551
Williams Pipeline Co.	529-6600
Phillips Pipeline Co.	1-800-766-8230


- Underground utility service lines and overhead utility pole lines are to be adjusted as necessary by others prior to construction unless the plans specifically call for their adjustment by the Contractor or unless the plans specifically identify a utility to be adjusted by its owner during construction. Existing utilities and their location, as shown on the plans, represent the best information obtainable for design. The Contractor will be required to work around existing utilities within the right-of-way which do not conflict with proposed construction.
- Trees and shrubs in public right-of-way which are in direct conflict with proposed new construction shall be removed by the Contractor with the Engineer's approval. Trees and shrubs which are not in direct conflict with proposed new construction shall be saved and protected from damage.
- The Contractor shall give all property owners and/or tenants of developed property abutting the construction of this project a minimum of ten (10) days advance notice prior to start of construction.
- The Contractor shall be responsible for preserving property irons. The Contractor will be required to re-establish any property irons which are damaged or destroyed by his construction operations. Such irons shall be reestablished by a licensed land surveyor in accordance with state laws.
- The Contractor shall be responsible for maintaining continuous flow of sewage through construction. Contractor's proposed method for maintaining sewage flow shall be approved by the Engineer. Cost of maintaining flow of sewage through construction will not be paid for directly and this cost shall be considered as subsidiary to the other pay items of work.
- The developer for this project is Ritchie Development, (316) 684-7300.

- Following construction, all disturbed areas shall be re-graded and restored to pre-construction grades. Any excess earth remaining from excavation shall be wasted on-site at a location to be determined by the engineer.
- All existing and proposed erosion control measures including silt fencing, erosion control mat, straw bales, inlet barriers, and const. entrance shall be maintained throughout construction by the contractor and until project is accepted by the City of Wichita. The on-site engineer shall complete weekly reports on the status of erosion control measures. The contractor shall be required to comply with maintenance and/or replacement of erosion control measures as determined by the on-site engineer until project is accepted by City of Wichita. Cost to be included in "Site Clearing and Restoration."
- All areas disturbed during construction shall be seeded at 300 lbs./acre with Rye Grass immediately following construction in that area. Contractor shall prepare ground per City Specifications. Cost shall be paid by bid item "Project Seeding."

#### BENCHMARKS:

BM #1: RR Spike in west face of 2nd power pole north of 29th St. N., east side of Greenwich Road.  
Elev. = 1388.93

BM #2: RR Spike in west side power pole, east side of Greenwich Road, north side of drive to House #3150.  
Elev. = 1398.38

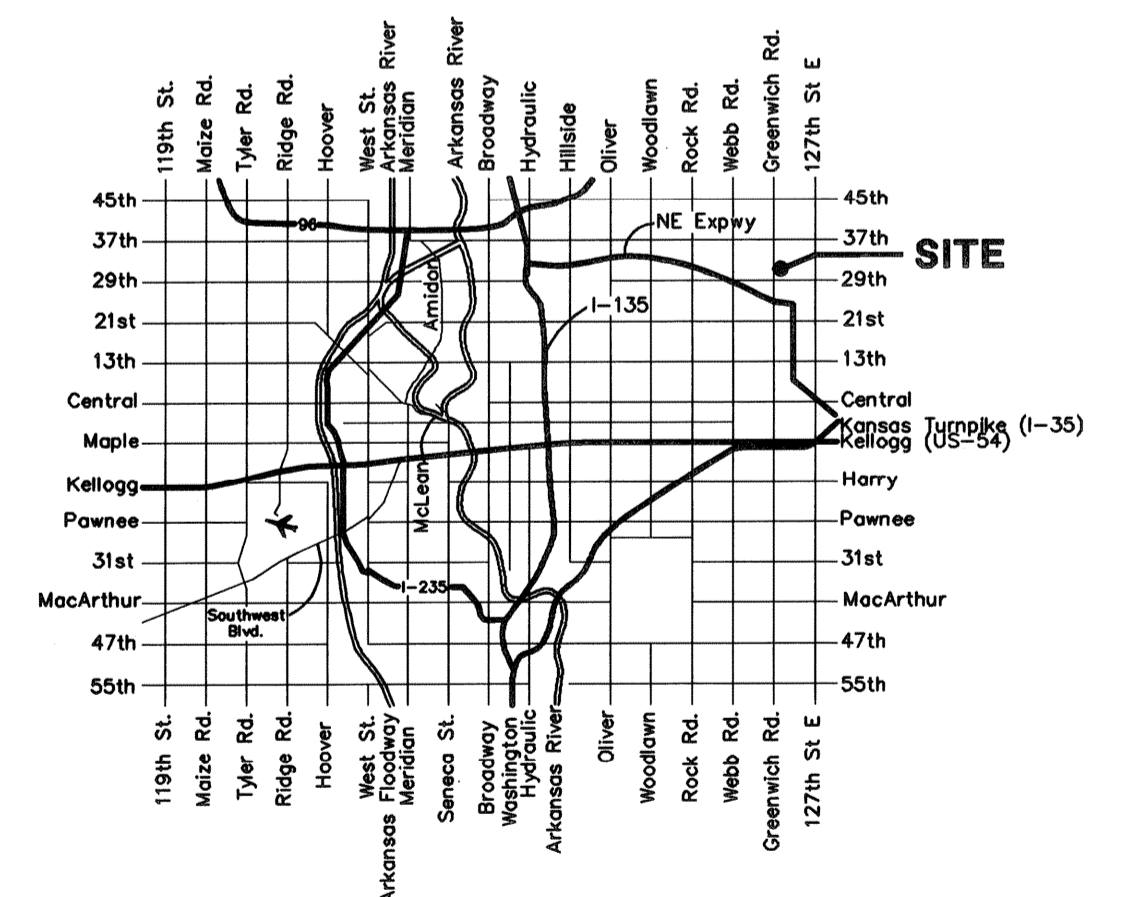

Vicinity Map

BENEFIT DISTRICT:

