


COUNTY	STATE	PROJECT NO.	YEAR	SHEET NO.	TOTAL SHEETS
SEDGWICK	KANSAS	87 N-0386-01	2009	86R	255


△ Revised 12/30/2009

GENERAL NOTES

1. Staked Sod shall be Buffalo and installed in accordance with the City of Wichita's Specifications
2. Light Stone Riprap shall be installed in accordance with the City of Wichita's Specifications.

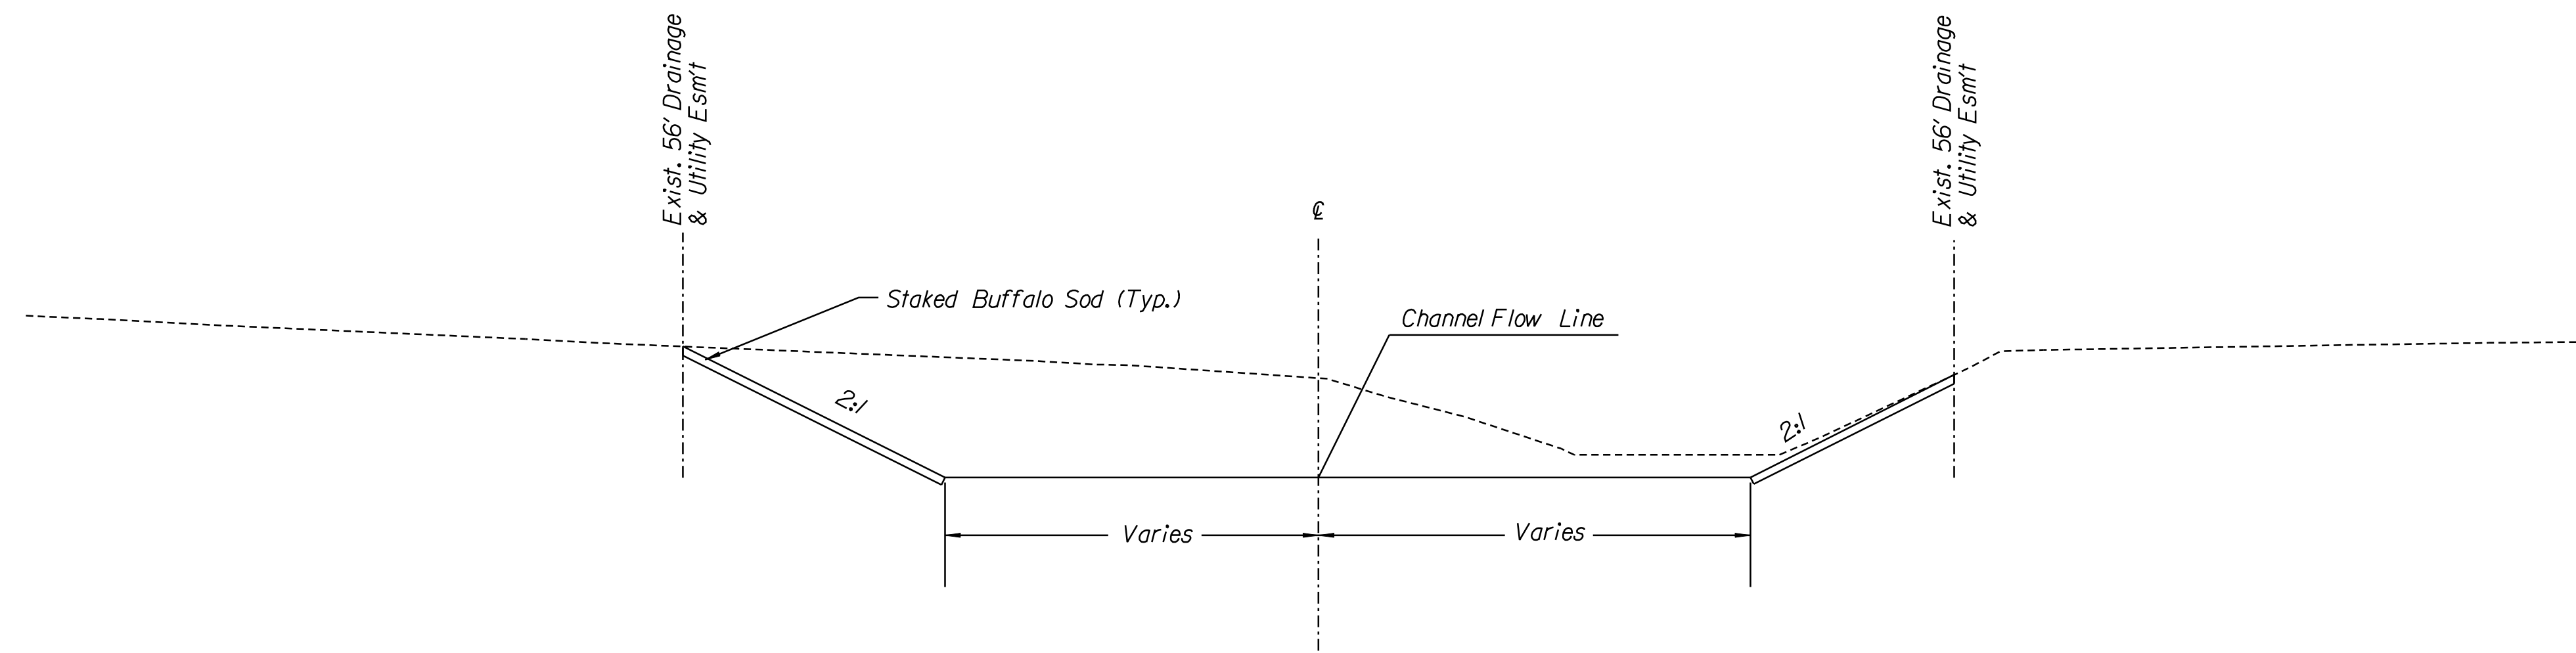


Channel Typical Section
(Sta. 5+75.50 to Sta. 10+72.68)

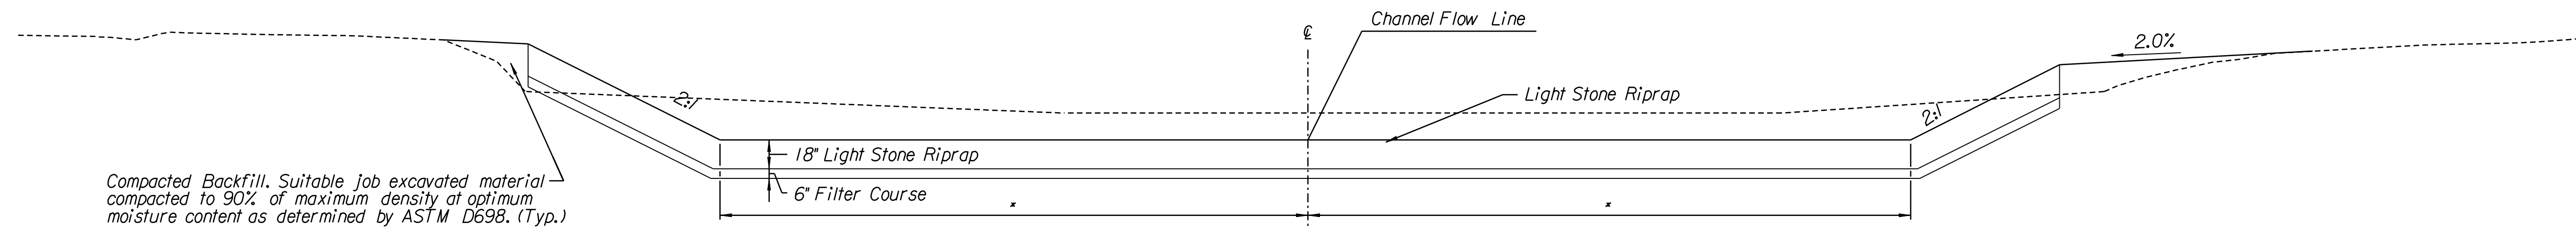

Compacted Backfill. Suitable job excavated material compacted to 90% of maximum density at optimum moisture content as determined by ASTM D698. (Typ.)


Channel Typical Section
(Sta. 10+72.68 to Sta. 11+00.00)
(Sta. 14+98.11 to Sta. 15+18.11)

* Variable Width from Sta. 10+72.60 to Sta. 10+92.60
30' Channel Width from Sta. 14+96.36 to Sta. 15+18.11

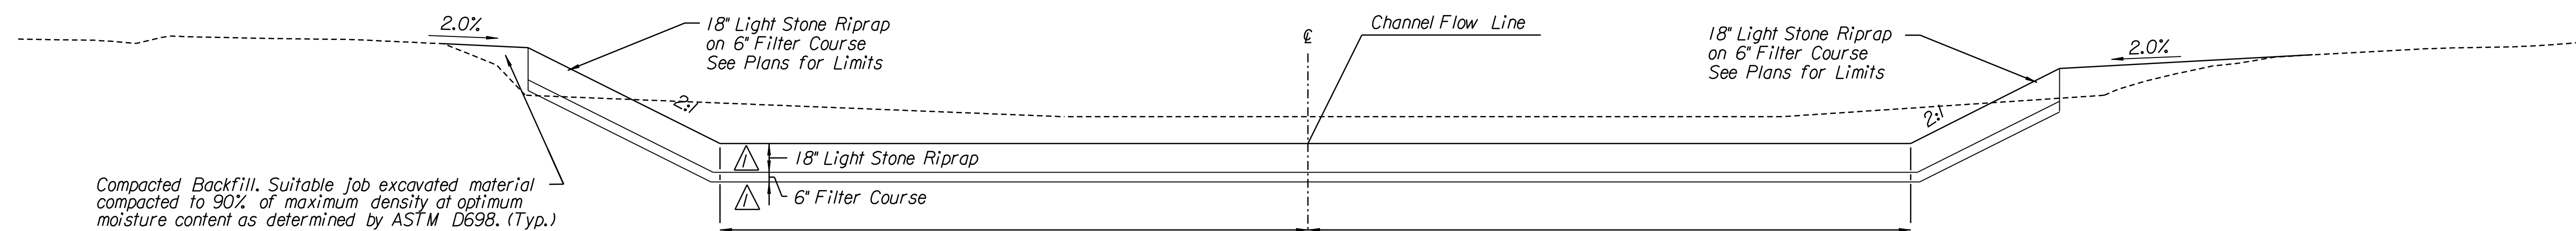

Compacted Backfill. Suitable job excavated material compacted to 90% of maximum density at optimum moisture content as determined by ASTM D698. (Typ.)

Channel Typical Section
(Sta. 14+82.64 to Sta. 14+95.11)

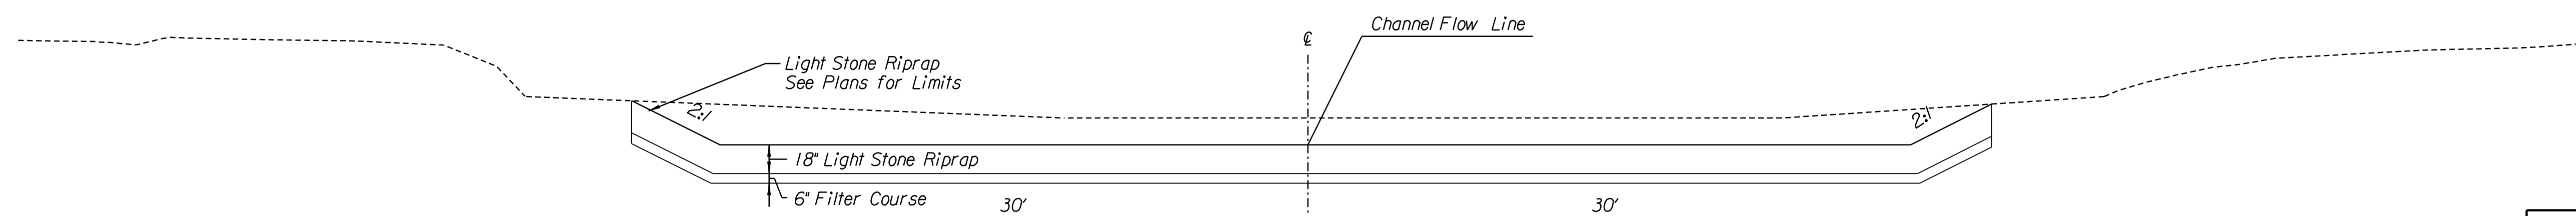

Channel Typical Section
(Sta. 15+18.11 to Sta. 15+96.84)

K:\35751A\CADD\SHEETS\DRAINAGE\CHANNEL TYP.DGN

SURV. PLOT CADD DES. RAN DR. JR TR. CKD. JUR APP.

CITY OF WICHITA JAMES ARMOUR, P.E., CITY ENGINEER	
TYPICAL SECTIONS CHANNEL & POND	
PB PARSONS BRINCKERHOFF <small>188. Wichita, Kansas</small>	
SCALE N.T.S.	DATE 11/23/2009
DWG. NO. 35751A	86R