


SPECIAL NOTES:

1. THE CONTRACTOR SHALL USE BEST MANAGEMENT PRACTICES TO CONTROL EROSION AND SEDIMENT DISCHARGE IN ALL DISTURBED AREAS OF CONSTRUCTION. THE CONTRACTOR SHALL PROVIDE ALL NECESSARY MATERIALS, AND EQUIPMENT, AND LABOR TO CONSTRUCT, OPERATE AND MAINTAIN TEMPORARY EROSION AND SEDIMENT CONTROLS DURING CONSTRUCTION. THIS WORK SHALL BE PAID FOR AS "SEEDING AND EROSION CONTROL".
2. THE CONTRACTOR SHALL FIELD VERIFY HORIZONTAL AND VERTICAL LOCATIONS OF EXISTING BURIED UTILITY LINES PRIOR TO CONSTRUCTION. REPORT ANY DISCREPANCIES TO THE ENGINEER.
3. ALL EXISTING RIP-RAP WITHIN CONSTRUCTION LIMITS SHALL BE REMOVED AND RE-INSTALLED TO NEW LOCATIONS SHOWN. ANY EXCESS RIP-RAP MATERIAL SHALL BE SALVAGED AND DELIVERED TO THE CITY OF DERBY AT HIGH PARK.

As-Built Drawing
1/25/10

YOUNG & ASSOCIATES, P.A.
Professional Civil Engineering Consultants
100 S. Geologie, Derby, KS 67037
tel: (316)788-2552 fax: (316)788-4408 email: engineering@yngpa.com

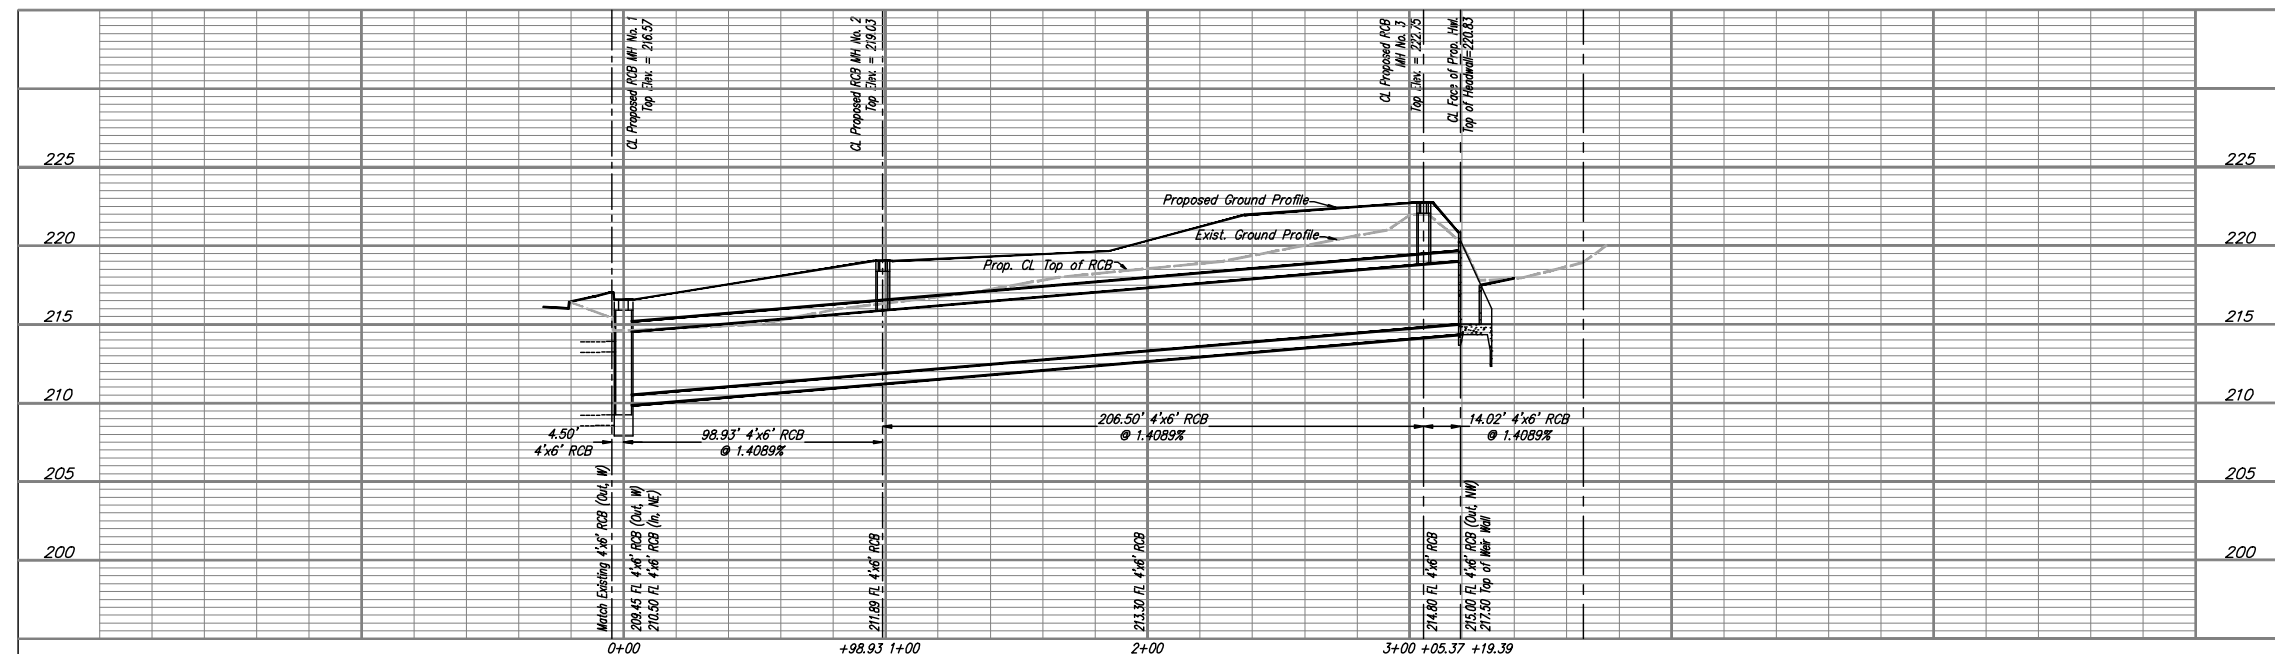

HOUSE OF SCHWAN ADDITION
3636 NORTH COMOTARA
WICHITA, KS

4x6\"/>

109039	
DATE:	11.12.08
REVISIONS	
12.11.2009	PERMIT RE-ISSUE

SW1.2