

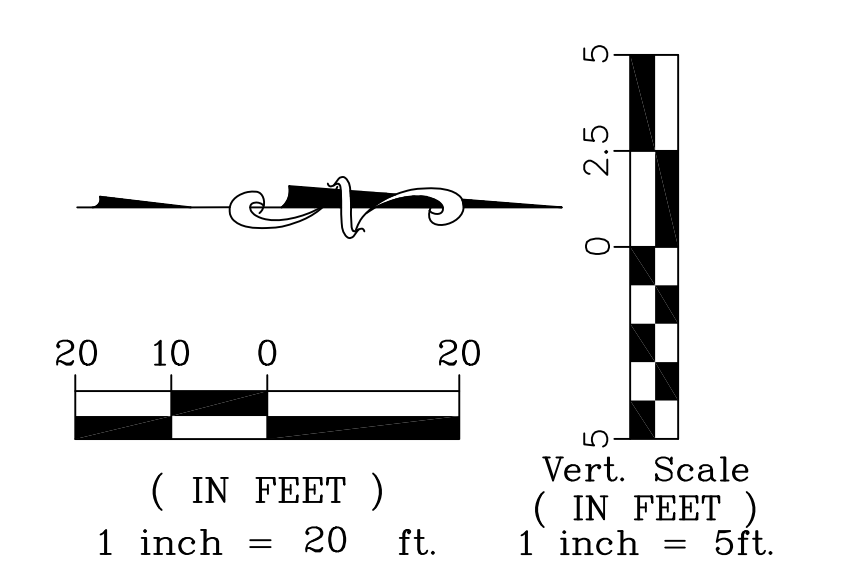


FHWA REG. NO.	STATE	PROJECT NO.:	YEAR	SHEET NUMBER	TOTAL SHEETS
	KANSAS				

MINNEHA AVE

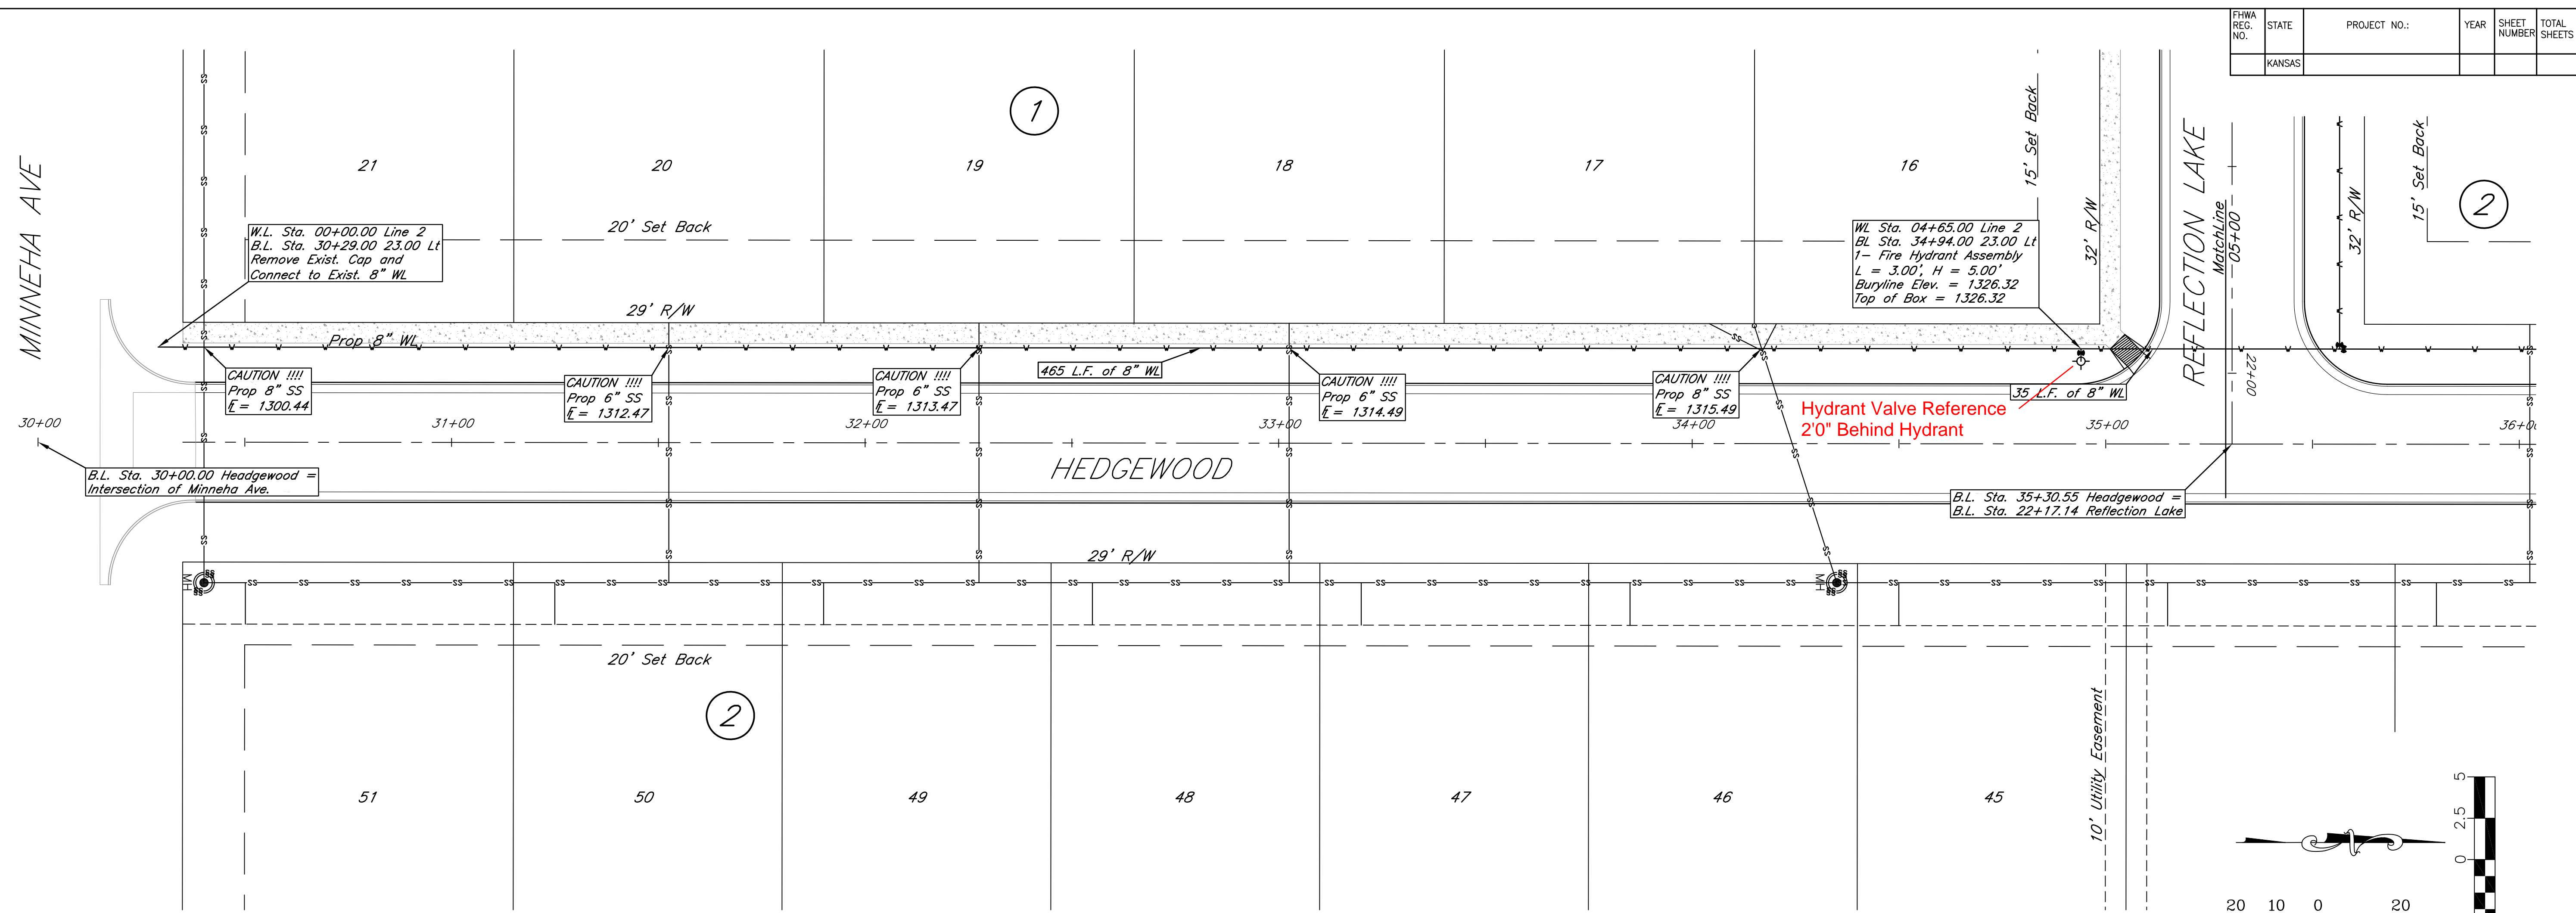

RECORD DRAWING
3-29-2010

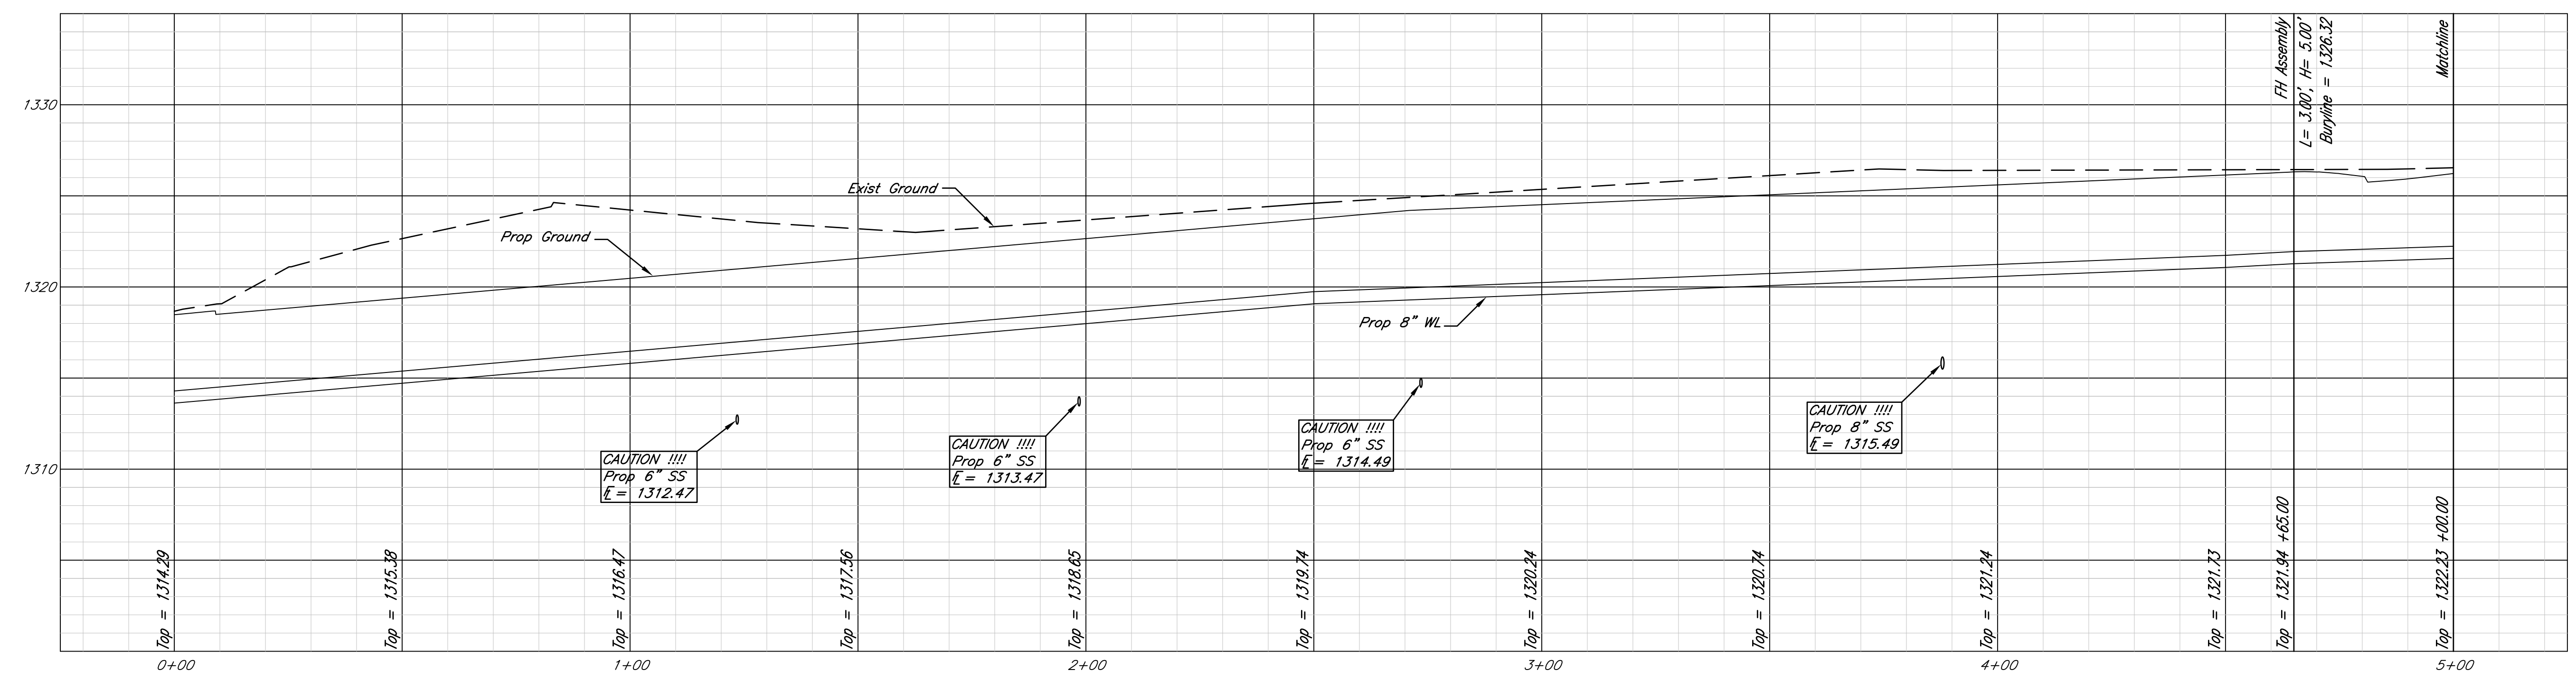

kemiler engineering
516 S. Market, Winona, KS 67202
316/284-0242

Reflection Lake 3rd Addition
Line 2 00+00 - 05+00
Andover, Kansas

KEM R/G	FILE
06128	WCT/EF
DESIGN KM	DRAWN NS
DATE 5/2008	REVISED 03/05/09

PROJECT NUMBER: _____
SHEET NUMBER: _____
SHEET 4 OF 11