

LATERAL 59 OF THE COWSKIN INTERCEPTOR SEWER IN THE CITY OF WICHITA, KANSAS


CITY OF WICHITA PROJECT NO. 468-84566

OCA NO. 744300

JAMES L. ARMOUR, P.E. - CITY ENGINEER

Wichita Excavation - Contractor
S. Cody - City of Wichita, Inspector
As-built
Release Date: 10/29/2009
pdf: APRosas 10/29/2009

Manholes - Wichita Concrete Pipe
8" Pipe - PSM North American, 763 WP,
SDR35, PVC Sewer Pipe

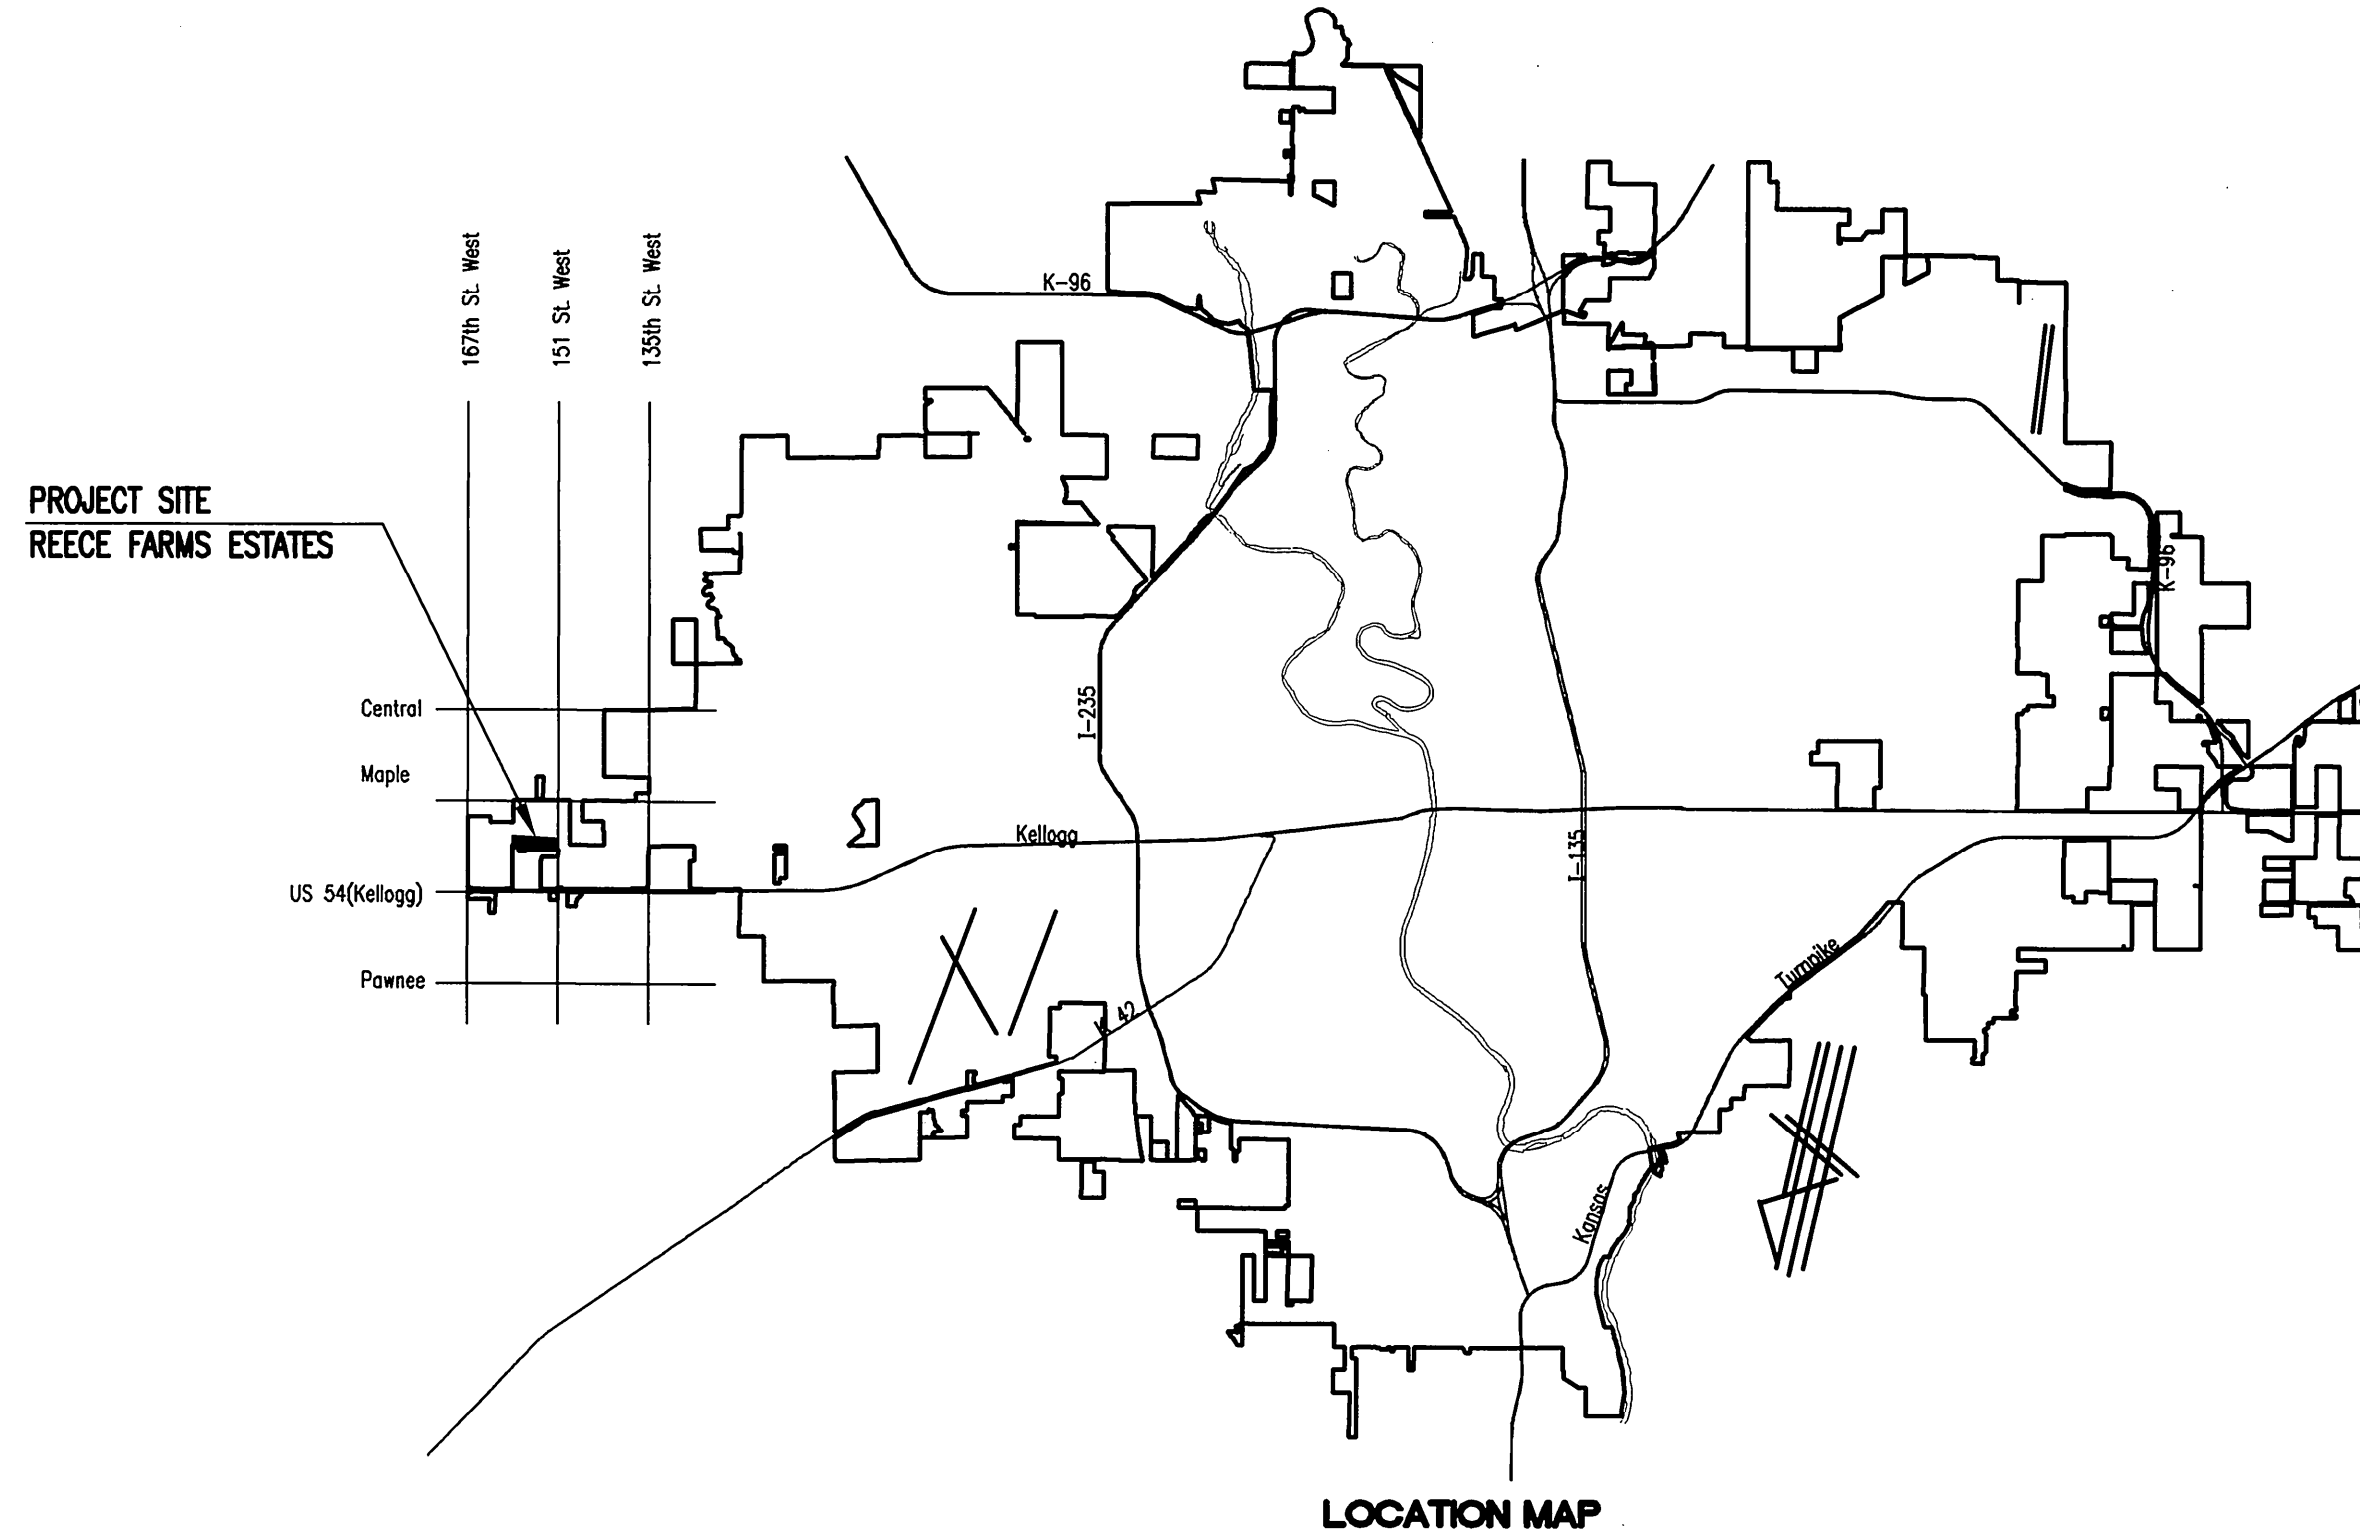

INDEX OF SHEETS

SHEET NO. 1	TITLE SHEET
SHEET NO. 2	KEY MAP AND GENERAL NOTES
SHEET NO. 3-5	PLAN/PROFILE
SHEET NO. 6	TYPE "P" MANHOLE DETAILS
SHEET NO. 7	FRAME & COVER DETAILS
SHEET NO. 8	SHALLOW MANHOLE DETAILS
SHEET NO. 9	RISER DETAILS
SHEET NO. 10	MANHOLE ADJUSTMENT DETAILS
SHEET NO. 11-13	SOIL EROSION BMP DETAILS

JULY 2009

PLANS PREPARED BY

PROFESSIONAL ENGINEERING CONSULTANTS, P.A.

ENGINEERS

WICHITA, KANSAS

