


PLAN	CHECKED	BY	DATE
	CHECKED		

PROFILE	CHECKED	BY	DATE
	CHECKED		

Saved: 07-16-2009 9:13:52 AM by CSL
 Plot Scale: 1:20 07-16-2009 4:26:57 PM by CSL
 0: 2009 08809 000 08809-000-C-SSPP02

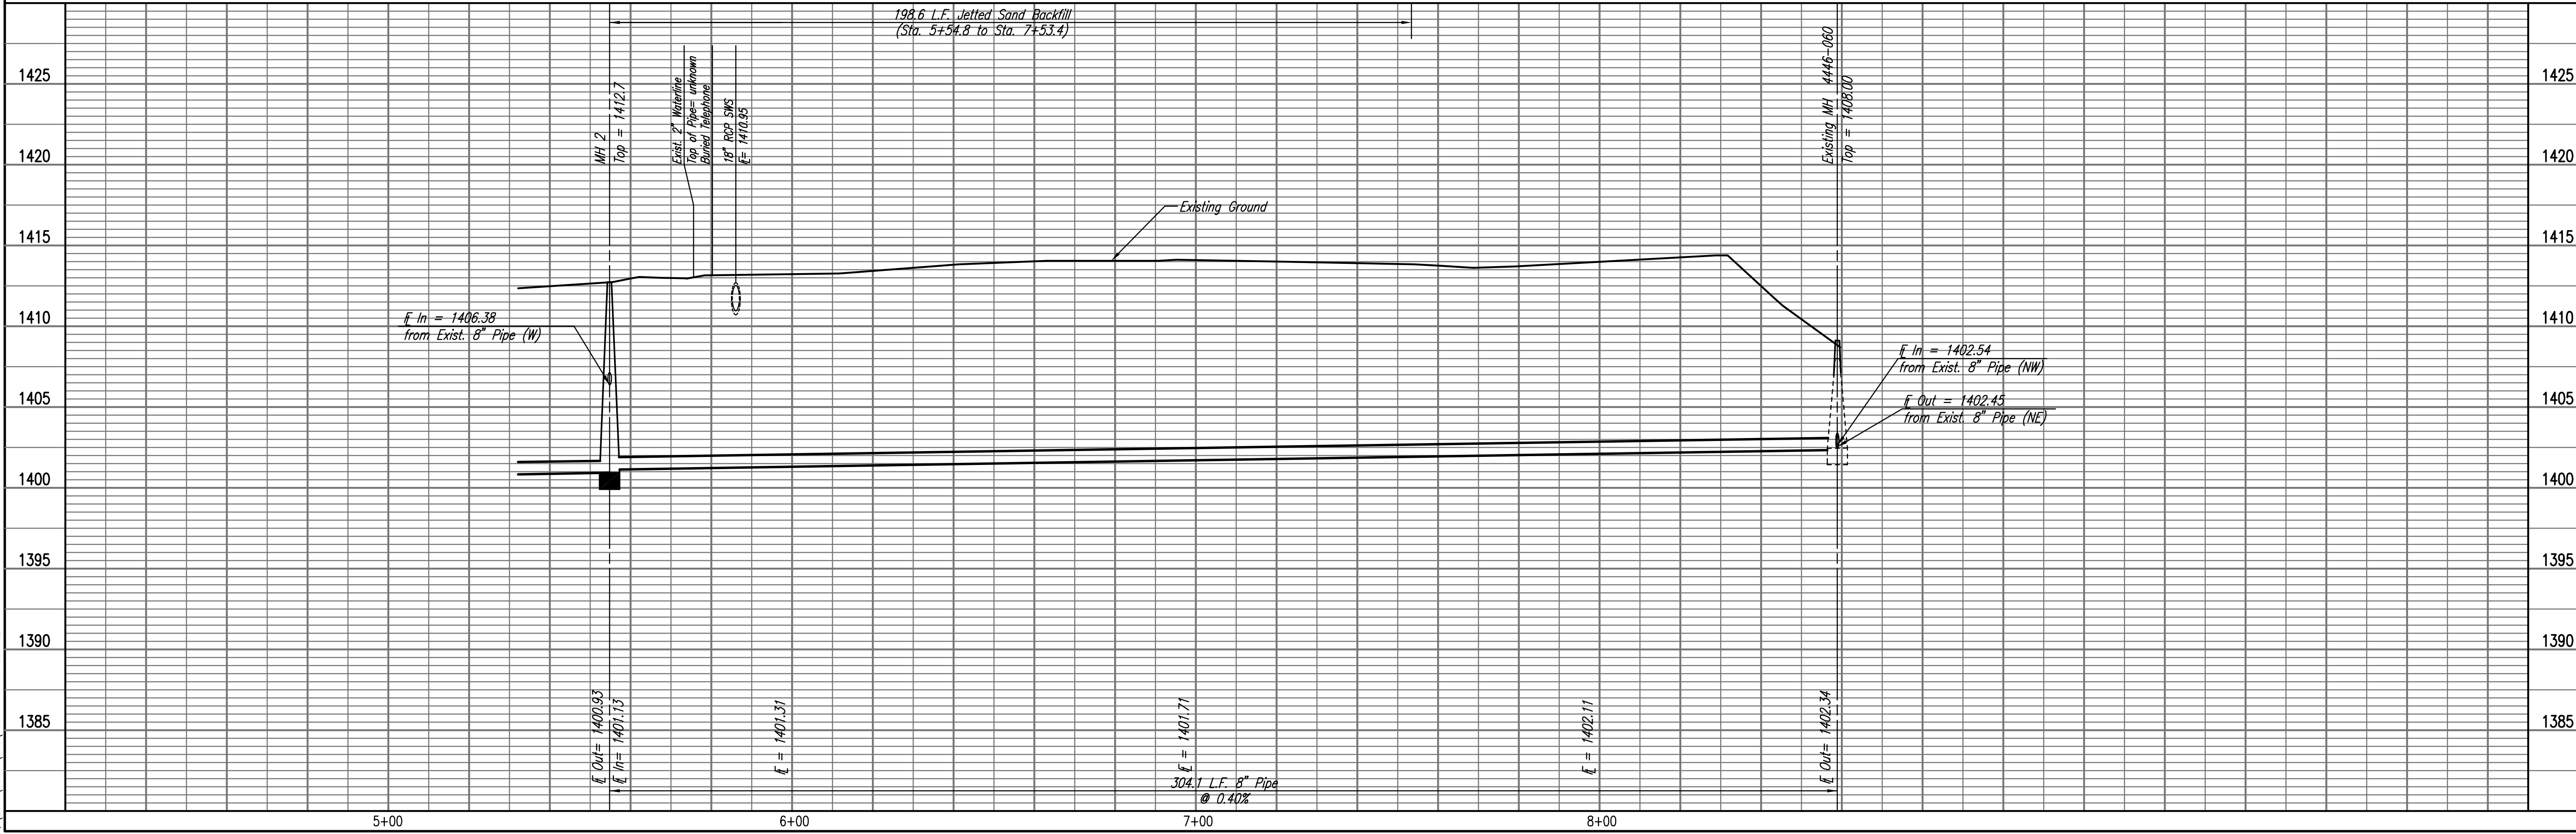

N: 19,754.6800, E: 24,319.9641
 Sta. 5+54.8
 MH 2


CAUTION !!!
 2" Waterline
 (City of Wichita)

CAUTION !!!
 Buried Telephone
 (AT&T)

CAUTION !!!
 18" RCP
 Storm Water Sewer

AS-BUILT

N: 20,058.7612, E: 24,319.2613
 Sta. 8+58.9
 Core existing concrete MH wall and Install New 8" Pipe.
 Seal new 8" Pipe to MH with an approved waterstop
 gasket and non-shrink grout. Construct a minimum of
 3' Reinforced Concrete Encasement from MH wall.
 Reshape MH floor to provide smooth flow. This work
 shall be considered subsidiary to the price bid for pipe
 in place. Adjust manhole top elevation to the elevation
 provided in the profile. The contractor shall provide new
 adjustment rings as necessary. Manhole adjustment shall
 be paid for at the contract unit price per each.
 Exist. MH Elev. = 1408.0
 Prop. MH Elev. = 1409.0
 Difference in elevation = 1.0'

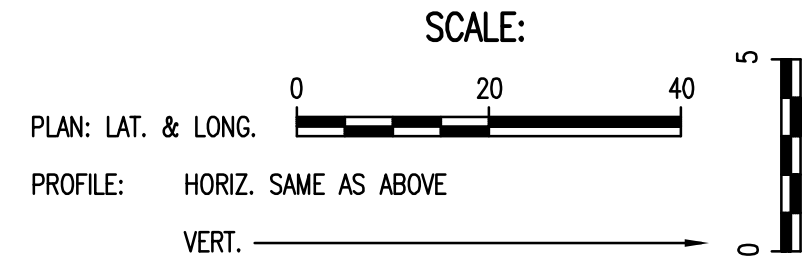

UNPLATTED

UNPLATTED

SANITARY SEWER LINE NO. 1

* BASE ROCK AND SURFACE ROCK REPLACEMENT FOR
 THE GRAVEL DRIVE SHALL BE OF THE SAME QUALITY, SIZE,
 AND APPEARANCE OF THE GRAVEL THAT IS REMOVED.

X = TREE REMOVAL

LATERAL 59
 OF THE COWSKIN INTERCEPTOR SEWER
 SANITARY SEWER LINE NO. 1

JAMES L. ARMOUR, P.E. - CITY ENGINEER
 CITY OF WICHITA PROJECT NO. 468-84566

Professional Engineering Consultants, P.A.
 603 S. TOPICKA AVENUE, WICHITA, KANSAS 67202
 316-262-2691 • FAX 316-262-3003

Designed By: MDK, JEH
 Drawn By: CSL
 Job No.: 35-08809-042
 Date: DECEMBER 2008