

# LATERAL 126, SANITARY SEWER NO. 23

IN


## THE CITY OF WICHITA, KANSAS

CITY OF WICHITA PROJECT NO. 468-84576

OCA NO. 744301

JAMES L. ARMOUR, P.E. - CITY ENGINEER

WB Carter - Contractor  
D.Hicks - City of Wichita, Inspector  
As-Built  
Cleanout  
Release Date: 08/22/2009  
pdf: APRosas 10/01/2009

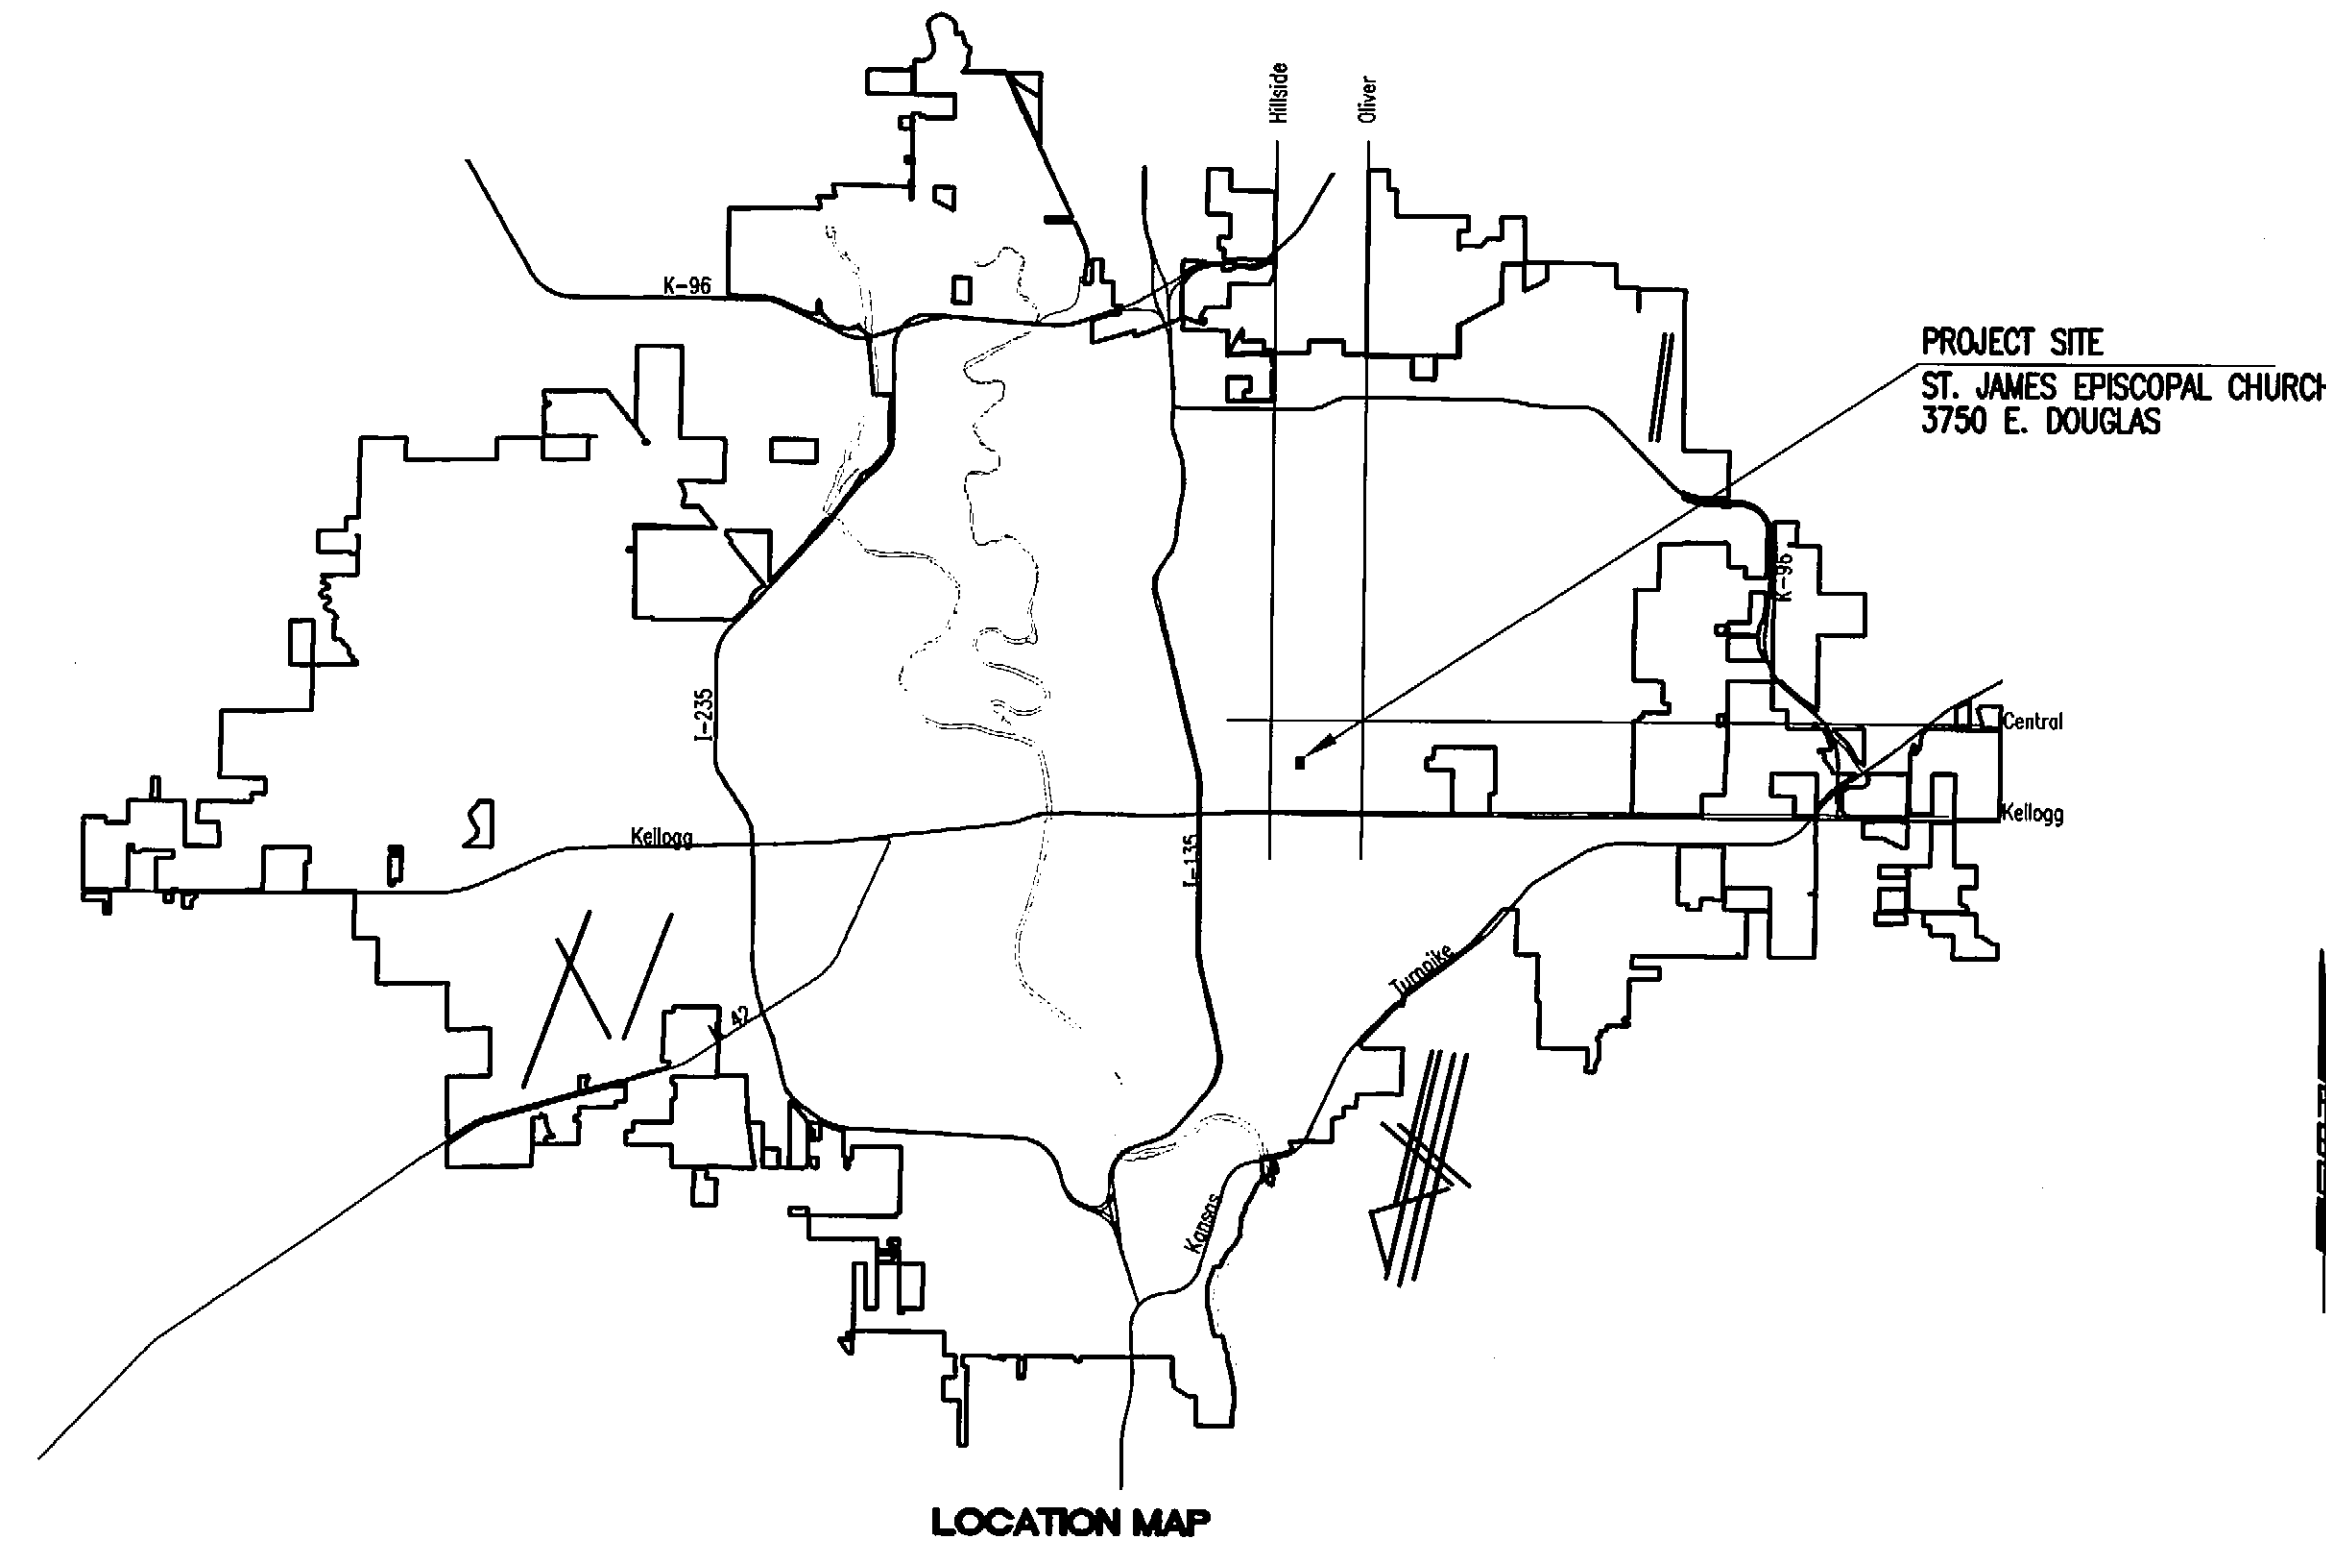

### INDEX OF SHEETS

SHEET NO. 1	TITLE SHEET
SHEET NO. 2	KEY MAP AND GENERAL NOTES
SHEET NO. 3-4	PLAN/PROFILE
SHEET NO. 5	TYPE "P" MANHOLE DETAILS
SHEET NO. 6	FRAME & COVER DETAILS
SHEET NO. 7	MANHOLE ADJUSTMENT DETAILS
SHEET NO. 8	CLEANOUT DETAILS
SHEET NO. 9	RISER DETAILS
SHEET NO. 10-12	SOIL EROSION BMP DETAILS

# MARCH 2009

PLANS PREPARED BY  
**PROFESSIONAL ENGINEERING CONSULTANTS, P.A.**  
ENGINEERS  
WICHITA, KANSAS

