

CONSTRUCTION PLANS FOR PROPOSED STORM WATER SEWER COLLECTION SYSTEM IMPROVEMENTS DOUGLAS AVENUE DRAINAGE OUTFALL PROJECT

~ PHASE 1 ~

FOR
THE CITY OF WICHITA, KANSAS

Jim Armour, P.E., City Engineer

Douglas Avenue
Drainage Outfall Project

Project No. 468-84060
O.C.A. No. 660798

Wabash Sanitary Sewer
Replacement Project


Project No. 468-84352
O.C.A. No. 620477

Douglas Water Main
Replacement Project

Project No. 448-90289
O.C.A. No. 636183

JULY 2007



VICINITY MAP

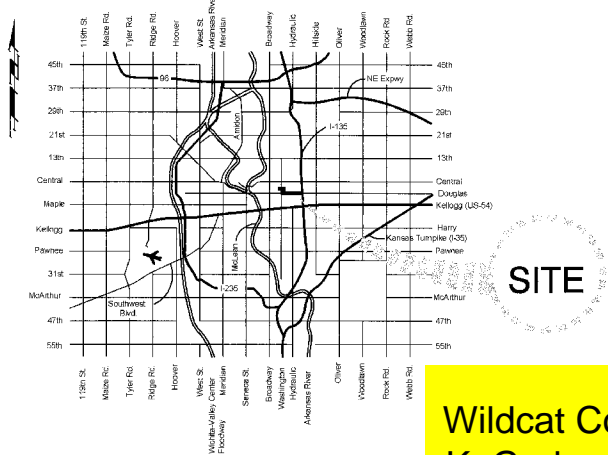

Wildcat Construction - Contractor
K. Graber - City of Wichita, Inspector
As-built
Release Date: 9/18/2009
pdf: APRosas 10/28/2009

Index

1	Title Sheet
2	Key Sheet
3	Notepage
4-5	SWS Line 1 Plan/Profile
6-9	SWS Lines 1a-1k Plan/Profile
10-17	SWS Line 2 Plan/Profile
18-21	SWS Lines 2a-2m Plan/Profile
22	SWS Line 3 Plan/Profile
23	RCP Connection Details
24-25	Inlet Rehabilitation Location & Details
26-27	SS Lines 1 & 2 Plan/Profile
28	SS Lines 2a & 2b Plan/Profile
29	SS Line 3 Plan/Profile
30-35	Water Line 1 Plan/Profile
36-42	Water Lines 1a-1m Plan/Profile
43	Water Lines 2 & 3 Plan/Profile
44	Standard Water Details
45	Water Meter Relocation Table
46-48	Pavement Typical Sections & Details
49-50	1st Street North Paving Plan
51-52	Wabash Paving Plan
53-55	Douglas Paving Plan
56-57	Brick Arch Connection Details
58	RCBC Transition Structure Details
59	Headwall & Wingwall Details
60-70	Storm Water Sewer Details
71	Quantity Recapitulation Sheet
72-74	Pavement Marking Plan
75	Pavement Marking Details
76-78	Construction Traffic Control Plan
79-80	Construction Traffic Control Details
81	Seeding/Sodding Restoration Plan
82	Erosion Control Plans
83-86	Erosion Control Details
87	Drainage Plan

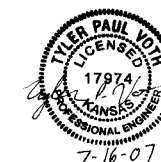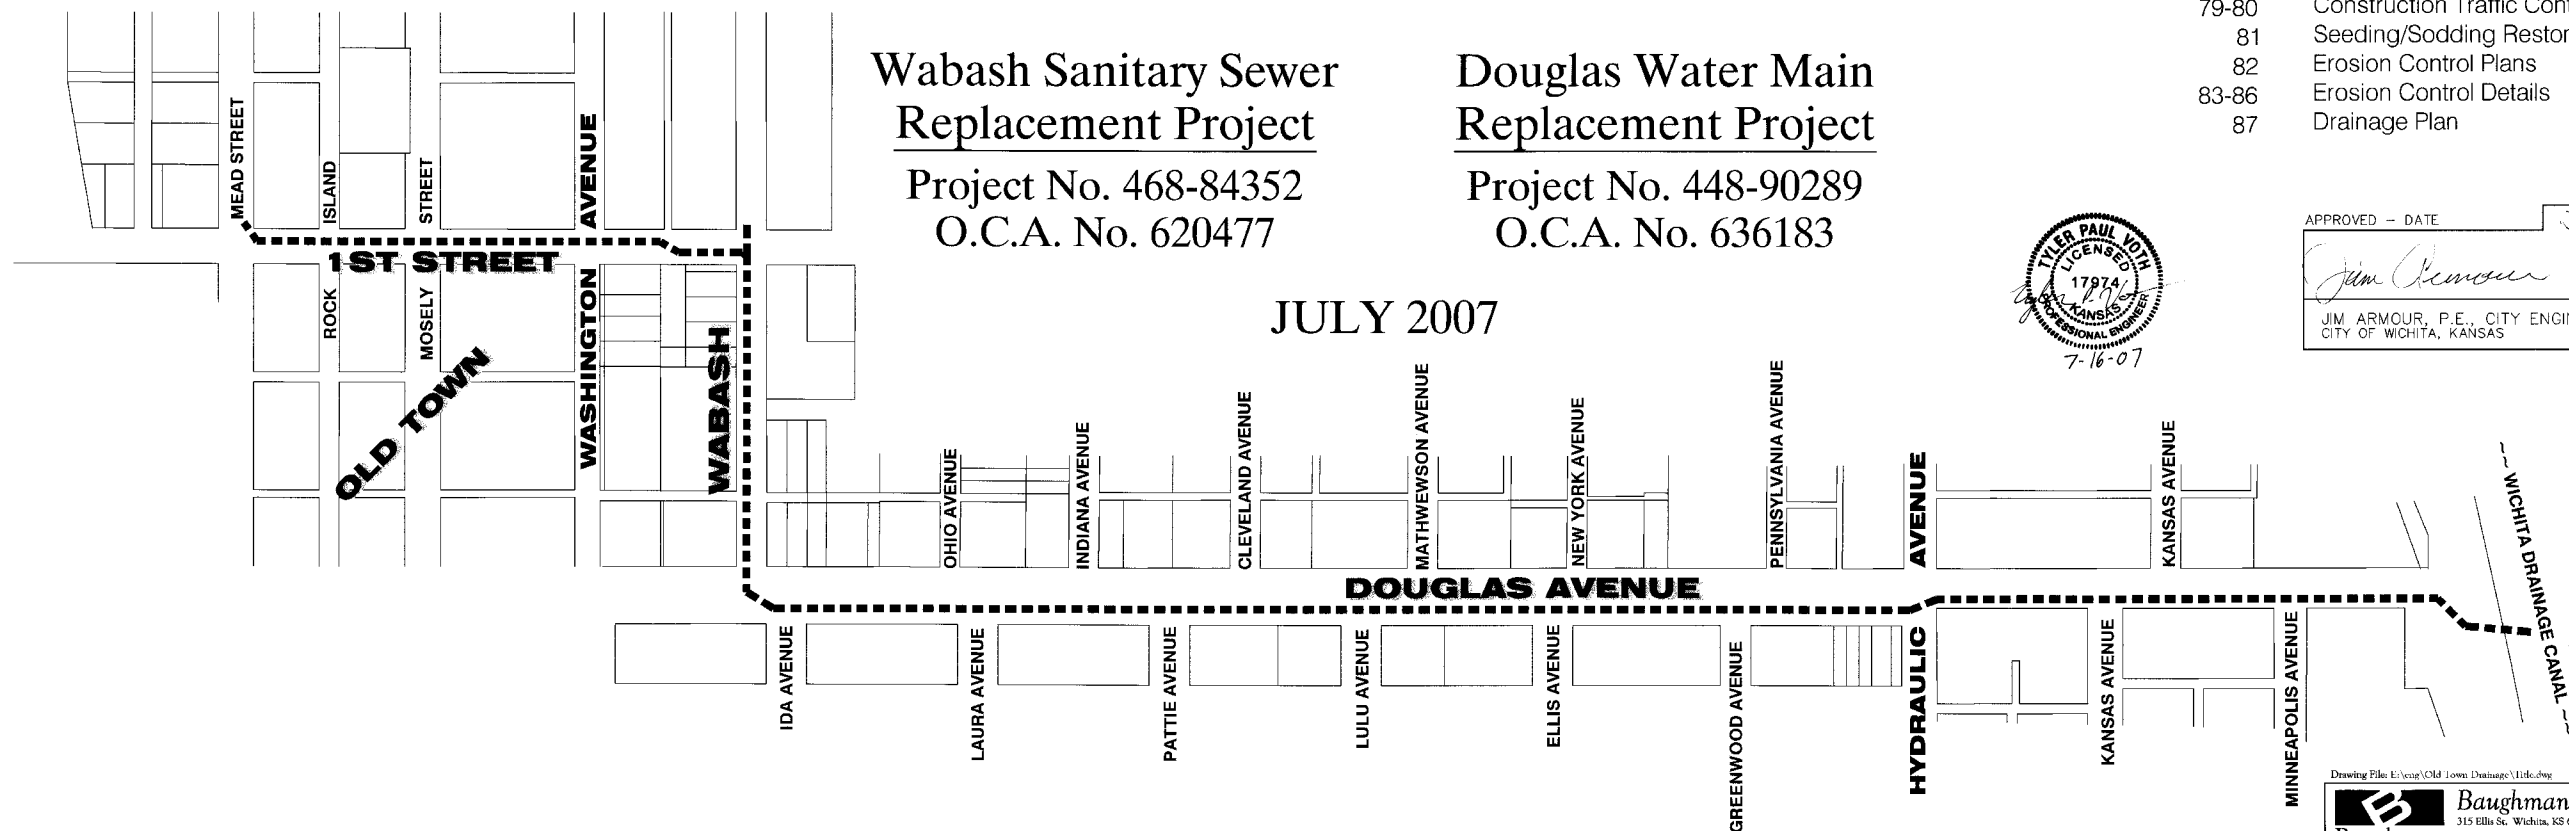

APPROVED - DATE July 16, 2007
Jim Armour
JIM ARMOUR, P.E., CITY ENGINEER
CITY OF WICHITA, KANSAS