

PRIVATE SANITARY SEWER EXTENSION

TO SERVE

FIRE TRAINING ACADEMY


PRIVATE PROJECT NO. 2001 PPS (607861)

CITY OF WICHITA, KANSAS

JAMES L. ARMOUR, P.E. - CITY ENGINEER

INDEX OF SHEETS

SHEET NO. C201	TITLE SHEET
SHEET NO. C202	KEY MAP AND GENERAL NOTES
SHEET NO. C203	UTILITY PLAN
SHEET NO. C204	PLAN/PROFILE
SHEET NO. C205	FRAME & COVER DETAILS
SHEET NO. C206	TYPE 'P' MANHOLE DETAILS
SHEET NO. C207	SHALLOW MANHOLES TYPE 'P' & 'C'
SHEET NO. C402-C404	SOIL EROSION BMP DETAILS

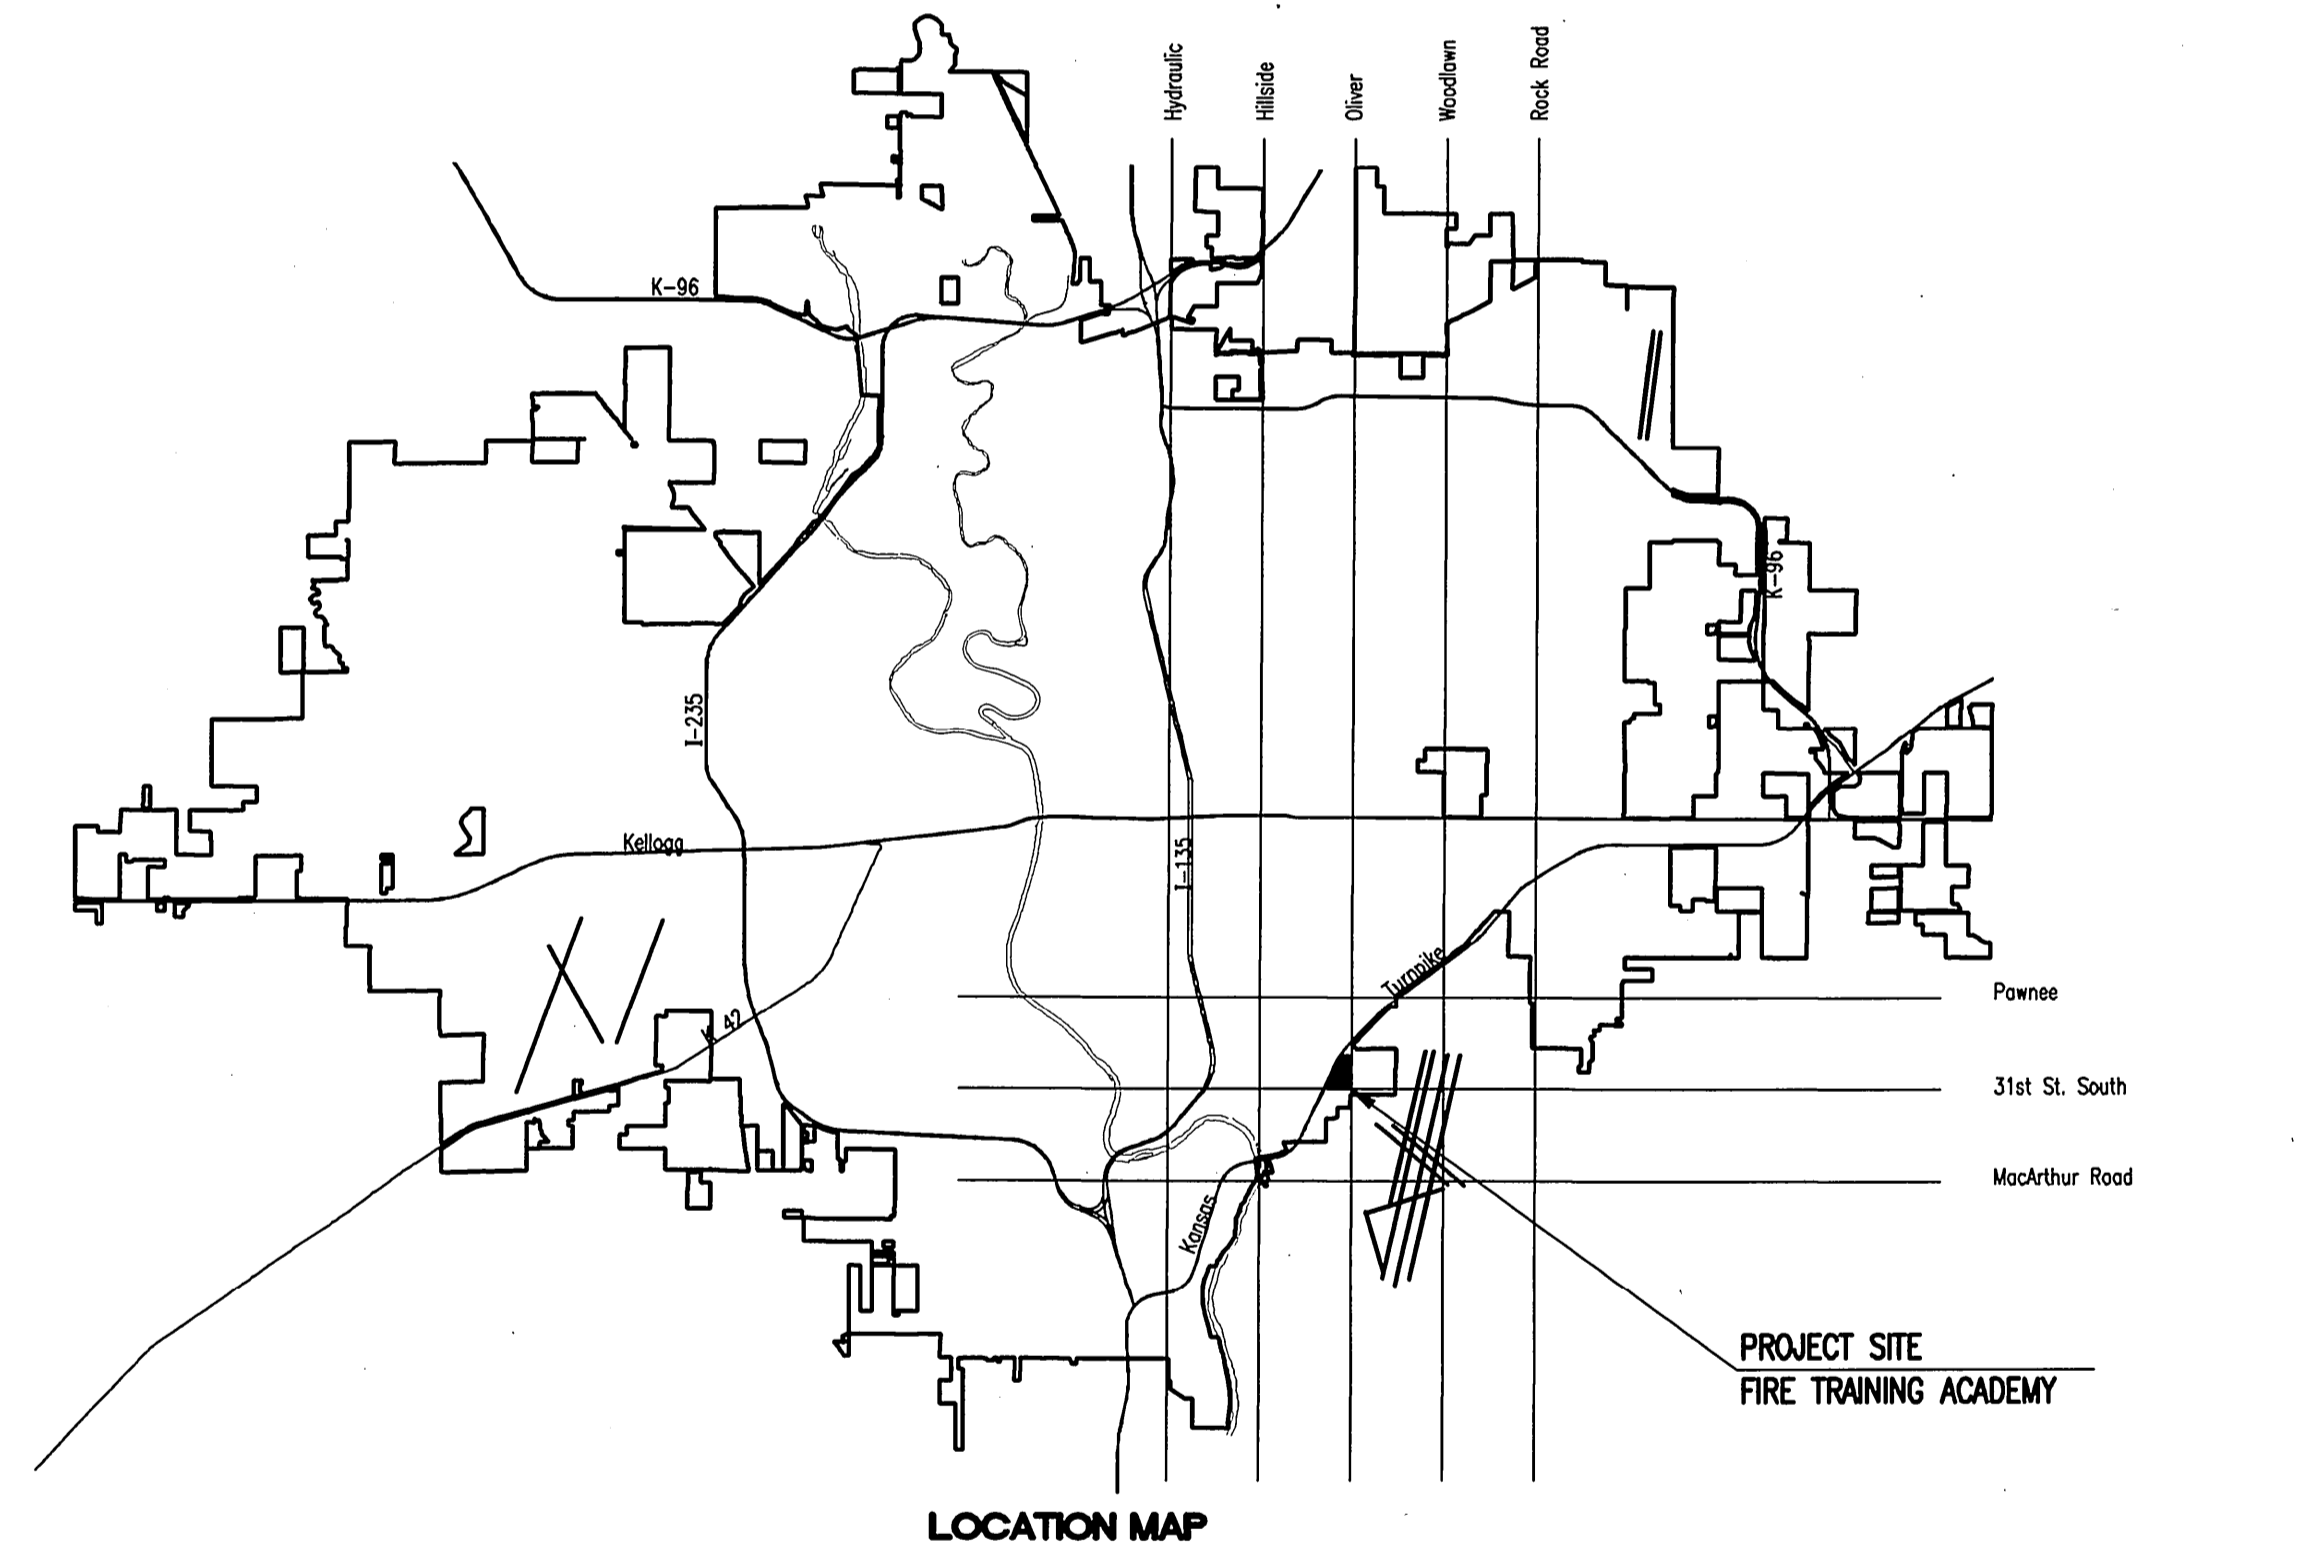

LOCATION MAP

APPROVED AS NOTED
By CITY ENGINEER OF WICHITA

Sanitary Sewers *Julianne Kellman 1-13-10*

Storm Sewers _____

Driveway Approaches _____

Paving _____

NOTE TO CONTRACTOR

INSPECTION AND TESTING FOR THIS PROJECT IS TO BE PROVIDED BY A LICENSED CONSULTING ENGINEERING FIRM CONTRACTED BY THE OWNER/DEVELOPER. SAID INSPECTION TO BE IN ACCORDANCE WITH THE CITY OF WICHITA STANDARD CONSTRUCTION ENGINEERING PRACTICES AND CERTIFIED BY A LICENSED PROFESSIONAL ENGINEER. NO WORK SHALL BE PERFORMED IN DEDICATED EASEMENTS OR PUBLIC RIGHT-OF-WAY BY THE CONTRACTOR UNTIL SUCH INSPECTION IS ARRANGED FOR AND REQUIRED BONDS HAVE BEEN SUBMITTED TO AND APPROVED BY THE CITY. NOR SHALL ANY WORK BE COMMENCED IN DEDICATED EASEMENTS OR PUBLIC RIGHT-OF-WAY WITHOUT WRITTEN AUTHORIZATION BY THE CITY ENGINEER. IMPROVEMENTS PERFORMED UNDER THIS PROJECT SHALL NOT BE ACCEPTED BY THE CITY UNTIL ALL APPLICABLE DOCUMENTATION HAS BEEN SUBMITTED TO THE CITY ENGINEER. THIS MAY INCLUDE: RECORD DRAWINGS, INSPECTION LOGS, TEST DOCUMENTATION, TV TAPES, AND A CERTIFICATE OF COMPLETION. THE ABOVE SHALL BE PERFORMED BY THE CONSULTING FIRM CONTRACTED TO INSPECT THIS PROJECT.

JANUARY 2010

PLANS PREPARED BY

PROFESSIONAL ENGINEERING CONSULTANTS, P.A.

ENGINEERS

WICHITA, KANSAS

RELEASE DATE: 07/09/2010
APRosas 07/27/2010


As Built Plans:

CONTRACTOR: Ewertz Excavating

INSPECTOR: Larry Gann

COMPANY: K E Miller Engineering

.PDF by: NWS, 04-27-2010

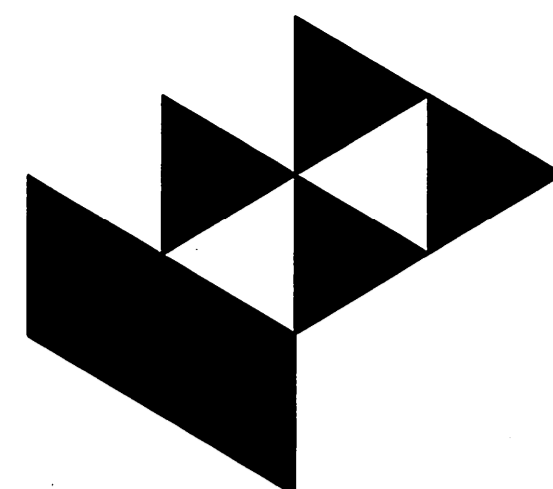

GossenLivingston

Architecture
420 South Emporia
Wichita, KS 67202
Tel: (316) 265-9367
Fax: (316) 265-5646
Email: architects@gossenlivingston.com



303 SOUTH TOPERA
WICHITA, KANSAS 67202
316-262-2691
FAX 316-262-3003
www.goc1.com

2009 GossenLivingston Associates, Inc.

ALL work herein is the exclusive property of Gossen Livingston Associates, Inc. and is not to be copied or used in any way without the express written consent of Gossen Livingston Associates, Inc. All drawings, specifications, ideas, designs and arrangements appearing herein constitute the original and unpublished work of:

Gossen Livingston Associates, Inc.

FIRE TRAINING ACADEMY
CITY OF WICHITA FIRE DEPARTMENT
WICHITA, KS

REV 5/01/05/10	ADDENDUM 4
REV 3/12/15/09	ADDENDUM 2
REV 2/11/20/09	PLAN REVIEW COMMENTS
REV 1/10/22/09	PLAN REVIEW COMMENTS / ISSUE TO BID

PPS TITLE SHEET

Job No. 1036.300
Date 09/24/09
Drawn SAW
Checked JEH

C201