



**SANITARY SEWER PLANS FOR  
MONARCH LANDING SECOND ADD.  
PHASE 2 PART A**

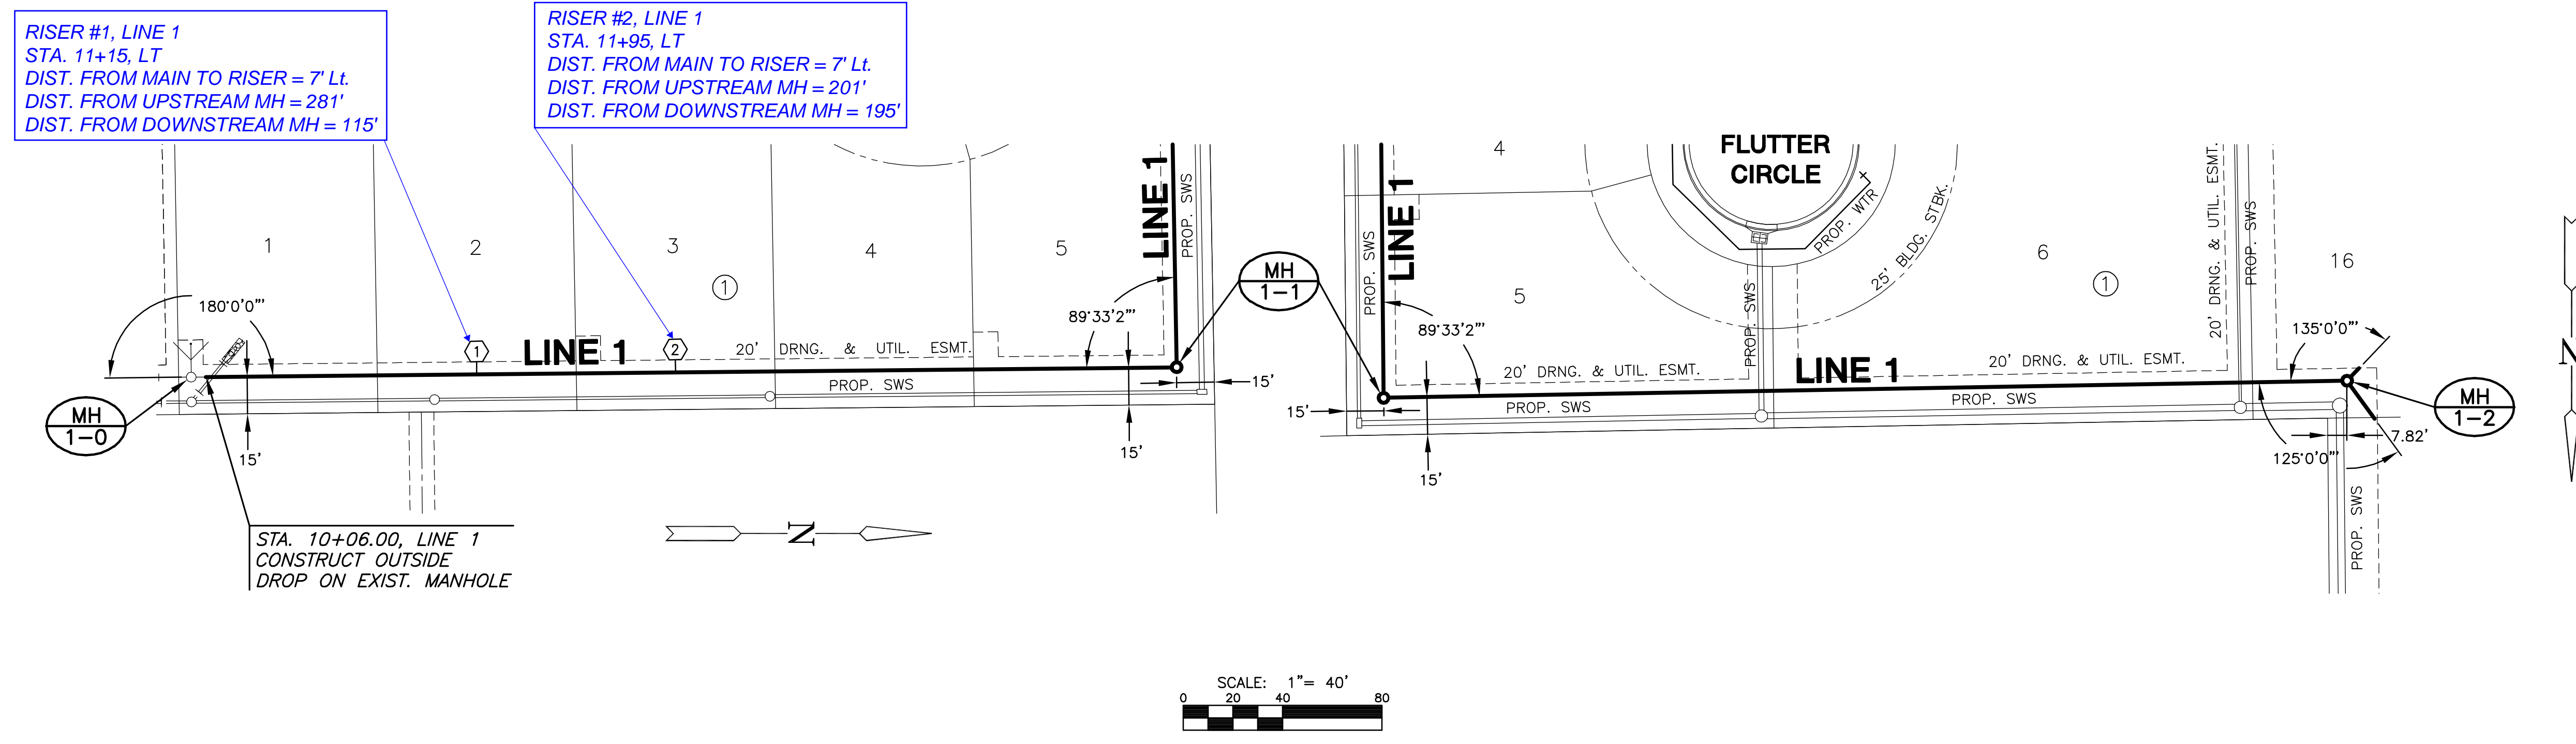

**NOTE:**  
CONTRACTOR TO VERIFY THE  
DEPTH AND LOCATION OF EXISTING  
UTILITIES PRIOR TO CONSTRUCTION.

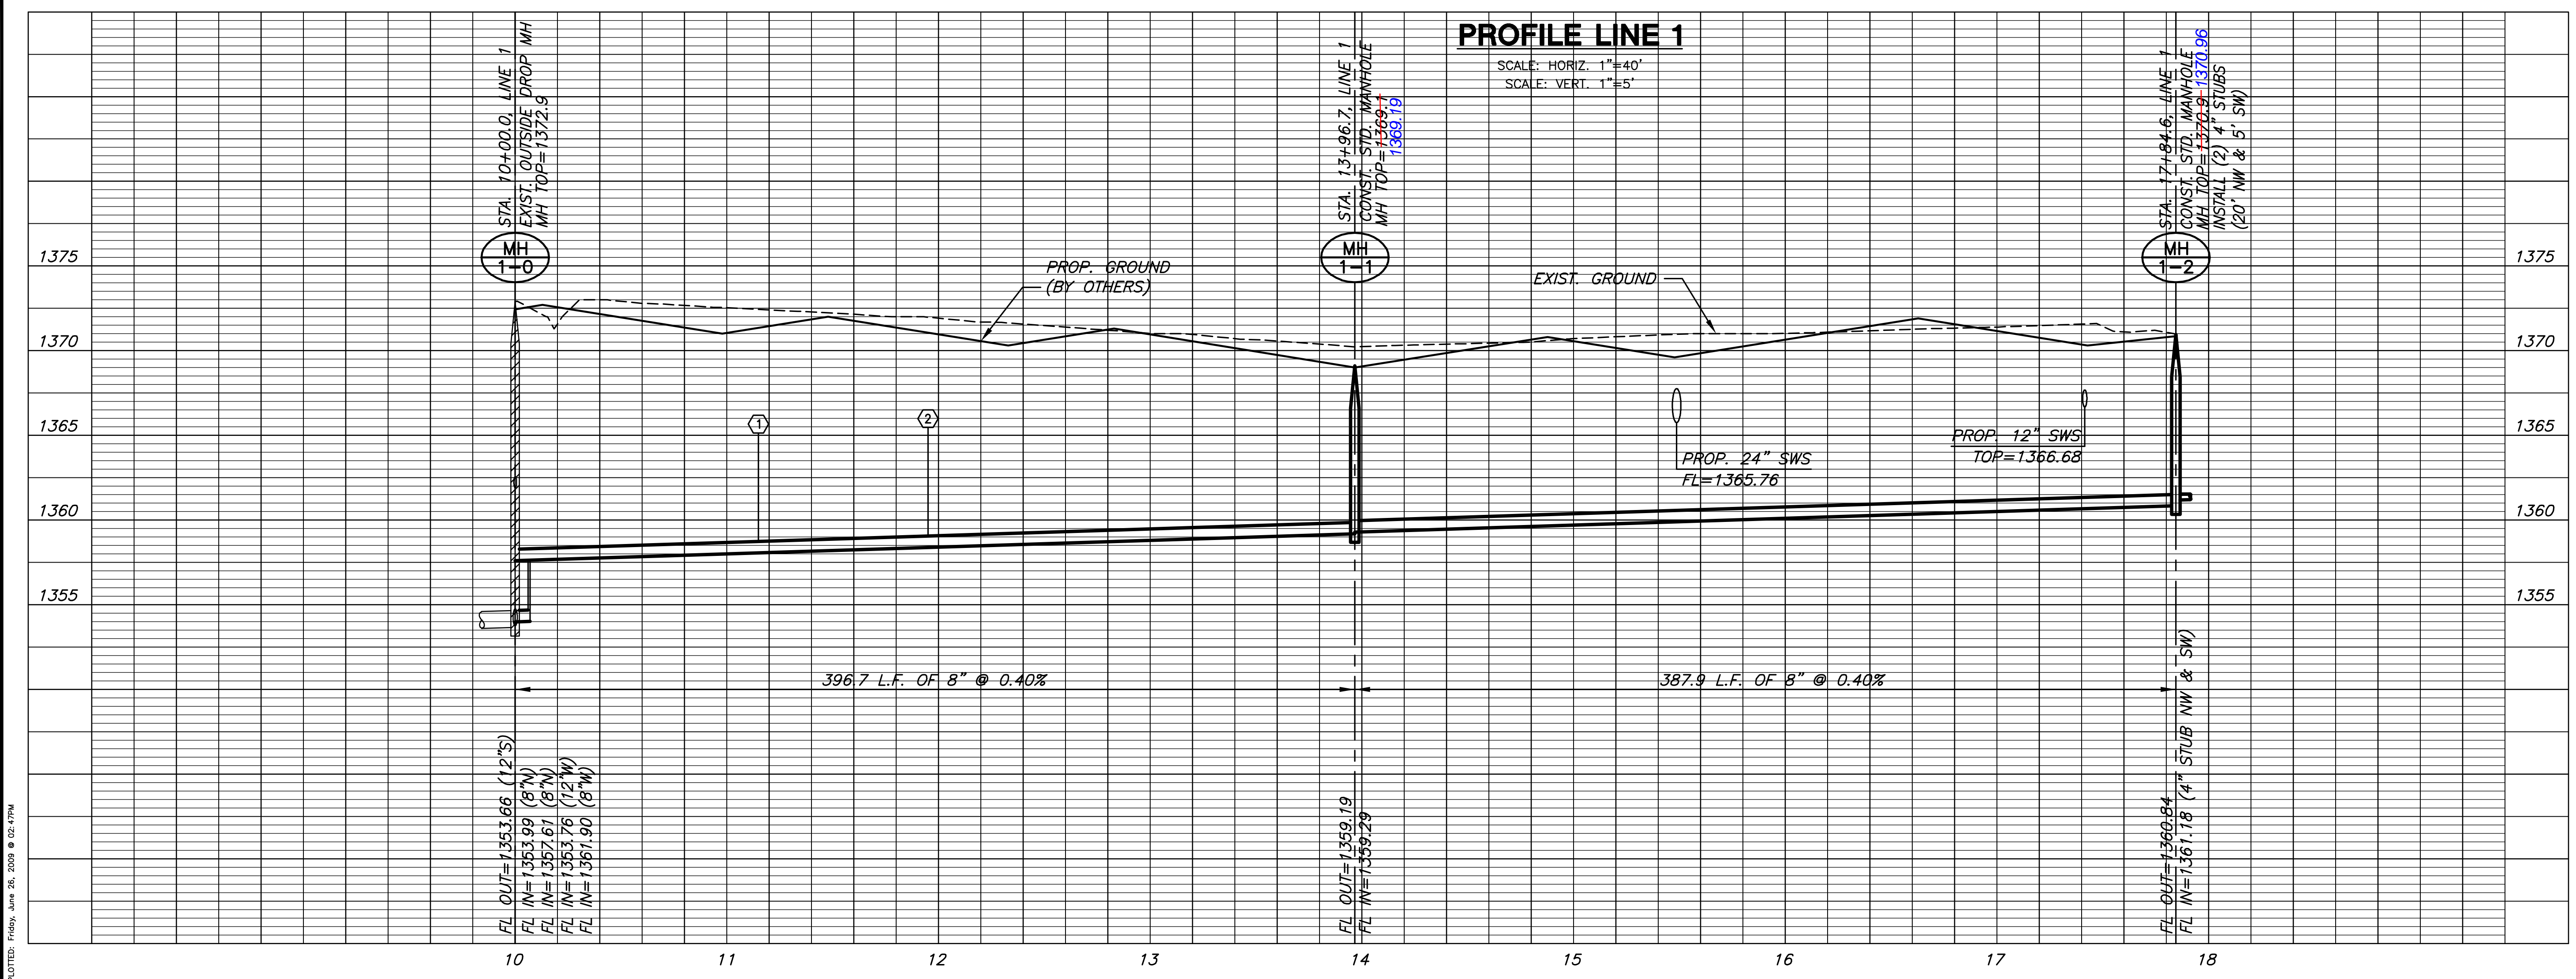

**LINE 1**  
SHEET TITLE  
468-84433  
PROJECT NUMBER

DESIGN BY: DFL  
 DRAWN BY: DM  
 CHECKED BY: GJA

ISSUED: June 2009  
 REVISED:

SHEET NO.  
4 of 11