

SANITARY SEWER MODIFICATIONS

620526
620527

AT ST. FRANCIS STREET - BETWEEN DOUGLAS AND WILLIAM STREETS


CITY OF WICHITA PROJECT NO. 468-84582
OCA NO. 620526

AND IN ALLEY BETWEEN TOPEKA AND EMPORIA - NORTH OF WILLIAM

CITY OF WICHITA PROJECT NO. 468-84581
OCA NO. 620527

IN THE CITY OF WICHITA, KANSAS JAMES L. ARMOUR, P.E. - CITY ENGINEER

Donlinger & Sons - Contractor
T. Anthis - City of Wichita, Inspector
As-built
Release Date:
:pdf APRosas 4/2/2010

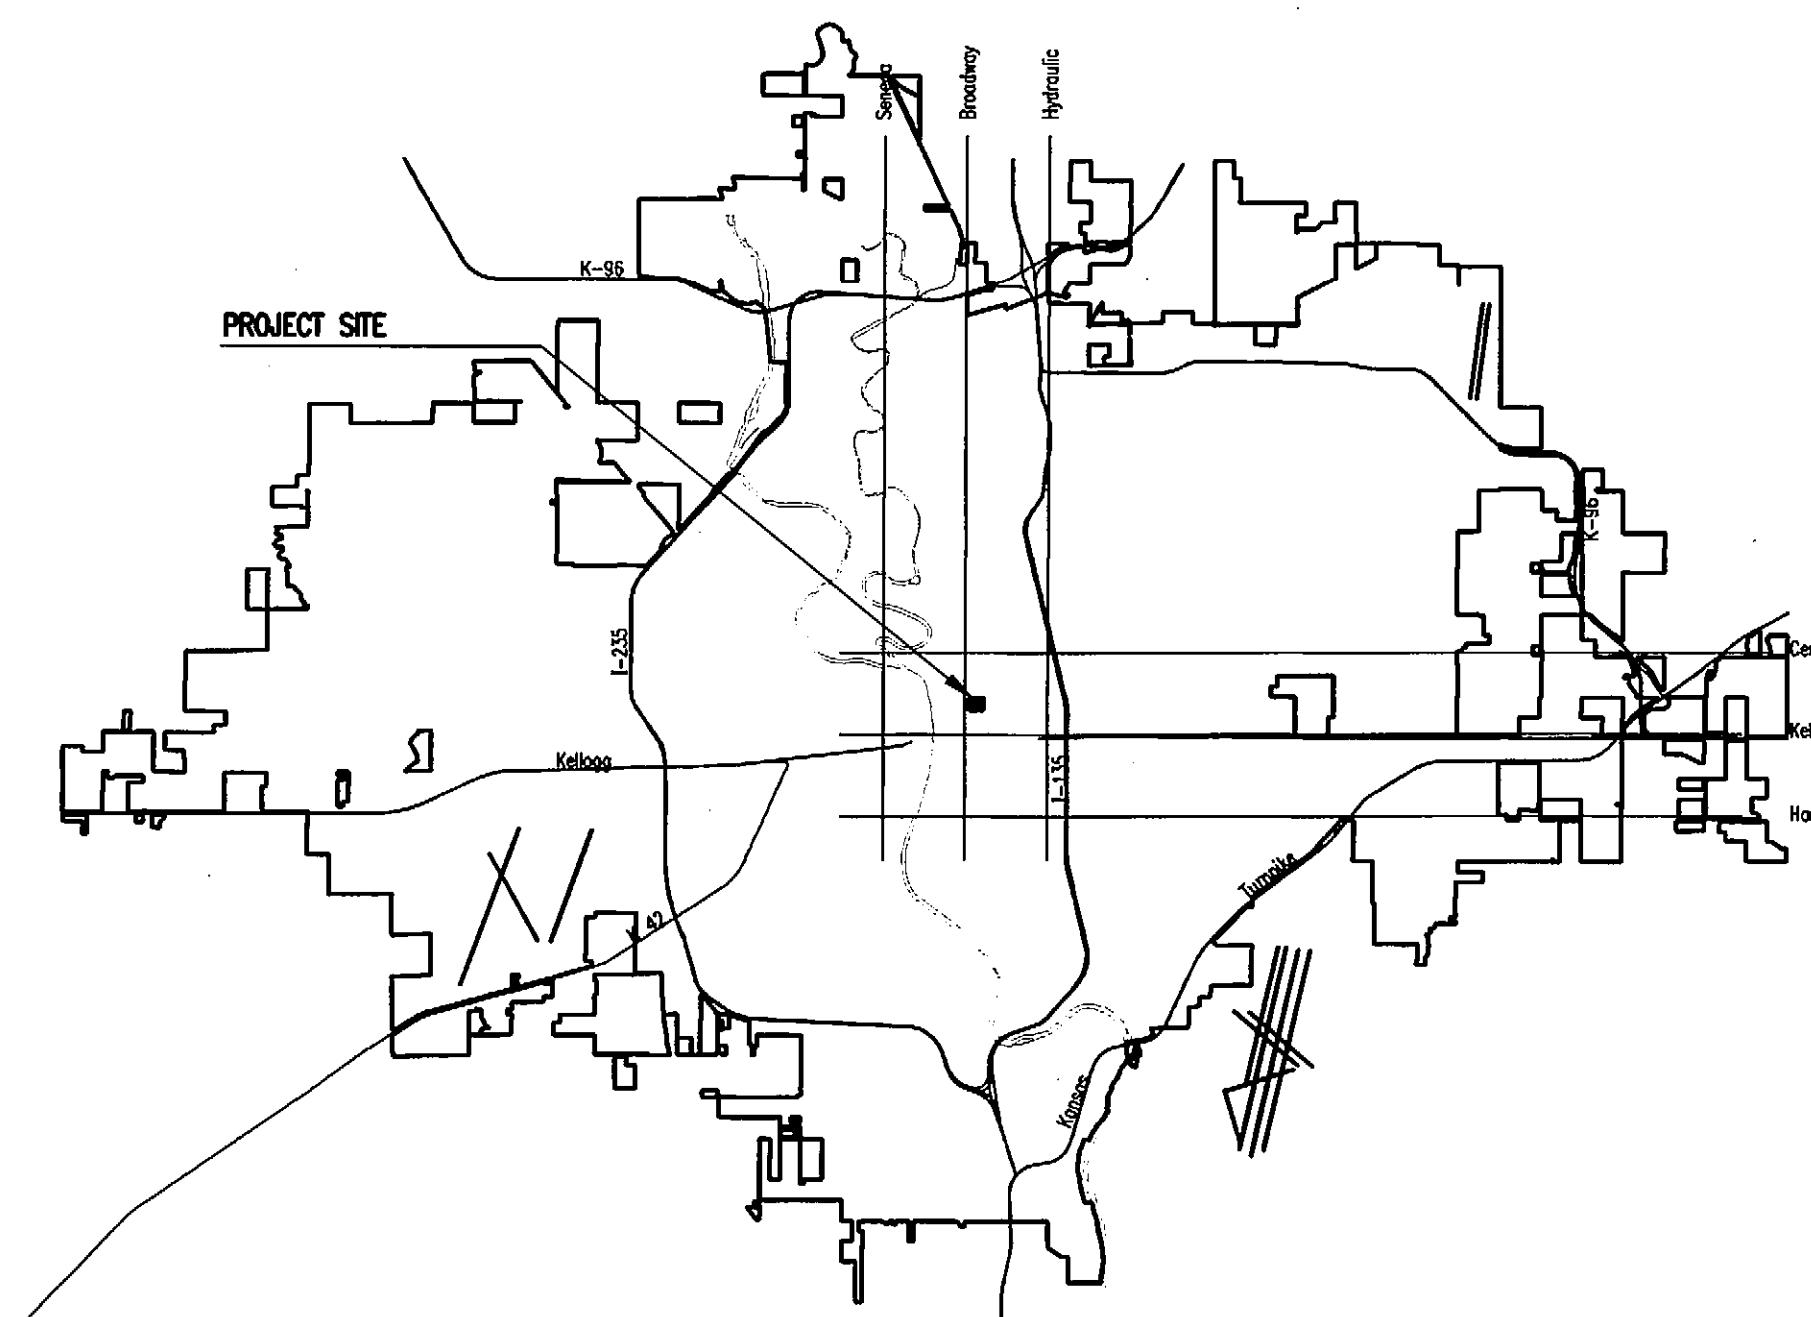

LOCATION MAP

MARCH 2009

PLANS PREPARED BY
PROFESSIONAL ENGINEERING CONSULTANTS, P.A.
ENGINEERS
WICHITA, KANSAS

INDEX OF SHEETS

SHEET NO. SS1	TITLE SHEET
SHEET NO. SS2	KEY MAP AND GENERAL NOTES
SHEET NO. SS3-SS4	PLAN/PROFILE
SHEET NO. SS5	TYPE "P" MANHOLE DETAILS
SHEET NO. SS6	FRAME & COVER DETAILS
SHEET NO. SS7	RISER DETAILS
SHEET NO. SS8	SHALLOW MANHOLE DETAILS
SHEET NO. SS9-SS11	SOIL EROSION BMP DETAILS

