


# MAIN 17B OF THE FOUR MILE CREEK SEWER IN THE CITY OF WICHITA, KANSAS

OCA NO. 622101  
 CITY OF WICHITA PROJECT NO. 468-84136  
 JAMES L. ARMOUR, P.E. - CITY ENGINEER

PART 2 - SANITARY SEWER		
SANITARY SEWER ITEMS	QUANTITY	UNIT
SS Pipe 24"	1897	L.F.
MH, Type P (Standard)	7	each
MH, Type P (Outside Drop)	1	each
Stub, SS (24")	1	each
Pipe Plug, SS (12")	2	each
Pipe Plug, SS (8")	2	each
MH Adjustment	4	each
Remove & Replace Frame & Lid	1	each
Remove & Replace Cone, Stack, Frame, & Lid	3	each
Reconstruct 4' Dia. MH	1	each
Reconstruct 5' Dia. MH	2	each
Flowable Fill	1490	L.F.
Steel Casing by boring (Min. I.D. 34")	78	L.F.
Reinforced Concrete Encasement	103	L.F.
Asphalt Pymt. Removed and Replaced w/temp Asphalt	141	L.F.
Sediment Barrier	325	L.F.
Site Clearing	1	Lump Sum
Site Restoration	1	Lump Sum

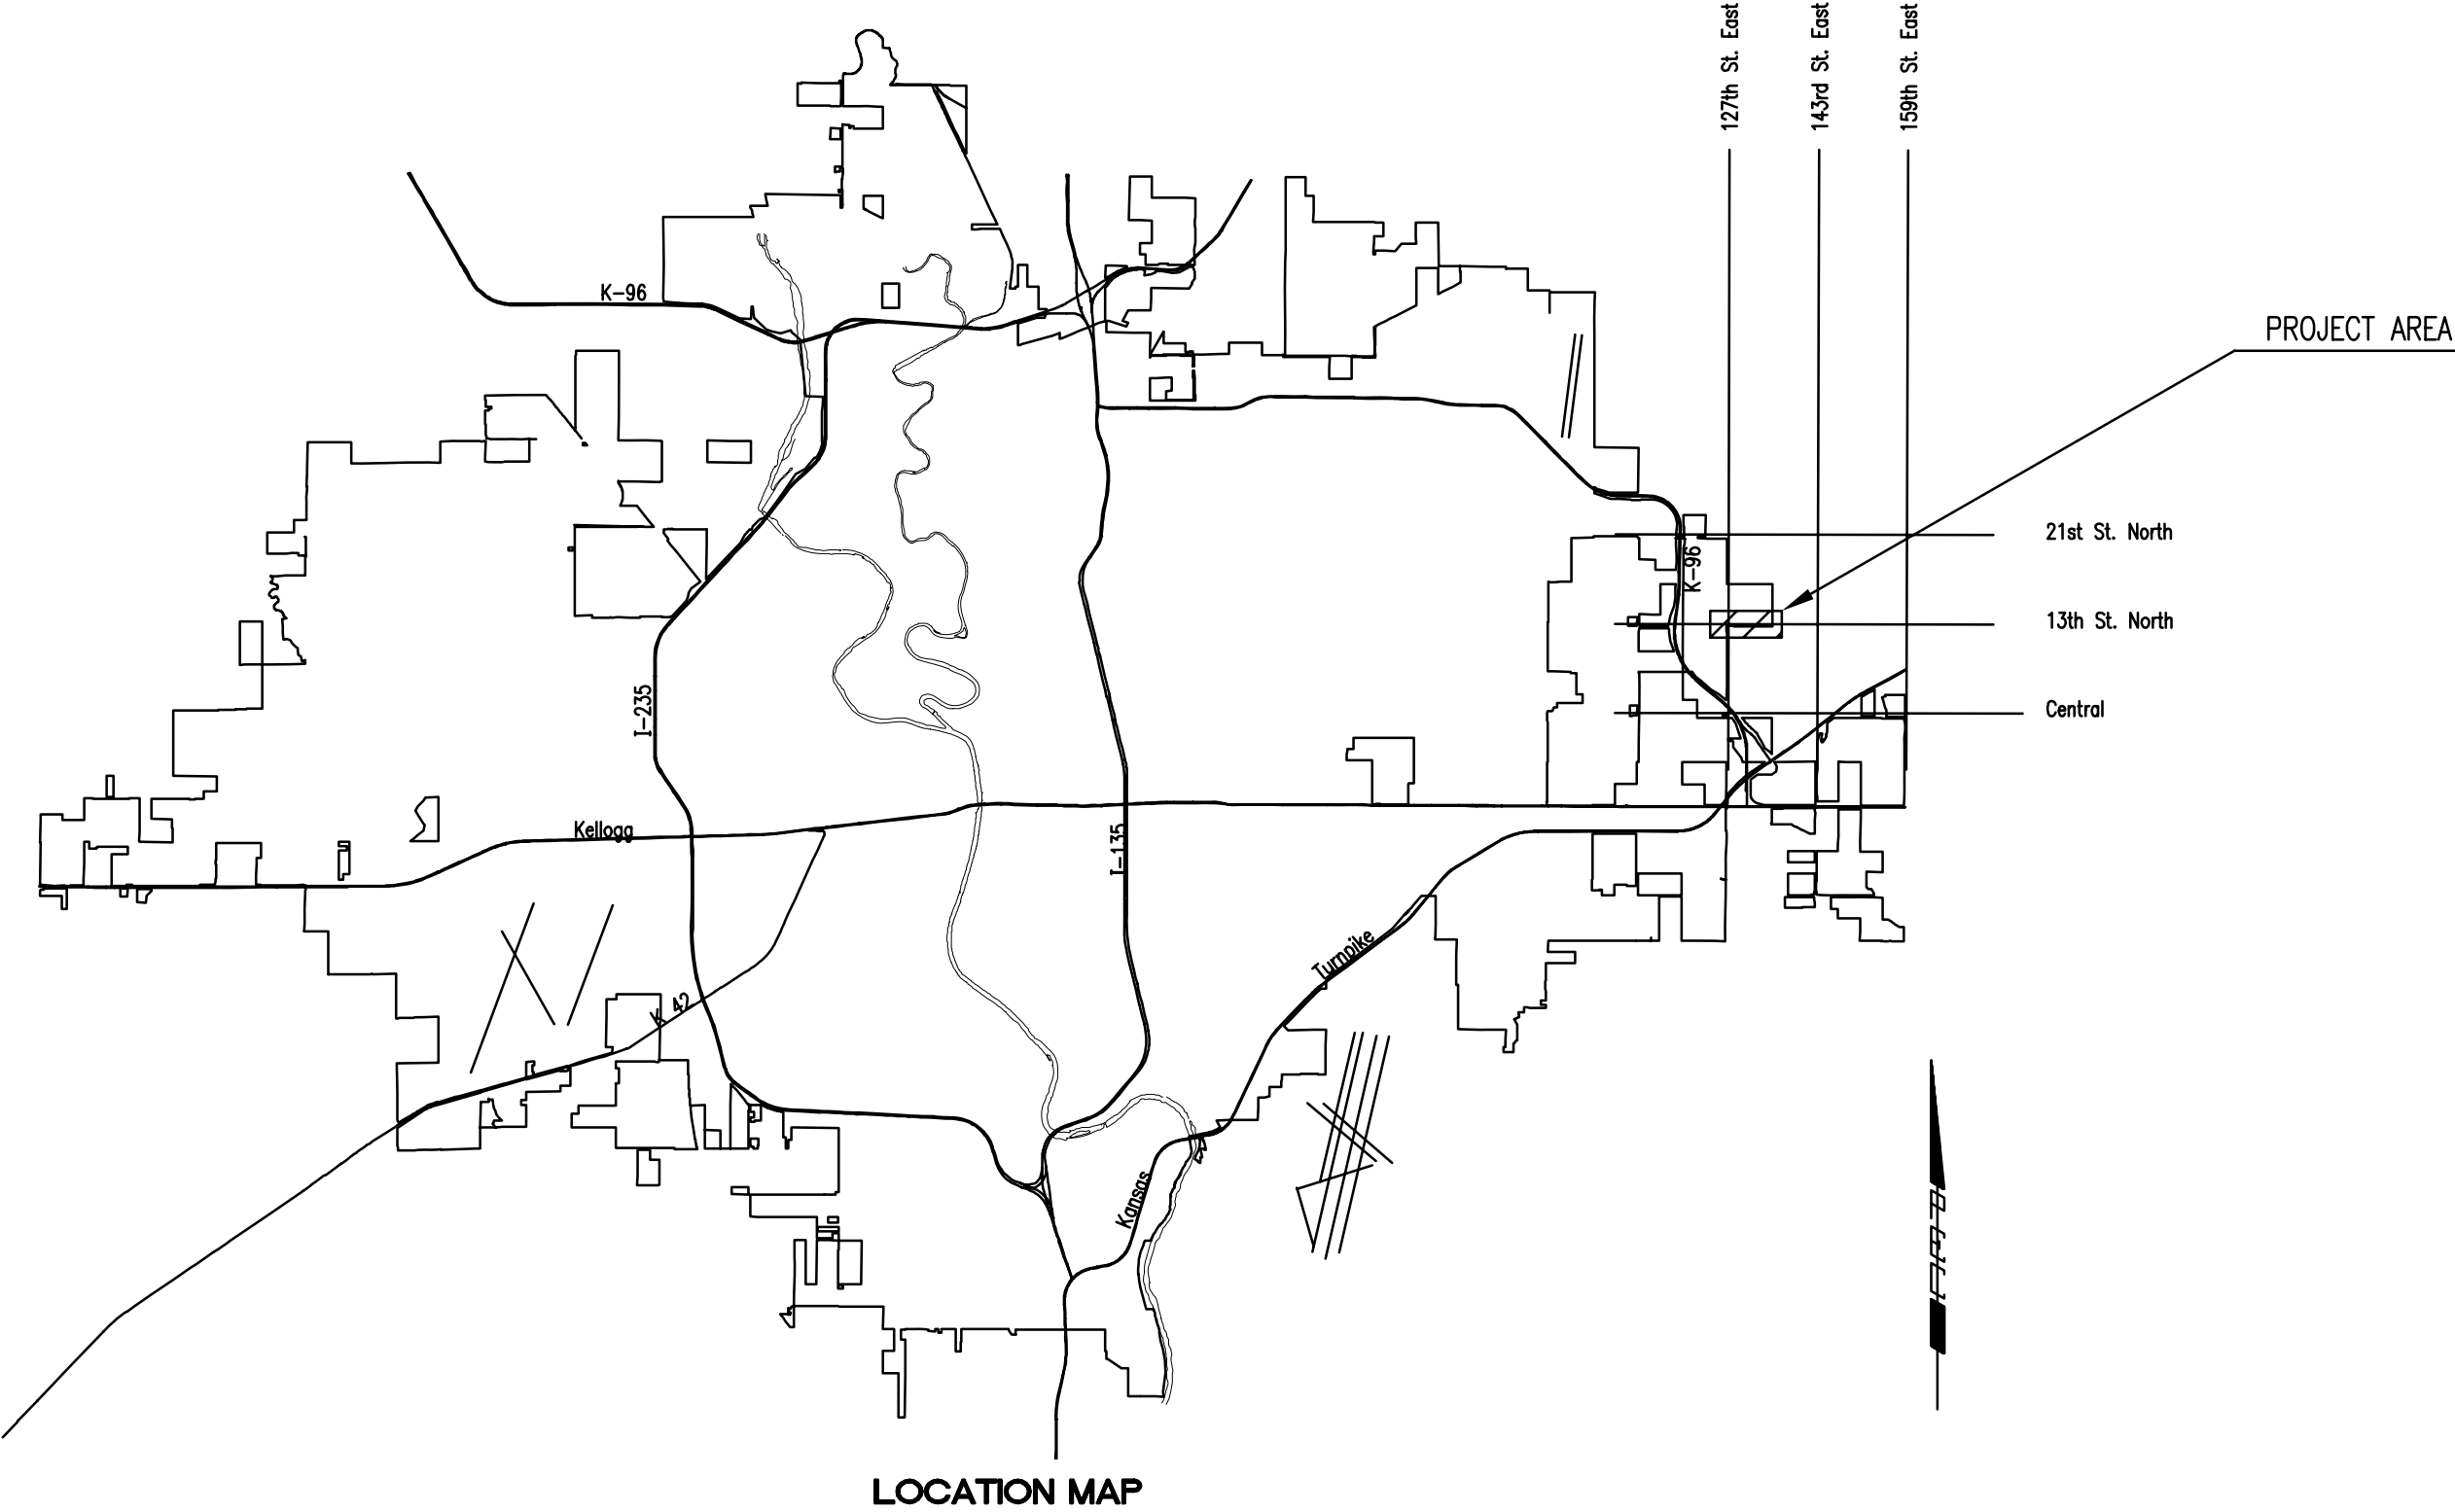

**INDEX OF SHEETS**

SHEET NO. 1	TITLE SHEET
SHEET NO. 2	KEY MAP AND GENERAL NOTES
SHEET NO. 3-6	PLAN/PROFILE
SHEET NO. 7	TYPE "P" MANHOLE DETAILS
SHEET NO. 8	FRAME & COVER DETAILS
SHEET NO. 9	MANHOLE ADJUSTMENT DETAILS
SHEET NO. 10-12	SOIL EROSION BMP DETAILS

- CONSTRUCTION SEQUENCING**
1. INSTALL PROPOSED 24" SS FROM STATION 0+22.00 TO STATION 1+29.40.
  2. COMPLETE WORK ON EXISTING MANHOLES IN CONJUNCTION WITH THE STAGE 2 STREET IMPROVEMENTS, PART 1 PROJECT.
  3. INSTALL PROPOSED 24" SS FROM STATION 1+29.40 TO STATION 3+52.70. THIS WORK SHALL NOT PROCEED UNTIL THE PILING FOR THE BRIDGE WIDENING IS DRIVEN IN PLACE AS PART OF THE STAGE 1 STREET IMPROVEMENTS, PART 1 PROJECT.
  4. INSTALL PROPOSED 24" SS FROM STATION 3+52.70 TO STATION 19+18.30 IN CONJUNCTION WITH STAGE 3 STREET IMPROVEMENTS, PART 1 PROJECT.

S. Lacy - Sedgwick County, Inspector  
 As-built  
 Stub  
 Date Released:  
 Date pdf: 04/14/2009, APR

**MARCH 2006**  
 PLANS PREPARED BY  
**PROFESSIONAL ENGINEERING CONSULTANTS, P.A.**  
 ENGINEERS  
 WICHITA, KANSAS

Sewer 03-09-2006 4:08:18 PM by: RFL  
 Plot Scale 1:1 03-09-2006 5:14:12 PM by: RFL  
 J:\SENTO\2006\0310\2006-03-09 to City\Sanitary Sewer\01-Title