

RELOCATION OF SANITARY SEWER NO. 23 INTERCEPTOR ALONG I-135 FROM ENGLISH TO PAWNEE

PHASE 1: ENGLISH/I-135 TO KELLOGG/GROVE


IN THE CITY OF WICHITA, KANSAS

OCA NO. ~~624078~~ 624087

CITY OF WICHITA PROJECT NO. 468-84375

JAMES L. ARMOUR, P.E. - CITY ENGINEER

BRB - Contractor
J. Wagner - City of Wichita, Field Project Engineer
K. Yale - City of Wichita, Inspector
Release Date: 5/7/2010
As-Built
pdf: APRosas 8/6/2010

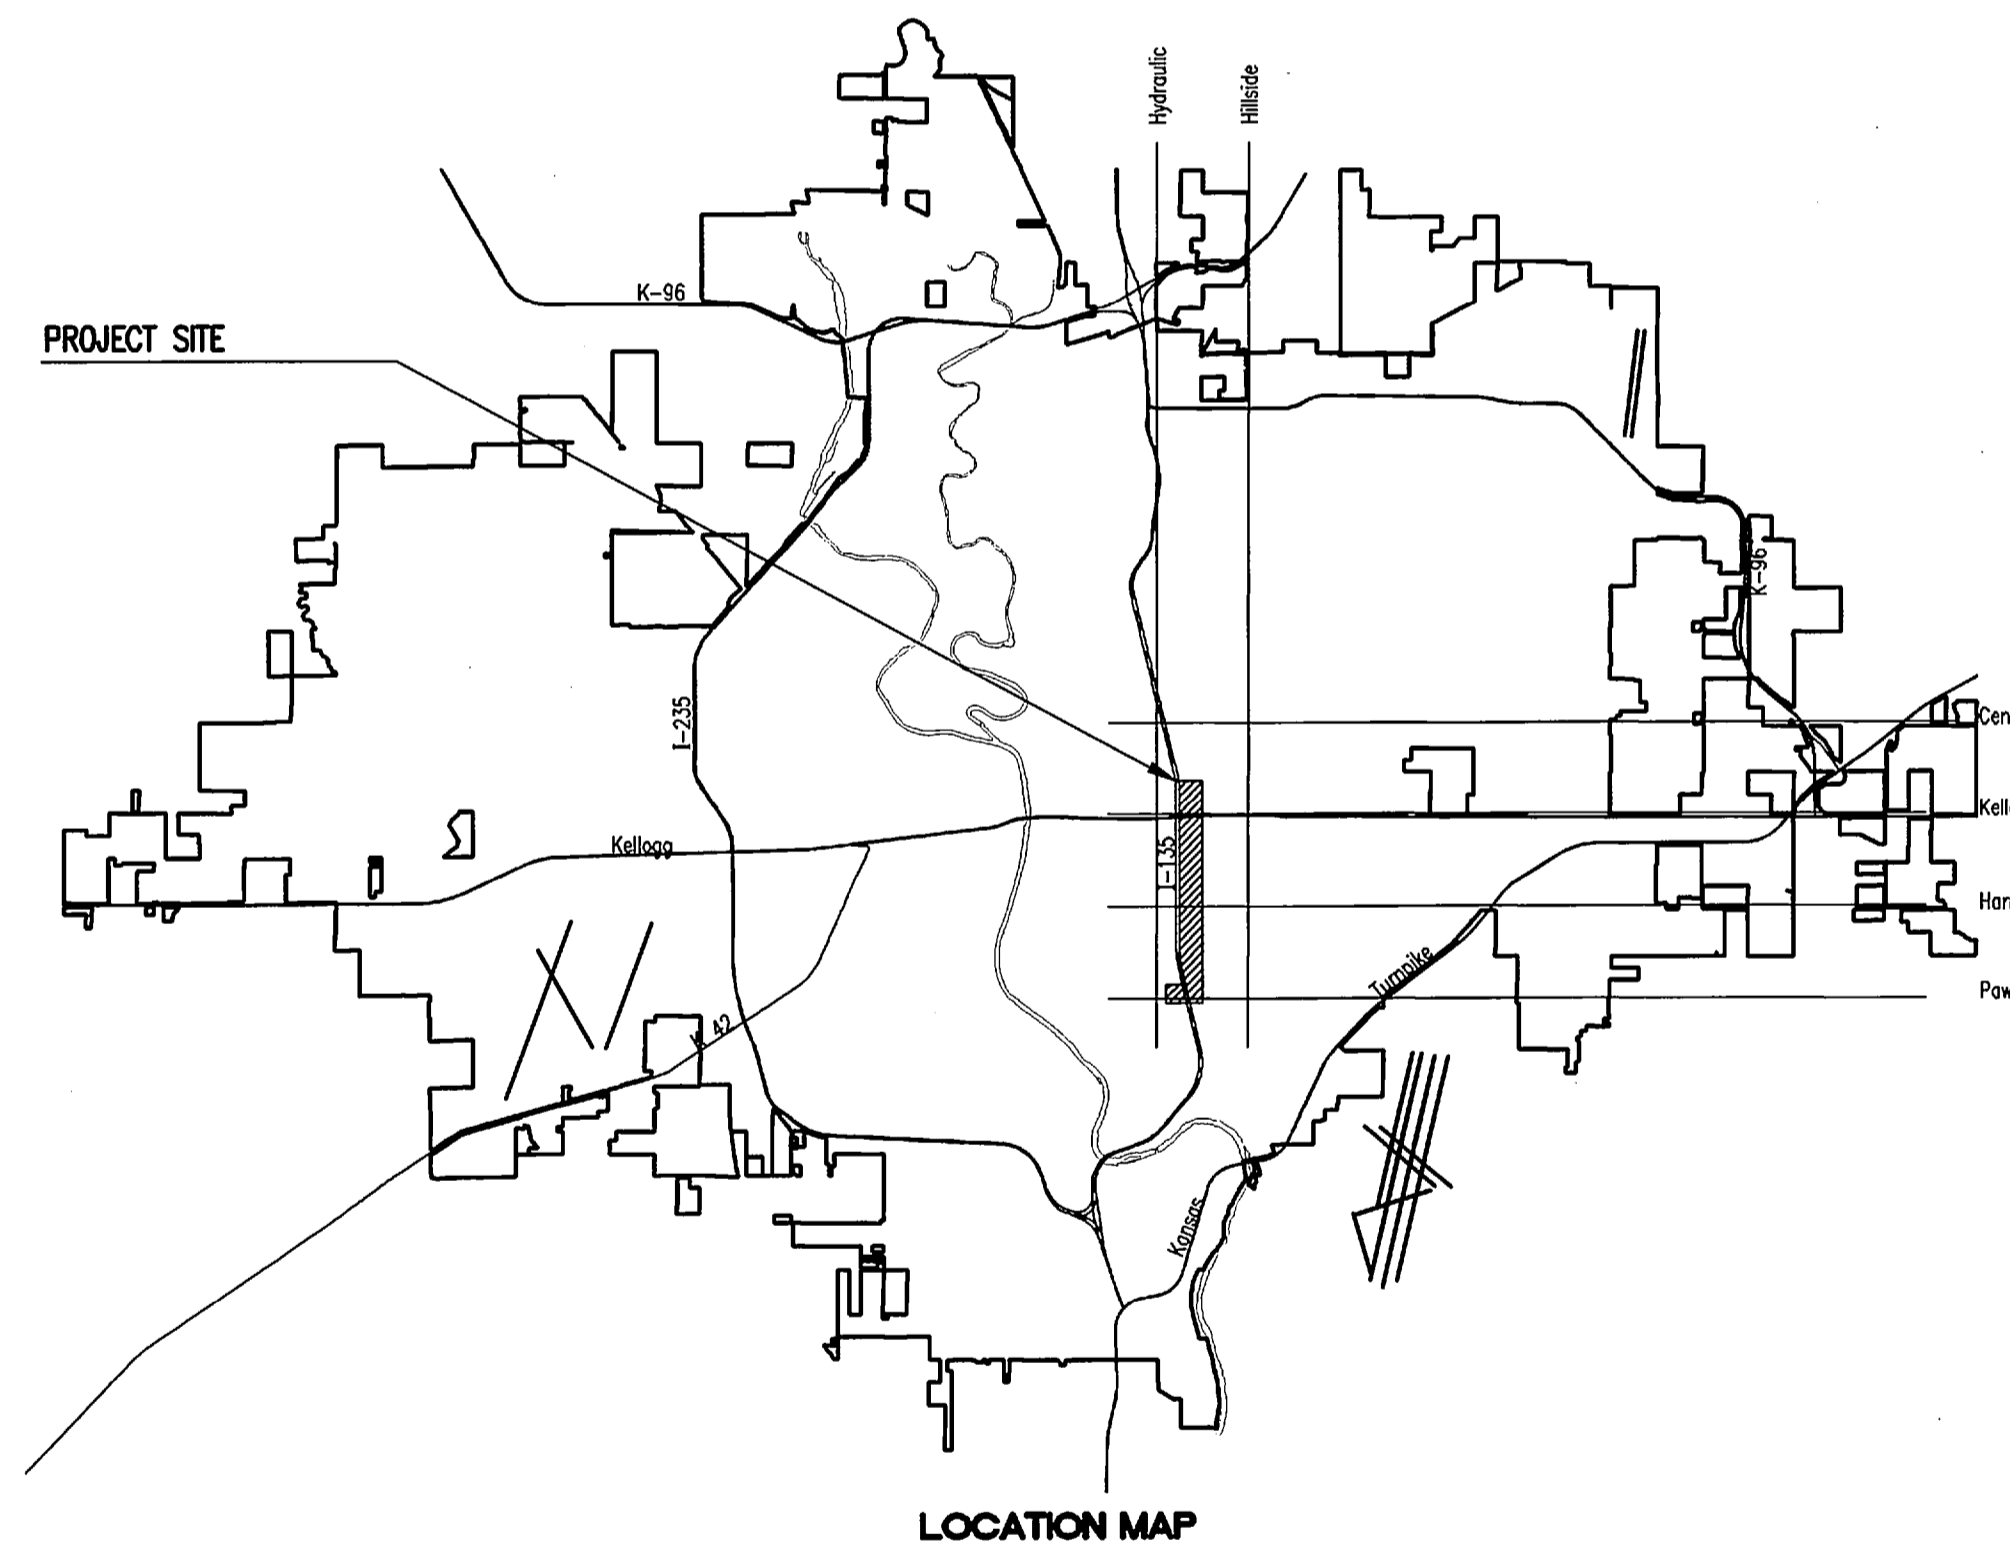

INDEX OF SHEETS

SHEET NO. 1	TITLE SHEET
SHEET NO. 2	KEY MAP AND GENERAL NOTES
SHEET NO. 3	HORIZONTAL CONTROL
SHEET NO. 4-12	PLAN/PROFILE
SHEET NO. 13	TYPE "P" MANHOLE DETAILS
SHEET NO. 14	FRAME & COVER DETAILS
SHEET NO. 15	MISCELLANIES DETAILS
SHEET NO. 16-18	SOIL EROSION BMP DETAILS
SHEET NO. 19	LANDSCAPE PLAN

FEBRUARY 2009

PLANS PREPARED BY
PROFESSIONAL ENGINEERING CONSULTANTS, P.A.
ENGINEERS
WICHITA, KANSAS

