


# LATERAL 16, MAIN 7 OF THE NORTHWEST INTERCEPTOR SEWER IN

**THE CITY OF WICHITA**  
OCA NO. 744308  
CITY OF WICHITA PROJECT NO. 468-84584  
JAMES L. ARMOUR, P.E. - CITY ENGINEER

Wichita Excavation - Contractor  
K. Kerns - City of Wichita, Field Project Engineer  
S. Cody - City of Wichita, Inspector  
As-built  
Stubs and Risers  
Release date: 4/10/2010  
pdf: APRosas 10/18/2010

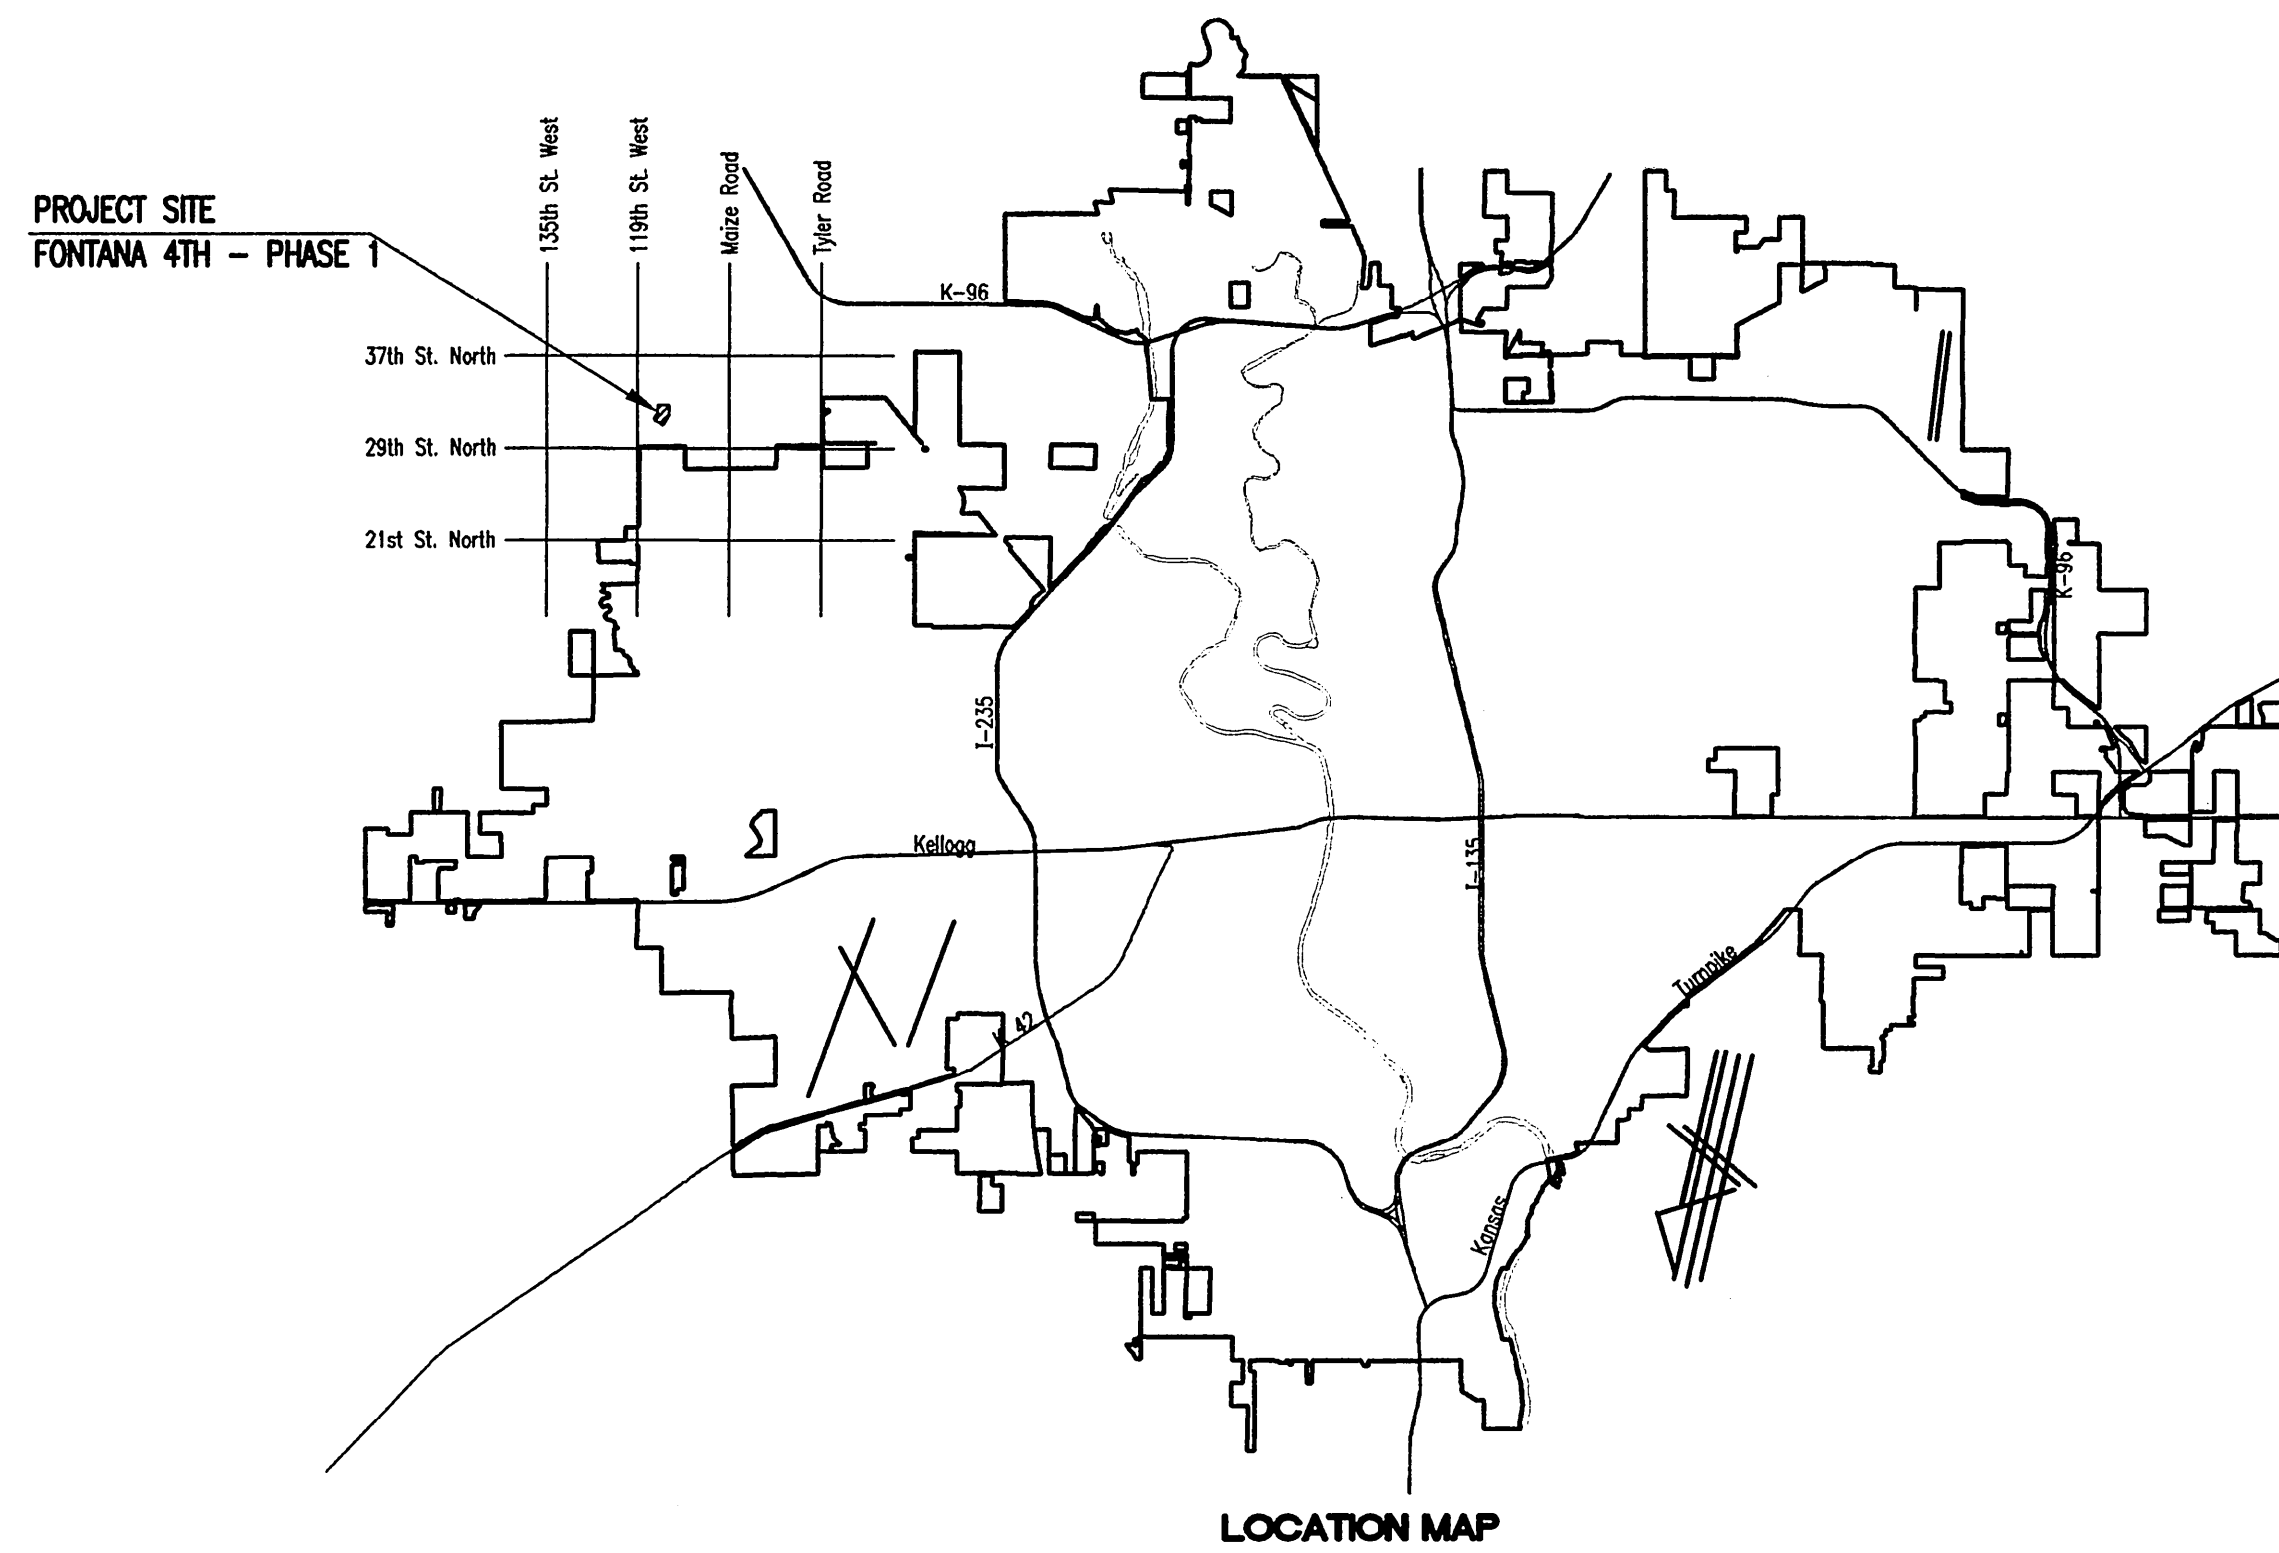

**INDEX OF SHEETS**

SHEET NO. 1	TITLE SHEET
SHEET NO. 2	KEY MAP AND GENERAL NOTES
SHEET NO. 3	PLAT
SHEET NO. 4-5	PLAT COORDINATE SHEETS
SHEET NO. 6-10	PLAN/PROFILE
SHEET NO. 11	TYPE "P" MANHOLE DETAILS
SHEET NO. 12	FRAME & COVER DETAILS
SHEET NO. 13	RISER DETAILS
SHEET NO. 14-17	SOIL EROSION BMP DETAILS
SHEET NO. 18	EROSION PROTECTION PLAN

**CONSTRUCTION SCHEDULE/SEQUENCE**

THE CONTRACTOR FOR EACH OF THE FOLLOWING FONTANA 4TH PROJECTS SHALL COORDINATE THEIR EFFORTS WITH OTHER CONTRACTORS PERFORMING WORK IN THIS AREA SUCH THAT ANY NECESSARY SIMULTANEOUS CONSTRUCTION CAN PROCEED CONCURRENTLY WITHOUT CAUSING UNDUE DELAYS SO THAT CONSTRUCTION CAN BE COMPLETED WITHIN THE TIME FRAMES AS NOTED.


**SANITARY SEWER (468-84584)**  
THE CONTRACTOR SHALL COMPLETE LINE NO. 1 AND LINE 2 IN THEIR ENTIRETY PRIOR TO COMMENCING WITH WORK ON THE REMAINDER OF THE PROJECT. THE CONTRACTOR SHALL SEQUENCE HIS WORK TO COMPLETE ALL SANITARY SEWER CONSTRUCTION, INCLUDING TESTING AND ACCEPTANCE, BY NOVEMBER 30, 2009.

**WATER DISTRIBUTION SYSTEM (448-90426)**  
THE CONTRACTOR SHALL COMPLETE FONTANA 4TH WATERLINE CONSTRUCTION BY DECEMBER 14, 2009.

**STREETS/DRAINAGE (472-84800)**  
**STORM WATER DRAIN (468-84588)**  
THE CONTRACTOR SHALL COMPLETE FONTANA 4TH STREETS/DRAINAGE CONSTRUCTION BY APRIL 1, 2010

**SEPTEMBER 2009**

PLANS PREPARED BY  
**PROFESSIONAL ENGINEERING CONSULTANTS, P.A.**  
ENGINEERS  
WICHITA, KANSAS

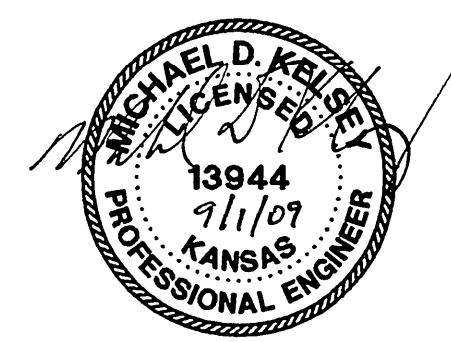

Saved: 09-01-2009 2:50:36 PM by: BEJ  
 Plot Scale: 1" = 100'-0" (09-01-2009 3:13:11 PM)  
 C:\2009\08389\001\08389-001-C-55TITLE