

Signed Chris Copeland Contractor PHILLIPS SOUTHERN ELECTRIC Date 6/16/08

Project TRAFFIC SIGNALIZATION @ N. I-235 AND MERIDIAN INTERCHANGES

Project Number 472.84424 (706956) * SOUTH INTERSECTION *

1) MOVED SIGNAL POLE BASE @ SW COR. OF SOUTH INTERSECTION APPROX. 4' S. OF PLAN. (POLE BASE @ PLAN LOCATION HAD INCORRECT BOLT PATTERN).

2) TRAFFIC CONTROLLER PAD MODIFIED TO BETTER SUIT SITE CONDITIONS
(SEE BACK)

3) MAST ARM ON POLE @ SW COR HAS A "DOG LEG" BEND IN IT. BENT DURING SHIPMENT; APPROVED FOR USE BY PAUL GUNZEL MAN, TRAFFIC ENG.

Form 192-034 (4/81)

Signed Chris Copeland Contractor PHILLIPS SOUTHERN ELECTRIC Date 6/16/08

Project TRAFFIC SIGNALIZATION @ NORTH I-235 AND MERIDIAN INTERCHANGES

Project Number 472.84424 (706956) * NORTH INTERSECTION

1) SIGNAL POLE @ NE COR OF INTERSECTION MOVED APPROX. 5' S. AND 3' WEST. (POLE BASE @ PLAN LOCATION HAD INCORRECT BOLT PATTERN).

2) TRAFFIC MH MOVED APPROX. 10' EAST AND 5' NORTH OF PLAN TO GET MH AWAY FROM ASPH. SHOULDER


3) TRAFFIC CONTROLLER AND PAD MOVED APPROX. 28' NORTH OF PLAN. IT WAS MOVED TO N. SIDE OF NEW SIGNAL POLE AS A PRECAUTIONARY MEASURE.

Form 192-034 (4/81)

Sketches, etc.

CONTROLLER BOX

ASPHALT
SHOULDER

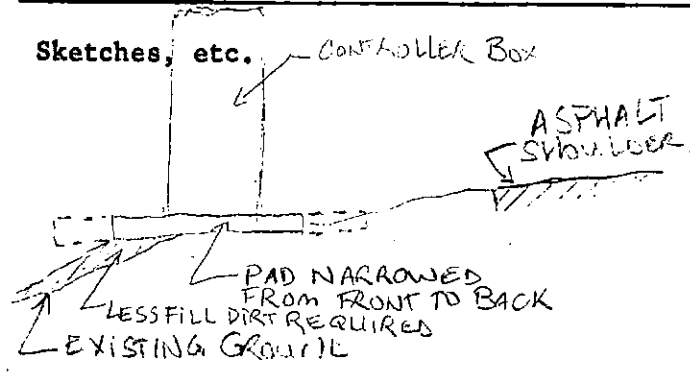

Signed Chris Coffey Contractor PHILLIPS SOUTHERN ELECTRIC Date 6/16/08

Project TRAFFIC SIGNALIZATION @ N. I-235 AND MERIDIAN INTERCHANGES

Project Number 472,84424 (706956) * SOUTH INTERSECTION *

1.) MOVED SIGNAL POLE BASE @ SW COR. OF SOUTH INTERSECTION APPROX. 4' S. OF PLAN. (POLE BASE & PLAN LOCATION HAD INCORRECT BOLT PATTERN)

2.) TRAFFIC CONTROLLER PAD MODIFIED TO BETTER SUIT SITE CONDITIONS
(SEE BACK)

3.) MAST ARM ON POLE @ SW COR HAS A "DOG LEG" BECAUSE IT WAS BENT DURING SHIPMENT; APPROVED FOR USE BY PAUL GUNZEL MAN, TRAFFIC ENG.

Signed Chris CopelandContractor PHILLIPS SOUTHERN ELECTRICDate 6/16/08Project TRAFFIC SIGNALIZATION @ NORTH I-235 AND MERIDIAN INTERCHANGESProject Number 472.84424 (706956) * NORTH INTERSECTION

1) SIGNAL POLE @ NE COR OF INTERSECTION MOVED APPROX. 5' S AND 3' WEST.
(POLE BASE @ PLAN LOCATION HAD INCORRECT BOLT PATTERN).

2) TRAFFIC MH MOVED APPROX. 10' EAST AND 5' NORTH OF PLAN TO GET MH AWAY FROM ASPH. SHOULDER

3) TRAFFIC CONTROLLER AND PAN MOVED APPROX. 28' NORTH OF PLAN. IT WAS MOVED TO N. SIDE OF NEW SIGNAL POLE AS A PRECAUTIONARY MEASURE.

Sketches, etc.


CONTROLLER BOX

ASPHALT
SHOULDER

PAD NARROWED
FROM FRONT TO BACK

LESS FILL DIRT REQUIRED

EXISTING GROUND

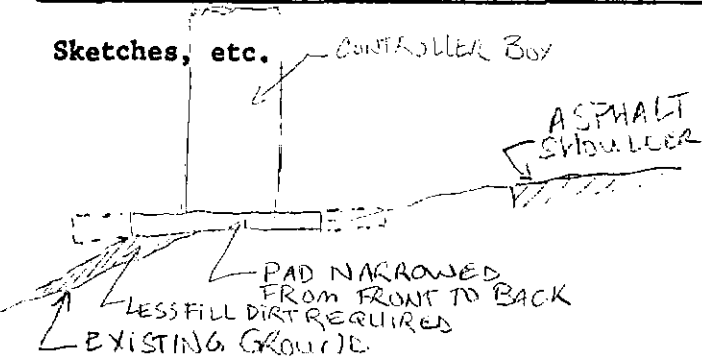

ENGINEERING DEPARTMENT

CITY OF WICHITA

MISCELLANEOUS INFORMATION

Signed Tim Anthis

Contractor PSE

Date 4-14-08

Project '06/07 Traf. Signalization - Ph I

Project Number 472-84424 (706956)

No major changes except for minor movements
of signal pole bases & realignment of sidewalks
— Additional New style WCR's added @
13th str. site per ADA standards