


**STORM WATER SEWER PLANS TO SERVE
MENARDS - WEST WICHITA, KS
STONEBRIDGE COMMERCIAL ADDITION**

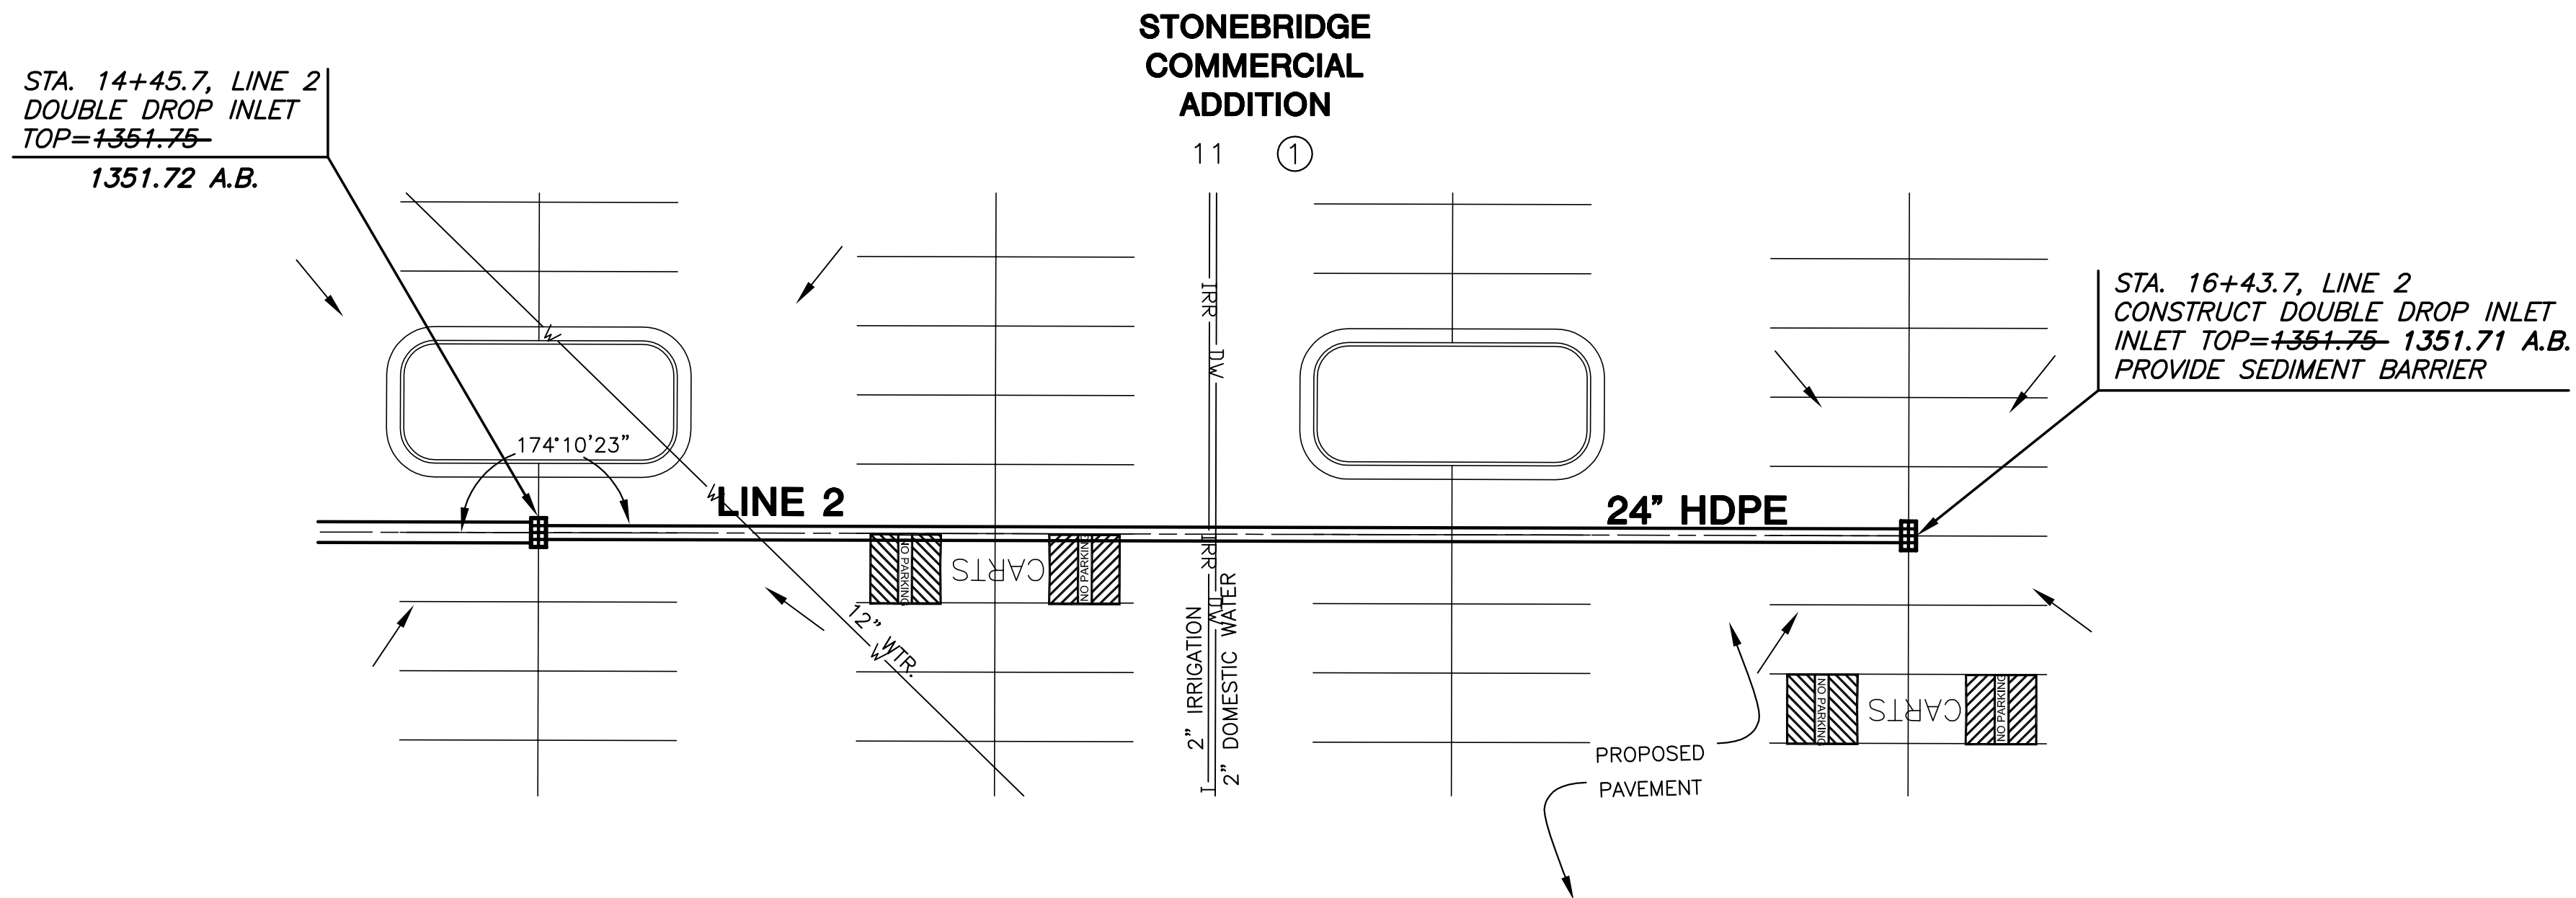


AS BUILT PLANS: 12.6.10

INSPECTED BY: MIKE VANDECREEK, MKEC
ENGINEERING CONSULTANTS, INC

CONSTRUCTED BY: DULING CONSTRUCTION
CO., INC.


NOTE:
HDPE PIPE SHALL BE ADS
N-12 ST FB INSTALLATION
AND BEDDING SHALL BE AS
PER MANUFACTURER'S
RECOMMENDATIONS.

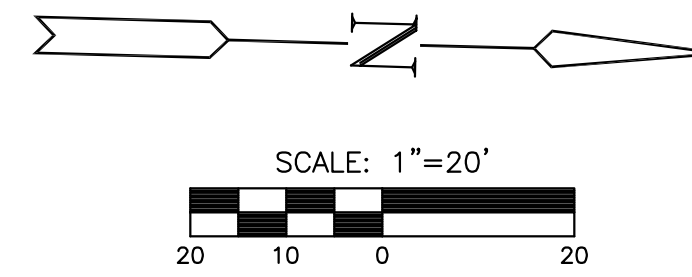

PLAN LINE 2

PROFILE LINE 2

SCALE: HORIZ. 1"=20'
SCALE: VERT. 1"=5'

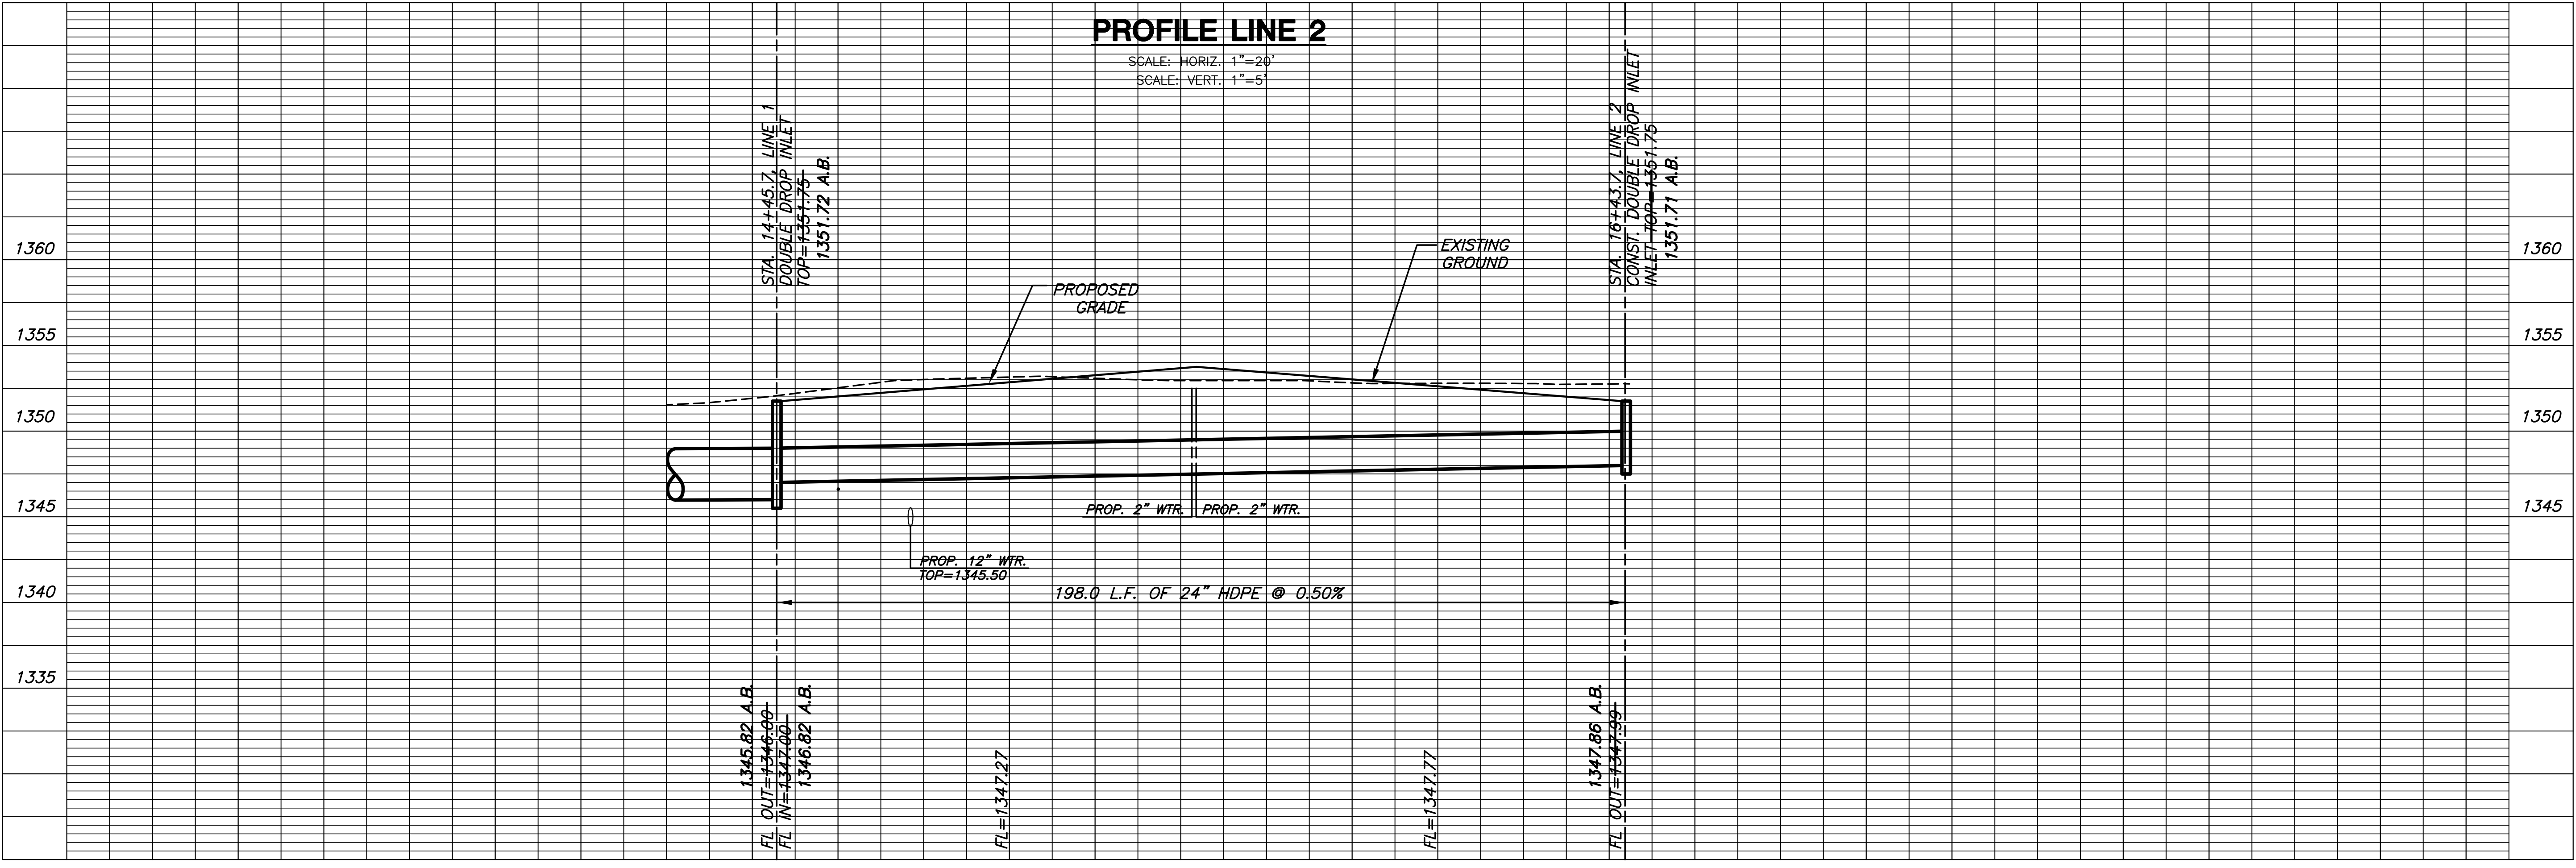

**SWS PLAN &
PROFILE**

SHEET TITLE
08626
PROJECT NUMBER

DESIGN BY: **MKEC**
DRAWN BY: **MKEC**
CHECKED BY: **MAB**

ISSUED
REVISED: **AS BUILT
12-06-10**

SHEET NO.
22 of 45