

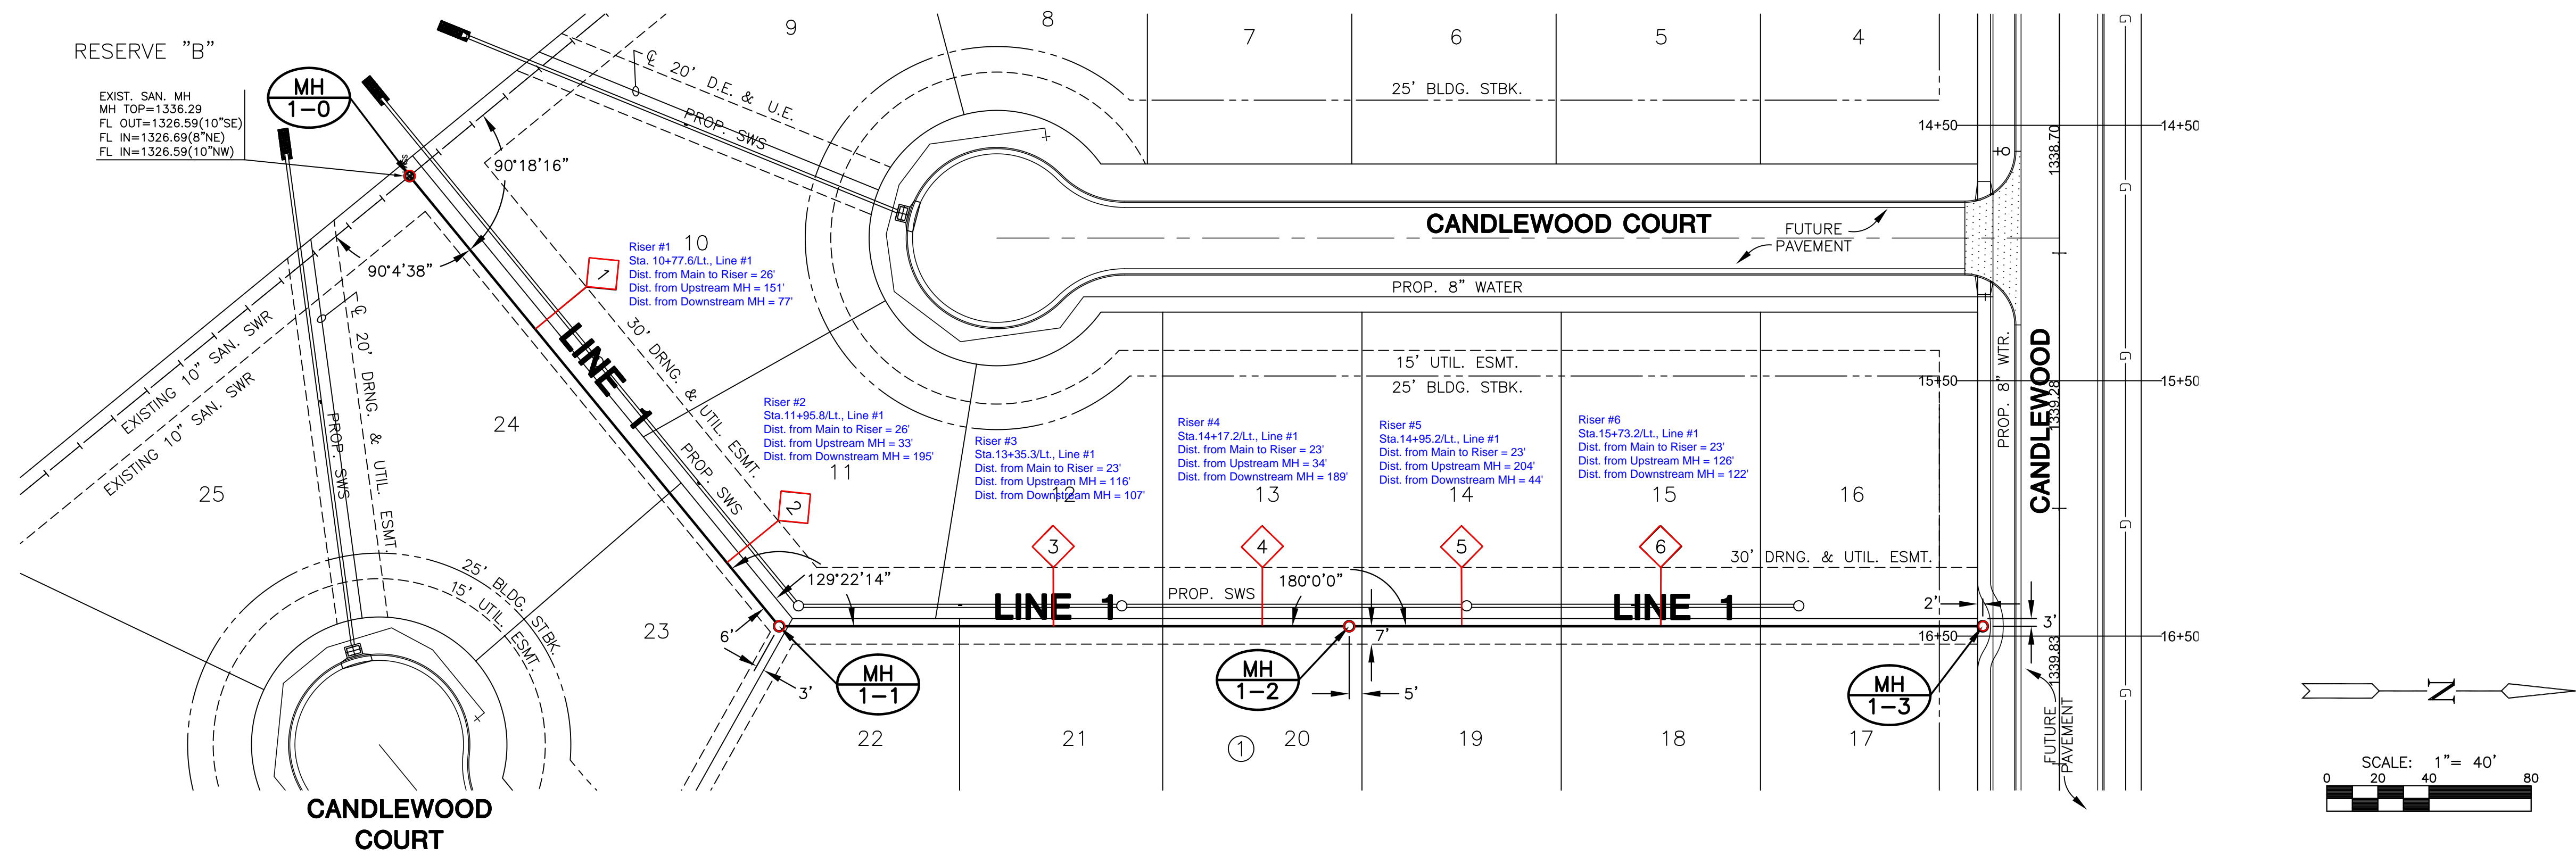


**SANITARY SEWER PLANS FOR
AVALON PARK 3RD ADDITION
PHASE 2**

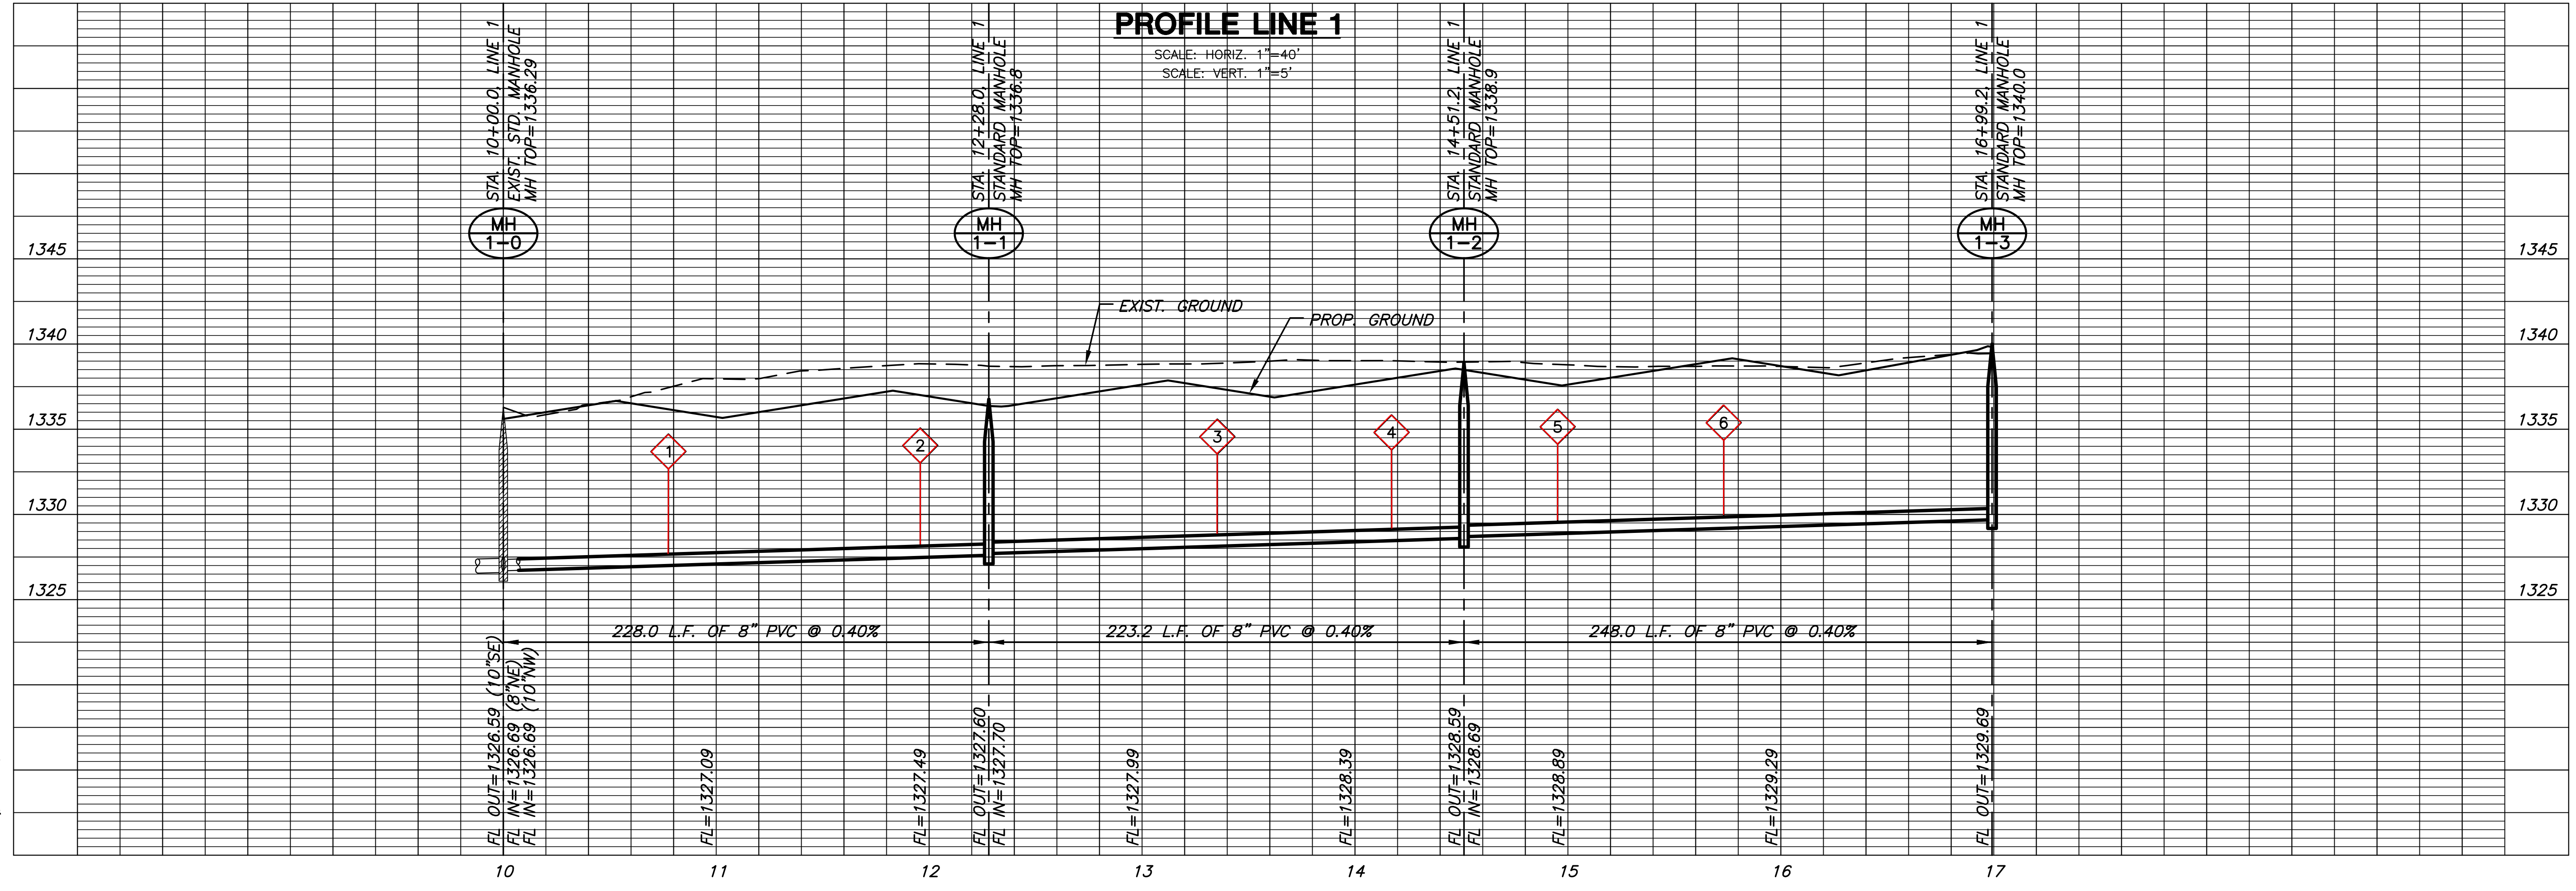

PLAN LINE 1

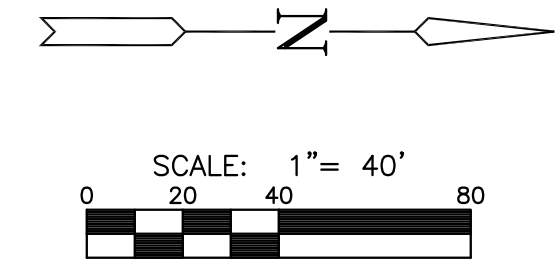

PROFILE LINE 1

SCALE: HORIZ. 1" = 40'
SCALE: VERT. 1" = 5'

LINE 1
SHEET TITLE
468-84010
PROJECT NUMBER

DESIGN BY: **DFL**
DRAWN BY: **JWC**
CHECKED BY: **GJA**

ISSUED: **October 2010**
REVISED:

SHEET NO.
4 of 12

PLOT DATE: Wednesday, October 13, 2010 @ 07:57AM

J:\PROJECTS\2010\10228_AVALON_PARK\CADD\CIVIL\SAN\10228_B1.DWG